

CERTIFICATE OF LOCATION OF GOVERNMENT CORNER

County of Anoka

State of Minnesota



East 1/4 Corner of Sec. 14 Township 30 Range 24

On the 4th day of September, 1943, the described corner was evidenced by a concrete monument

and to perpetuate the location of said corner, at the exact location thereof, a permanent marker was placed consisting of a position on a manhole cover with holes drilled in rim of manhole to the North, South, East and West

AND on the 4th day of September, 2008, said permanent marker was found and the ties were updated

Updated reference ties are as shown below.

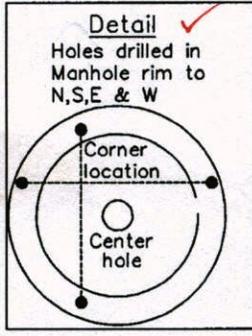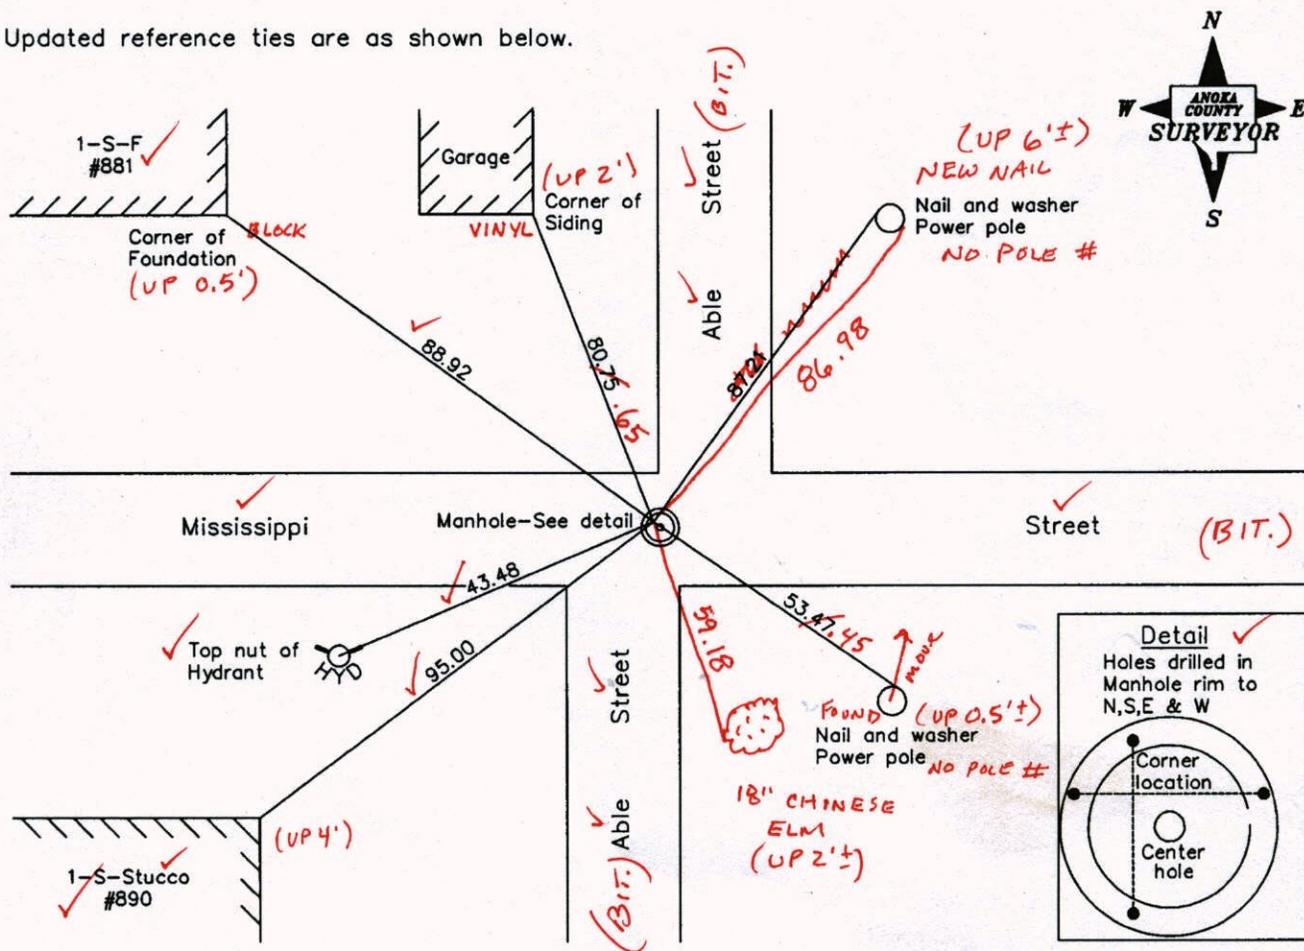

~~10-30-14~~
10-30-14
BK-55

Revised date	7/19/89
	7/28/94
	9/04/08

TOTAL STA.

N.A.D. 1983 Coordinates (1996 Adjustment)	
County Project Coordinates	
Northing	118529.0067
Easting	504818.6969
Date	7/15/04

I hereby certify that this United States public land survey monument record is correct and complete to the best of my knowledge and belief.

Larry D. Hoium Date 11/07/08

Larry D. Hoium, Anoka County Surveyor

Minnesota License Number 18165

CERTIFICATE OF LOCATION OF GOVERNMENT CORNER

County of Anoka

State of Minnesota


East 1/4 Corner of Sec. 14 Township 30 Range 24

On the 4th day of September, 1943, the described corner was evidenced by a concrete monument

and to perpetuate the location of said corner, at the exact location thereof, a permanent marker was placed consisting of a position on a manhole cover with holes drilled in rim of manhole to the North, South, East and West

AND on the 4th day of September, 2008, said permanent marker was found and the ties were updated

Updated reference ties are as shown below.

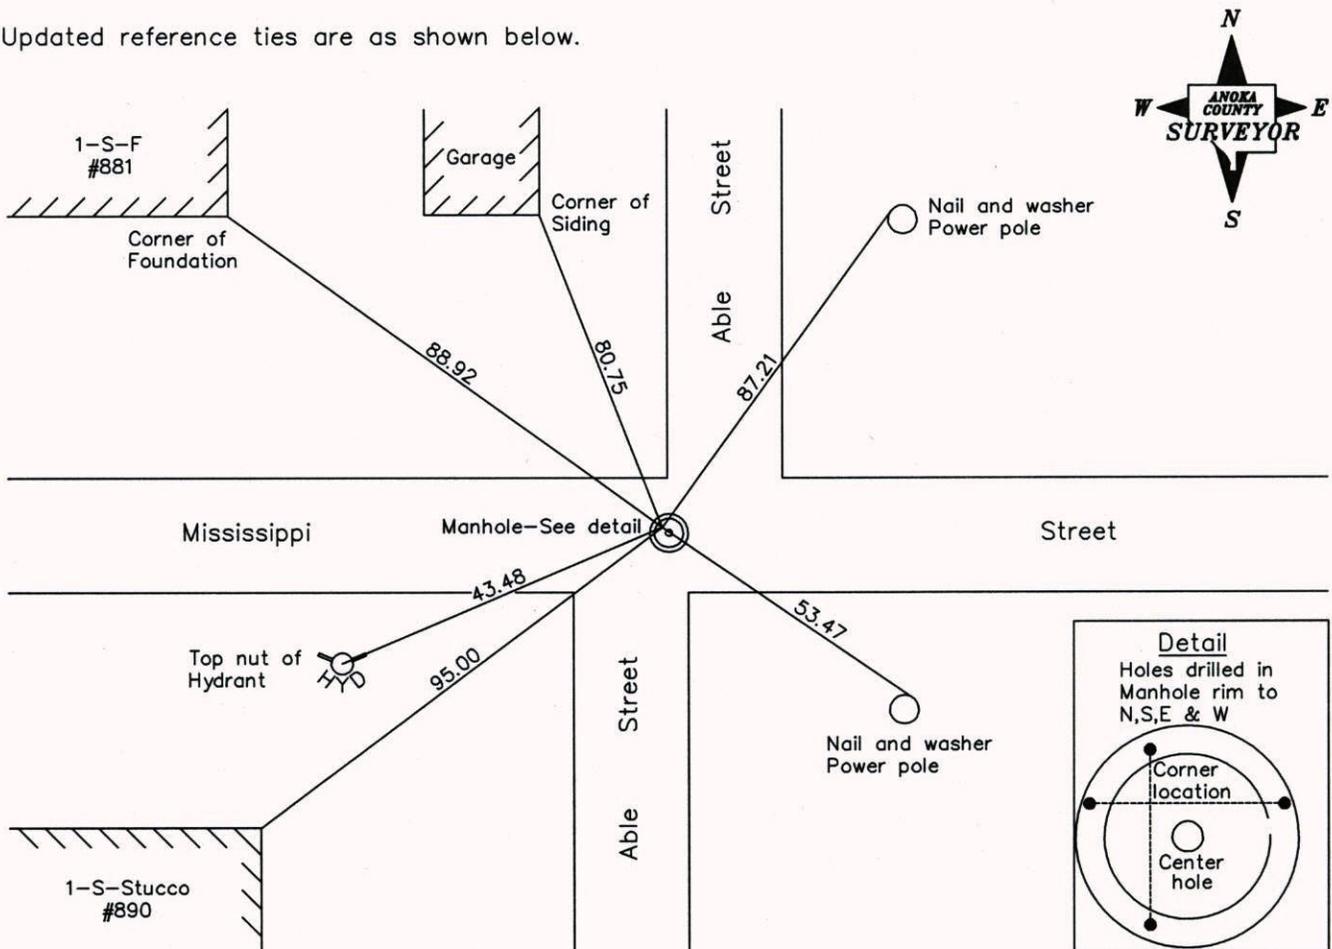

Revised date
7/19/89
7/28/94
9/04/08

N.A.D. 1983 Coordinates (1996 Adjustment)	
County Project Coordinates	
Northing	118529.0067
Easting	504818.6969
Date	7/15/04

I hereby certify that this United States public land survey monument record is correct and complete to the best of my knowledge and belief.

Date 11/07/08
 Larry D. Hoium, Anoka County Surveyor
 Minnesota License Number 18165

CERTIFICATE OF LOCATION OF GOVERNMENT CORNER

County of Anoka

State of Minnesota

EAST 1/4 Corner of Sec. 14 Township 30 Range 24


I hereby certify that on the 4 day of SEPT., 1943, I found the described corner which was evidenced by CONC. MON.

and I further certify that to perpetuate the location of said corner, I did, at the exact location thereof, place a permanent marker consisting of MANHOLE COVER HOLES DRILLED IN RIM OF MANHOLE N-S-E-W

which reference or witness monuments are located in the manner following:



N.A.D.	1983	Co-ordinates
County	Project	Co-ordinates
Northing	<u>118529.0067</u>	
State Plane Co-ordinates		
Y	_____	
X	_____	
Date	<u>7/15/04</u>	

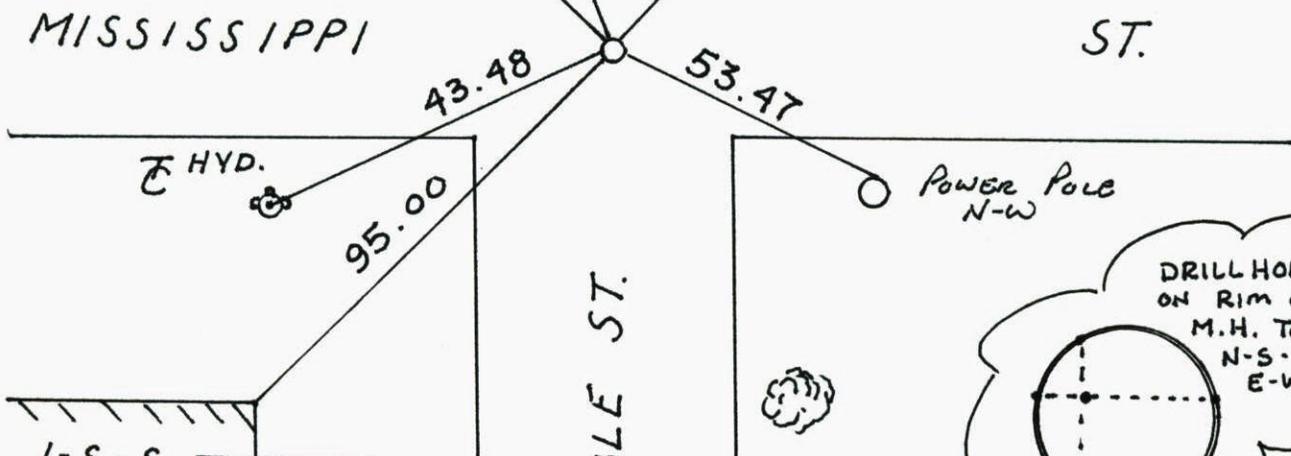


I hereby certify that this United States public land survey monument record is correct and complete to the best of my knowledge and belief.

Larry D. Hoium Date 11/7/08

LARRY D. HOIUM, Anoka County Surveyor

Minnesota License Number 18165

Revised date	Revised date	Revised date
<u>7-1-86</u>		
<u>1-7-88</u>		
<u>7-19-89</u>		
<u>7-28-94</u>		
<u>9-4-08</u>		

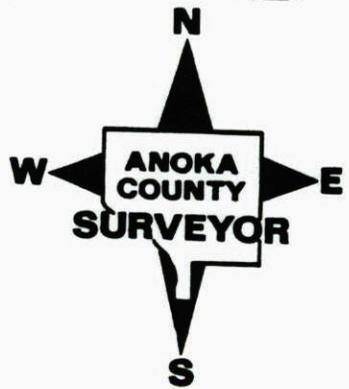

CERTIFICATE OF LOCATION OF GOVERNMENT CORNER

County of Anoka

State of Minnesota


EAST 1/4 Corner of Sec. 14 Township 30 Range 24

I hereby certify that on the 4 day of SEPT., 1943, I found the described corner which was evidenced by CONCRETE MONUMENT


and I further certify that to perpetuate the location of said corner, I did, at the exact location thereof, place a permanent marker consisting of MANHOLE COVER

P.K.s 2.00' NORTH AND EAST

which reference or witness monuments are located in the manner following:

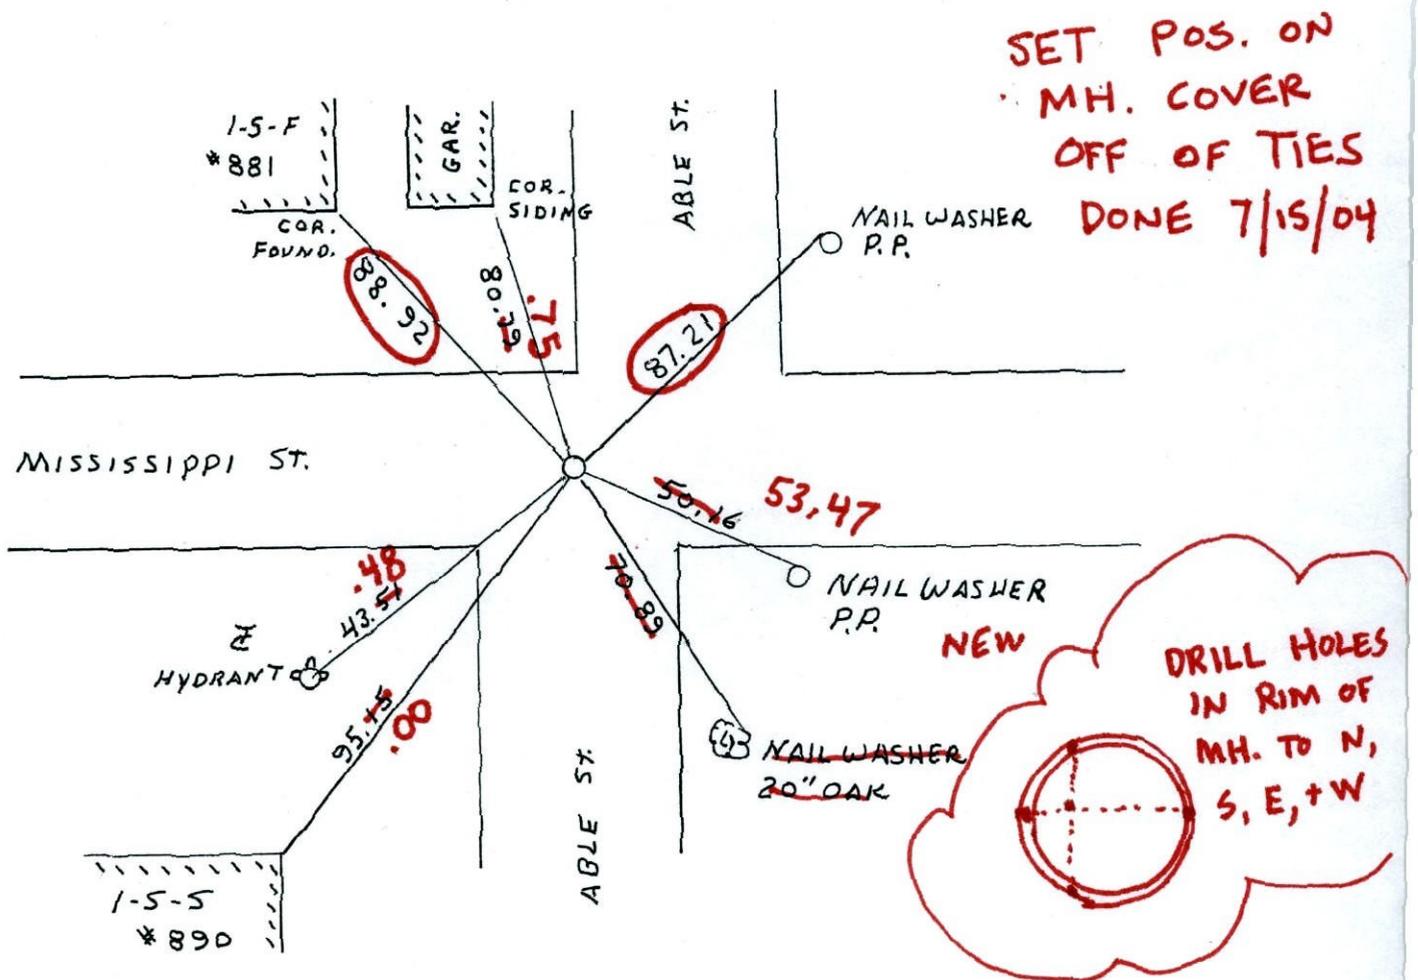

SET POS. ON
MH. COVER
OFF OF TIES
DONE 7/15/04

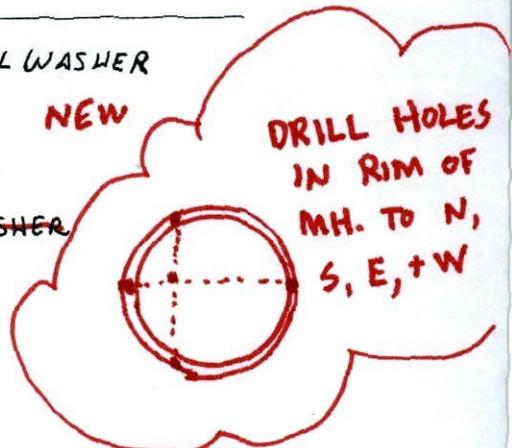

Revised date	By
	H. LARSON
7-1-86	D. ROSS
REDRAWN 1-7-88	H. LARSON
7-19-89	A. SHROYER
7-28-94	

9-4-08

Minnesota State Plane Coordinates
South Zone

Y _____ X _____

County Surveyor _____

Date _____

Registered Land Surveyor No. _____


E 1/4 Cor. Sec. 14, T30, R24

A point on Manhole Cover in \pm Miss St. &

Able St. to South

Retied after Const. of Miss. St.

PKs 2' NNE

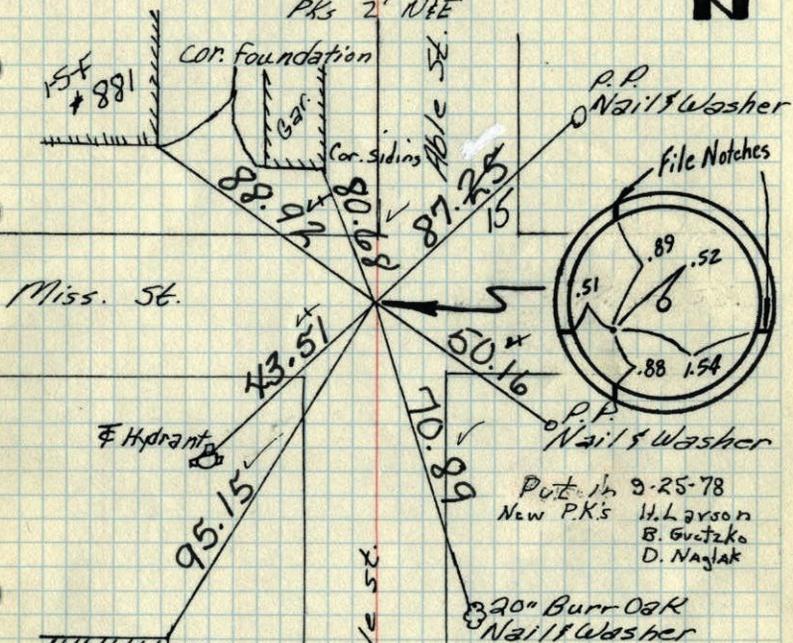

TIE CHECK
7-18-80
B. STEPHENS
P. ROSS
P. HORNEY

Tie Check
Aug 18, 1970
D. Powell
R. Brien
B. Olson

Tie Check
June 24, 74
R. Farmer
N. Dahl
D. Dahl

TIE CHECK
August 1, 1977
R. Spahr
S. Brien
J. Stephens

Oct. 19, 1966
M. D. Anderson
H. J. Larson
D. h. Potter

temp 50°

TIE CHECK
7-27-78
D. DAHL

TEMPERATURE CORRECTED
AND HORIZONTALLY
TAPED MEASUREMENTS


ROLAND W. ANDERSON
COUNTY SURVEYOR
ANOKA COUNTY, MINNESOTA

E 1/4 Cor. Sec. 14, T30, R24

A point on Manhole Cover in \pm Miss St. &

Able St. to South

Retied after Const. of Miss. St.

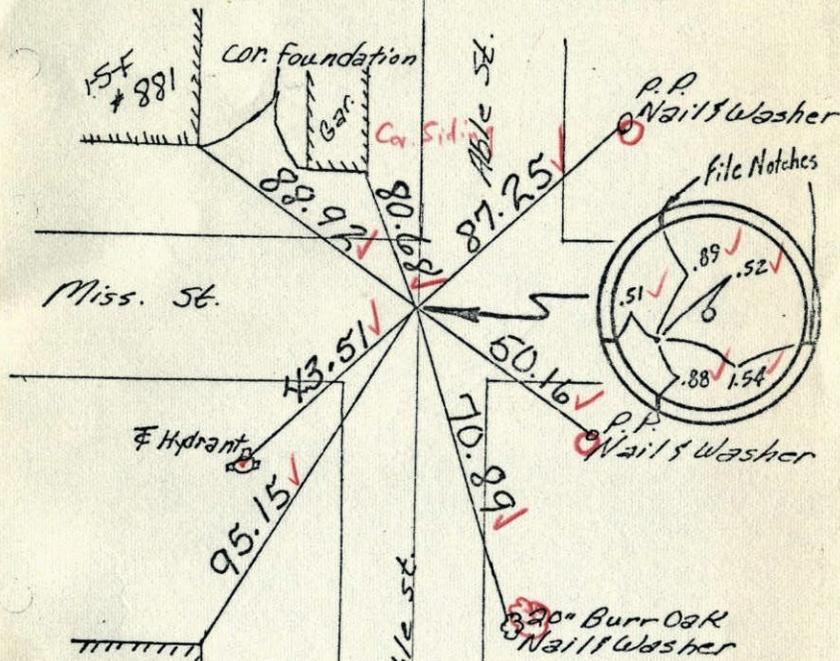

1-5-5
#890

8/18/70
D. Powell
R. Brien
B. Olson

Oct. 19, 1966
M. D. Anderson
H. J. Larson
D. h. Potter

temp 50°


TEMPERATURE CORRECTED
AND HORIZONTALLY
TAPED MEASUREMENTS

ROLAND W. ANDERSON
COUNTY SURVEYOR
ANOKA COUNTY, MINNESOTA

E 1/4 Cor. Sec. 14 T30-R24

1966


A point on Manhole Cover in E.E. Miss St. & Able St. to South
Retied after Const. of Miss St.

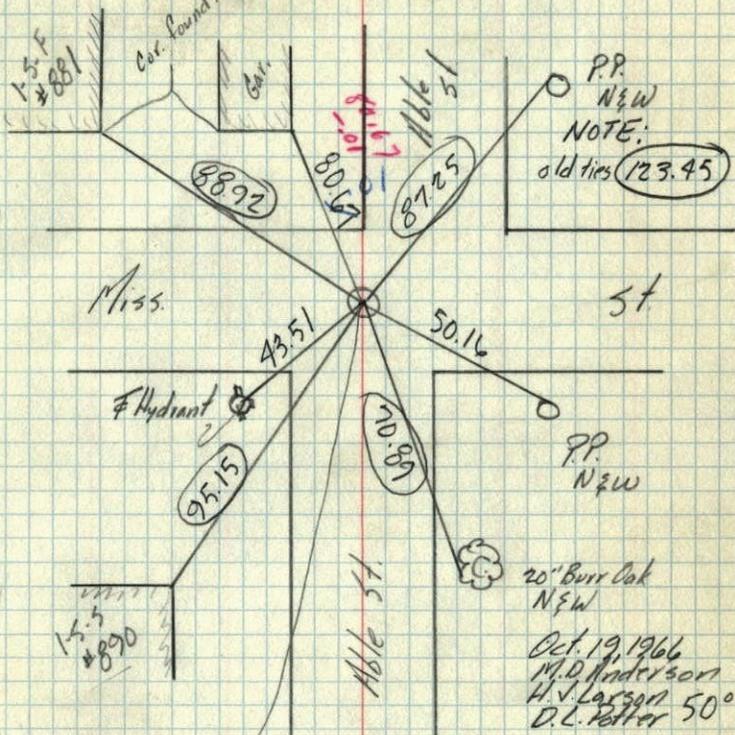

P.P. N&W
NOTE:
old ties 123.45

20\" Burr Oak
N&W
Oct. 19, 1966
M.D. Anderson
H. Larson 50°
D.L. Potter


REDRAW

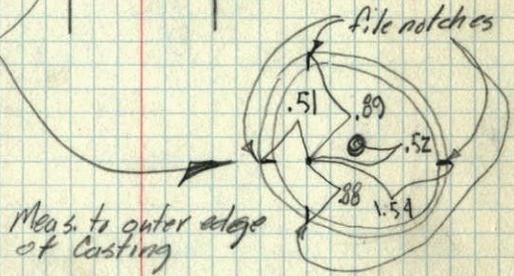



E 1/4 Cor. Sec 14 T30-R24

1960 30

A Point on Manhole Cover
2.2' So. of E.E. of Miss. St. & Able St. to So.

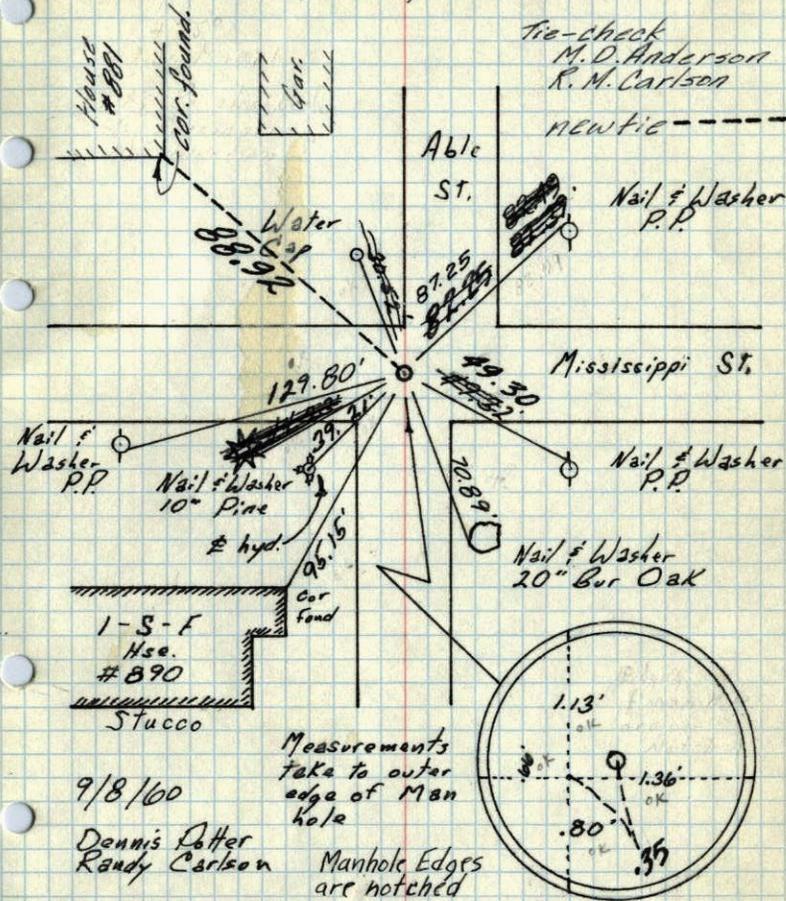

Tie-check
M.D. Anderson
R.M. Carlson

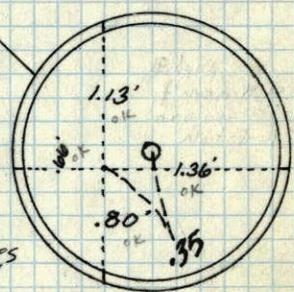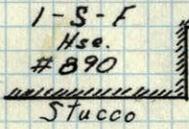



TEMPERATURE CORRECTED
AND HORIZONTALLY
TAPED MEASUREMENTS

Tie Check
July 5, 1966
H. Larson
D. Potter

ROLAND W. ANDERSON
COUNTY SURVEYOR
ANOKA COUNTY, MINNESOTA

1960
E 1/4 Cor. Sec 14, T30, R24

A point on Man
hole cover

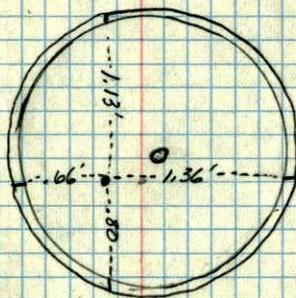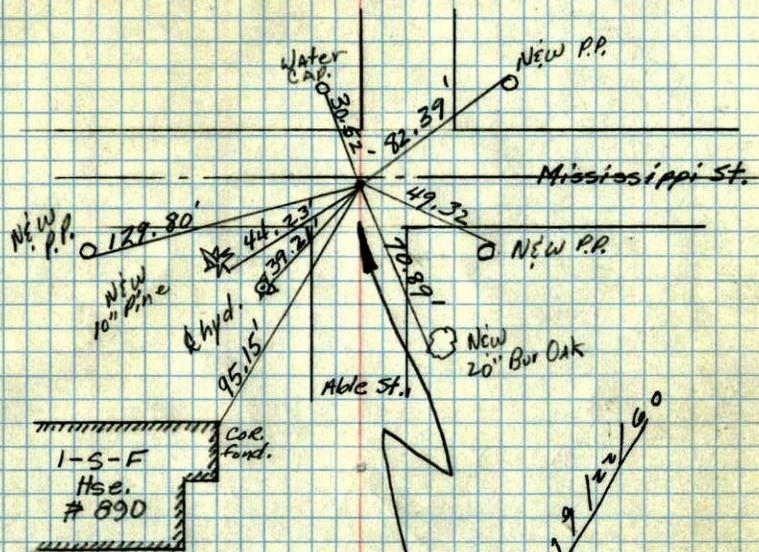

Measurement
take to outer
edge of Man
hole

TC
9/8/60


Temp. 65°

Dennis Potter
Randy Carlson

1955
E 1/4 CORNER OF Sec. 14 T. 30 N. R. 24 W

Concrete Man Down 4"

Re-tried By
W. J. Lundstrom
4-30-55

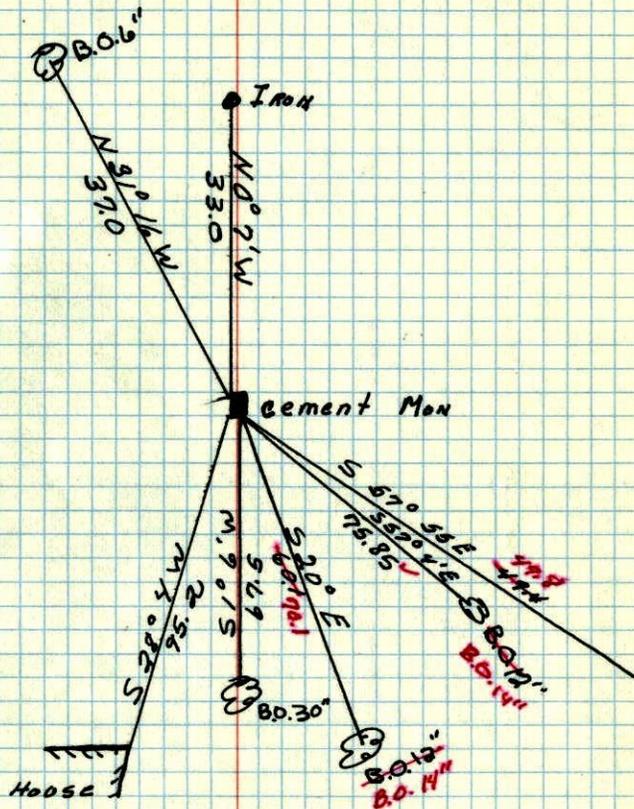

Sept 4, 1943
Harvey A Cartwright