

CERTIFICATE OF LOCATION OF GOVERNMENT CORNER

County of Anoka

State of Minnesota

Meander Corner of Sec. 13 Township 30 Range 24



(On south line of section)

On the 4th day of January, 1963, the described corner was evidenced by a 3/4" iron pipe

and to perpetuate the location of said corner, at the exact location thereof, a permanent marker was placed consisting of a cast iron monument with a sign and post on the south side

AND on the 4th day of September, 2008, said permanent marker was found and the ties were updated

Updated reference ties are as shown below.

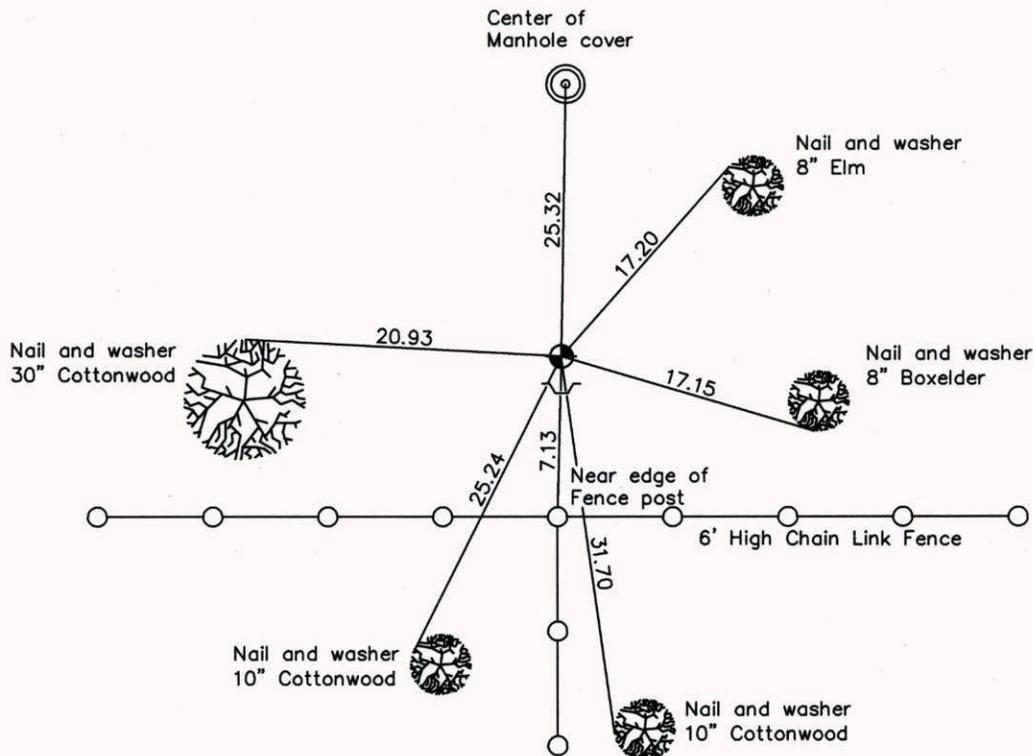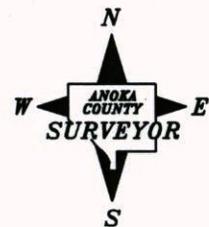

Revised date

8/04/94
12/08/98
9/04/08

N.A.D. 1983 Coordinates
(1996 Adjustment)

County Project Coordinates	
Northing	<u>115864.0476</u>
Easting	<u>506772.7195</u>
Date	<u>12/16/04</u>

I hereby certify that this United States public land survey monument record is correct and complete to the best of my knowledge and belief.

Larry D. Hoium Date 11/07/08
 _____, Anoka County Surveyor
 Minnesota License Number 18165

CERTIFICATE OF LOCATION OF GOVERNMENT CORNER

County of Anoka

State of Minnesota

MEANDER ON
SOUTH LINE Corner of Sec. 13 Township 30 Range 24


I hereby certify that on the 4 day of JAN., 1963, I found the described corner which was evidenced by 3/4" I.P.

and I further certify that to perpetuate the location of said corner, I did, at the exact location thereof, place a permanent marker consisting of CAST IRON MON. SIGN AND POST ON SOUTH SIDE

which reference or witness monuments are located in the manner following:

N.A.D.	1983	Co-ordinates
County	Project	Co-ordinates
Northing	<u>115864.0476</u>	
Easting	<u>506772.7195</u>	
State Plane Co-ordinates		
Y	_____	
X	_____	
Date	<u>12/16/04</u>	


HEALTH
 CLUB
 TENNIS
 COURTS

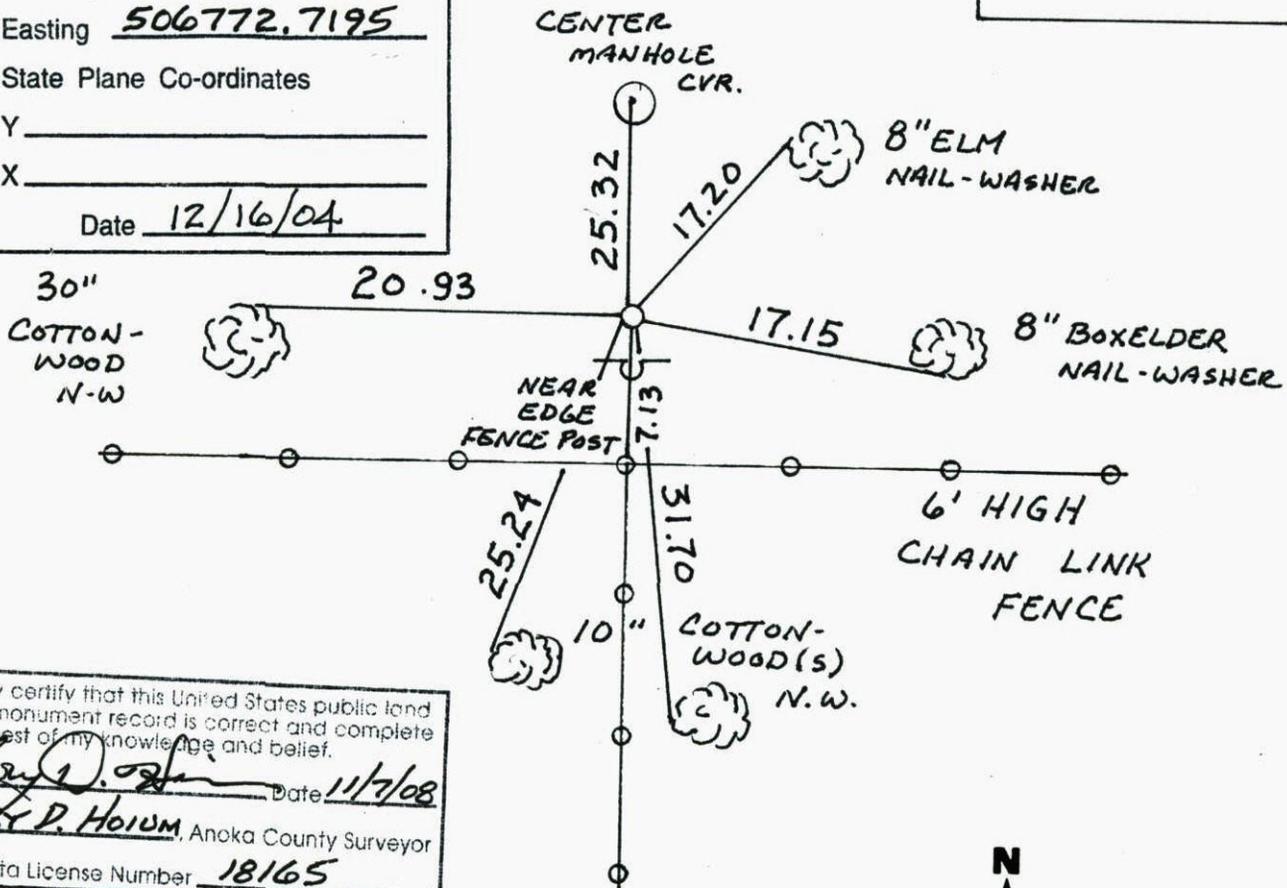

I hereby certify that this United States public land survey monument record is correct and complete to the best of my knowledge and belief.

Larry D. Hoium Date 11/7/08
LARRY D. HOIUM, Anoka County Surveyor
 Minnesota License Number 18165

Revised date	Revised date	Revised date
8-4-89		
8-4-94		
12-8-98		
9-4-08		

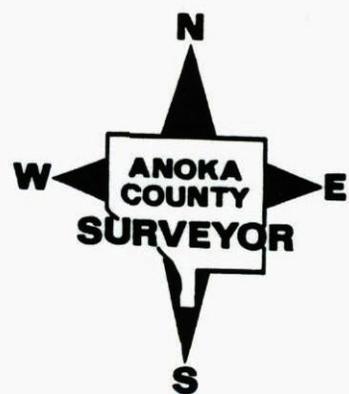

CERTIFICATE OF LOCATION OF GOVERNMENT CORNER

County of Anoka


State of Minnesota

MEANDER
ON SOUTH LINE Corner of Sec. 13 Township 30 Range 24


I hereby certify that on the 4 day of JAN, 19 63, I found the described corner which was evidenced by 3/4" IRON PIPE

and I further certify that to perpetuate the location of said corner, I did, at the exact location thereof, place a permanent marker consisting of CAST IRON MON SIGN & POST SOUTH SIDE

which reference or witness monuments are located in the manner following:

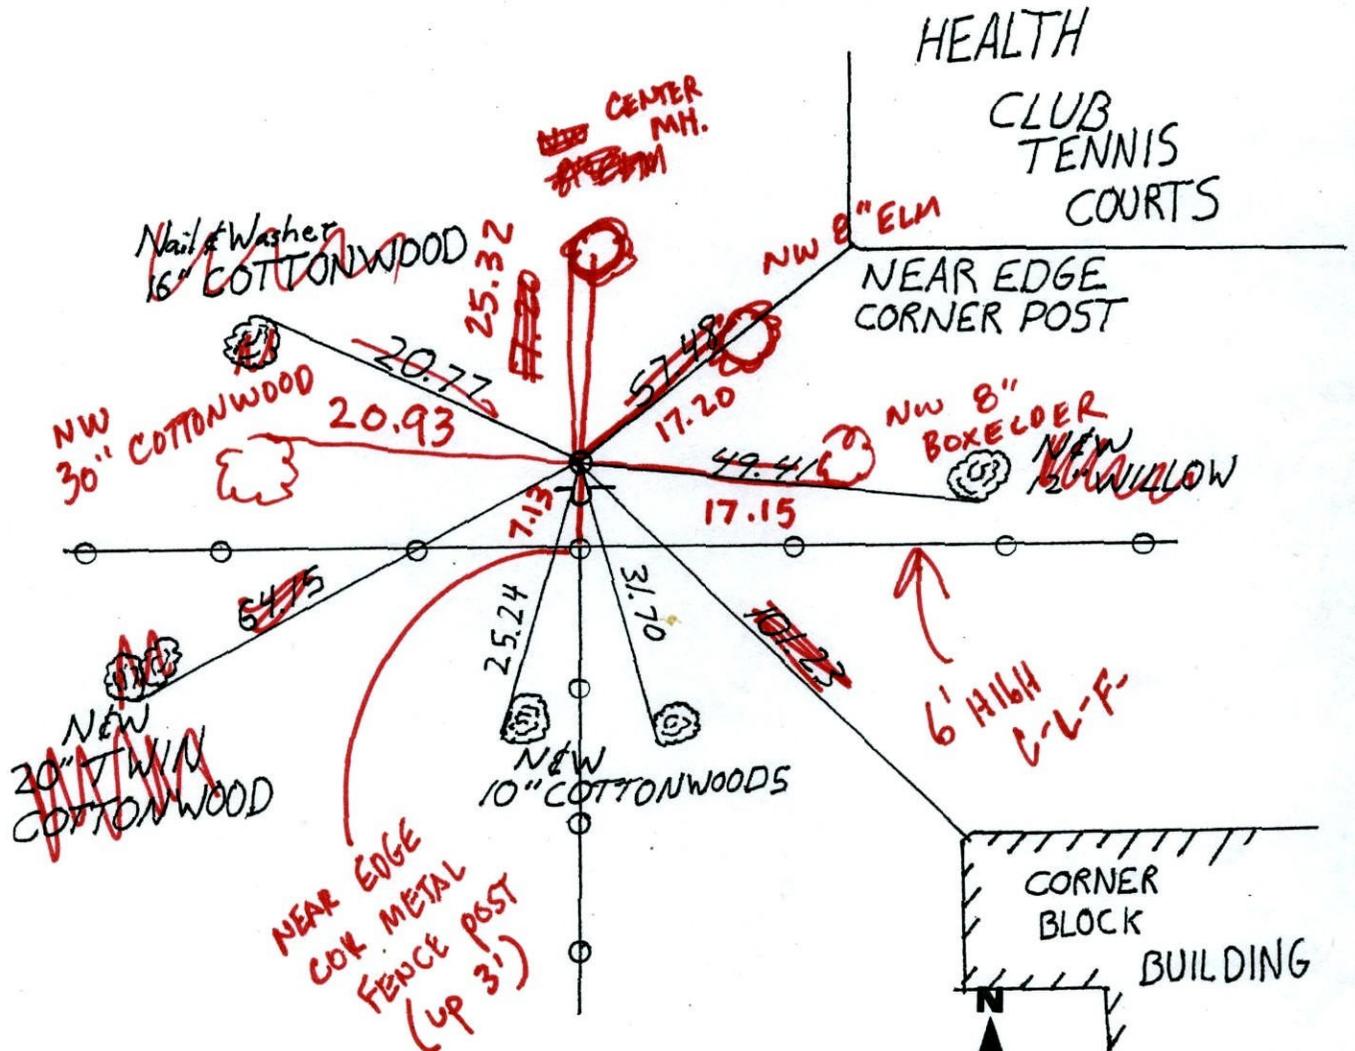

Revised date	Revised date	Revised date
8-4-89		
8-4-94		
12-8-98		
	9.5.08	TAPED

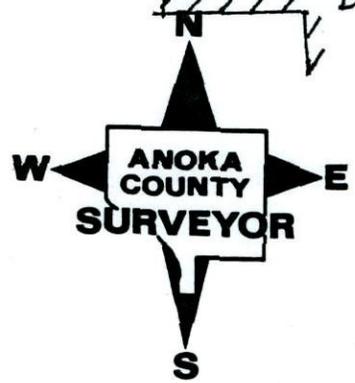


MEANDER
ON SOUTH LINE

pg. 40

Sec. 13 Tw. 30 R. 24

RETRIEVE CAST IRON MONUMENT
SIGN AND POST ON SOUTH SIDE

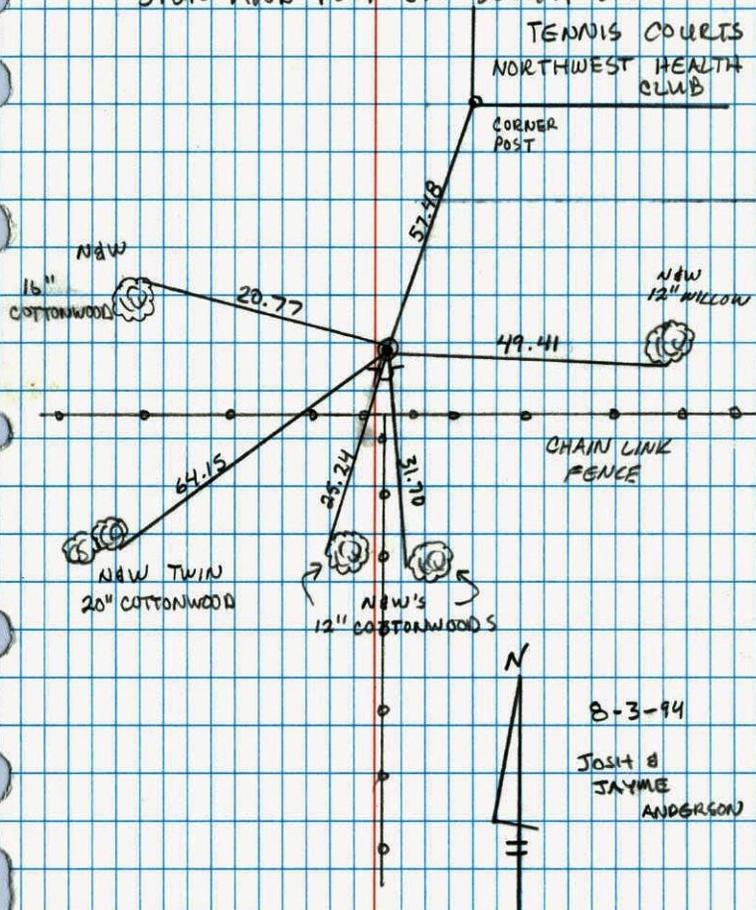

NO. 446


NATIONAL PRINTING

40

Meander Corner on South Line Sec. 13 T30 R24

Retrieved Cast Iron Monument

City Park

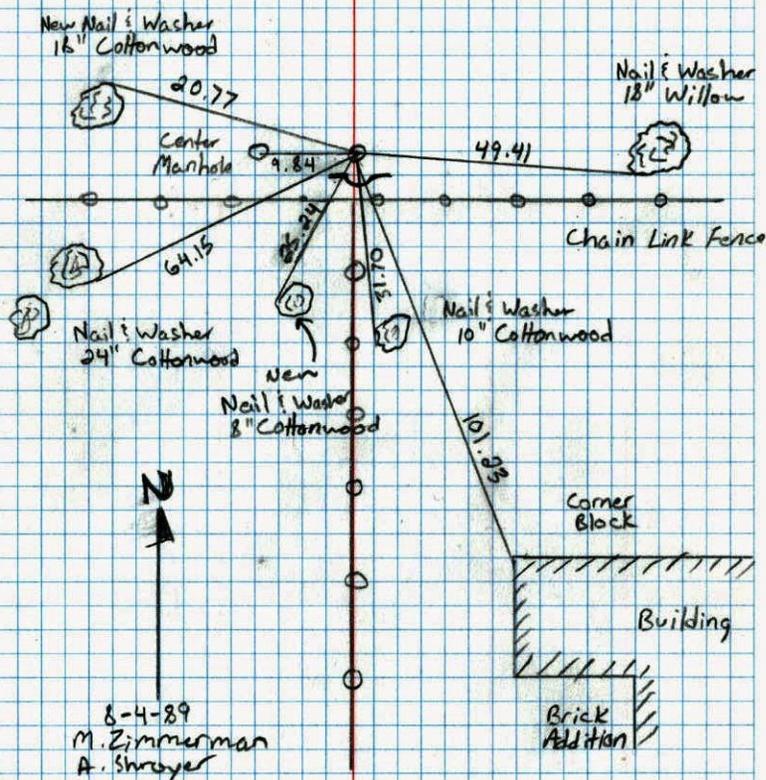


NO. 448

NATIONAL PRINTING

Meander Corner on East Line of Sec. 14 T30 R24

Retied Cast Iron Monument

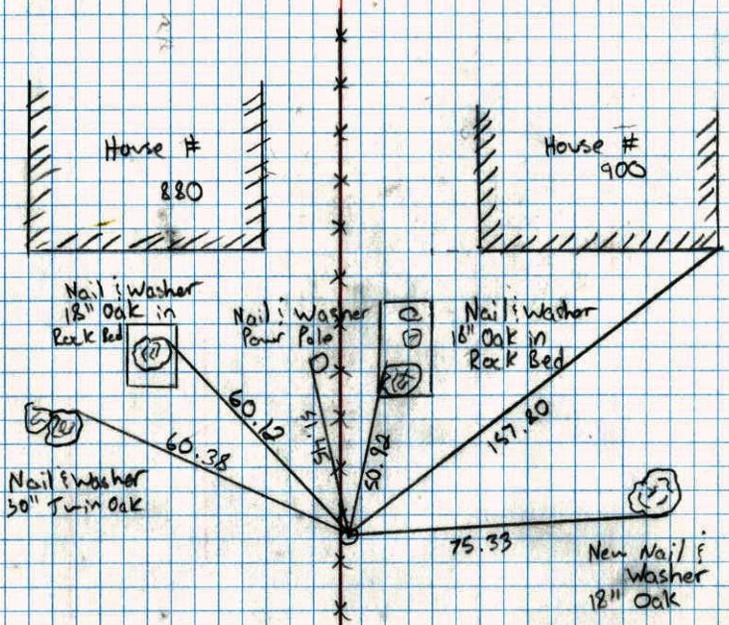

Moore

Lake




7-21-89
M. Zimmerman
A. Shroyer

NO. 448

TELEPHONE

NAC ON SOUTH LINE SEC. 13 T30 R24

RESET CAST IRON MONUMENT FROM CONST.
TIES SIGN + POST ON SOUTH SIDE.

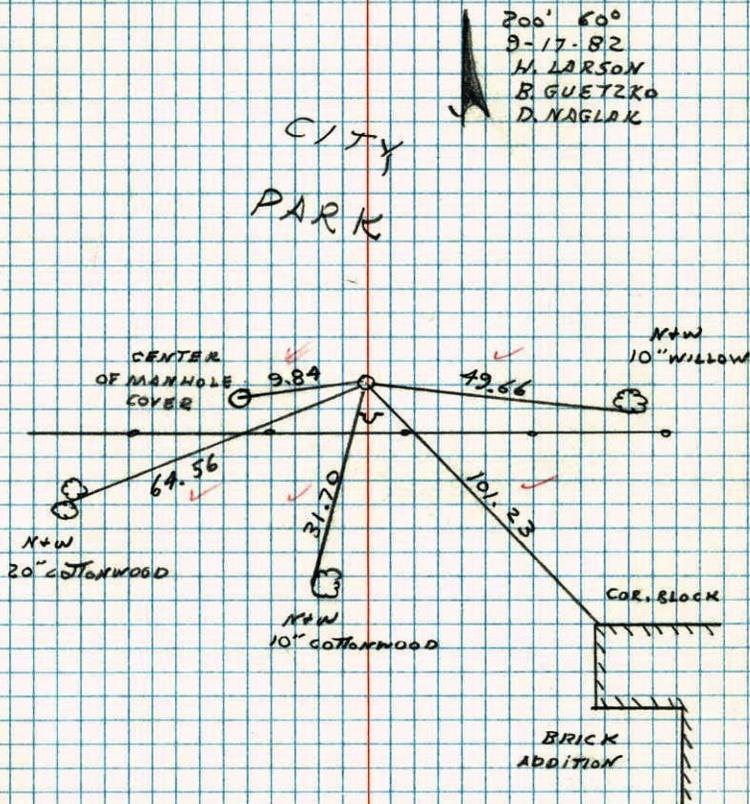

CITY
PARK

200' 60°
9-17-82
H. LARSON
B. GUETZKO
D. NAGLIK

NO. 448

TELEPHONE


M.C. on So. LINE SEC. 13 T30 R24

RETIRED CAST IRON MONUMENT

SET BY D. POWELL IN 1970

NO. 448 TELEPHONE

#3 20°
11-18-81
H. LARSON
B. EVETZKO
D. NYAGLAK

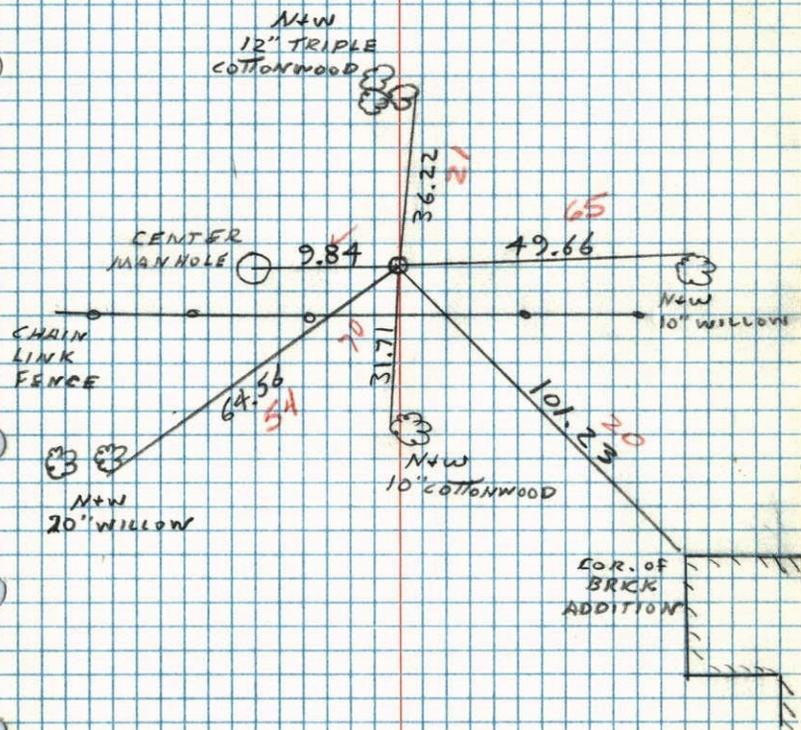

M.C. on So. line Sec. 13, T30, R24


found 3/4" Iron pipe from old Cartwright's
three remaining tie trees. down 0.1±.

Ties fit good.

Concrete Removed because of Sewer construction

Replaced Iron Pipe with Cast Iron Monument Flush.

8/20/70
D. Powell
R. Brien
B. Olson

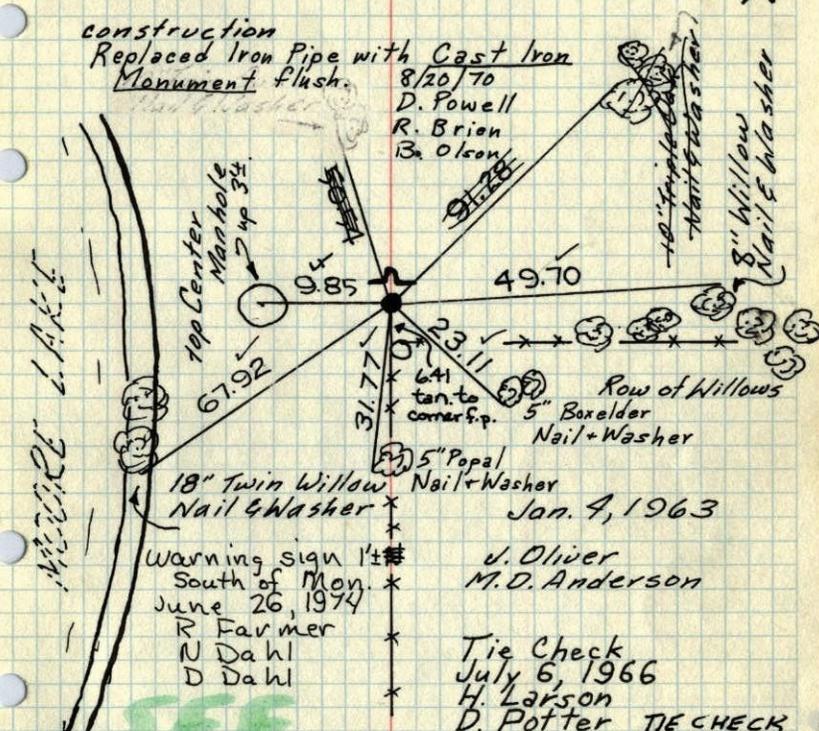

TEMPERATURE CORRECTED
AND HORIZONTALLY
TAPED MEASUREMENTS

Book

Jan. 4, 1963
J. Oliver
M. D. Anderson

Tie Check
July 6, 1966
H. Larson
D. Potter

TIE CHECK
7-24-80
B. STEPHENS
August 1, 1977 P. ROSS
P. SANDERUD P. HORNBY
S. BRIEN
J. STEPHENS

ROLAND W. ANDERSON
COUNTY SURVEYOR
ANOKA COUNTY, MINNESOTA

CERTIFICATE OF LOCATION OF GOVERNMENT CORNER

County of Anoka


State of Minnesota

MEANDER CORNER ON Corner of Sec. 13 Township 30 Range 24
SOUTH LINE

I hereby certify that on the _____ day of _____, 19____, I found the described corner which was evidenced by _____

and I further certify that to perpetuate the location of said corner, I did, at the exact location thereof, place a permanent marker consisting of CAST IRON MONUMENT

which reference or witness monuments are located in the manner following:

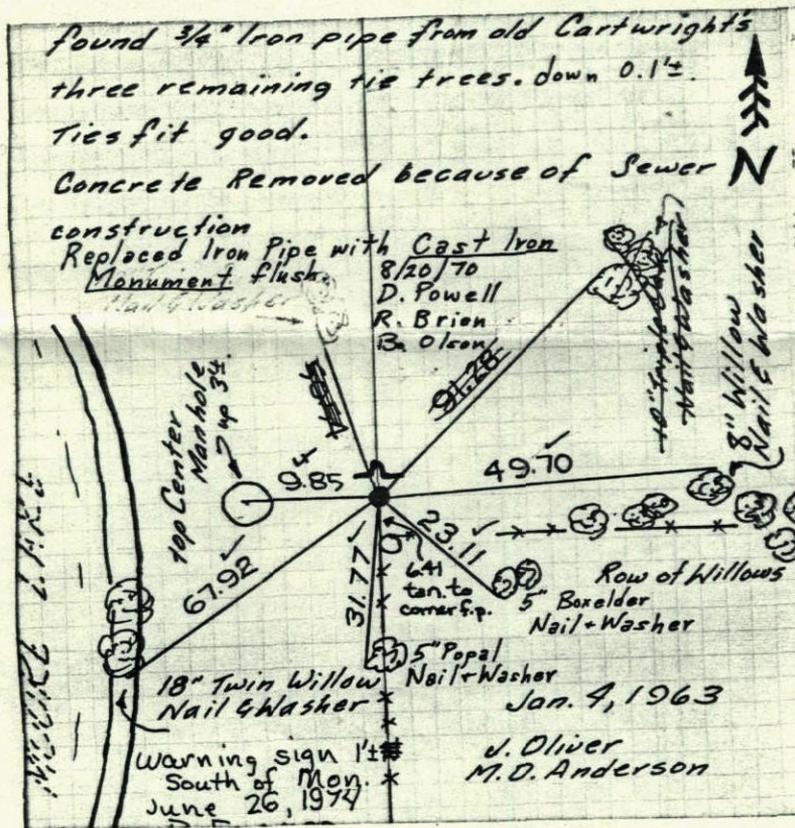

Revised date

By

Minnesota State Plane Coordinates
South Zone

Y _____ X _____

County Surveyor


Date

Registered Land Surveyor No. _____

1970

38

M.C. on So. line Sec. 13, T. 30, R. 24
 found $\frac{3}{4}$ " Iron pipe from old Cartwright's
 three remaining tie trees. down 0.1',
 ties fit good. Replaced I.P. with
 C.I. Mon. flush.
 Concrete Removed because of Sewer
 construction

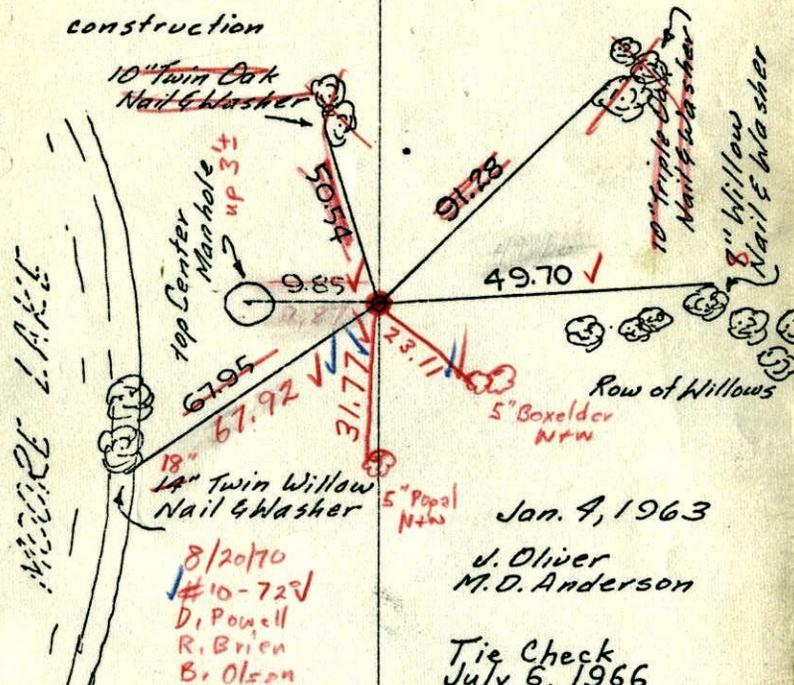

Jan. 4, 1963

J. Oliver
M.D. Anderson


Tie Check
July 6, 1966
H. Larson
D. Potter

TEMPERATURE CORRECTED
AND HORIZONTALLY
TAPED MEASUREMENTS

ROLAND W. ANDERSON
COUNTY SURVEYOR
ANOKA COUNTY, MINNESOTA

1963

M.C. on So. line Sec. 13, T. 30, R. 24
 Found $\frac{3}{4}$ " I.P. from Cartwright's three
 remaining tree ties. Ties Fit Iron
 good. Concrete Removed because of
 Sewer Const.

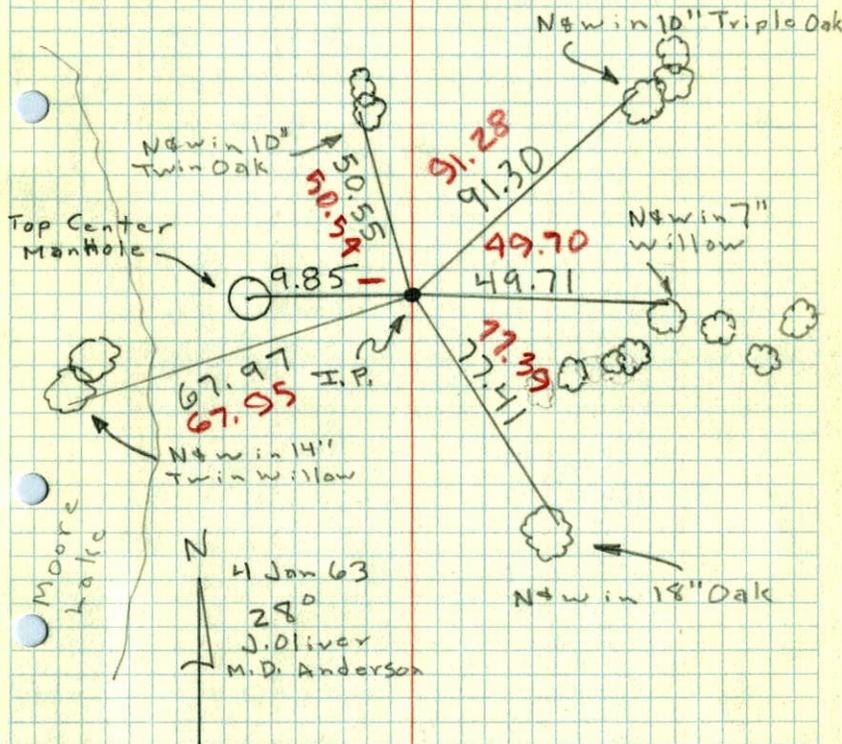

4 Jan 63

28°
J. Oliver
M.D. Anderson

M.C. 5- 1947 ✓
Sec 13, T30, R24

MOORE } 13
LAKE } 24

2/10/47


3" Oak	N 26-25 E	19.2
4" Willow	S 86-40 E	49.3
10" Oak	S 40-50 E	77.0
Tw. Willow	S 76-45 W	68.1
3" Oak	N 11-40 W	18.5

Peter

Moium

M.C. on South line of Sec. 13 T. 30. R. 24 ✓
Concrete Monument

New Tics
in new Tie Book

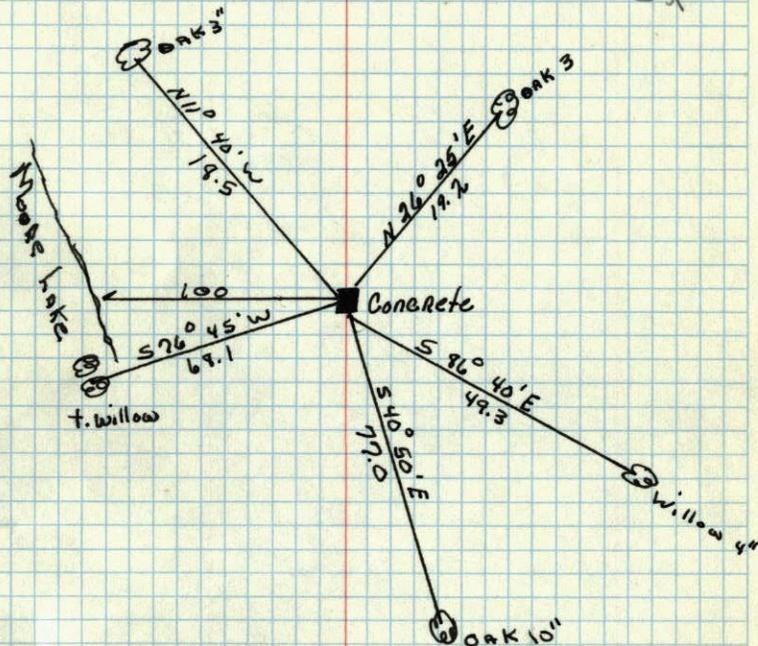

Feb. 10, 1944
Harvey A. Cartwright