

CERTIFICATE OF LOCATION OF GOVERNMENT CORNER

County of Anoka

State of Minnesota


Meander Corner of Sec. 14 Township 30 Range 24
(On east line of section)

On the 2nd day of September, 1960, the described corner was evidenced by a concrete monument

and to perpetuate the location of said corner, at the exact location thereof, a permanent marker was placed consisting of a cast iron monument (DOWN 0.1'±)

AND on the 9th day of October, 2008, said permanent marker was found and the ties were updated

Updated reference ties are as shown below.

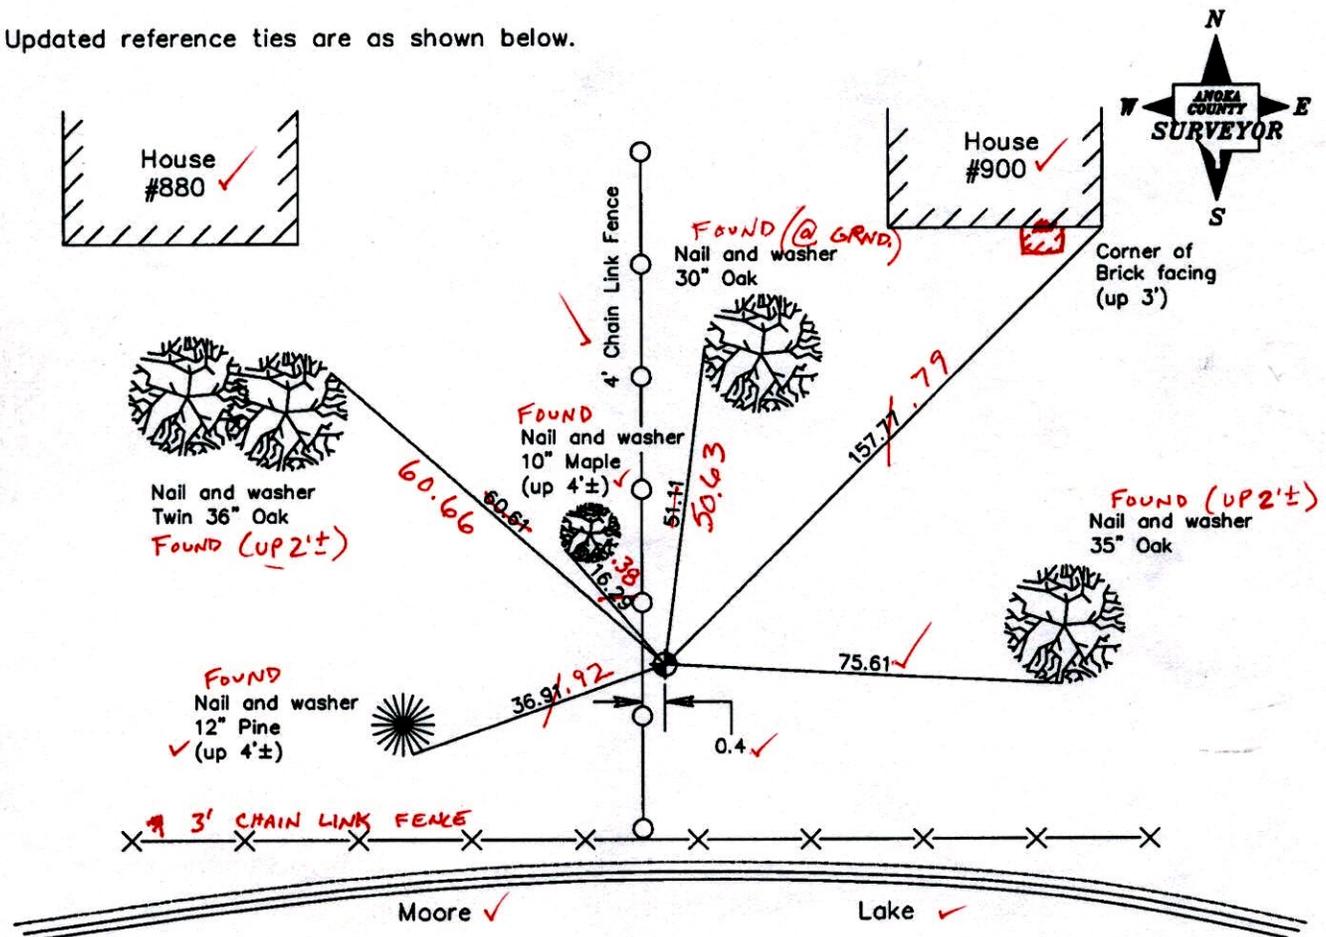

Revised date

7/21/89
7/27/94
10/09/08

N.A.D. 1983 Coordinates
(1996 Adjustment)

County Project Coordinates	
Northing	116377.7050
Easting	504870.1538
Date	6/29/04

I hereby certify that this United States public land survey monument record is correct and complete to the best of my knowledge and belief.

Larry D. Hoium Date 11/07/08
 _____, Anoka County Surveyor
 Minnesota License Number 18165

CERTIFICATE OF LOCATION OF GOVERNMENT CORNER

County of Anoka

State of Minnesota


Meander Corner of Sec. 14 Township 30 Range 24
(On east line of section)

On the 2nd day of September, 1960, the described corner was evidenced by a concrete monument

and to perpetuate the location of said corner, at the exact location thereof, a permanent marker was placed consisting of a cast iron monument

AND on the 9th day of October, 2008, said permanent marker was found and the ties were updated

Updated reference ties are as shown below.

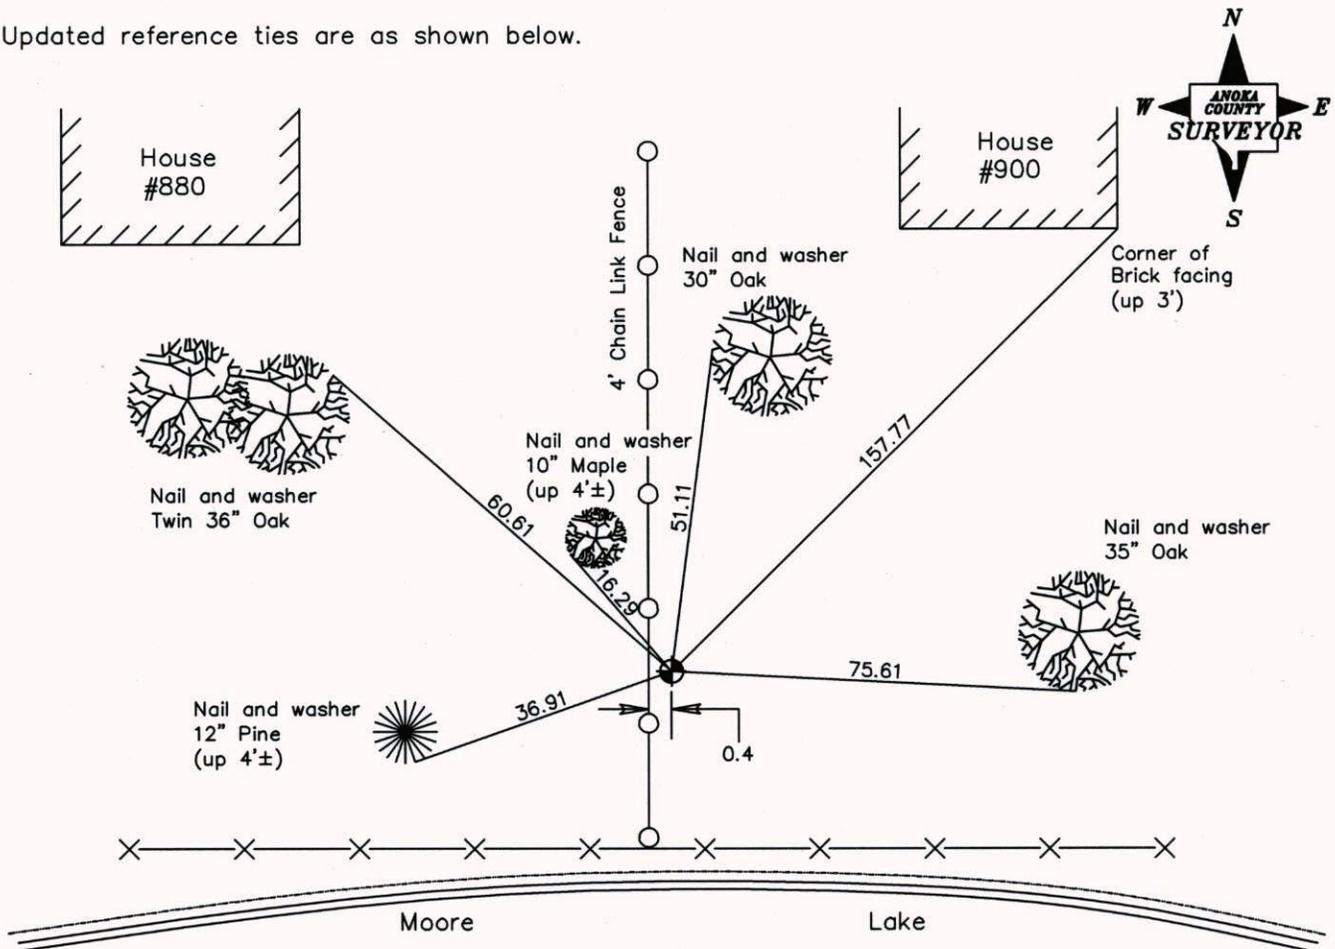

Revised date

7/21/89
7/27/94
10/09/08

N.A.D. 1983 Coordinates
(1996 Adjustment)

County Project Coordinates	
Northing	<u>116377.7050</u>
Easting	<u>504870.1538</u>
Date	<u>6/29/04</u>

I hereby certify that this United States public land survey monument record is correct and complete to the best of my knowledge and belief.

Larry D. Hoium Date 11/07/08
 Larry D. Hoium, Anoka County Surveyor
 Minnesota License Number 18165

CERTIFICATE OF LOCATION OF GOVERNMENT CORNER

County of Anoka


State of Minnesota

MEANDER COR.
EAST LINE Corner of Sec. 14 Township 30 Range 24

I hereby certify that on the 2 day of SEPT., 1960, I found the described corner which was evidenced by CONC. MON.

and I further certify that to perpetuate the location of said corner, I did, at the exact location thereof, place a permanent marker consisting of CAST IRON MON.

which reference or witness monuments are located in the manner following:

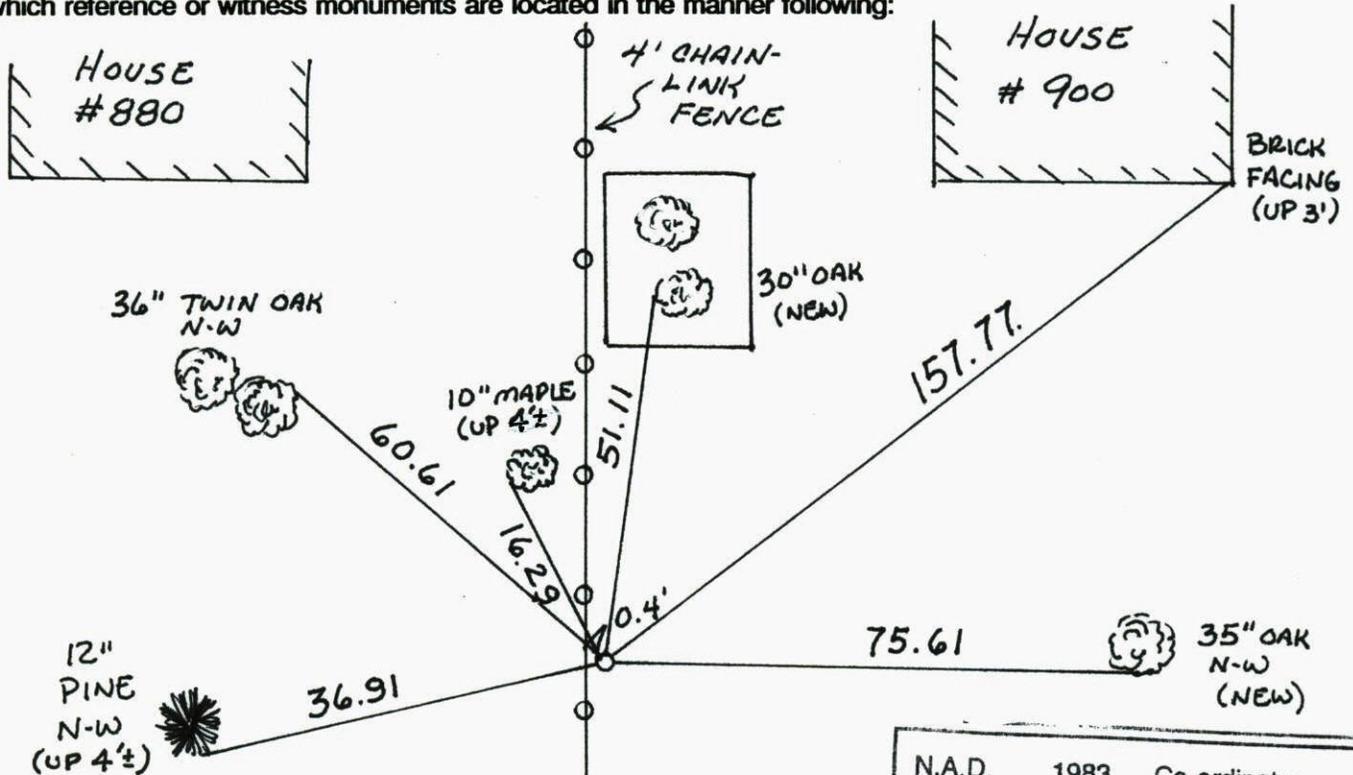


I hereby certify that this United States public land survey monument record is correct and complete to the best of my knowledge and belief.
Larry D. Holm Date 11/7/08
LARRY D. HOLM, Anoka County Surveyor
 Minnesota License Number 18165

N.A.D. 1983 Co-ordinates
 County Project Co-ordinates
 Northing 116377.7050
 Easting 504870.1538
 State Plane Co-ordinates
 Y _____
 X _____
 Date 6/29/04

MOORE LAKE

Revised date	Revised date	Revised date
7-1-86		
7-21-89		
7-27-94		
10-9-08		

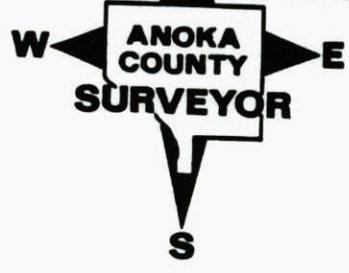

CERTIFICATE OF LOCATION OF GOVERNMENT CORNER

County of Anoka

State of Minnesota

MEANDER CORNER


OF EAST LINE

Corner of Sec. 14 Township 30 Range 24

I hereby certify that on the 2nd day of September, 1960, I found the described corner which was evidenced by CONCRETE MONUMENT


and I further certify that to perpetuate the location of said corner, I did, at the exact location thereof, place a permanent marker consisting of CAST IRON MONUMENT

which reference or witness monuments are located in the manner following:

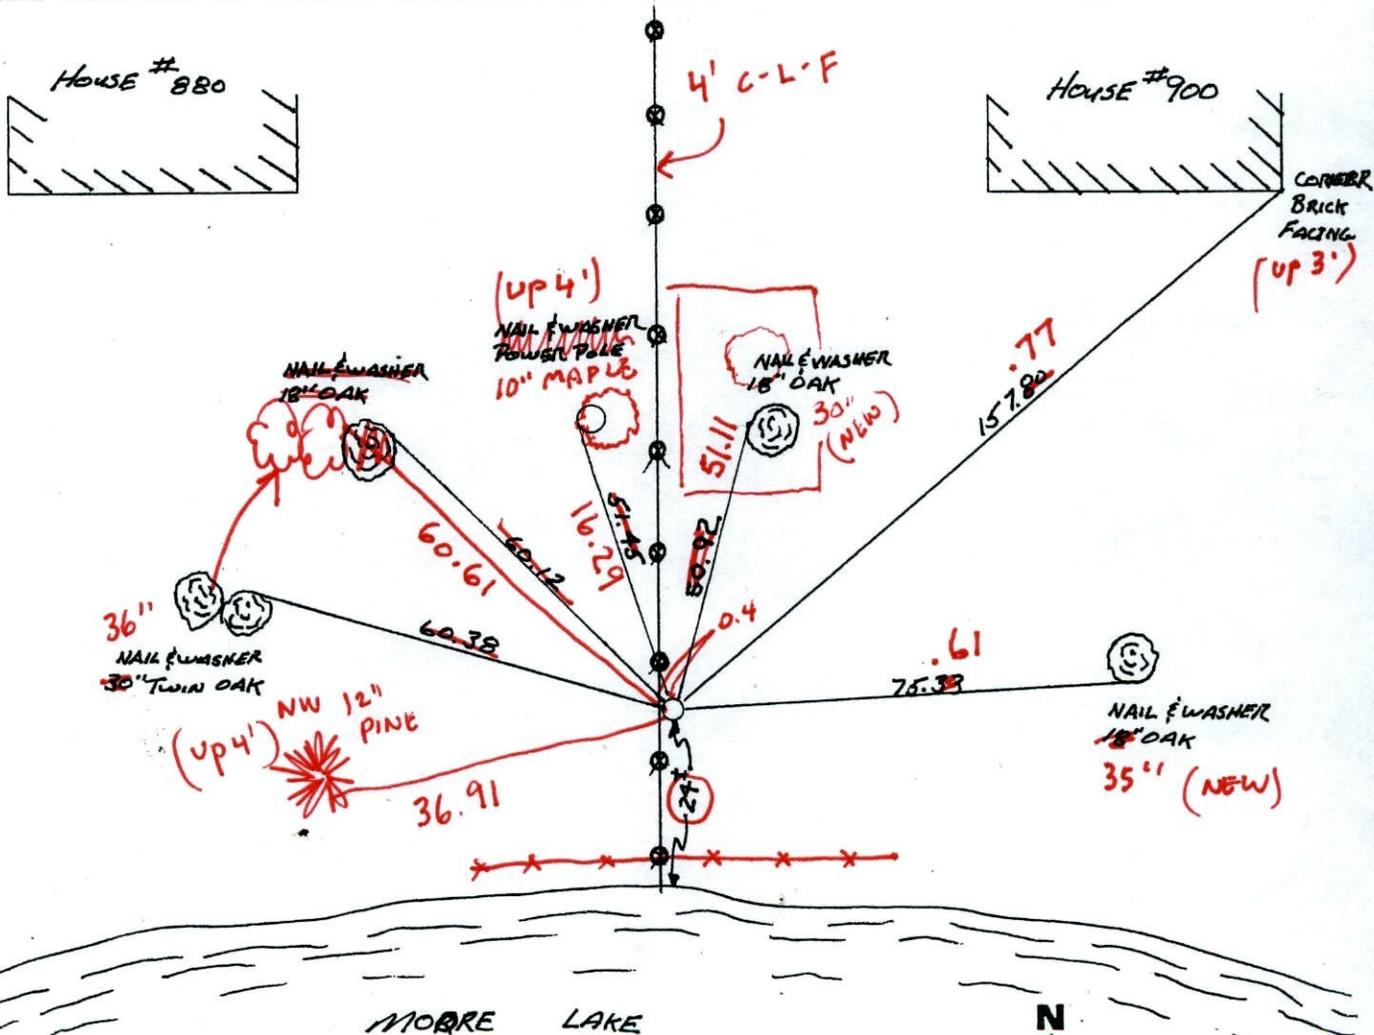

MOORE LAKE


Revised date	Revised date	Revised date
7-1-86		
7-21-89		
7-27-94		
10-9-08	TAPCO	

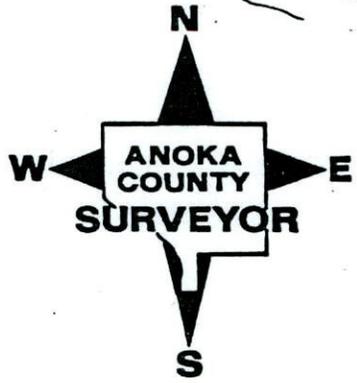

51347.4 M.C. #9 on East 14, T30, R24

1960

West Moore Lake Drive

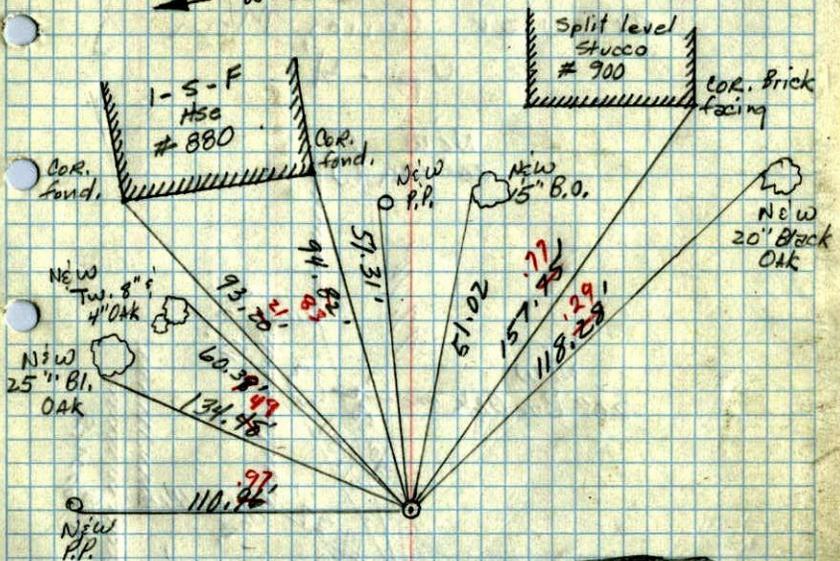

Concrete Monument
Broken & with
Cast Iron Monument
on top and up .5'

9/2/60

Temp 85° TC

Dennis Potter
Randy Carlson

MOORE
LAKE


(OVER)

9/20/60

M.C. #1 on South line 34, T30, R24
Harbor line Mon # 89

1960

circular Concr. Mon
up .4

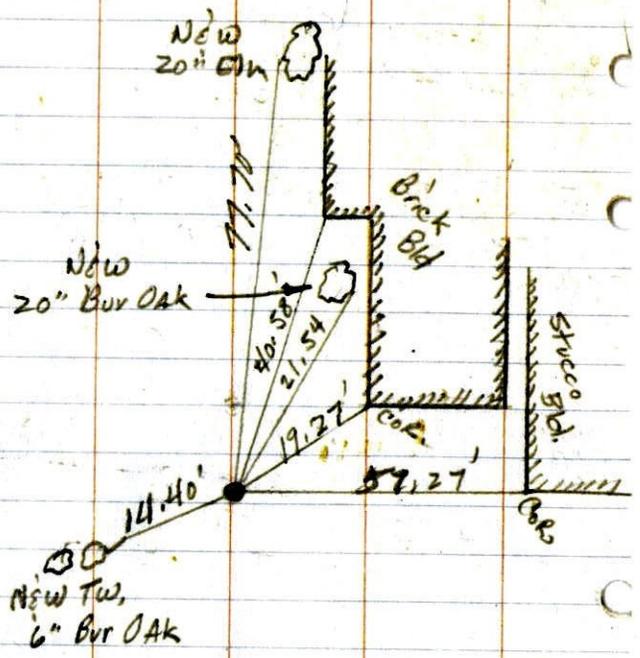

9/15/60

70° TC

Randy Carlson
Dennis Potter

9/20/60

T30, R24

M.C. ~~N. Side~~

MOORE lake

14 | 13

2-10-47 & 6-6-55

12" Oak	N 24-35W	46.8
14" Oak	N 9-50E	50.6
14" Oak	N 48-45E	117.4
14" Oak	N 69-30W	77.1


Retie

1/010m

1955 29A ✓

1947 31 ✓

M.C. on East Line Sec. 14 T. 30. R. 24
Concrete Monument

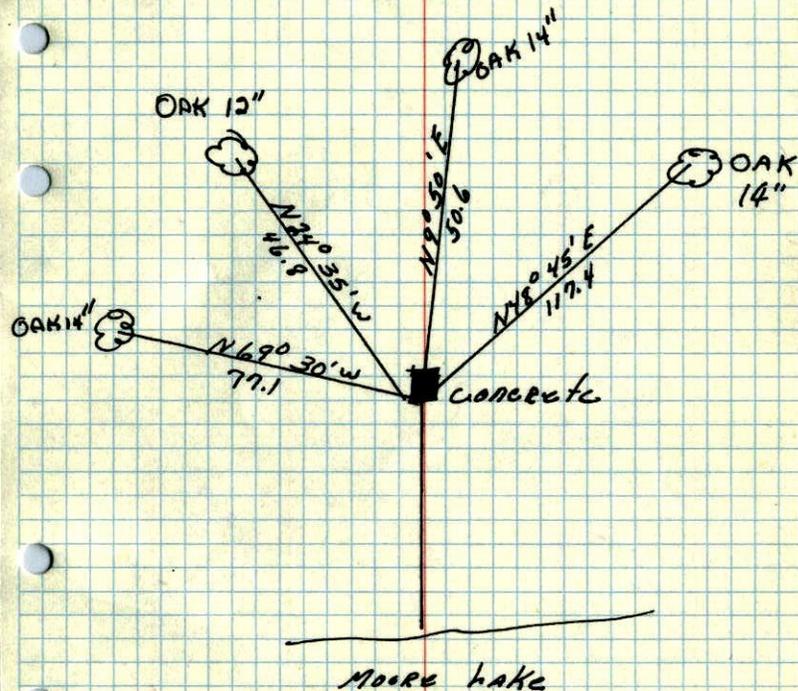

Feb. 10, 1947
Harvey A. Cestwright