CERTIFICATE OF LOCATION OF GOVERNMENT CORNER

County of Anoka State of Minnesota

Meander Corner of Sec. 22 Township 30 Range 24
(Meander Corner No. 4)

On the 15th day of September, 1960, the described corner was evidenced by a concrete monument

and to perpetuate the location of said corner, at the exact location thereof, a permanent marker was placed consisting of a cast iron monument with a sign and post on the north side

AND on the 8th day of September, 2008, said permanent marker was found and the ties were updated

Updated reference ties are as shown below.

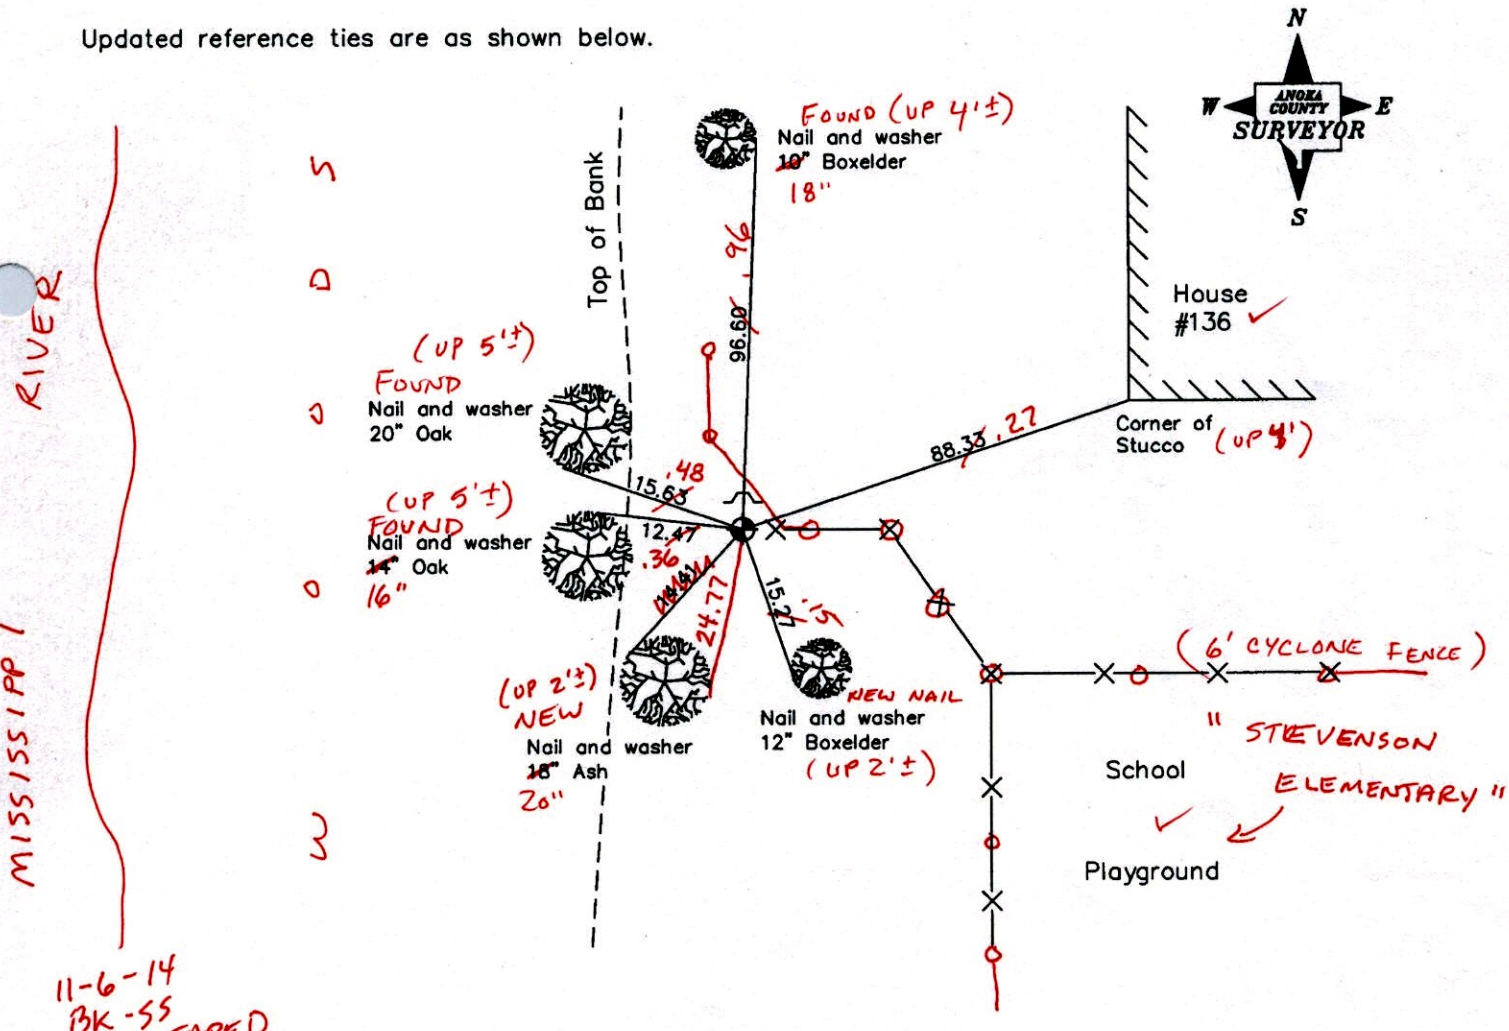

Revised date

7/17/89
8/26/94
9/08/08

N.A.D. 1983 Coordinates
(1996 Adjustment)

County Project Coordinates	
Northing	115918.7057
Easting	497370.4904
Date	12/29/04

I hereby certify that this United States public land survey monument record is correct and complete to the best of my knowledge and belief.

Date 11/17/08

Larry D. Hoium, Anoka County Surveyor

Minnesota License Number 18165

CERTIFICATE OF LOCATION OF GOVERNMENT CORNER

County of Anoka State of Minnesota

Meander Corner of Sec. 22 Township 30 Range 24
(Meander Corner No. 4)

On the 15th day of September, 1960, the described corner was evidenced by a concrete monument

and to perpetuate the location of said corner, at the exact location thereof, a permanent marker was placed consisting of a cast iron monument with a sign and post on the north side

AND on the 8th day of September, 2008, said permanent marker was found and the ties were updated

Updated reference ties are as shown below.

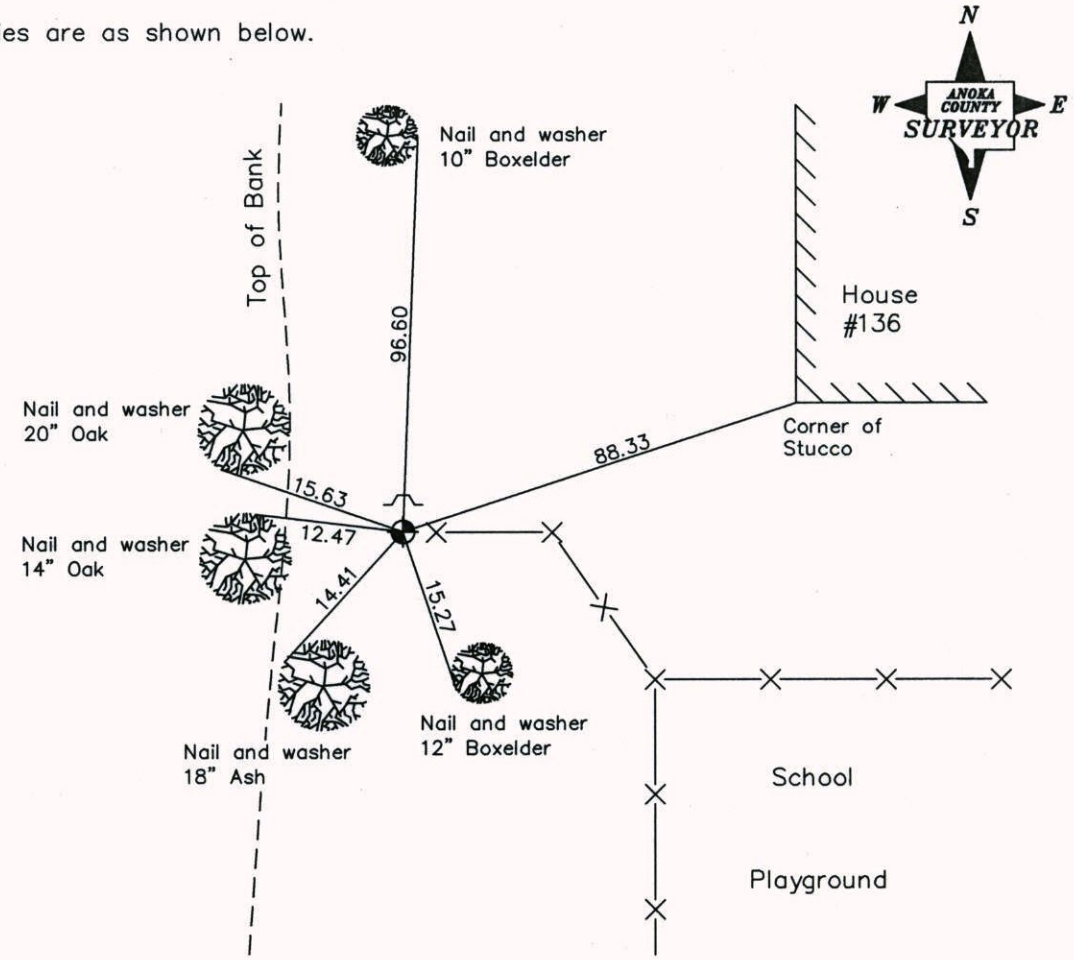

Revised date
7/17/89
8/26/94
9/08/08

N.A.D. 1983 Coordinates
(1996 Adjustment)

County Project Coordinates	
Northing	115918.7057
Easting	497370.4904
Date	12/29/04

I hereby certify that this United States public land survey monument record is correct and complete to the best of my knowledge and belief.

Larry D. Hoium Date 11/17/08

Larry D. Hoium, Anoka County Surveyor

Minnesota License Number 18165

CERTIFICATE OF LOCATION OF GOVERNMENT CORNER

County of Anoka *State of Minnesota*

M.C. # 4 Corner of Sec. 22 Township 30 Range 24

I hereby certify that on the 15 *day of* SEPT. , 19 60, *I found the described corner which was evidenced by* CONCRETE MONUMENT

and I further certify that to perpetuate the location of said corner, I did, at the exact location thereof, place a permanent marker consisting of CAST IRON MONUMENT SIGN AND POST ON NORTH SIDE

which reference or witness monuments are located in the manner following:

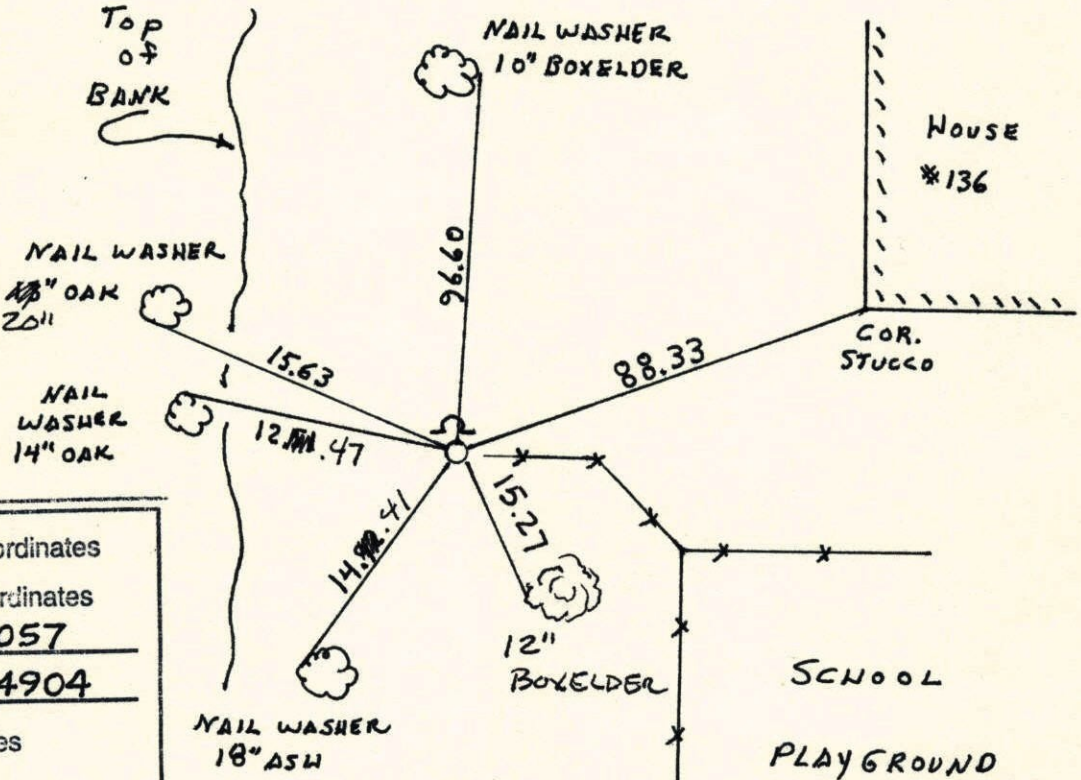

N.A.D. 1983 Co-ordinates
County Project Co-ordinates
Northing 115918.7057
Easting 497370.4904
State Plane Co-ordinates
Y
X
Date 12/29/04

I hereby certify that this United States public land survey monument record is correct and complete to the best of my knowledge and belief.

Larry D. Hoium Date 11/17/08

LARRY D. HOIUM, Anoka County Surveyor

Minnesota License Number 18165

Revised date	Revised date	Revised date
6-26-74	9-8-08	
8-19-70		
8-2-77		
7-21-80		
7-1-86		
7-17-89		
8-26-94		

N
W ANOKA COUNTY SURVEYOR E
S

Page No. 46

CERTIFICATE OF LOCATION OF GOVERNMENT CORNER

County of Anoka *State of Minnesota*

M.C. # 4 Corner of Sec. 22 Township 30 Range 24

I hereby certify that on the 15 *day of* SEPT., 1960, *I found the described corner which was evidenced by* CONCRETE MONUMENT

and I further certify that to perpetuate the location of said corner, I did, at the exact location thereof, place a permanent marker consisting of CAST IRON MONUMENT SIGN AND POST ON NORTH SIDE

which reference or witness monuments are located in the manner following:

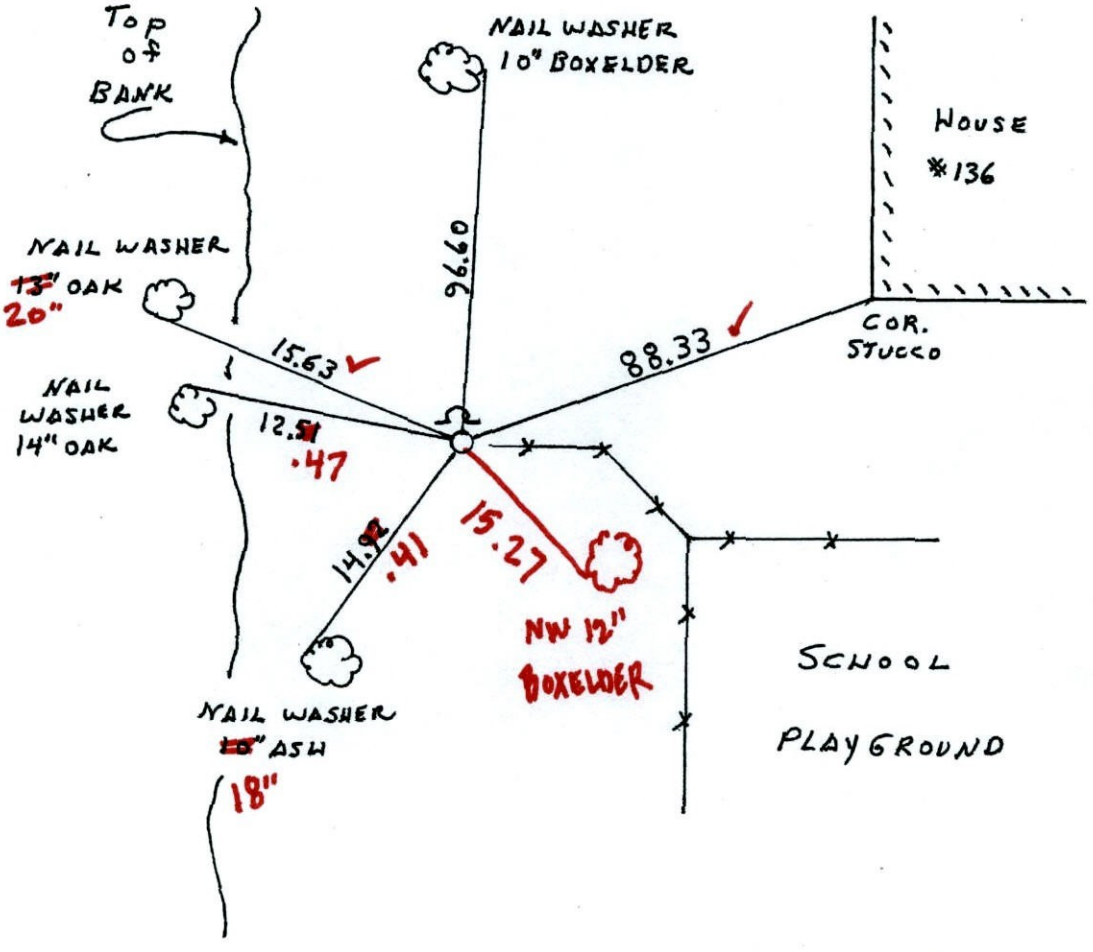

Revised date	Revised date	Revised date
6-26-74		
8-19-70		
8-2-77		9-8-08
7-21-80		
7-1-86		TAPED
7-17-89		
8-26-94		

N
W ANOKA COUNTY SURVEYOR E
S

Meander Corner #4 Sec. 22 T30 R24

Pitted Cast Iron Monument

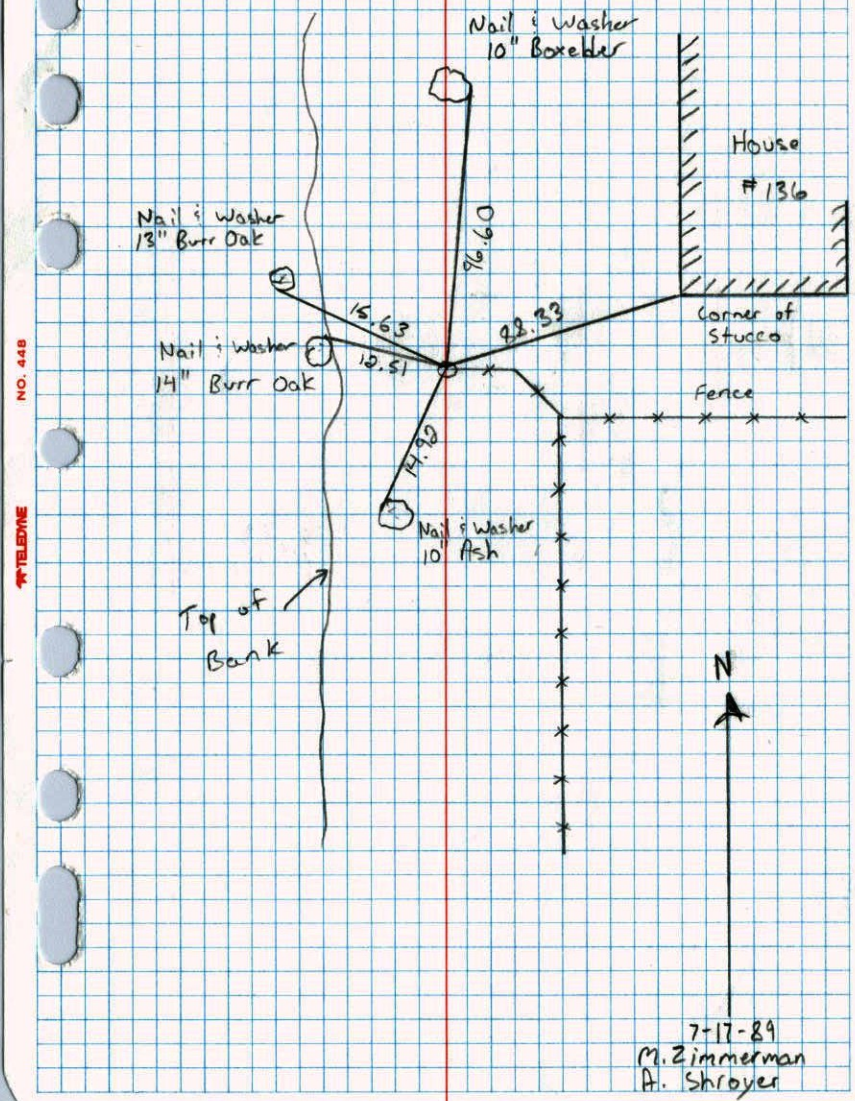

7-17-89
M. Zimmerman
A. Shroyer

TELEDYNE NO. 448

46

MC #4 N. line Sec 22-T30-R24

Conc. Mon., up 0.5'

Set cast Iron mon (up .1'±) warning sign 1'± N

June 26, 1974
R Farmer
N Dahl
D Dahl

Sept 15, 1960
D. Potter
R. Carlson

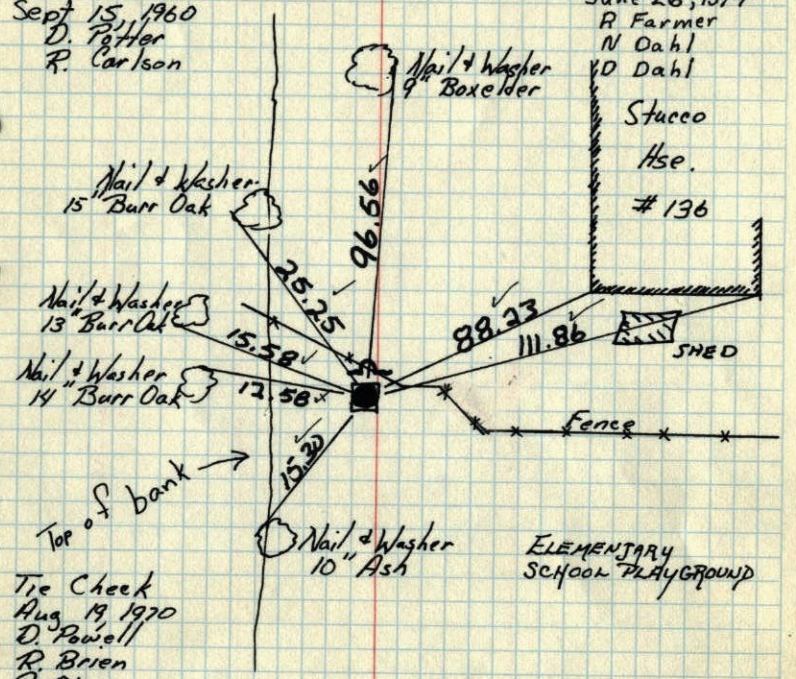

Tie Check
Aug 19 1970
D. Powell
R. Brien
B. Olson

TIE CHECK
AUGUST 2, 1977
K. SANNERUD
S. BRIEN
J. STEPHENS

TIE CHECK
7-21-80
B. STEPHENS
P. ROSS
P. HORNBY

ROLAND W. ANDERSON
COUNTY SURVEYOR
ANOKA COUNTY, MINNESOTA

TEMPERATURE CORRECTED AND HORIZONTALLY TAPED MEASUREMENTS

1966 43

MC #4 N. line Sec 22-T30-R24

Conc. Mon., up 0.5'

New tree

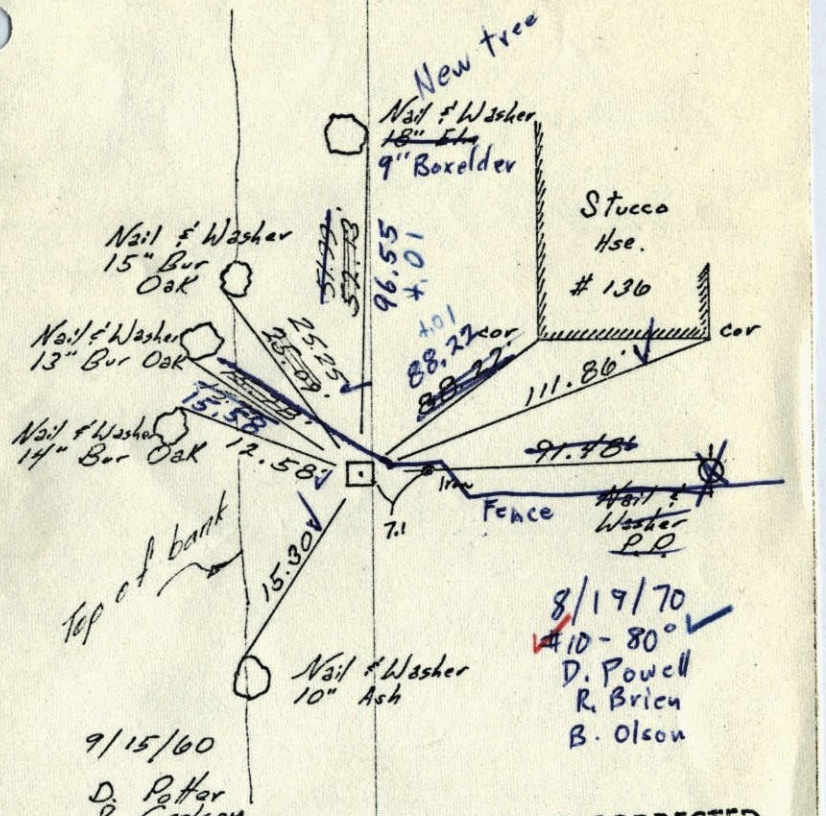

9/15/60
D. Potter
R. Carlson

8/19/70
410 - 80
D. Powell
R. Brien
B. Olson

Tie check
July 29, 1964
M.O. Anderson
R.M. Carlson

Tie Check
June 27, 1966
H. Larson
D. Potter

TEMPERATURE CORRECTED AND HORIZONTALLY TAPED MEASUREMENTS

ROLAND W. ANDERSON
COUNTY SURVEYOR
ANOKA COUNTY, MINNESOTA

1966 43

MC #4 N. line Sec 22-T30-R24

Conc. Mon., up 0.5'

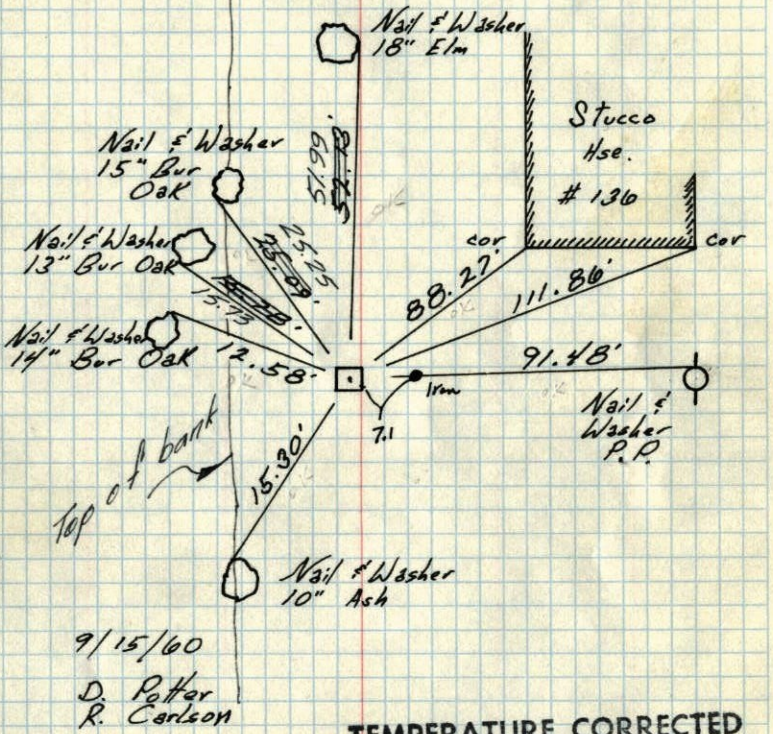

9/15/60
D. Potter
R. Carlson

Tie check
July 29, 1964
M.O. Anderson
R.M. Carlson

Tie Check
June 27, 1966
H. Larson
D. Potter

TEMPERATURE CORRECTED
AND HORIZONTALLY
TAPED MEASUREMENTS

ROLAND W. ANDERSON
COUNTY SURVEYOR
ANOKA COUNTY, MINNESOTA

M.C. #4 N 8- line Sec 15, 22 T30, R24 1955

CONC. MON.

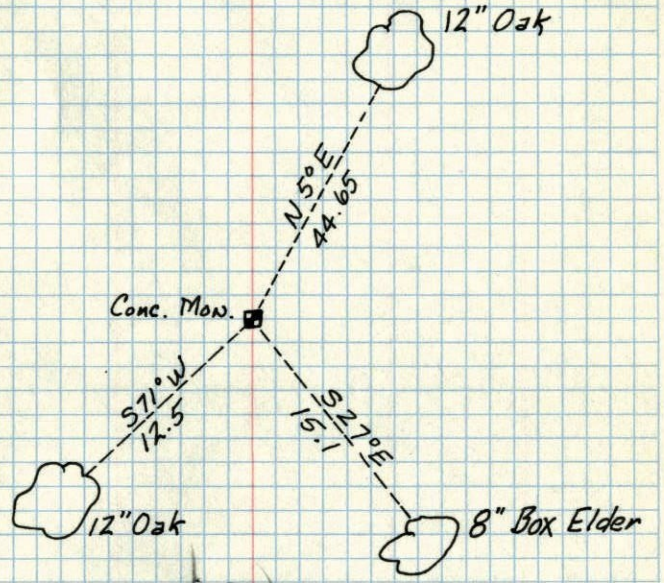

Oct 1955
Caswell Eng. Co.

#4 North
M. Corner ~~South~~ Line Sec. 15, Township 30 22
Range 24. & Mississippi River
by DONN E. PEPPER
Caswell Engineering Co.
found October 1955 (flush)

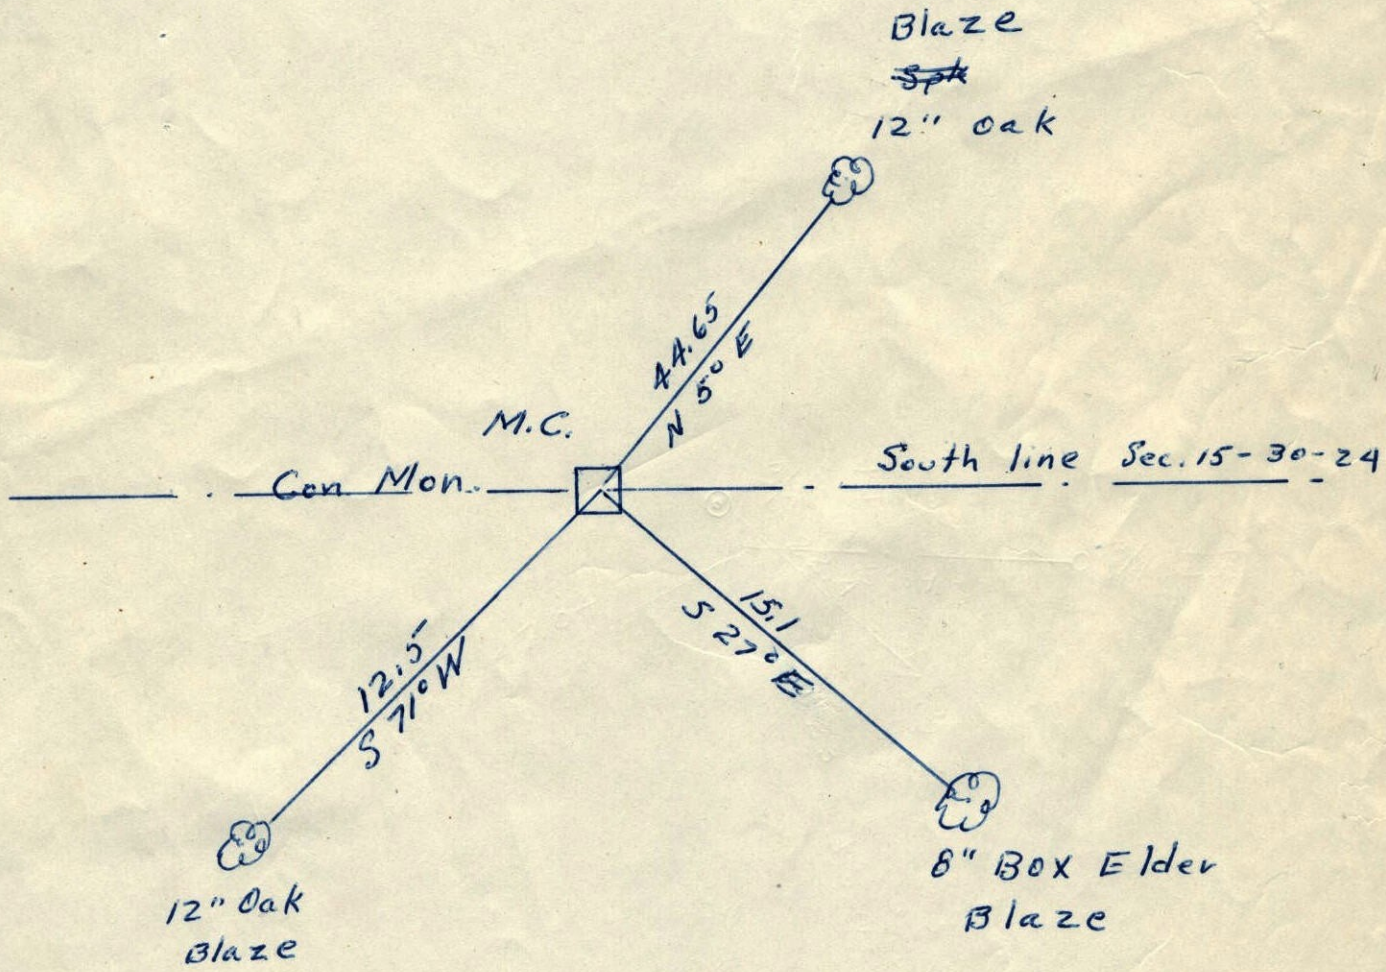

M.C. #4 , T30, R24

~~N~~ line Sec. ~~15~~ 22

1955

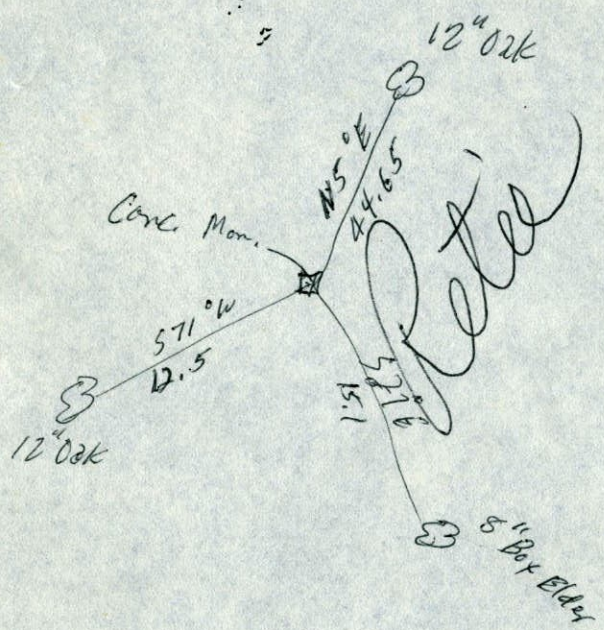

Oct. 1955
Caswell Eng. Co.

1943

35

M.C. corner of N. side of Sec. 22 T30N. R24W.
Concrete Mon. flush

Reties by
Caswell Eng. Co.
Oct 1955 (flush)

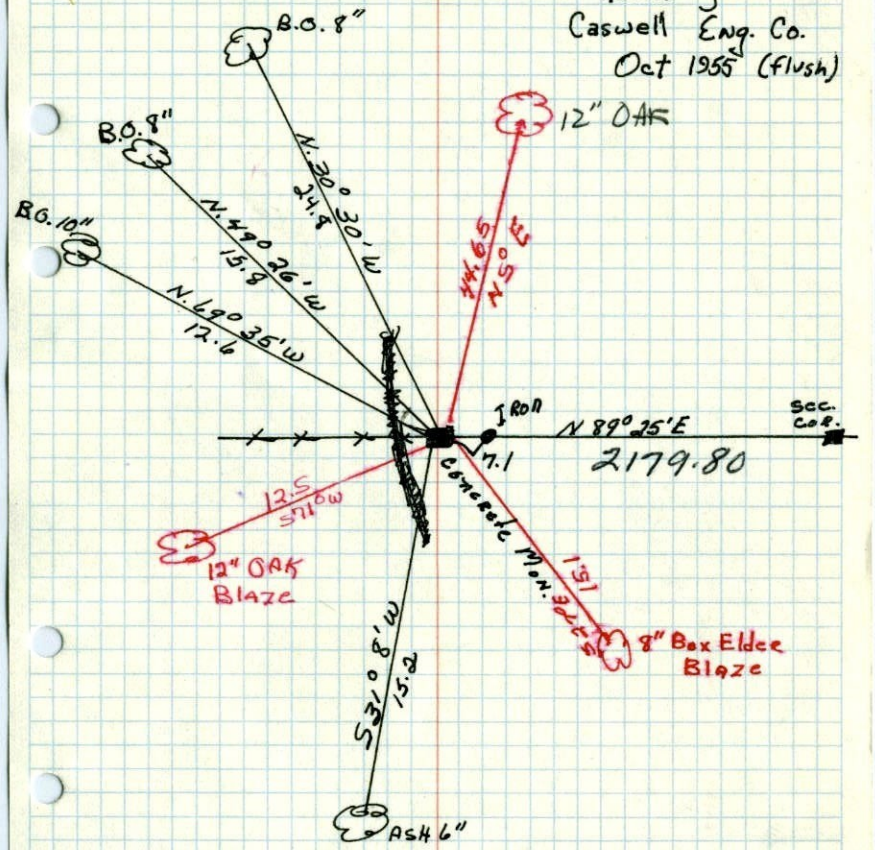

July 12, 1943
Harvey D. Cartwright

N 22 1943 V

M.C.#4 - Sec. 15, T30, R24

15
22

7/12/43

Conc. Mon.

I.P.	N 89-25 E	7.1
NE Sec. Cor.	E	2179.80
10" BO	N 69-35 W	12.6
8" BO	N 30-30 W	24.8
8" BO	N 79-24 W	15.9
6" ~~BO~~ Ash	S 31-8 W	15.2

Reilee

Hoium