Page No. 5

CERTIFICATE OF LOCATION OF GOVERNMENT CORNER

County of Anoka State of Minnesota

North 1/4 Corner of Sec. 2 Township 30 Range 24

On the 28th day of June, 1960, the described corner was evidenced by an iron fence post

and to perpetuate the location of said corner, at the exact location thereof, a permanent marker was placed consisting of a cast iron monument 11-20-14 ~~UNDER BIT.~~ 11-25-14 RAISED

AND on the 15th day of August, 2008, said permanent marker was found and the ties were updated

Updated reference ties are as shown below.

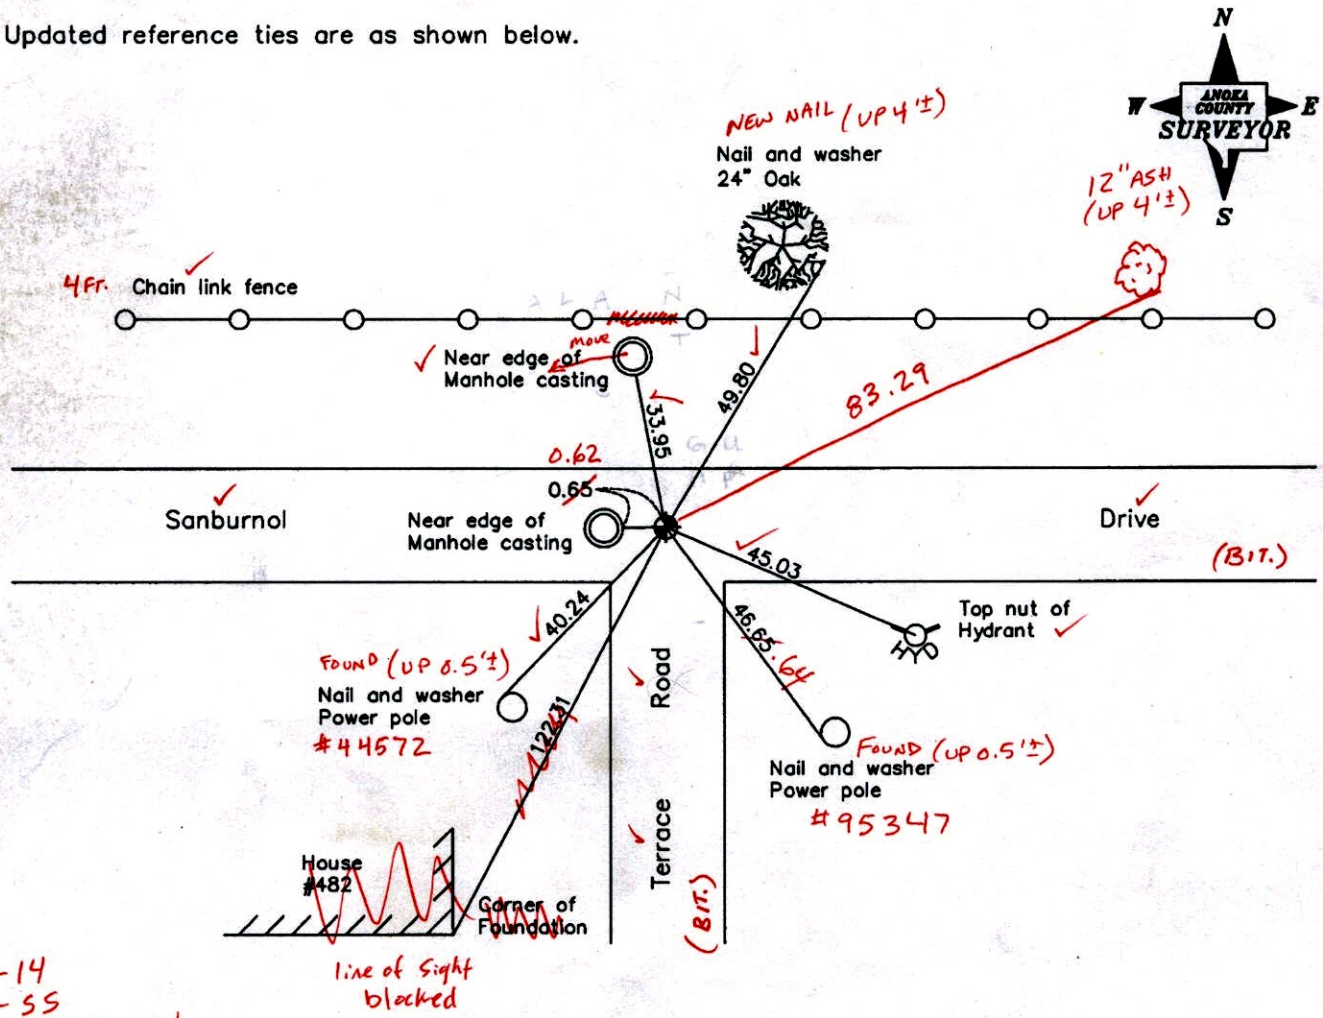

11-25-14
BK-55
TOTAL STATION

Revised date

7/27/94
2/03/00
8/15/08

N.A.D. 1983 Coordinates
(1996 Adjustment)

County Project Coordinates	
Northing	132550.4796
Easting	502067.1466
Date	7/01/04

I hereby certify that this United States public land survey monument record is correct and complete to the best of my knowledge and belief.

Date 11/06/08

Larry D. Hoium, Anoka County Surveyor

Minnesota License Number 18165

CERTIFICATE OF LOCATION OF GOVERNMENT CORNER

County of Anoka State of Minnesota

North 1/4 Corner of Sec. 2 Township 30 Range 24

On the 28th day of June, 1960, the described corner was evidenced by an iron fence post

and to perpetuate the location of said corner, at the exact location thereof, a permanent marker was placed consisting of a cast iron monument

AND on the 15th day of August, 2008, said permanent marker was found and the ties were updated

Updated reference ties are as shown below.

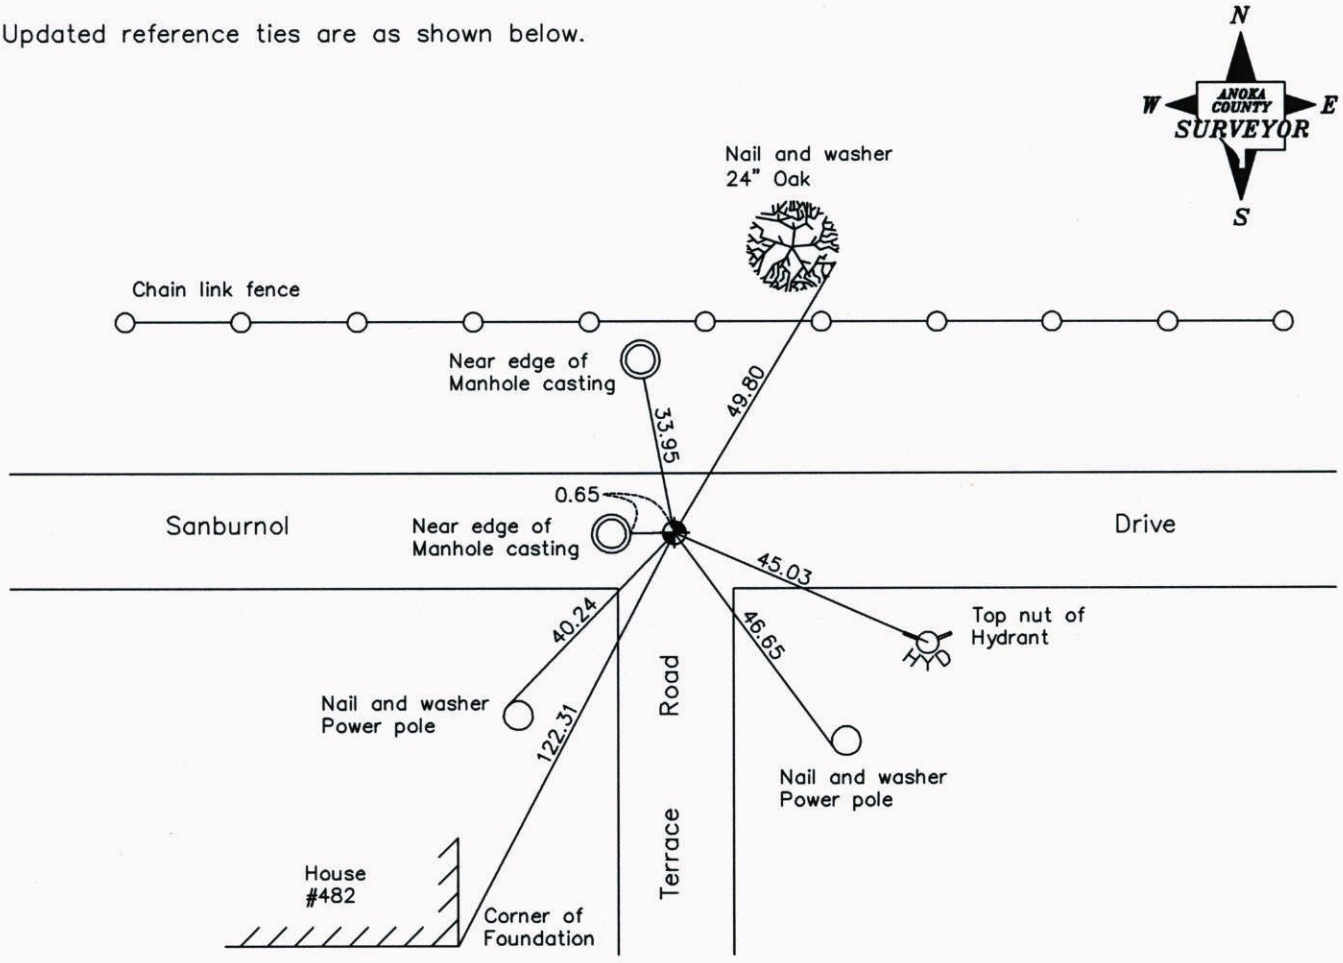

Revised date
7/27/94
2/03/00
8/15/08

N.A.D. 1983 Coordinates
(1996 Adjustment)

County Project Coordinates	
Northing	132550.4796
Easting	502067.1466
Date	7/01/04

I hereby certify that this United States public land survey monument record is correct and complete to the best of my knowledge and belief.

Date 11/06/08

Larry D. Hoium, Anoka County Surveyor

Minnesota License Number 18165

CERTIFICATE OF LOCATION OF GOVERNMENT CORNER

County of Anoka State of Minnesota

NORTH 1/4 Corner of Sec. 2 Township 30 Range 24

I hereby certify that on the 28 day of JUNE, 1960, I found the described corner which was evidenced by IRON FENCE POST

and I further certify that to perpetuate the location of said corner, I did, at the exact location thereof, place a permanent marker consisting of CAST IRON MON'T.

which reference or witness monuments are located in the manner following:

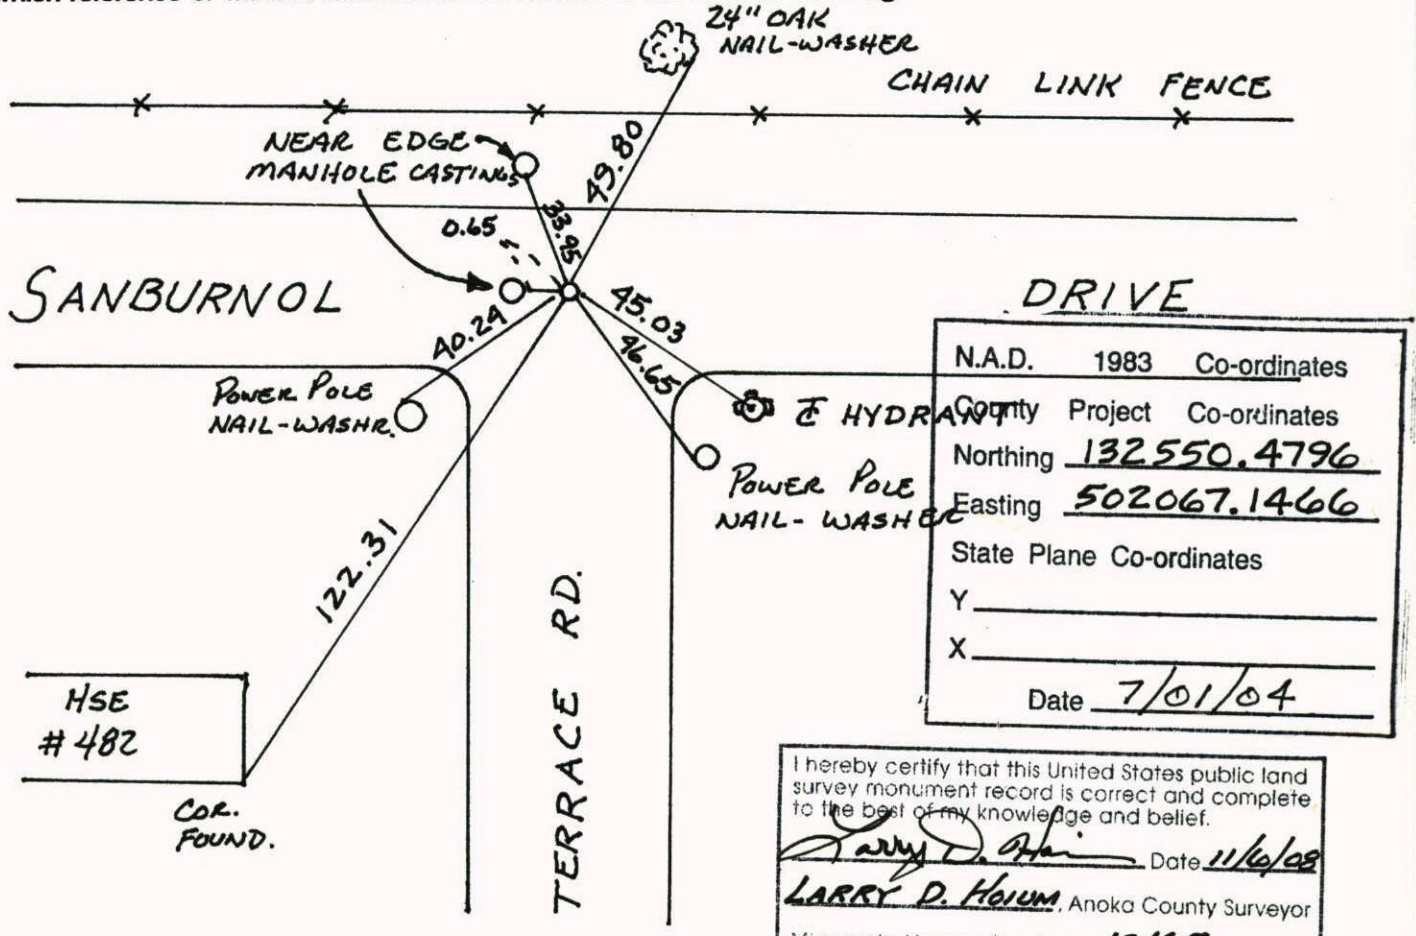

N.A.D. 1983 Co-ordinates

County Project Co-ordinates

Northing 132550.4796

Easting 502067.1466

State Plane Co-ordinates

Y

X

Date 7/01/04

I hereby certify that this United States public land survey monument record is correct and complete to the best of my knowledge and belief.

Larry D. Holum Date 11/6/08

LARRY D. HOLUM, Anoka County Surveyor

Minnesota License Number 18165

Revised date	Revised date	Revised date
6-20-74	8-15-08	
7-27-77		
7-11-80		
6-24-86		
6-27-89		
7-27-94		
2-3-00		

N
W ANOKA COUNTY SURVEYOR E
S

Page No. 5

CERTIFICATE OF LOCATION OF GOVERNMENT CORNER

County of Anoka *State of Minnesota*

NORTH 1/4 Corner of Sec. 2 Township 30 Range 24

I hereby certify that on the 28TH *day of* JUNE, 1960, *I found the described corner which was evidenced by* IRON FENCE POST

and I further certify that to perpetuate the location of said corner, I did, at the exact location thereof, place a permanent marker consisting of CAST IRON MONUMENT

which reference or witness monuments are located in the manner following:

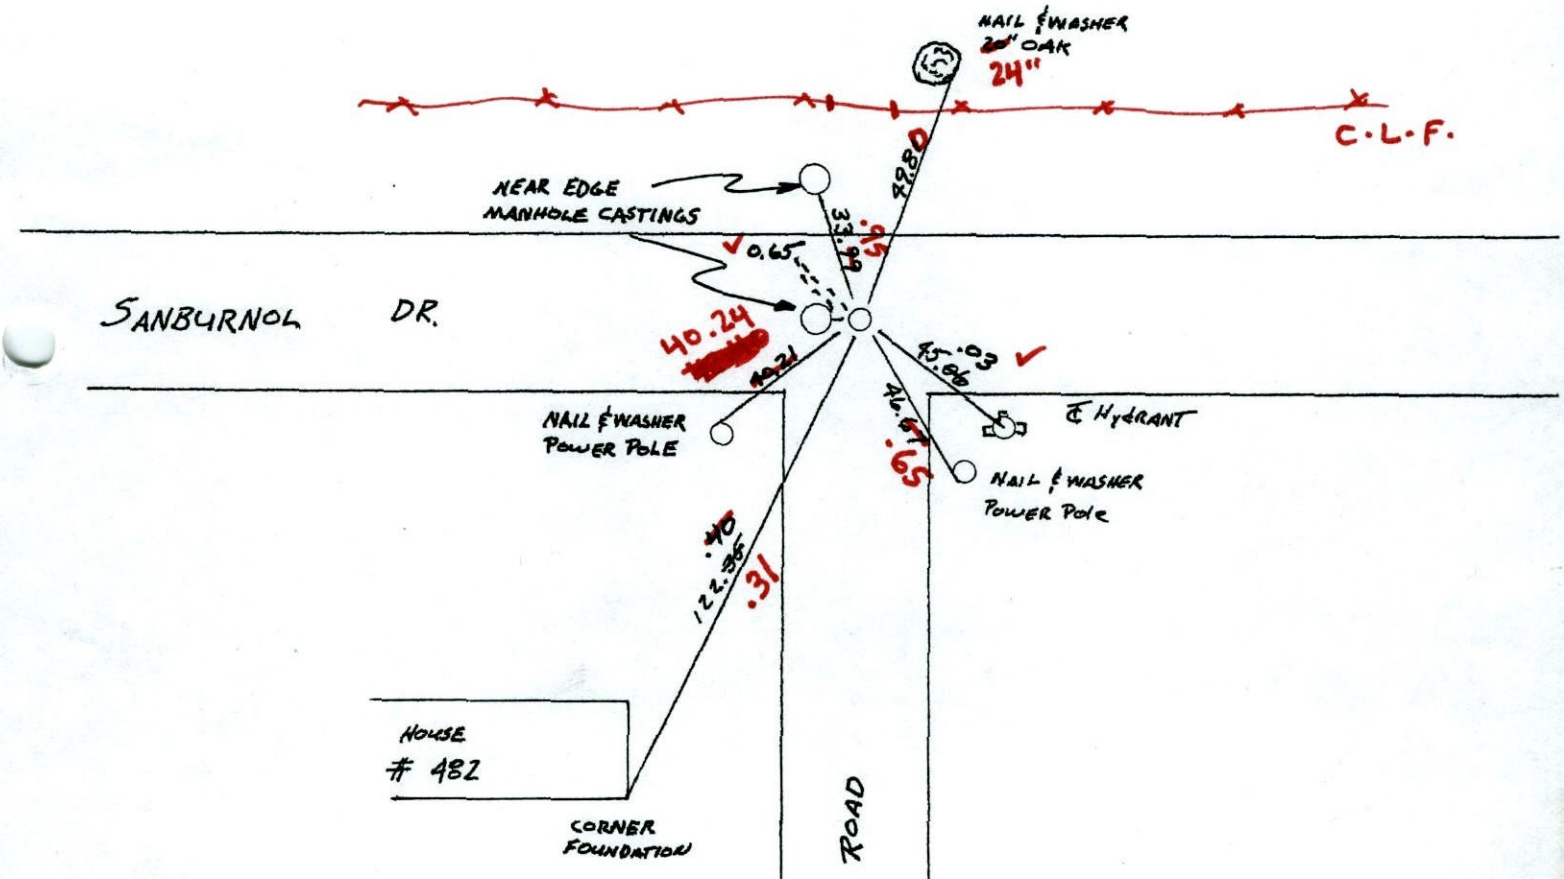

Revised date	Revised date	Revised date
6-20-74	8-15-68	JS AND SS.
7-27-77		
7-11-80		
6-24-86		
6-27-89		
7-27-94		
2-3-00		

N
W ANOKA COUNTY SURVEYOR E
S

NORTH 1/4 CORNER SEC 2 T30 R24

RETIED CAST IRON MONUMENT

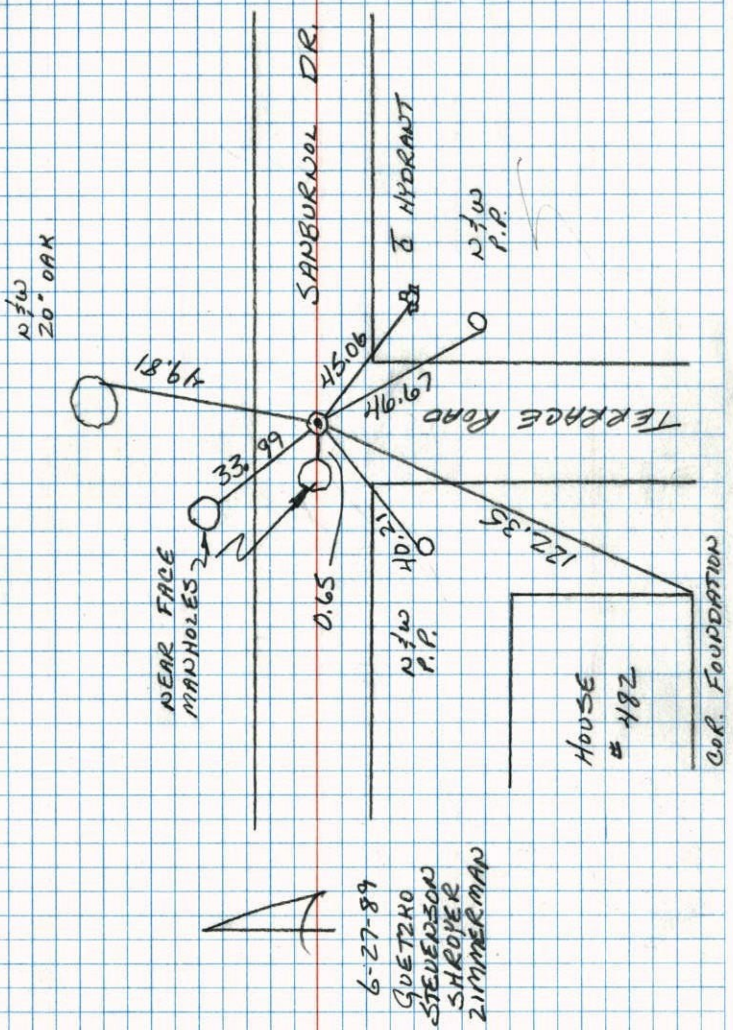

TELEDYNE NO. 448

N 1/4 COR. Sec. 2 T. 30 R. 24

CAST IRON MONU. - IRON FENCE POST ON NORTH SIDE BENT TO EAST. SET P.K.'S 2.0' N. & E.

6-28-60
D. POTTER
R. ROBINSON

TIE CHECK
JUNE 20 1974
R. FARMER
N. DAHL
D. DAHL

NAIL & WASHER 16" BLACK OAK

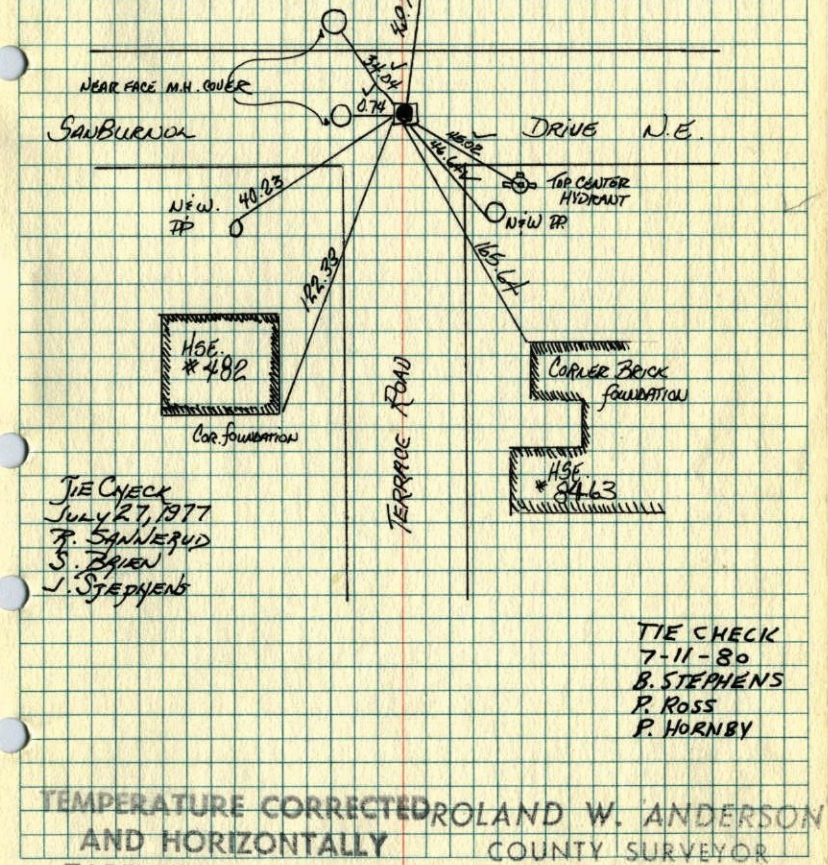

TIE CHECK
JULY 27, 1977
R. SANNERUD
S. BRIEN
J. STEPHENS

TIE CHECK
7-11-80
B. STEPHENS
P. ROSS
P. HORNBY

TEMPERATURE CORRECTED AND HORIZONTALLY TAPED MEASUREMENTS

ROLAND W. ANDERSON
COUNTY SURVEYOR
ANOKA COUNTY, MINNESOTA

1970 5

N¼ Cor. Sec 2, T30, R24

Cast Iron Monument ~~Gone. Mon. down 2'~~
Iron fence post on North side bent to the East.

Retied (All ties good)
May 11, 1964
M.D.A

Set PK's 2.0' N + E

New Nail & Washer 16" Burr Oak

Nail & Washer 19" Burr Oak

Tie Check
July 8, 1966
H. Larson
D. Potter

Nail & Washer Fence Post

~~Nail & Washer P.P.~~

~~Nail & Washer P.P. #7059~~

Near Face of Manhole cover Sanburnol Dr. N.E.

Cast Iron Monument

V5102 ℄ Hydrant

Nail & Washer 4" Burr Oak

N&W P.P.

~~Nail & Washer Tw. 6" B. Oak~~

cor. found

Hse. #482

cor. found

Tie Check
8/14/70
R. Brien
B. Olson

6/28/60
D. Potter
R. Robinson

Terrace Rd.

Cor. Brick facing

Tie check
June 20, 1974
R Farmer
N Dahl
D Dahl

Hse #8463

Placed C.I. Mon June 9, 1966
M.P. Anderson
H.S. Larson All ties O.K.

ROLAND W. ANDERSON
COUNTY SURVEYOR
ANOKA COUNTY, MINNESOTA

TEMPERATURE CORRECTED
AND HORIZONTALLY
TAPED MEASUREMENTS

X

1970 5

N¼ Cor. Sec 2, T30, R24

Cast Iron Monument ~~Gone. Mon. down 2'~~
Iron fence post on North side bent to the East.

Set PK's 2.0' N&E

Retied (All ties good)
May 11, 1964
M.D.A

New

Nail & Washer 19" Burr Oak

Nail & Washer 16" Burr Oak

Tie Check
July 8, 1966
H. Larson
D. Potter

Nail & Washer Fence Post

Nail & Washer P.P.

Nail & Washer P.P. #7059

Manhole

Cast Iron Monument

Sanburnol Dr. N.E.

E of fire hydrant 4502

Nail & Washer 4" Burr Oak

N&W P.P.

Nail & Washer Tw. 6" B. Oak

cor. found

Hse. #482

cor. found

6/28/60
D. Potter
R. Robinson

Terrace Rd.

Cor. Brick facing

Hse #8463

Placed C.I. Mon June 9, 1966
M.P. Anderson
H.S. Larson All ties O.K.

ROLAND W. ANDERSON
COUNTY SURVEYOR
ANOKA COUNTY, MINNESOTA

TEMPERATURE CORRECTED
AND HORIZONTALLY
TAPED MEASUREMENTS

1960

Oct

46790.5 N¼ Sec. 2, T30, R24

In 19.8

Conc. Mon. Down.

Iron fence post on North side bent to the east iron placed over center flush Mon. down 1.8'

46810.3

6/28/60

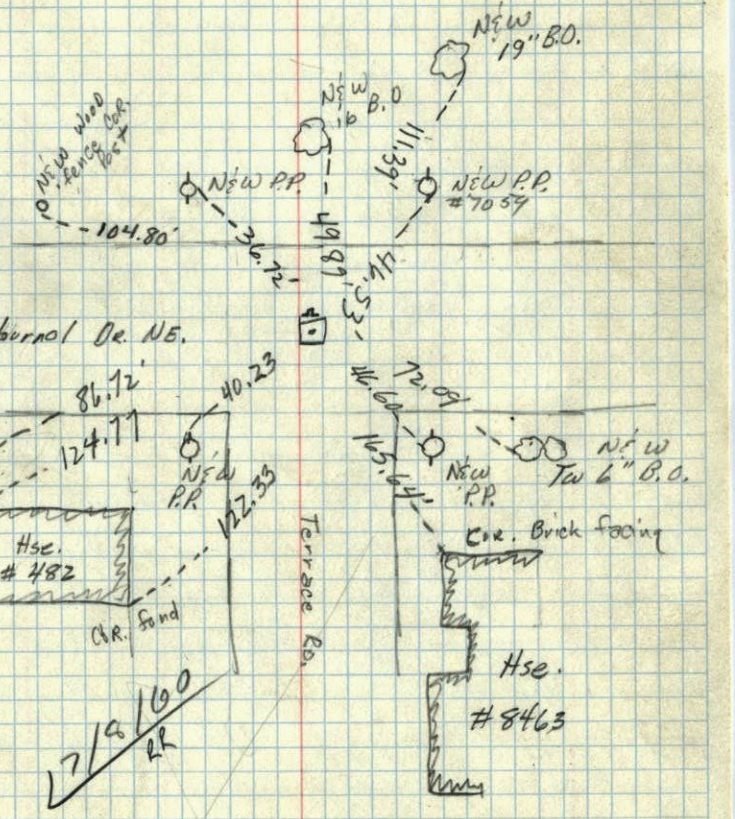

1943 10 ✓

N¼ corner Sec. 2 T. 30 N R24 W

Con. Mon flush

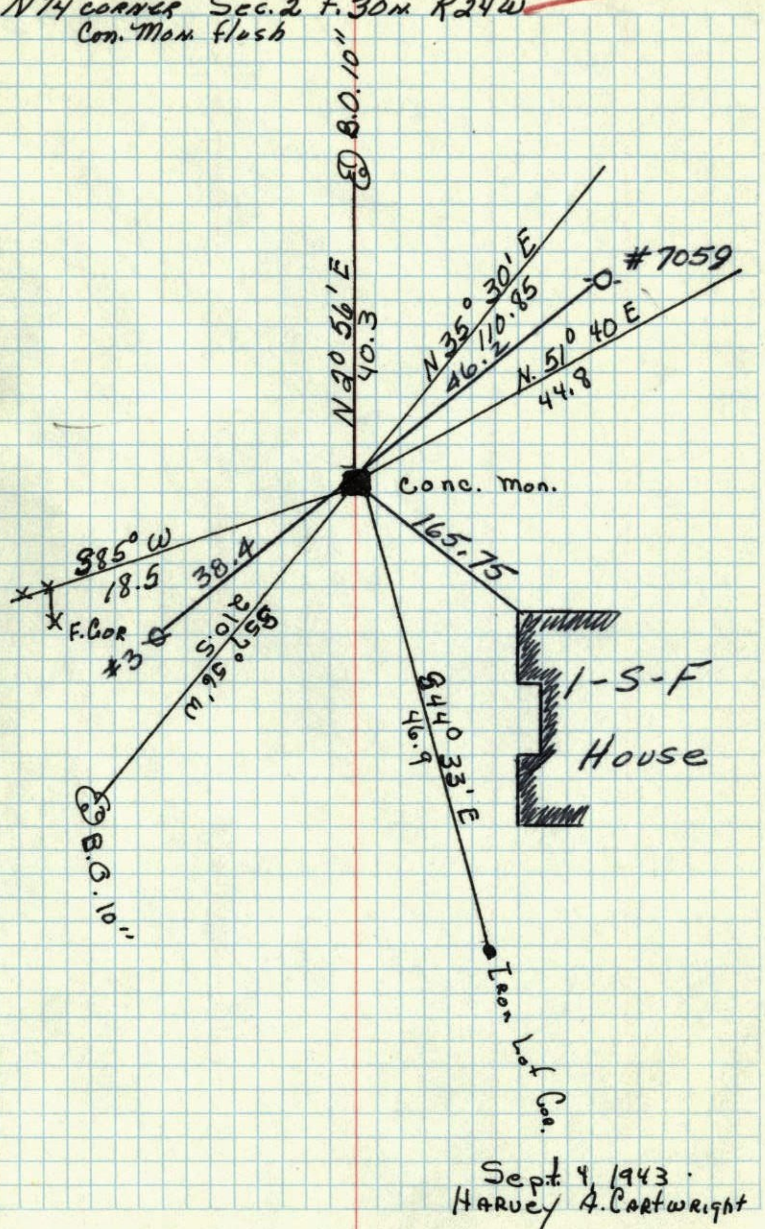

Sept 4, 1943.

Harvey A. Cartwright