Page No. 65

CERTIFICATE OF LOCATION OF GOVERNMENT CORNER

County of Anoka State of Minnesota

North 1/4 Corner of Sec. 36 Township 30 Range 24

On the 11th day of April, 1962, the described corner was evidenced by a 1" iron pipe

and to perpetuate the location of said corner, at the exact location thereof, a permanent marker was placed consisting of a cast iron monument

AND on the 30th day of September, 2008, said permanent marker was found and the ties were updated

Updated reference ties are as shown below.

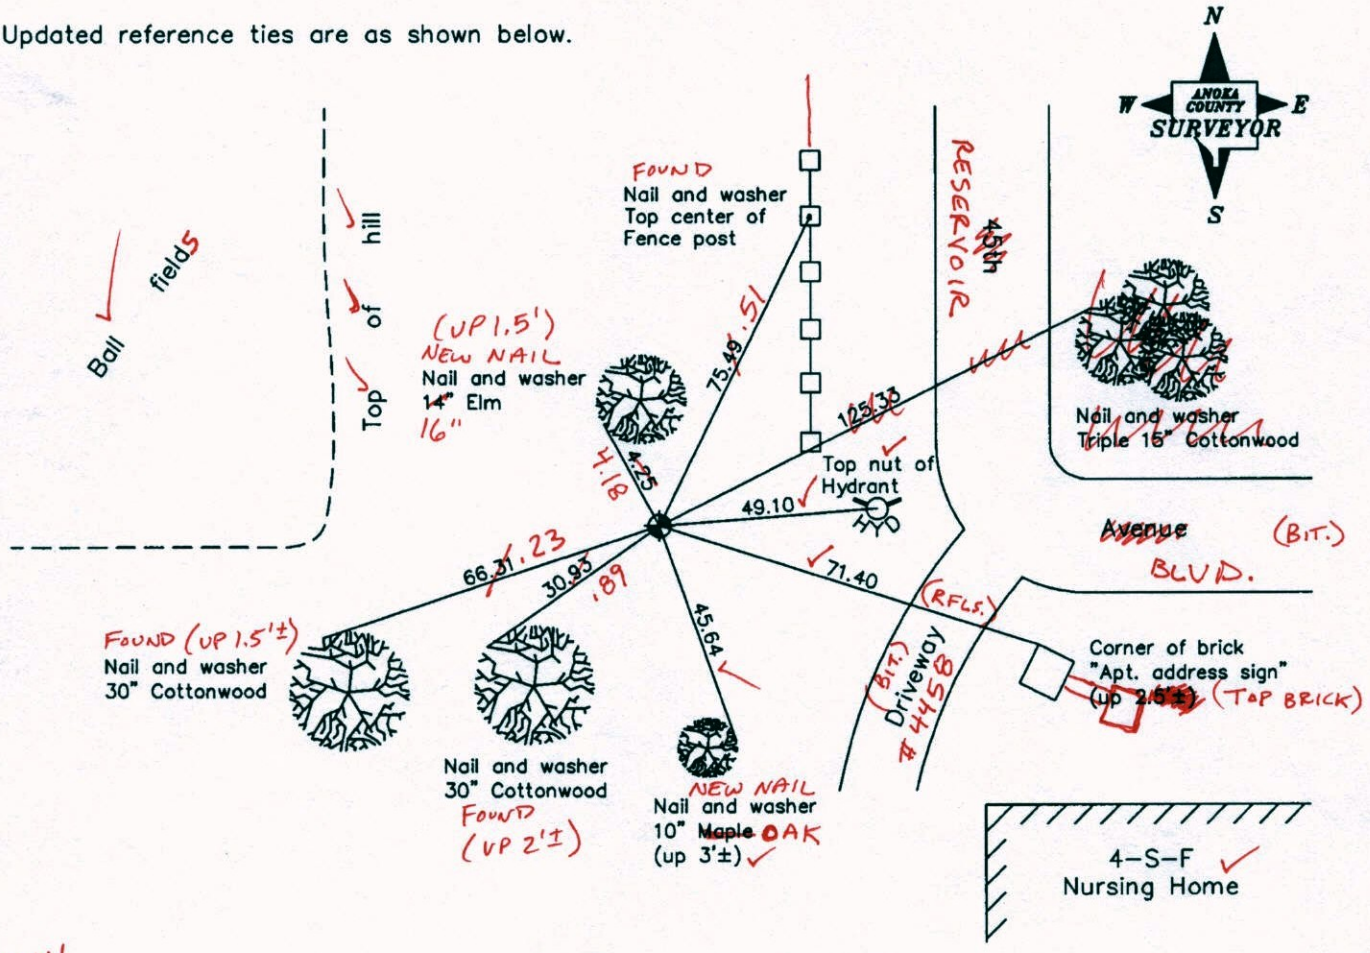

11-4-14
BK-55
TOTAL STATION

Revised date

7/25/89
7/26/94
9/30/08

N.A.D. 1983 Coordinates
(1996 Adjustment)

County Project Coordinates	
Northing	105352.8517
Easting	507608.5956
Date	8/21/03

I hereby certify that this United States public land survey monument record is correct and complete to the best of my knowledge and belief.

Larry D. Hoium Date 11/10/08

Larry D. Hoium, Anoka County Surveyor

Minnesota License Number 18165

CERTIFICATE OF LOCATION OF GOVERNMENT CORNER

County of Anoka State of Minnesota

North 1/4 Corner of Sec. 36 Township 30 Range 24

On the 11th day of April, 1962, the described corner was evidenced by a 1" iron pipe

and to perpetuate the location of said corner, at the exact location thereof, a permanent marker was placed consisting of a cast iron monument

AND on the 30th day of September, 2008, said permanent marker was found and the ties were updated

Updated reference ties are as shown below.

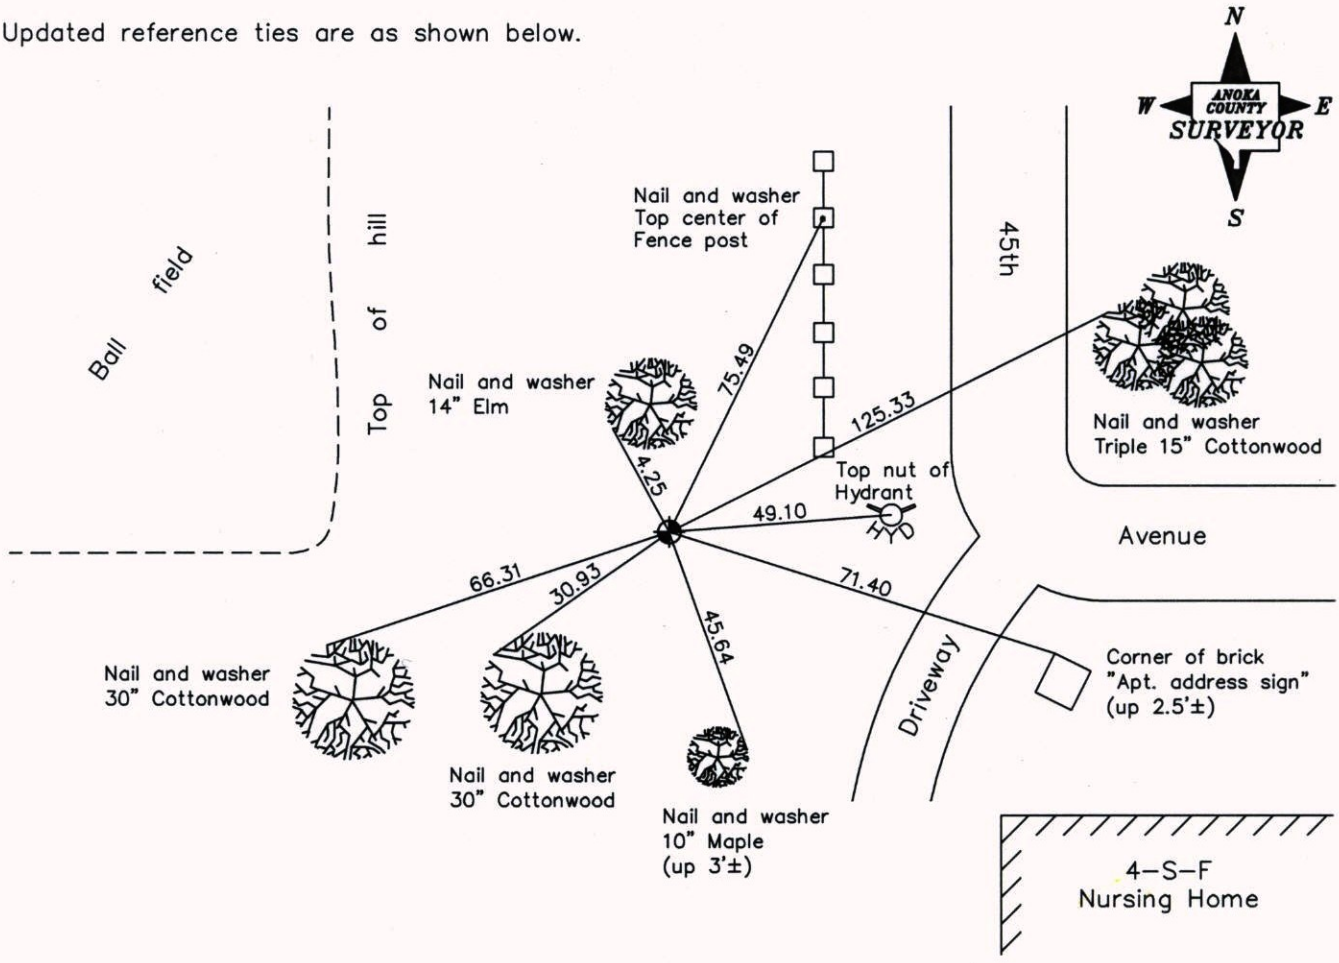

Revised date
7/25/89
7/26/94
9/30/08

N.A.D. 1983 Coordinates
(1996 Adjustment)

County Project Coordinates	
Northing	105352.8517
Easting	507608.5956
Date	8/21/03

I hereby certify that this United States public land survey monument record is correct and complete to the best of my knowledge and belief.

Larry D. Hoium Date 11/10/08

Larry D. Hoium, Anoka County Surveyor

Minnesota License Number 18165

CERTIFICATE OF LOCATION OF GOVERNMENT CORNER

County of Anoka State of Minnesota

NORTH 1/4 Corner of Sec. 36 Township 30 Range 24

I hereby certify that on the 11TH day of APRIL, 1962, I found the described corner which was evidenced by 1" IRON PIPE

and I further certify that to perpetuate the location of said corner, I did, at the exact location thereof, place a permanent marker consisting of CAST IRON MONUMENT

which reference or witness monuments are located in the manner following:

N.A.D. 1983 Co-ordinates
County Project Co-ordinates
Northing 105352.8517
Easting 507608.5956
State Plane Co-ordinates
Y
X
Date 8/21/03

I hereby certify that this United States public land survey monument record is correct and complete to the best of my knowledge and belief.
Larry D. Hoium Date 11/10/08
LARRY D. HOIUM, Anoka County Surveyor
Minnesota License Number 18165

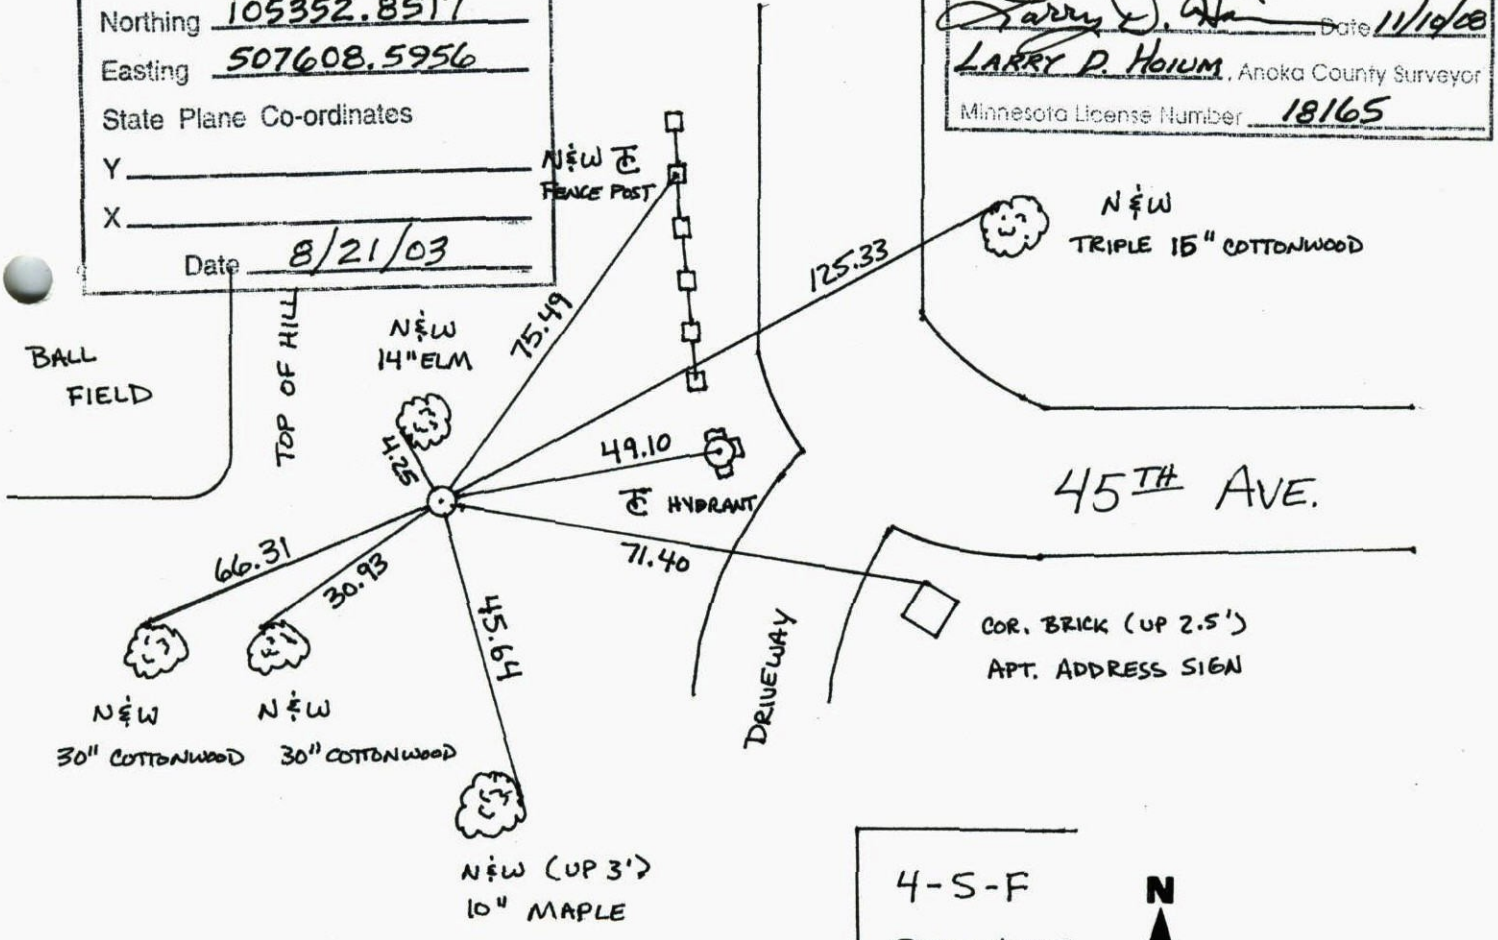

Revised date	Revised date	Revised date
6-26-86		
7-25-89		
7-26-94		
9-30-08		

4-5-F
REST HOME

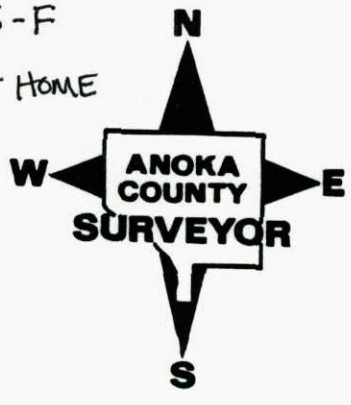

CERTIFICATE OF LOCATION OF GOVERNMENT CORNER

County of Anoka State of Minnesota

NORTH 1/4 Corner of Sec. 36 Township 30 Range 24

I hereby certify that on the 11 day of APRIL, 19 62, I found the described corner which was evidenced by 1" IRON PIPE

and I further certify that to perpetuate the location of said corner, I did, at the exact location thereof, place a permanent marker consisting of CAST IRON MONUMENT

which reference or witness monuments are located in the manner following:

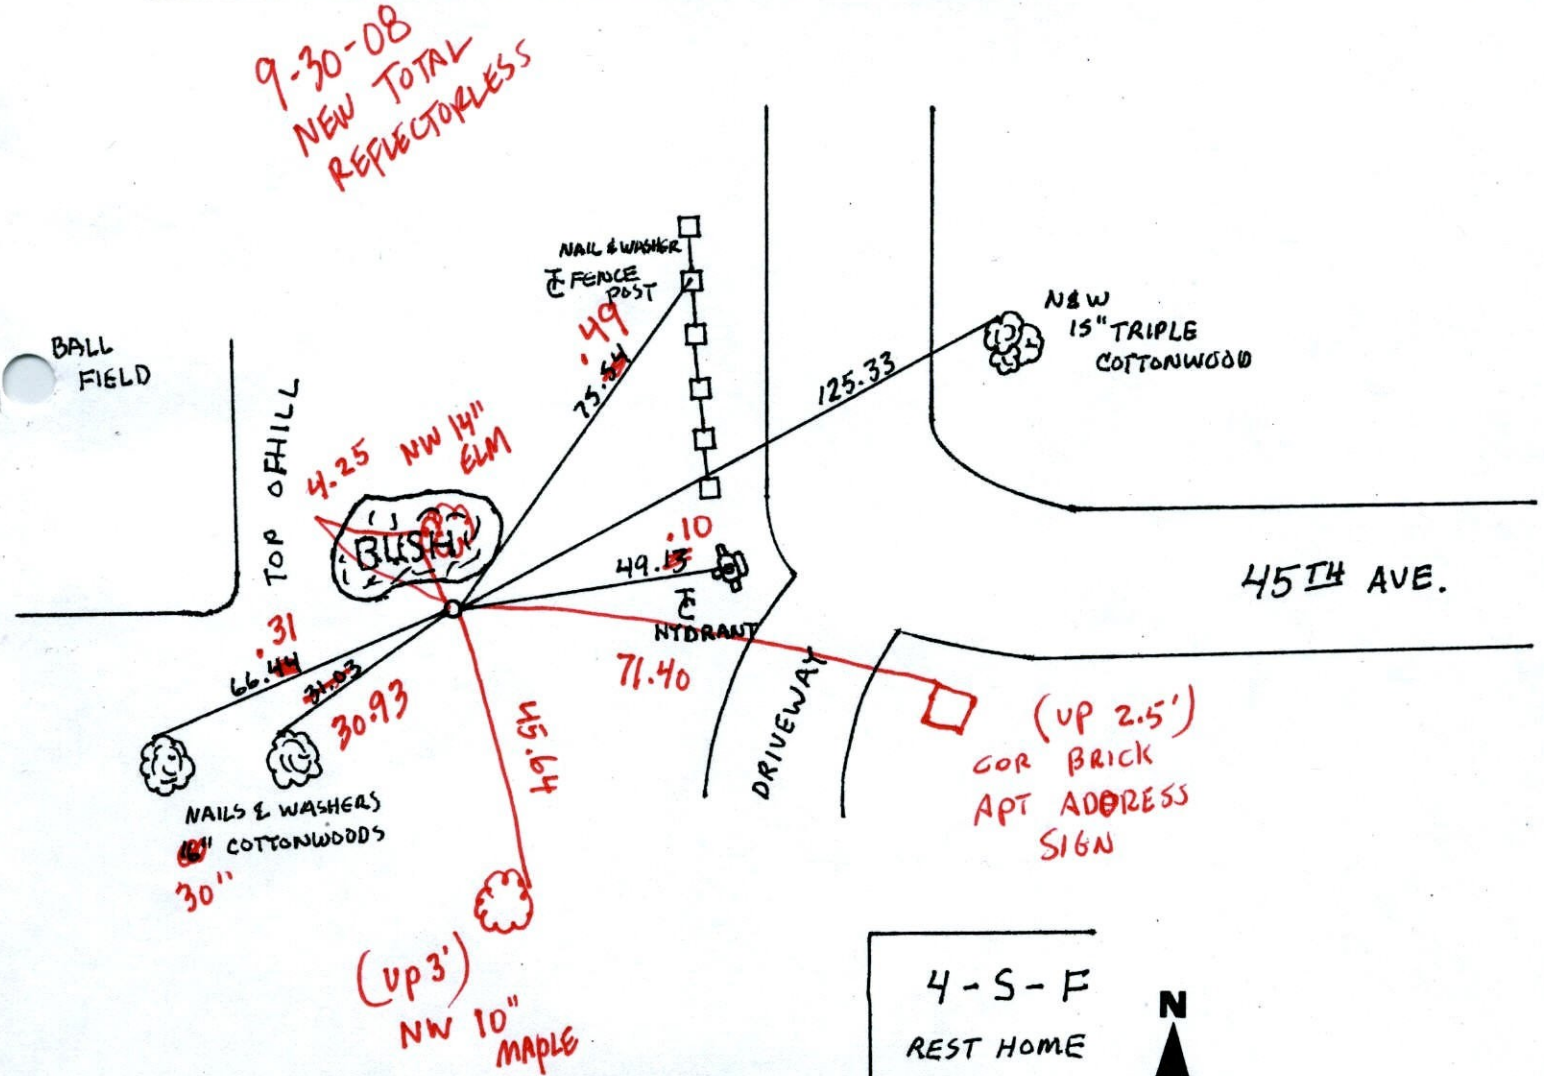

4-S-F
REST HOME

N
W ANOKA COUNTY SURVEYOR E
S

Revised date	Revised date	Revised date
6-26-86		
7-25-89		
7-26-94		

Page No. [redacted]

CERTIFICATE OF LOCATION OF GOVERNMENT CORNER

redraw

County of Anoka State of Minnesota

NORTH ONE QUARTER Corner of Sec. 36 Township 30 Range 24

I hereby certify that on the 11 day of April, 1962, I found the described corner which was evidenced by 1" IRON PIPE

and I further certify that to perpetuate the location of said corner, I did, at the exact location thereof, place a permanent marker consisting of CAST IRON MONUMENT

which reference or witness monuments are located in the manner following:

redraw

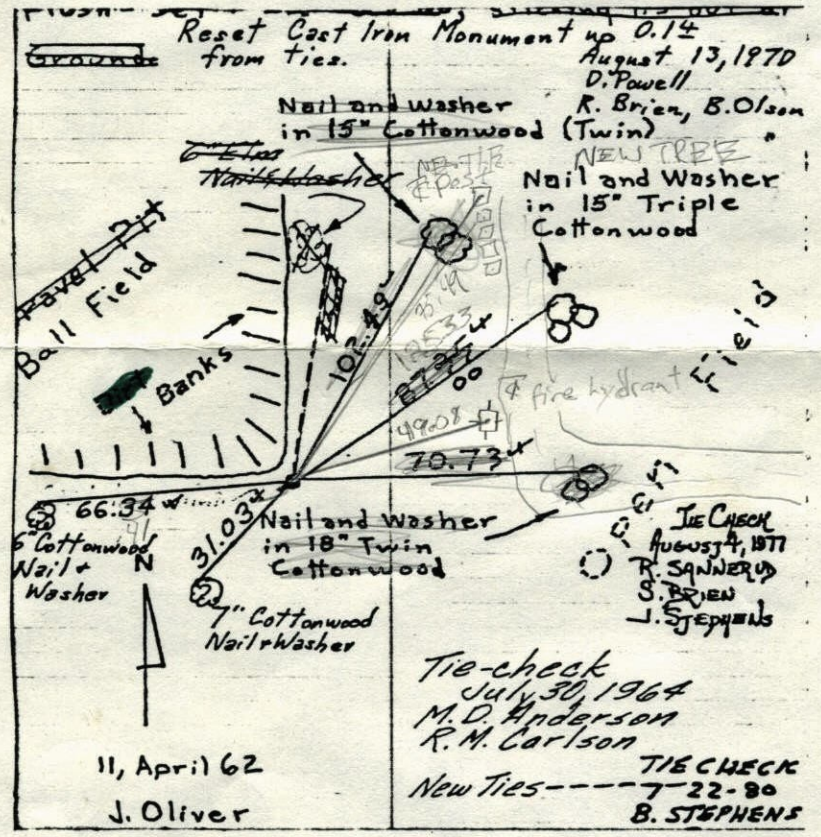

Revised date	By
7-27-83	P. ROSS
6-26-86	D. Ross

#3 85°

Minnesota State Plane Coordinates
South Zone

Y_____ X_____

_____, _____
County Surveyor Date

Registered Land Surveyor No. _____

N 1/4 Sec. 36 Tw. 30 R. 24

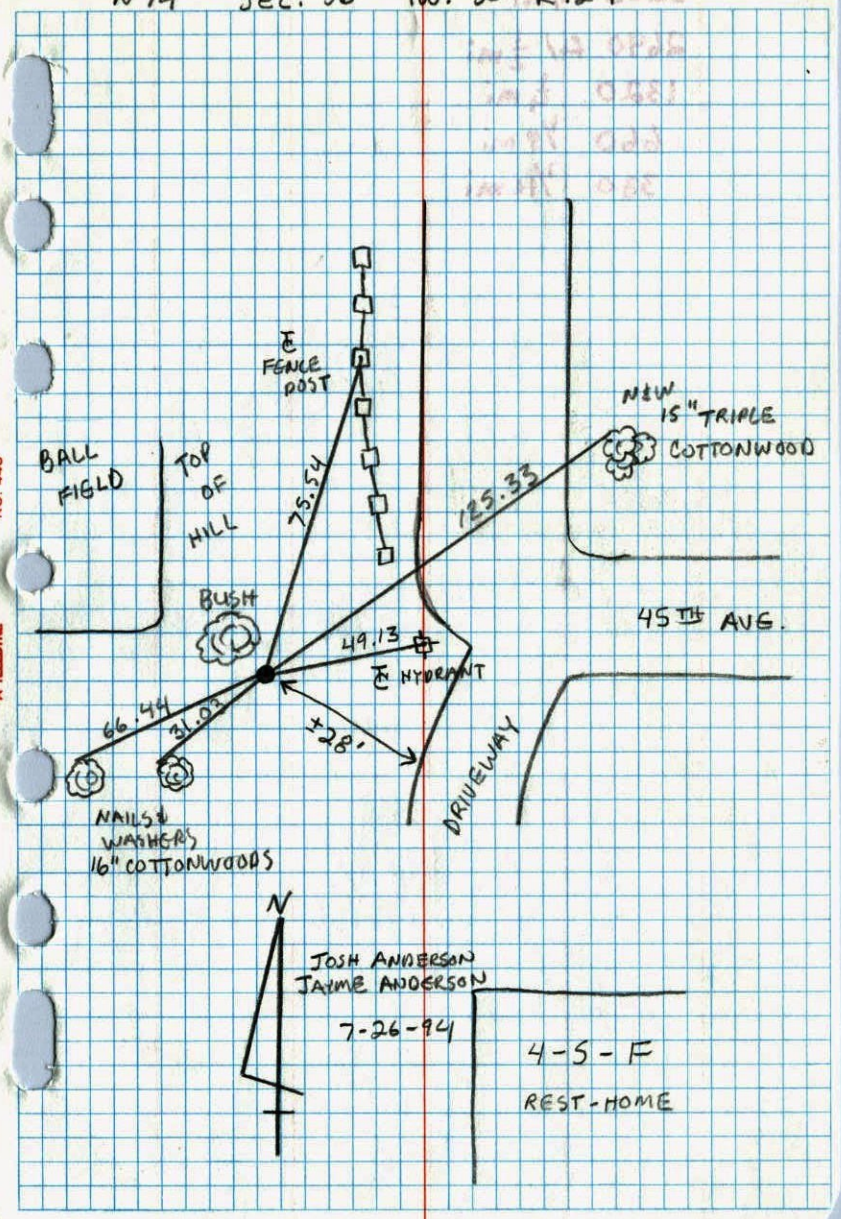

North 1/4 Corner Sec. 36 T30 R24

Retied Cast Iron Monument

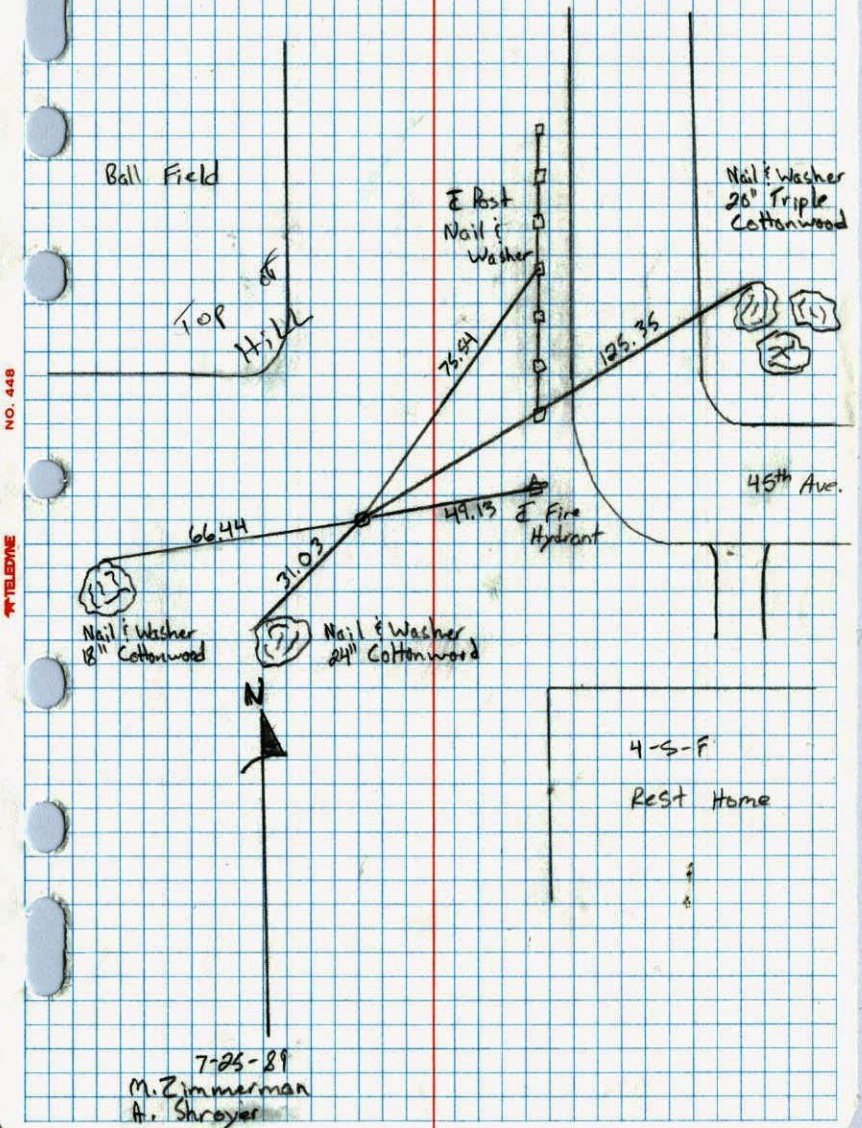

65

N 1/4 Cor. Sec. 36, T30, R 24

Found 1" I.P. down 0.7' which fits old Ties,
drove I.P. down and set Cast Iron Monument
Flush - ~~Set 1" I.P. 0.5' No,~~ ~~sticking 1.5 out of~~ ~~Ground~~
Reset Cast Iron Monument up 0.1± from ties.

August 13, 1970
D. Powell
R. Brien, B. Olson

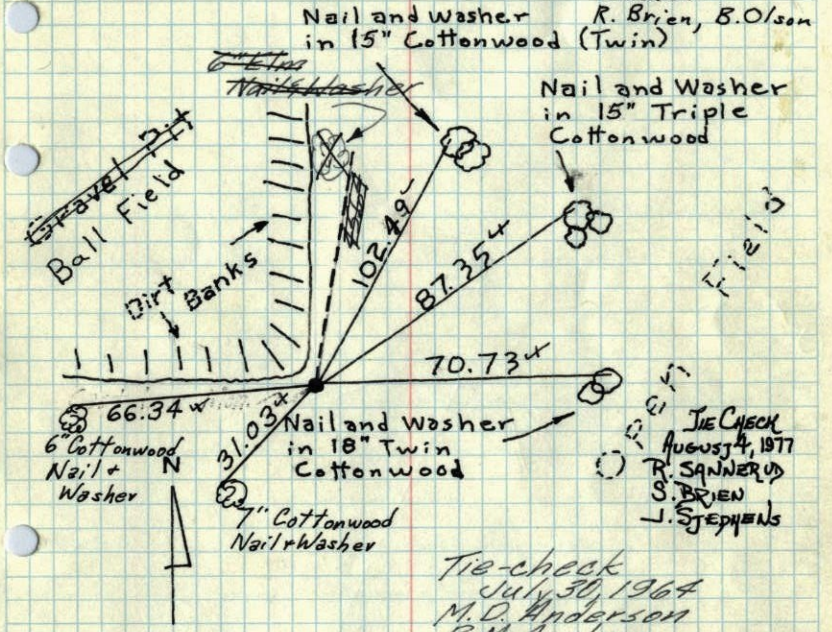

11, April 62
J. Oliver
M.D. Anderson

Tie Check
June 27, 1974
R Farmer
N Dahl
D Dahl

Tie-check
July 30, 1964
M.D. Anderson
R.M. Carlson

New Ties ---- TIE CHECK 7-22-80 B. STEPHENS P. ROSS P. HORNBY

Tie Check
June 30, 1966
H. Larson
D. Potter

ROLAND W. ANDERSON
COUNTY SURVEYOR
ANOKA COUNTY, MINNESOTA

TEMPERATURE CORRECTED
AND HORIZONTALLY
TAPED MEASUREMENTS

62

1970

N 1/4 Cor. Sec. 36, T30, R 24

Found 1" I.P. down 0.7' which fits old Ties,
drove I.P. down and set Cast Iron Monumen
Flush - ~~Set 1" I.P. 0.5' No,~~ ~~sticking 1.5 out of~~ ~~Ground~~
up 1.5 ft.
Gone
C.I. broken off. Set new C.I.
Mon. up 0.1± from ties.

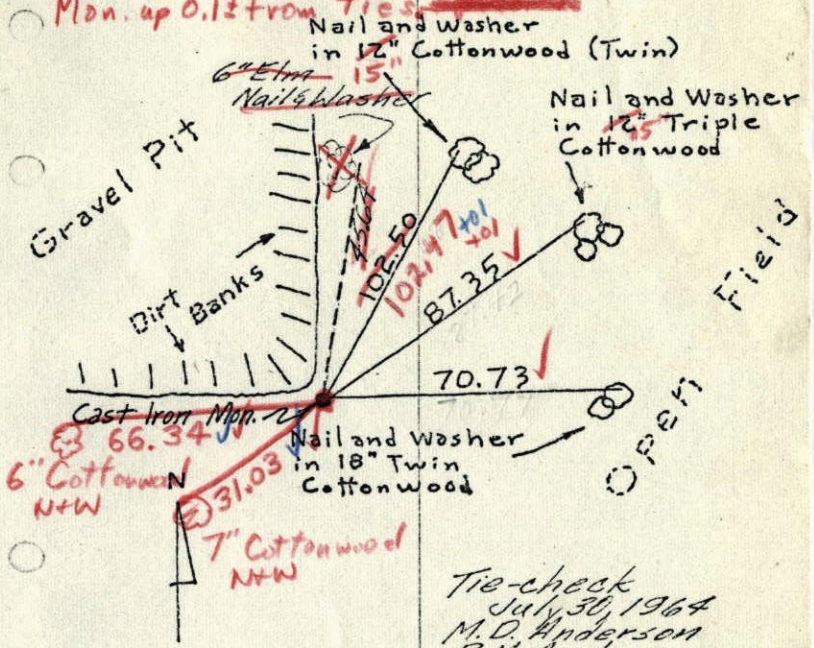

11, April 62
J. Oliver
M.D. Anderson

8/13/70 ✓
#10-80 ✓
D. Powell
R. Brien, B. Olson

Tie-check
July 30, 1964
M.D. Anderson
R.M. Carlson

New Ties ------

Tie Check
June 30, 1966
H. Larson
D. Potter

ROLAND W. ANDERSON
COUNTY SURVEYOR
ANOKA COUNTY, MINNESOTA

TEMPERATURE CORRECTED
AND HORIZONTALLY
TAPED MEASUREMENTS

66

1962

N¼ Cor. Sec. 36, T 30, R 24

Found 1" I.P. down 0.7' which fits Ties, drove down and set C.I. Mon. Flush - Set 1" I.P. ½' No. 8 sticking 1½' out of Ground.

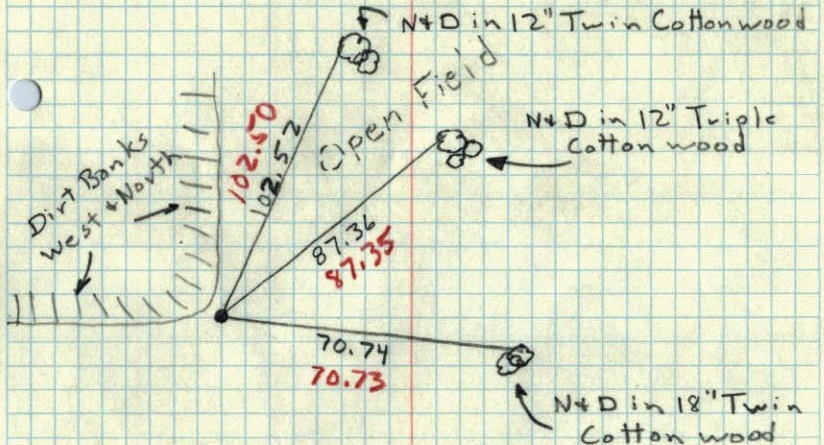

11, April 62
42°
V. Oliver
M.D. Anderson

66

NO DATE

N¼ corner of Sec. 36 + 30. R. 24

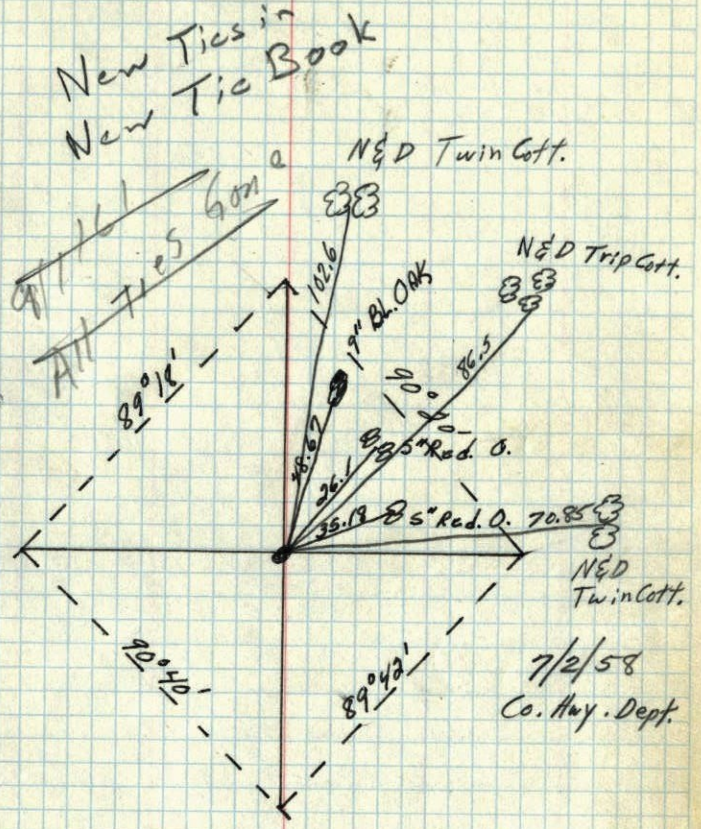

No Date
Mpls. Water Works