

# CERTIFICATE OF LOCATION OF GOVERNMENT CORNER

County of Anoka

State of Minnesota


North 1/4 Corner of Sec. 3 Township 30 Range 24

On the 12th day of June, 1969, the described corner was evidenced by a 3/4" iron pipe

and to perpetuate the location of said corner, at the exact location thereof, a permanent marker was placed consisting of a cast iron monument AN E (~~DOWN 0.3'± NEEDS TO BE RAISED~~)  
BK-SS 11-24-14 RAISED

AND on the 18th day of August, 2008, said permanent marker was found and the ties were updated

Updated reference ties are as shown below.

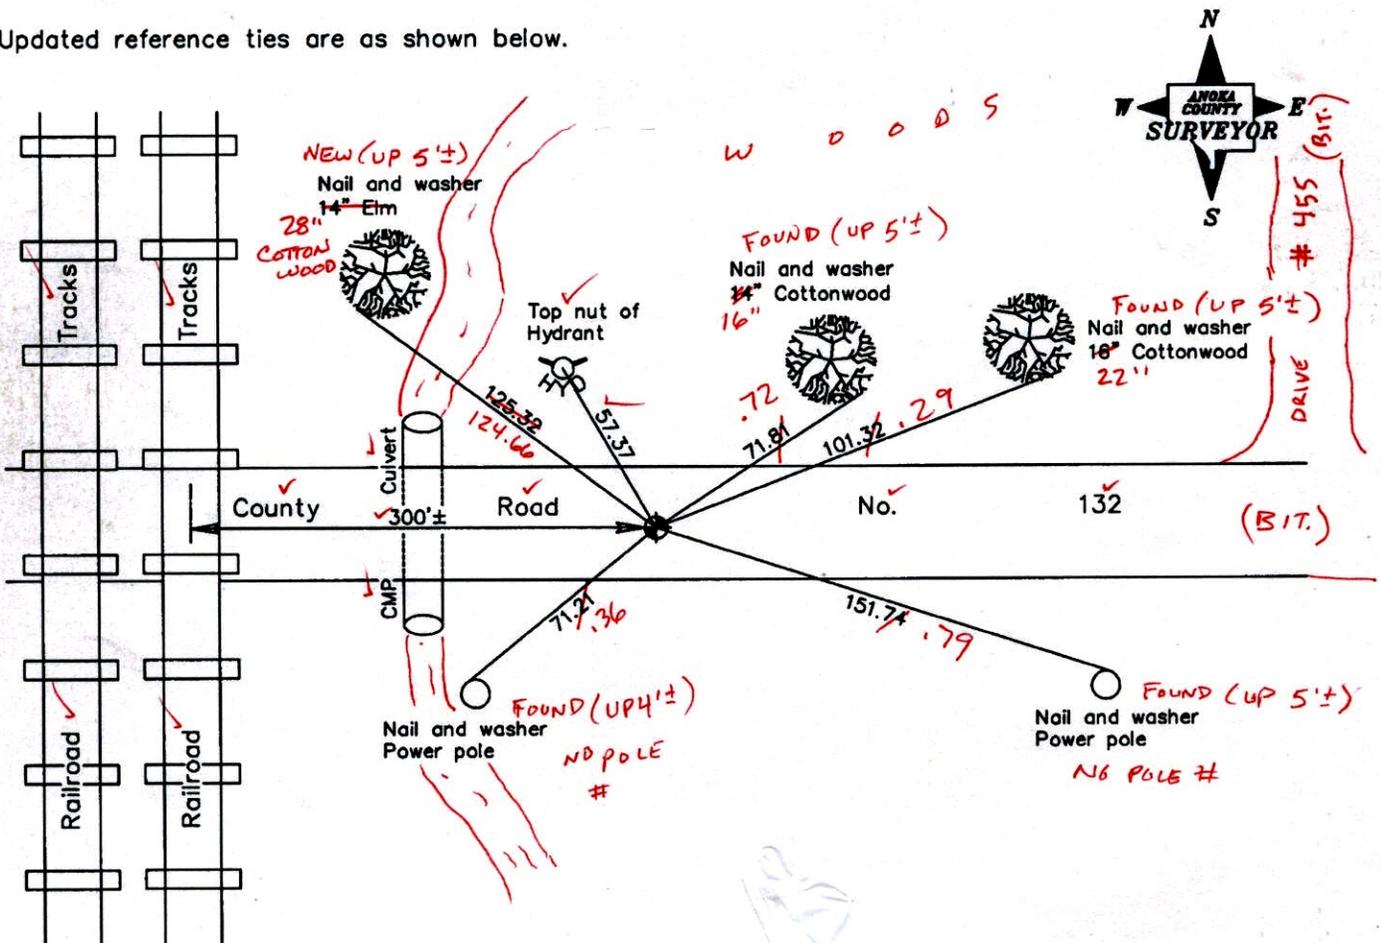

11-20-14  
BK-SS  
TOTAL Revised date  

6/27/89
7/28/94
8/18/08

 STA.  
 VRS

N.A.D. 1983 Coordinates  
(1996 Adjustment)

County Project Coordinates	
Northing	132510.2535
Easting	496785.9886
Date	12/15/04

I hereby certify that this United States public land survey monument record is correct and complete to the best of my knowledge and belief.

*Larry D. Hoium* Date 11/06/08  
 Larry D. Hoium, Anoka County Surveyor  
 Minnesota License Number 18165

3DQ = 0.05    N = 132510.2402    E = 496785.0262

# CERTIFICATE OF LOCATION OF GOVERNMENT CORNER

County of Anoka

State of Minnesota


North 1/4 Corner of Sec. 3 Township 30 Range 24

On the 12th day of June, 1969, the described corner was evidenced by a 3/4" iron pipe

and to perpetuate the location of said corner, at the exact location thereof, a permanent marker was placed consisting of a cast iron monument

AND on the 18th day of August, 2008, said permanent marker was found and the ties were updated

Updated reference ties are as shown below.

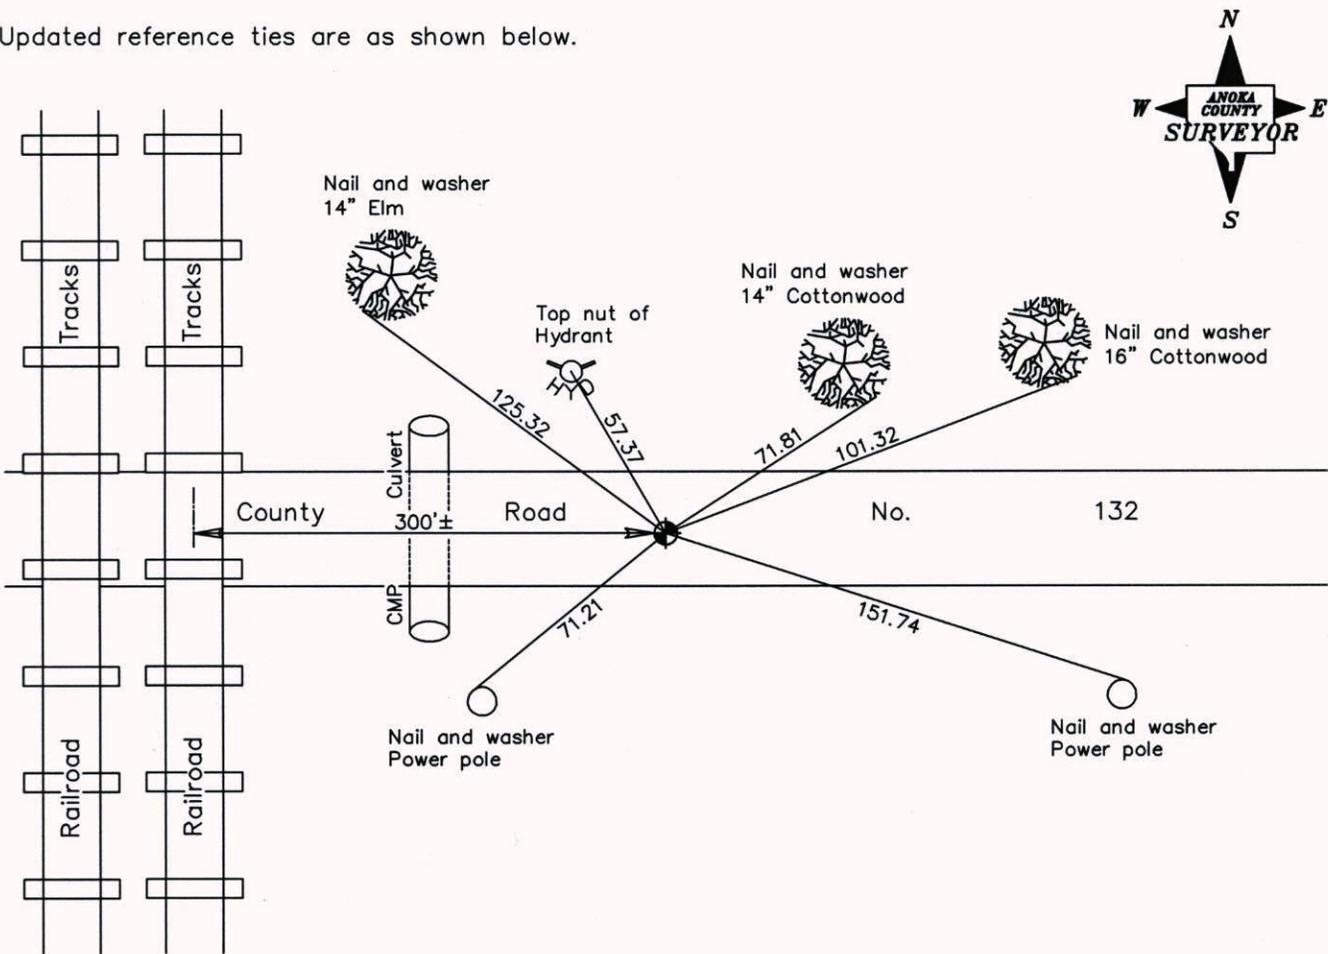

Revised date
6/27/89
7/28/94
8/18/08

N.A.D. 1983 Coordinates (1996 Adjustment)	
County Project Coordinates	
Northing	<u>132510.2535</u>
Easting	<u>496785.9886</u>
Date	<u>12/15/04</u>

I hereby certify that this United States public land survey monument record is correct and complete to the best of my knowledge and belief.

*Larry D. Hoium* Date 11/06/08

Larry D. Hoium, Anoka County Surveyor

Minnesota License Number 18165

# CERTIFICATE OF LOCATION OF GOVERNMENT CORNER

County of Anoka


State of Minnesota

NORTH 1/4 Corner of Sec. 3 Township 30 Range 24

I hereby certify that on the 12 day of JUNE, 1969, I found the described corner which was evidenced by 3/4" I.P.

and I further certify that to perpetuate the location of said corner, I did, at the exact location thereof, place a permanent marker consisting of CAST IRON MON. T.


which reference or witness monuments are located in the manner following:

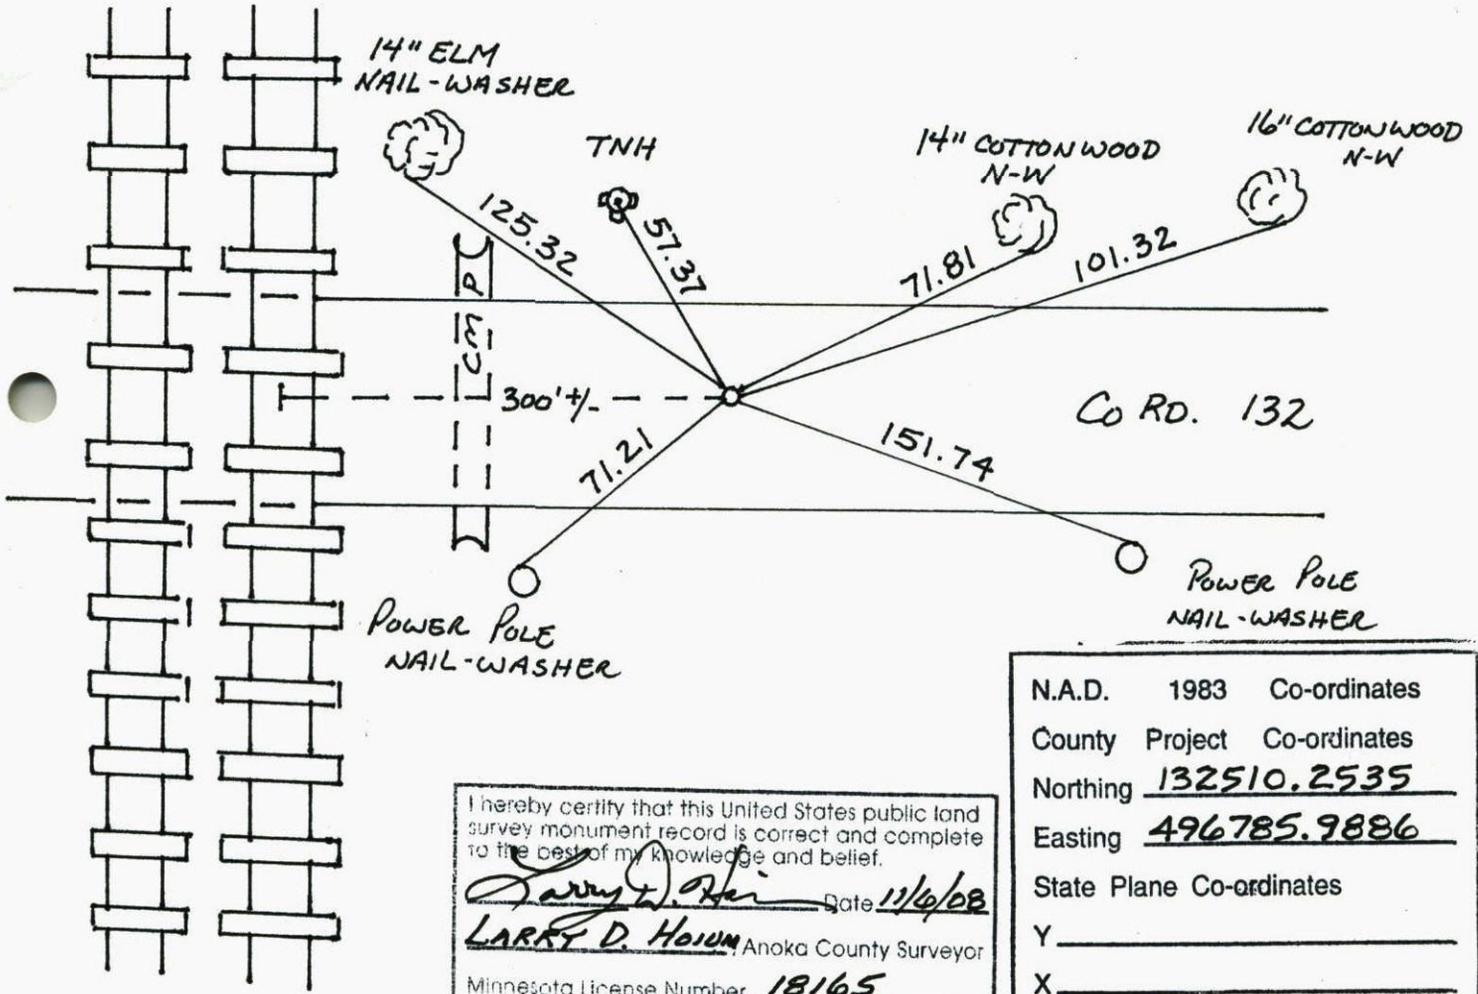



I hereby certify that this United States public land survey monument record is correct and complete to the best of my knowledge and belief.  
*Larry D. Hoium* Date 11/6/08  
**LARRY D. HOIUM** Anoka County Surveyor  
 Minnesota License Number 18165

N.A.D.	1983	Co-ordinates
County	Project	Co-ordinates
Northing	<u>132510.2535</u>	
Easting	<u>496785.9886</u>	
State Plane	Co-ordinates	
Y	_____	
X	_____	
Date	<u>12/15/04</u>	

Revised date	Revised date	Revised date
<u>8-16-76</u>		
<u>7-28-77</u>		
<u>10-12-81</u>		
<u>6-24-86</u>		
<u>6-27-89</u>		
<u>7-28-94</u>		
<u>8-18-08</u>		

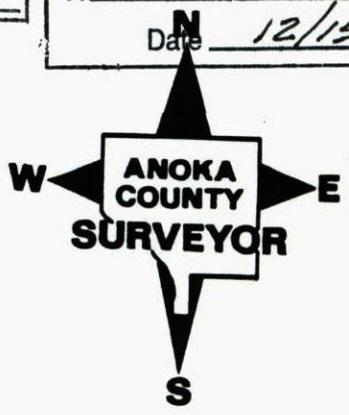

NORTH

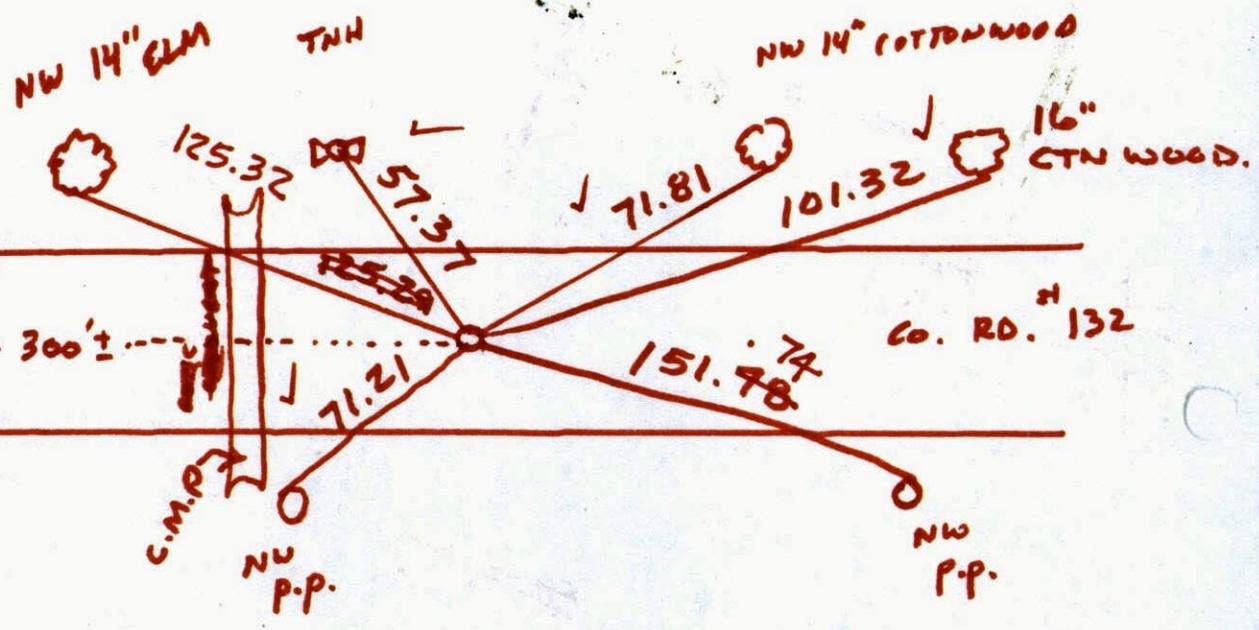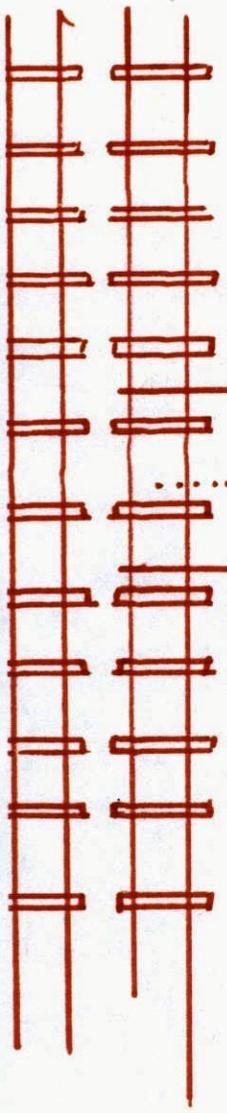

8-18-08

# CERTIFICATE OF LOCATION OF GOVERNMENT CORNER

County of Anoka


State of Minnesota

NORTH 1/4 Corner of Sec. 3 Township 30 Range 24

I hereby certify that on the 12<sup>TH</sup> day of JUNE, 1969, I found the described corner which was evidenced by 3/4" IRON PIPE

and I further certify that to perpetuate the location of said corner, I did, at the exact location thereof, place a permanent marker consisting of CAST IRON MONUMENT


which reference or witness monuments are located in the manner following:

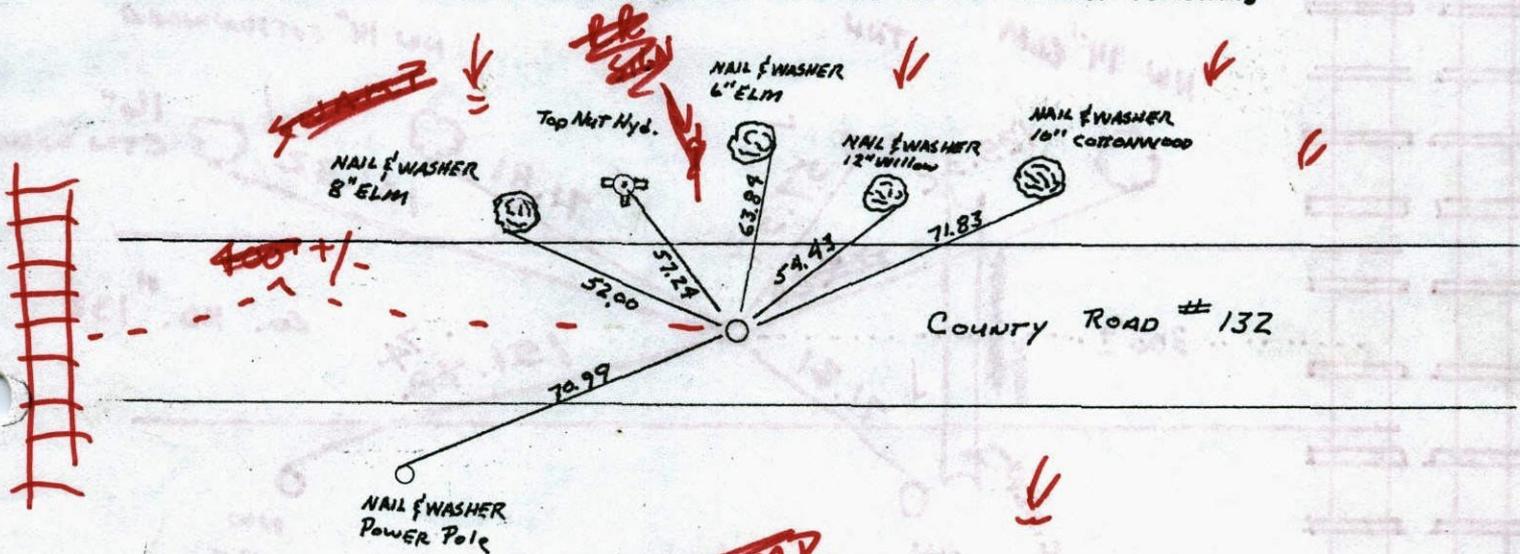

~~GPS'D  
9-24-03~~


~~SLAMP~~  
SEE BACK  
FOR TIES  
GPS'D 12-15-04

Revised date	Revised date	Revised date
8-16-76		
7-28-77		
10-12-81		
6-24-86		
6-27-89		
7-28-94		

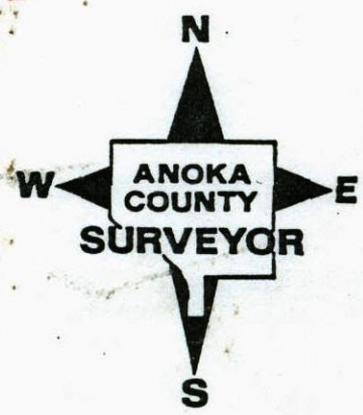

NORTH 1/4 CORNER SEC 3 T30 R24

RETIED CAST IRON MONUMENT

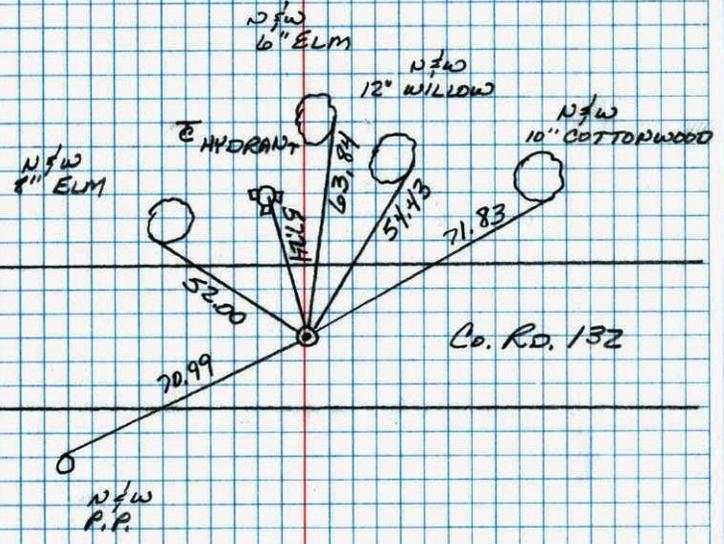

Co. Rd. 132



6-27-89  
 GUETZKO  
 STEVENSON  
 ZIMMERMAN  
 SHROYER

NO. 448 TELEPHONE


N 1/4 Cor. Sec. 3 T. 30 R. 24

Replaced Iron Pipe with CI Flush

8-20-69


Retied  
 10-12-81  
 H. Larson  
 B. Guetzko  
 D. Nachk

Reset CI Flush  
 P.K. 2' N of E  
 6-11-82  
 P. Ross  
 R. Dierckes

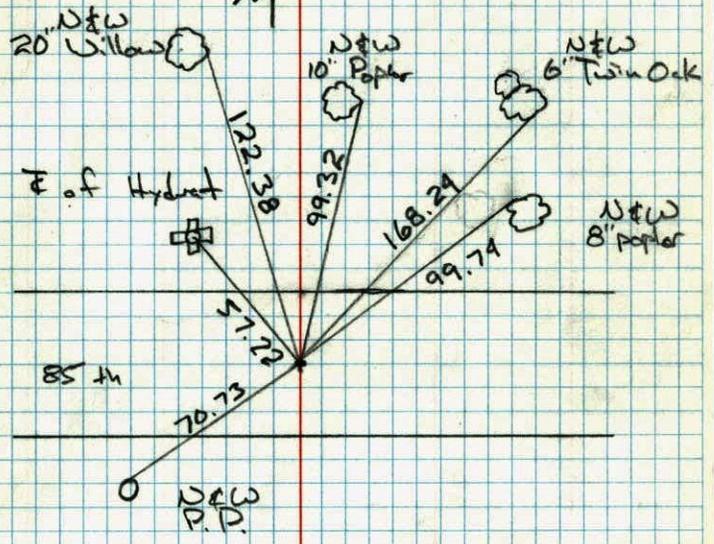

NO. 448 TELEPHONE


CONSTRUCTION TIES FOR N<sup>1</sup>/<sub>4</sub> COR  
SECTION 3 T30 R24

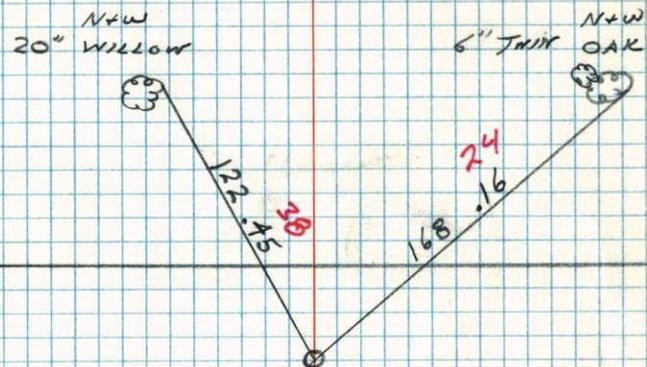

200' S89  
10-12-81  
H. LARSON  
B. GUETKO  
D. MAGLAK

N<sup>1</sup>/<sub>4</sub> Cor. Sec. 3 T30 R24

Tied 3/4" iron pipe reset by N.C. Hoium  
down 0.3'±. Replaced Iron Pipe with Cast  
Iron Monument flush. PK's 2.00' North + East.

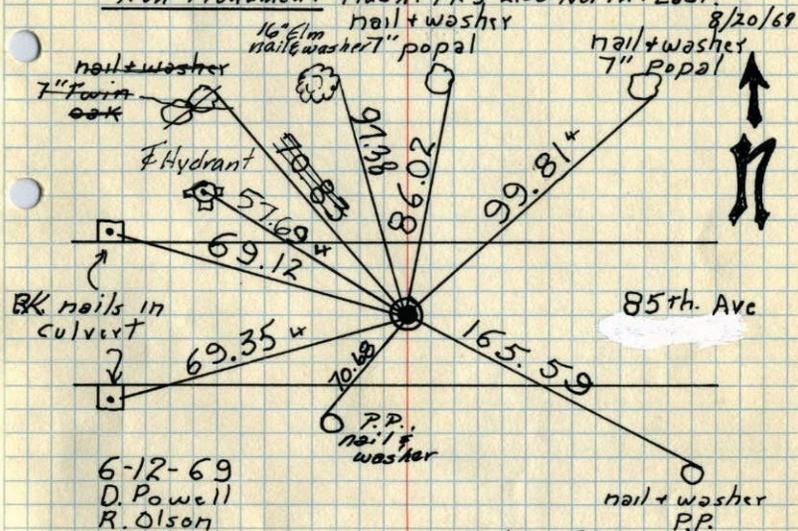

6-12-69  
D. Powell  
R. Olson  
B. Olson

Aug. 20, 1969  
D. Powell  
R. Olson  
R. Brien  
Cast tie ✓  
May 10, 1973  
M. D. Anderson  
all ties O.K.

Broken off.  
Reset Cast Iron  
Monument flush.  
June 15, 1970  
D. Powell  
R. Brien  
W. Waslander

TIE CHECK  
JULY 28, 1977  
S. BRIEN  
J. STEPHENS

Tie check  
June 24, 1973  
R. Farmer  
N. Dahl  
D. Dahl


TIE CHECK  
8-16-76  
G. ADAMS  
S. BRIEN  
J. STEPHENS

TEMPERATURE CORRECTED  
AND HORIZONTALLY  
TAPED MEASUREMENTS

ROLAND W. ANDERSON  
COUNTY SURVEYOR  
ANOKA COUNTY, MINNESOTA

1969  
N<sup>1</sup>/<sub>4</sub> Cor. Sec. 3 T30 R24

Tied 3/4" Iron pipe ReSet by N.C. Hoium  
down 0.3'±. Set C.I. Mon. Flush in  
place of iron. PK's 2,00' N+E.

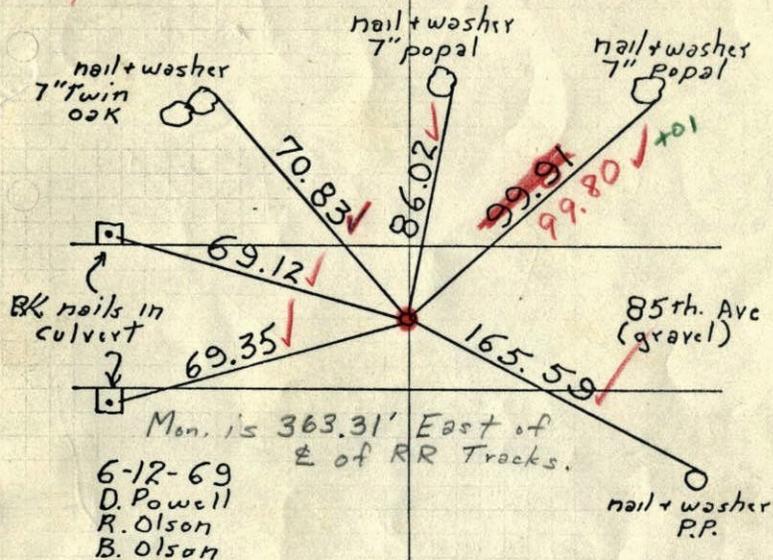

6-12-69  
D. Powell  
R. Olson  
B. Olson

8/20/69  
45-70° ✓  
D. Powell  
R. Olson  
R. Brien

~~CT To be Set~~

TEMPERATURE CORRECTED  
AND HORIZONTALLY  
TAPED MEASUREMENTS

1969  
N<sup>1</sup>/<sub>4</sub> Cor. Sec. 3 - T30 - R24

3/4" Iron Pipe down 0.3'±  
ReSet by N.C. Hoium

