

CERTIFICATE OF LOCATION OF GOVERNMENT CORNER

County of Anoka State of Minnesota

South $\frac{1}{4}$ Corner of Sec. 36 Township 30 Range 24


On the 25th day of May, 1978, the described corner was evidenced by a brass plate in concrete

and to perpetuate the location of said corner, at the exact location thereof, a permanent marker was placed consisting of the same brass plate in concrete set in hole down 0.5' with steel cover

11-3-14 UNABLE TO SET-UP ON MON./COVERED TUBE CROOKED AND COVERING MON.
BK-55 (NOT A.C. MON.)

AND on the 1st day of October, 2008, said permanent marker was found and the ties were updated

Updated reference ties are as shown below.

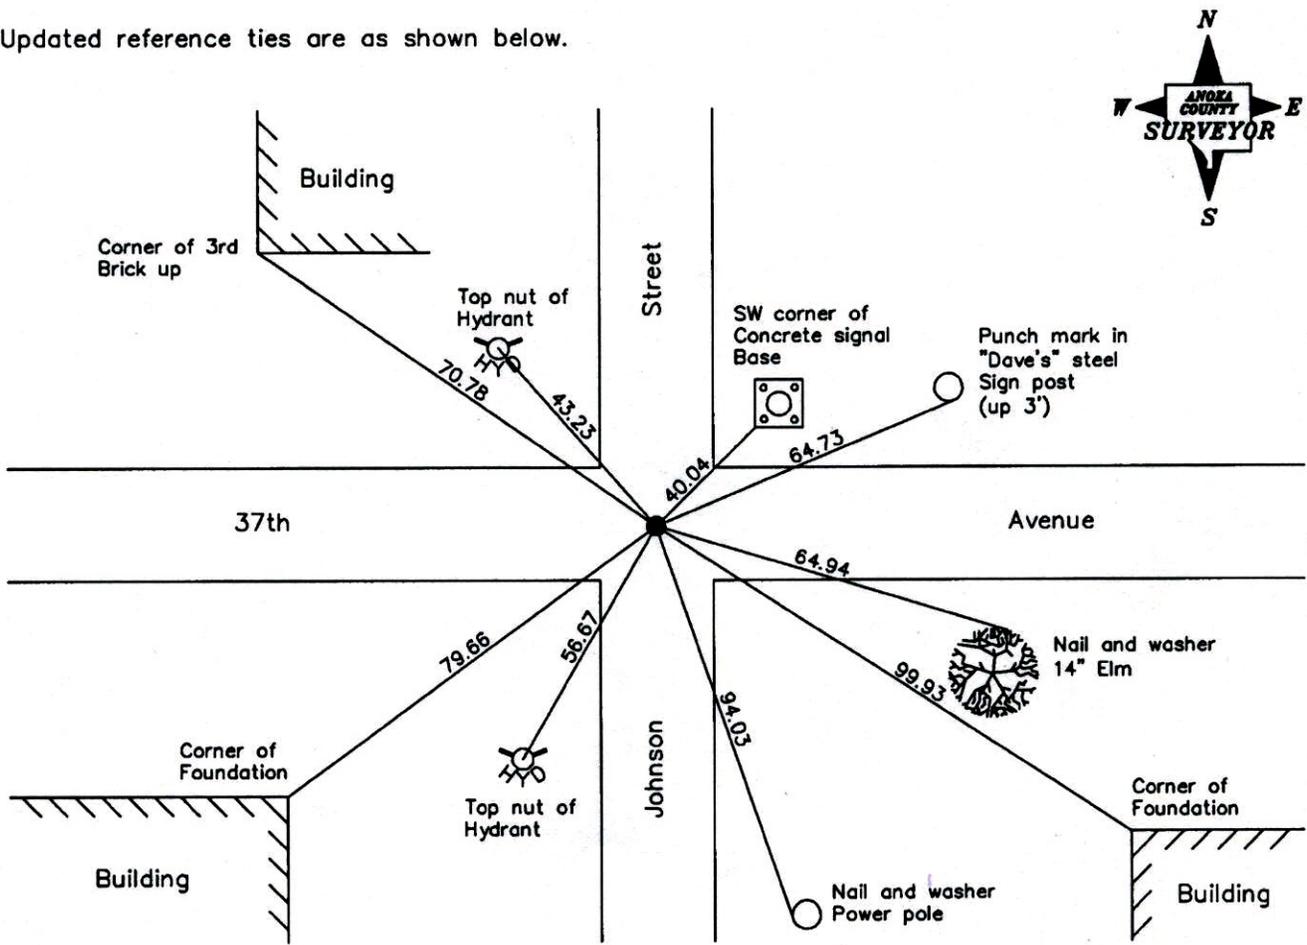

Revised date
8/01/89
7/25/94
10/01/08

N.A.D. 1983 Coordinates (1996 Adjustment)	
County Project Coordinates	
Northing	<u>100123.9263</u>
Easting	<u>507639.4979</u>
Date	<u>7/13/04</u>

I hereby certify that this United States public land survey monument record is correct and complete to the best of my knowledge and belief.

Larry D. Hoium Date 11/10/08

Larry D. Hoium, Anoka County Surveyor

Minnesota License Number 18165

CERTIFICATE OF LOCATION OF GOVERNMENT CORNER

County of Anoka

State of Minnesota


South $\frac{1}{4}$ Corner of Sec. 36 Township 30 Range 24

On the 25th day of May, 1978, the described corner was evidenced by a brass plate in concrete

and to perpetuate the location of said corner, at the exact location thereof, a permanent marker was placed consisting of the same brass plate in concrete set in hole down 0.5' with steel cover

AND on the 1st day of October, 2008, said permanent marker was found and the ties were updated

Updated reference ties are as shown below.

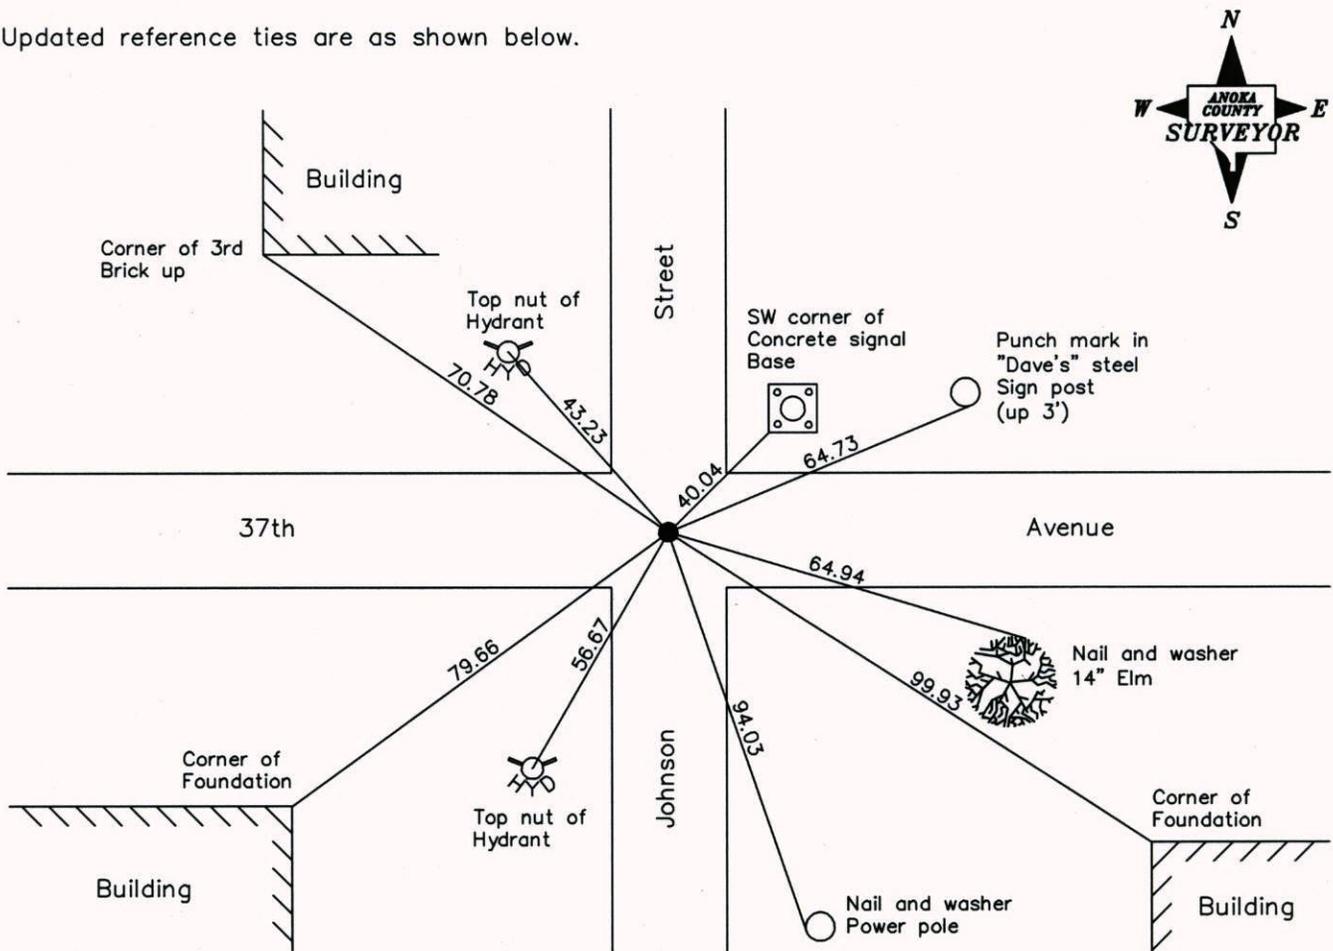

Revised date
8/01/89
7/25/94
10/01/08

N.A.D. 1983 Coordinates (1996 Adjustment)	
County Project Coordinates	
Northing	<u>100123.9263</u>
Easting	<u>507639.4979</u>
Date	<u>7/13/04</u>

I hereby certify that this United States public land survey monument record is correct and complete to the best of my knowledge and belief.

Date 11/10/08

Larry D. Hoium, Anoka County Surveyor

Minnesota License Number 18165

CERTIFICATE OF LOCATION OF GOVERNMENT CORNER

County of Anoka

State of Minnesota


SOUTH QTR. Corner of Sec. 36 Township 30 Range 24

I hereby certify that on the 25TH day of MAY, 1978, I found the described corner which was evidenced by BRASS PLATE IN CONCRETE

and I further certify that to perpetuate the location of said corner, I did, at the exact location thereof, place a permanent marker consisting of BRASS PLATE IN CONCRETE SET IN HOLE
DOWN 0.5'± WITH STEEL COVER

which reference or witness monuments are located in the manner following:

N.A.D.	1983	Co-ordinates
County Project		Co-ordinates
Northing	<u>100123.9263</u>	
Easting	<u>507639.4979</u>	
State Plane Co-ordinates	Y _____	
	X _____	
Date	<u>7/13/04</u>	

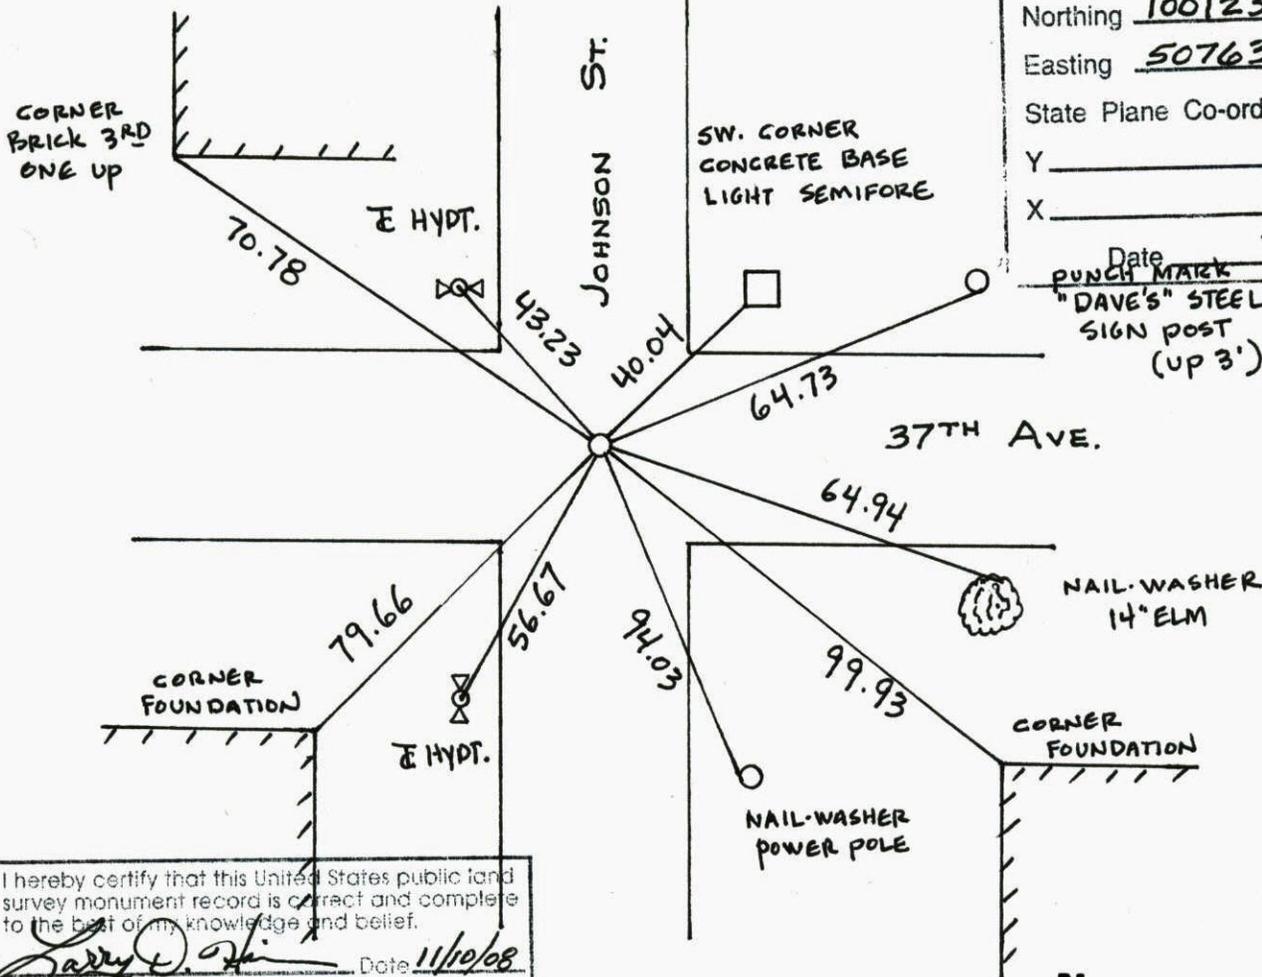


I hereby certify that this United States public land survey monument record is correct and complete to the best of my knowledge and belief.

Larry D. Hoium Date 11/10/08

LARRY D. HOIUM, Anoka County Surveyor
Minnesota License Number 18165

Revised date	Revised date	Revised date
10.21.86		
8.1.89		
7.25.94		
10.01.08		

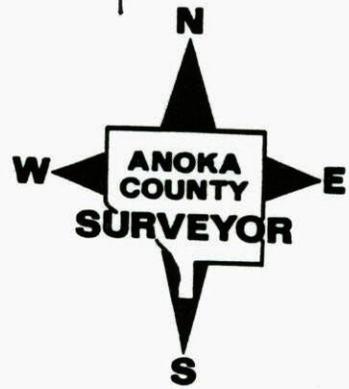

CERTIFICATE OF LOCATION OF GOVERNMENT CORNER

County of Anoka

State of Minnesota


✓ DONE

SOUTH 1/4 Corner of Sec. 36 Township 30 Range 24

I hereby certify that on the 25 day of MAY, 1978, I found the described corner which was evidenced by BRASS PLATE IN CONCRETE

and I further certify that to perpetuate the location of said corner, I did, at the exact location thereof, place a permanent marker consisting of BRASS PLATE IN CONCRETE SET IN HOLE DOWN .5'± WITH STEEL COVER

which reference or witness monuments are located in the manner following:

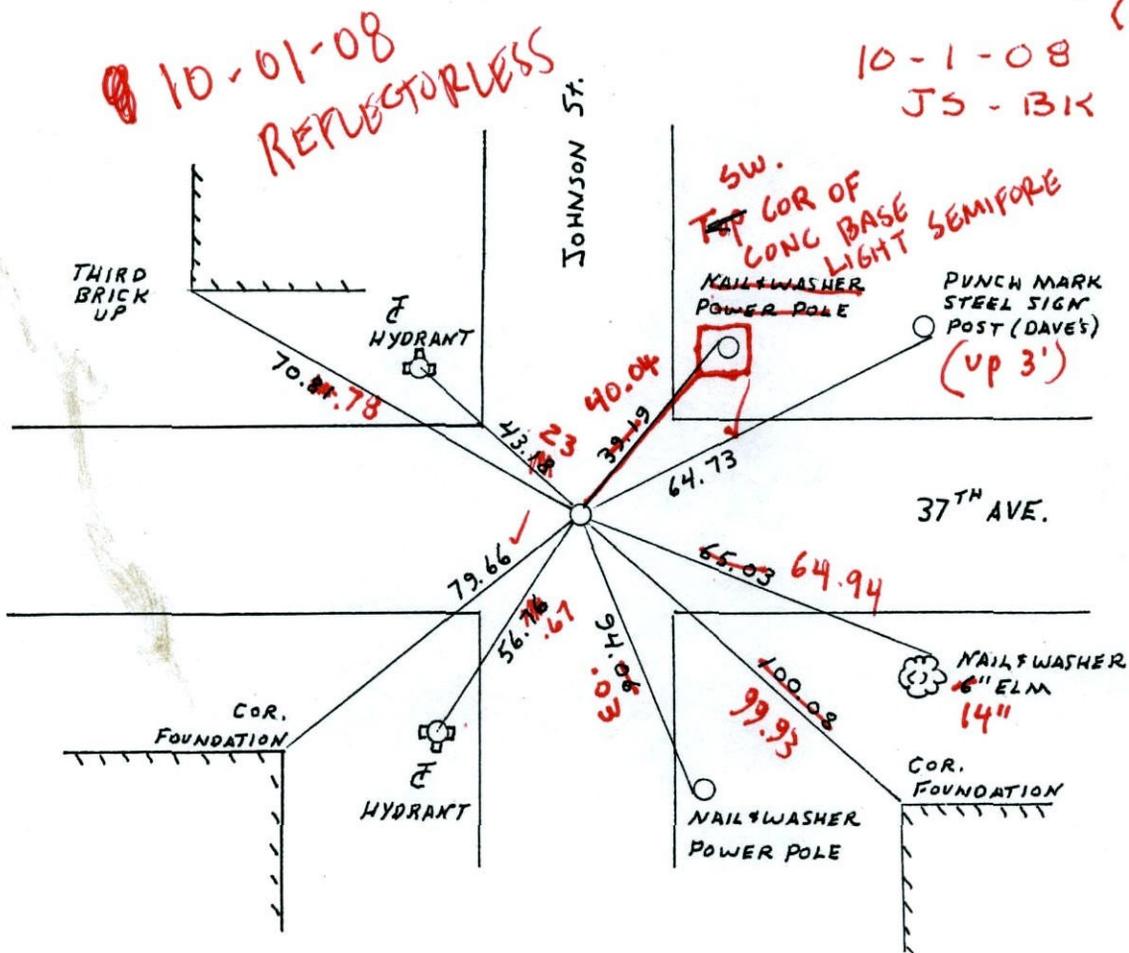

Revised date
RESET AND
RETIED
10-21-86
8-1-89
7-25-94

By
H. LARSON
A. SHROYER
J. A.

Minnesota State Plane Coordinates
South Zone

Y _____ X _____

County Surveyor _____ Date _____

Registered Land Surveyor No. _____


CONSTRUCTION TIES

RESET (77)
10-21-86

SOUTH 1/4 CORNER SECTION 36 T30 R24

TOOK ADDITIONAL TIES FOR
CONSTRUCTION.

W3 56°
5-23-86
H. LARSON
B. GUETZKO

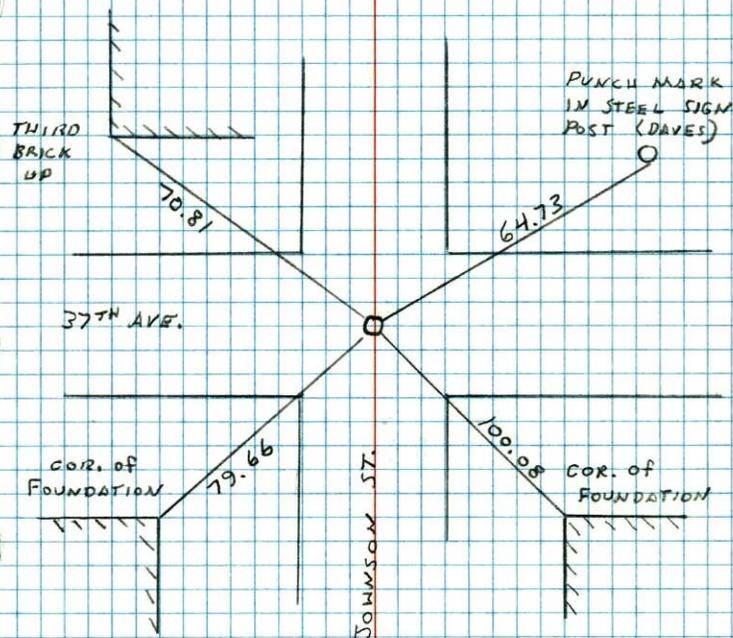


NO. 448

TELEPHONE

77

S 1/4 COR. SEC. 36-T30-R24

FOUND AND TIED CONCRETE MONUMENT WITH
BRASS PLATE IN TOP OF MONUMENT SET IN
PIPE WITH COVER. CONCRETE DOWN .5'±

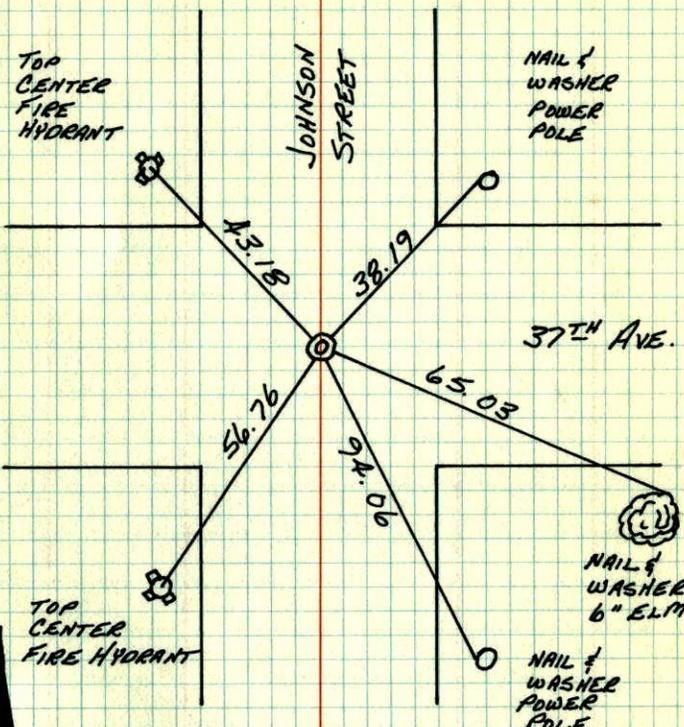

25 MAY 78
H. LARSON
B. GUETZKO
D. DAHL


TIE CHECK
7-21-80
B. STEPHENS
P. ROSS
P. HORNBY

TEMPERATURE CORRECTED
AND HORIZONTALLY
TAPED MEASUREMENTS

ROLAND W. ANDERSON
COUNTY SURVEYOR
ANOKA COUNTY, MINNESOTA

24
S 1/4 Cor. Section 36 T30 R23

Found and tied concrete monument with
brass plate in top monument set in
pipe with cover conc. down .5'

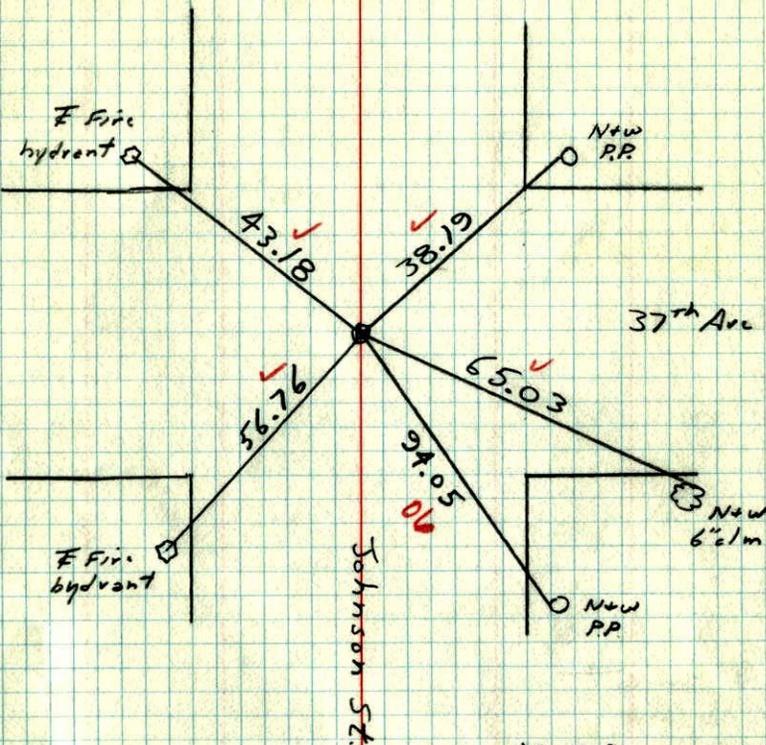

#1 80°
5-25-78
H. Larson
B. Guetzko
D. Dahl