CERTIFICATE OF LOCATION OF GOVERNMENT CORNER

County of Anoka State of Minnesota

Northwest Corner of Sec. 3 Township 30 Range 24

On the 10th day of April, 1943, the described corner was evidenced by a granite monument

and to perpetuate the location of said corner, at the exact location thereof, a permanent marker was placed consisting of the same granite monument

AND on the 18th day of August, 2008, said permanent marker was found and the ties were updated

Updated reference ties are as shown below.

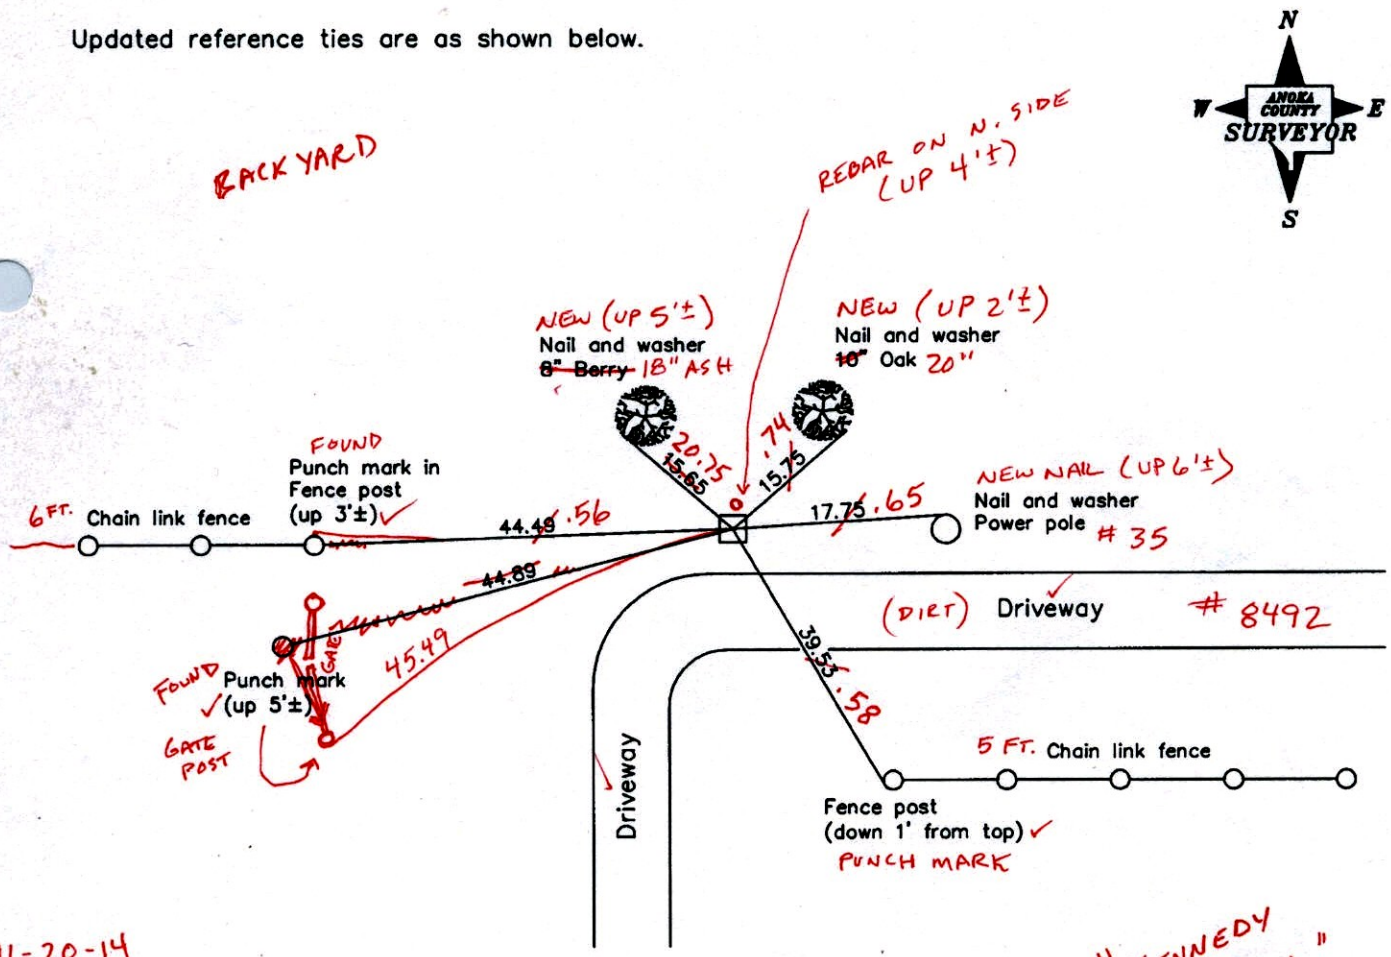

11-20-14
BK-55
TOTAL STA.

"KENNEDY PARK"

Revised date
8/08/89
8/03/94
8/18/08

N.A.D. 1983 Coordinates (1996 Adjustment)

County Project Coordinates	
Northing	132472.4087
Easting	494124.5336
Date	12/15/04

I hereby certify that this United States public land survey monument record is correct and complete to the best of my knowledge and belief.

Larry D. Hoium Date 11/06/08

Larry D. Hoium, Anoka County Surveyor

Minnesota License Number 18165

CERTIFICATE OF LOCATION OF GOVERNMENT CORNER

County of Anoka State of Minnesota

Northwest Corner of Sec. 3 Township 30 Range 24

On the 10th day of April, 1943, the described corner was evidenced by a granite monument

and to perpetuate the location of said corner, at the exact location thereof, a permanent marker was placed consisting of the same granite monument

AND on the 18th day of August, 2008, said permanent marker was found and the ties were updated

Updated reference ties are as shown below.

N
W ANOKA COUNTY SURVEYOR E
S

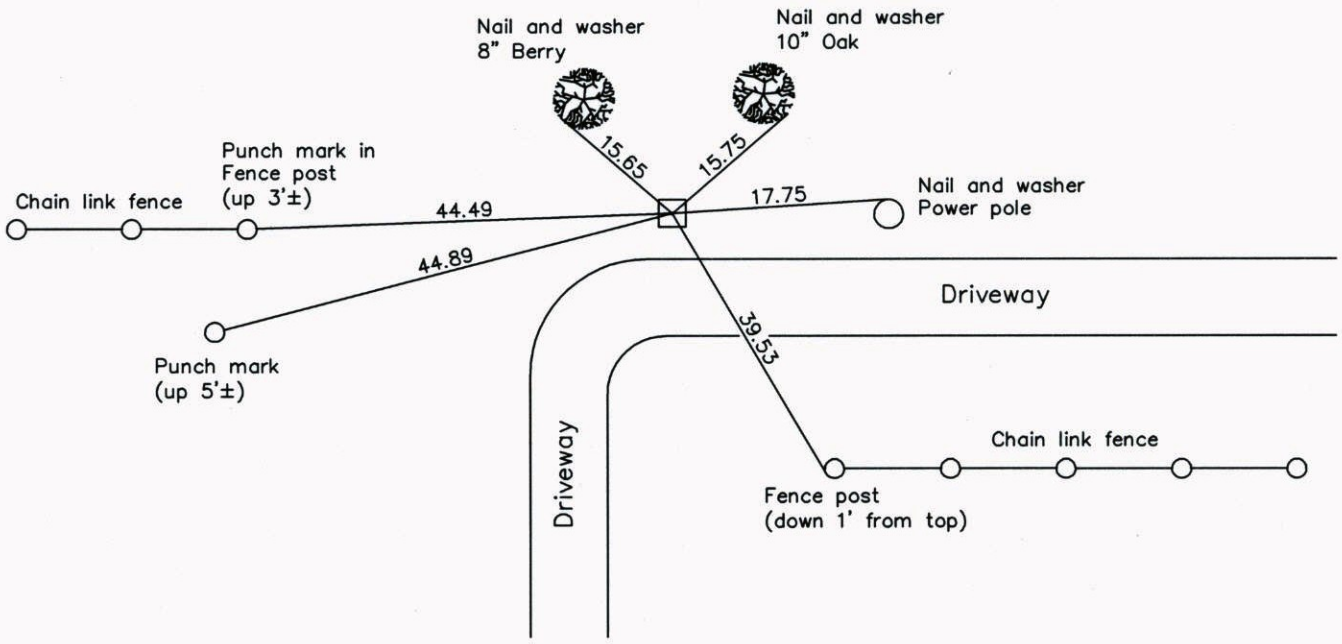

Revised date
8/08/89
8/03/94
8/18/08

N.A.D. 1983 Coordinates
(1996 Adjustment)

County Project Coordinates	
Northing	132472.4087
Easting	494124.5336
Date	12/15/04

I hereby certify that this United States public land survey monument record is correct and complete to the best of my knowledge and belief.

Larry D. Hoium Date 11/06/08

Larry D. Hoium, Anoka County Surveyor

Minnesota License Number 18165

CERTIFICATE OF LOCATION OF GOVERNMENT CORNER

County of Anoka State of Minnesota

NORTHWEST Corner of Sec. 3 Township 30 Range 24

I hereby certify that on the 10 day of APRIL, 1943, I found the described corner which was evidenced by GRANITE MON.

and I further certify that to perpetuate the location of said corner, I did, at the exact location thereof, place a permanent marker consisting of SAME

which reference or witness monuments are located in the manner following:

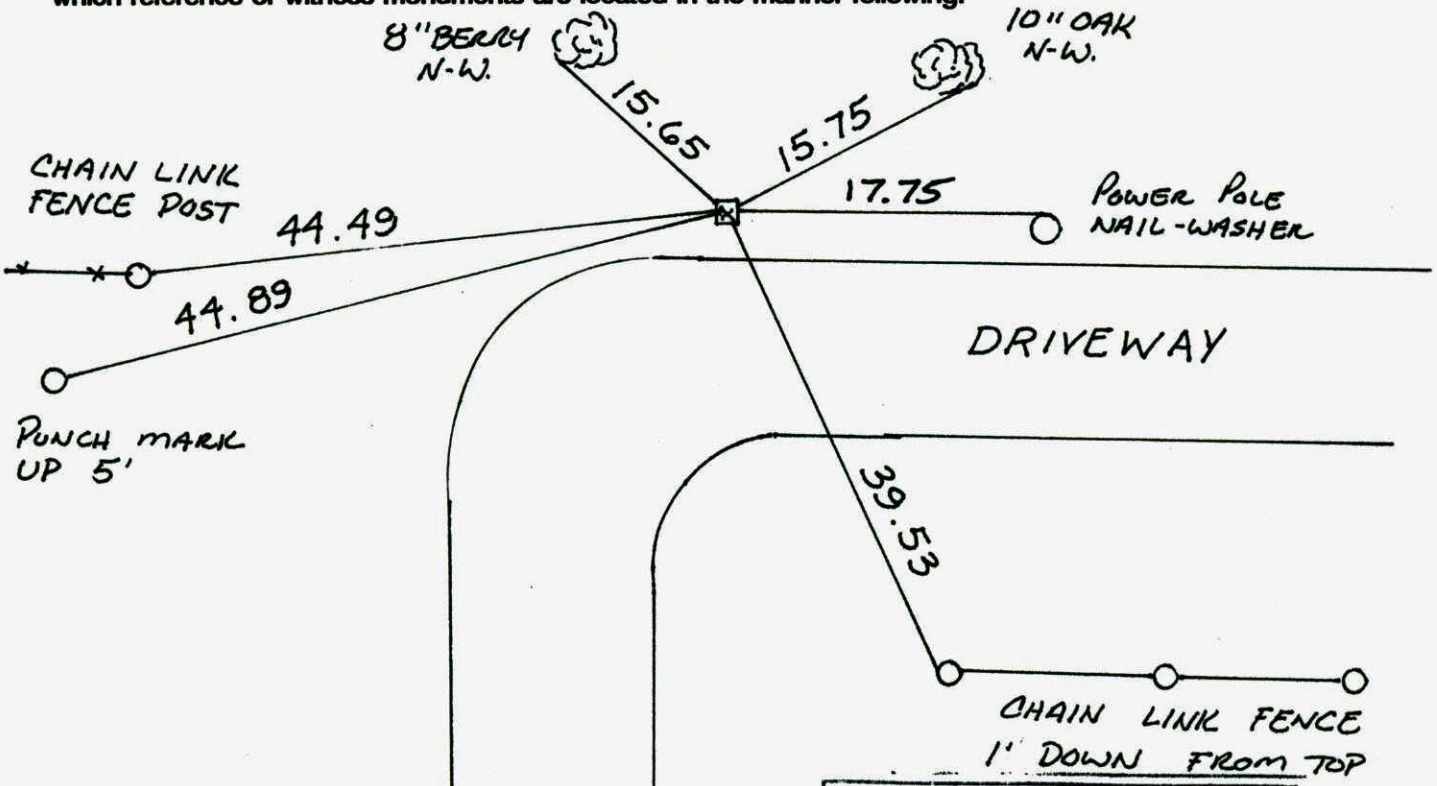

I hereby certify that this United States public land survey monument record is correct and complete to the best of my knowledge and belief.

Larry D. Holum Date 11/6/08

LARRY D. HOLUM, Anoka County Surveyor

Minnesota License Number 18165

N.A.D. 1983 Co-ordinates

County Project Co-ordinates

Northing 132472.4087

Easting 494124.5336

State Plane Co-ordinates

Y

X

Date 12/15/04

ANOKA COUNTY SURVEYOR

Revised date	Revised date	Revised date
8-8-89		
8-3-94		
8-18-08		

CERTIFICATE OF LOCATION OF GOVERNMENT CORNER

County of Anoka State of Minnesota

NORTHWEST Corner of Sec. 3 Township 30 Range 24

I hereby certify that on the 10 day of APRIL, 19 43, I found the described corner which was evidenced by GRANITE MON.

and I further certify that to perpetuate the location of said corner, I did, at the exact location thereof, place a permanent marker consisting of SAME

which reference or witness monuments are located in the manner following:

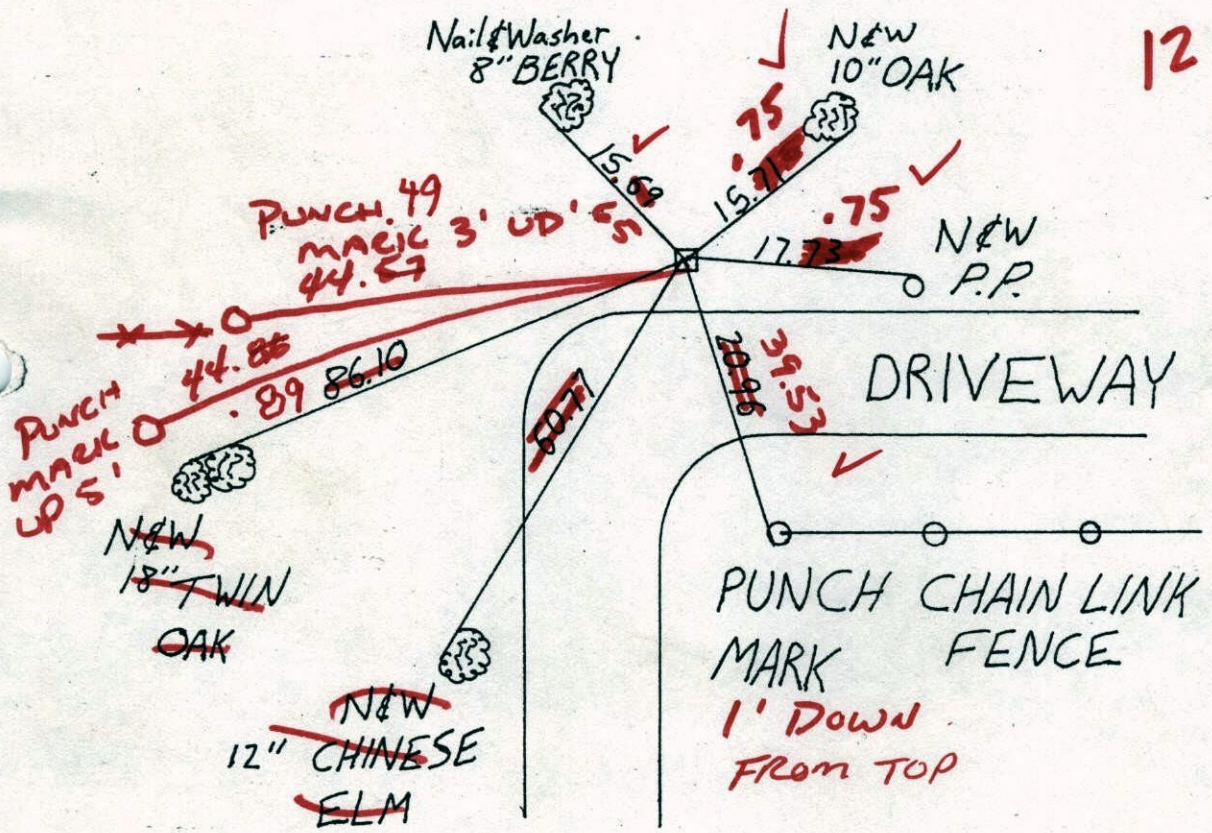

12-15-04
GPS'D

8-18-08

Revised date	Revised date	Revised date
8-8-89		
8-3-94		

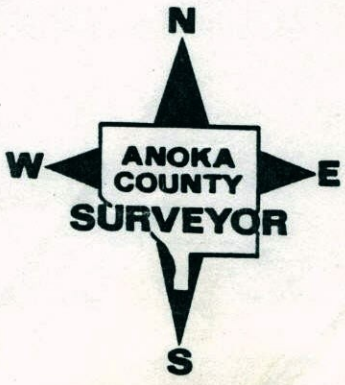

NW Sec. 3 Tw. 30 R. 24

RETIE GRANITE MON.

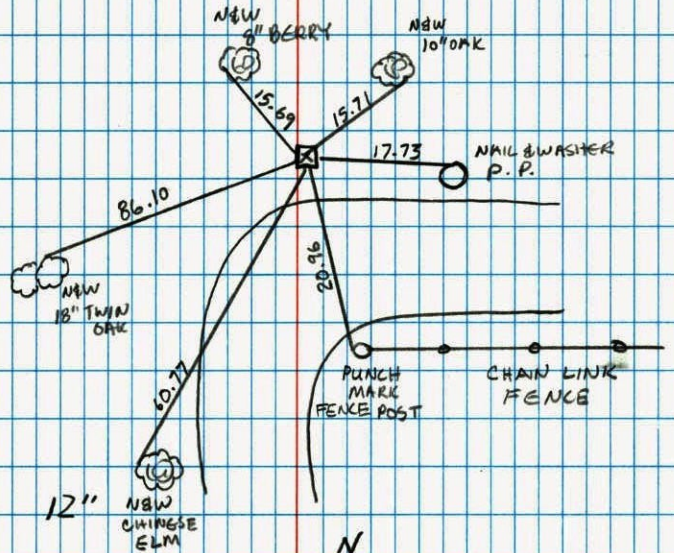

8-3-94

JOSH & JAYME ANDERSON

NO. 446 NATIONAL PRINTFAST

NORTHWEST COR. SECTION 3 T30 R24

RETIED GRANITE MON.

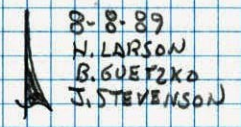

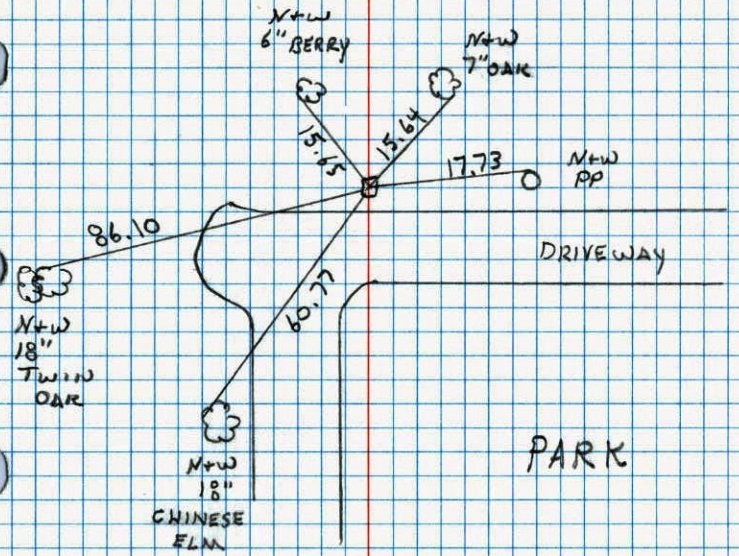

NO. 448 TELEDYNE

8

N.W. Corner Sec. 3 T. 30 R. 24

8"x8" Granite Mon'l. up 0.3'±
Iron on North

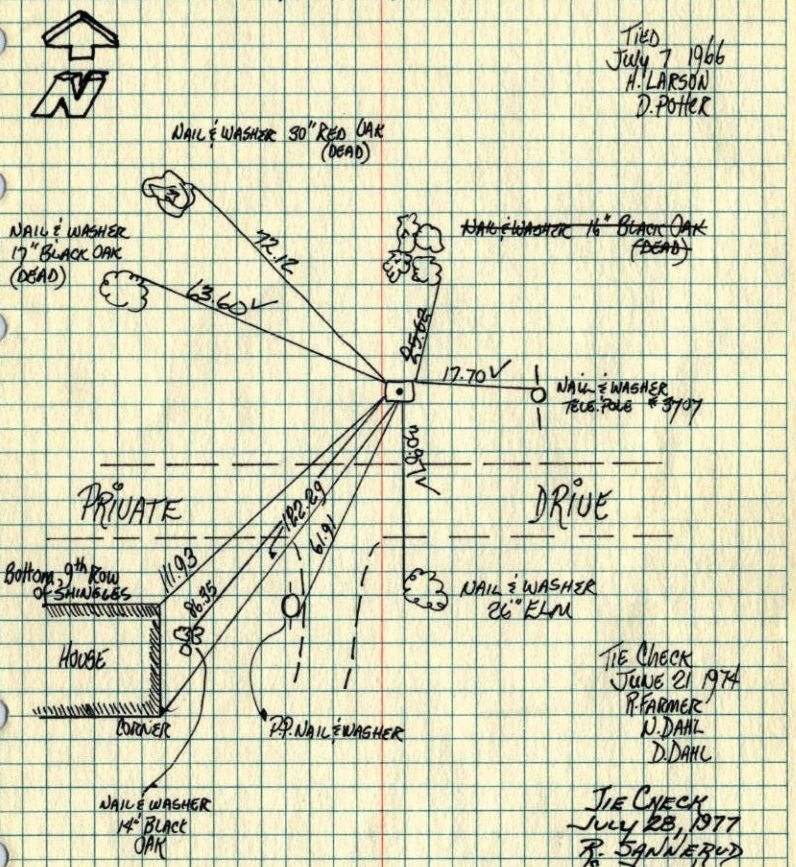

ROLAND W. ANDERSON
COUNTY SURVEYOR
ANOKA COUNTY, MINNESOTA

TEMPERATURE CORRECTED AND HORIZONTALLY TAPED MEASUREMENTS

1974 8

NW Cor. Sec. 3-T30-R24

8"x8" Granite up 0.3'
Iron on North

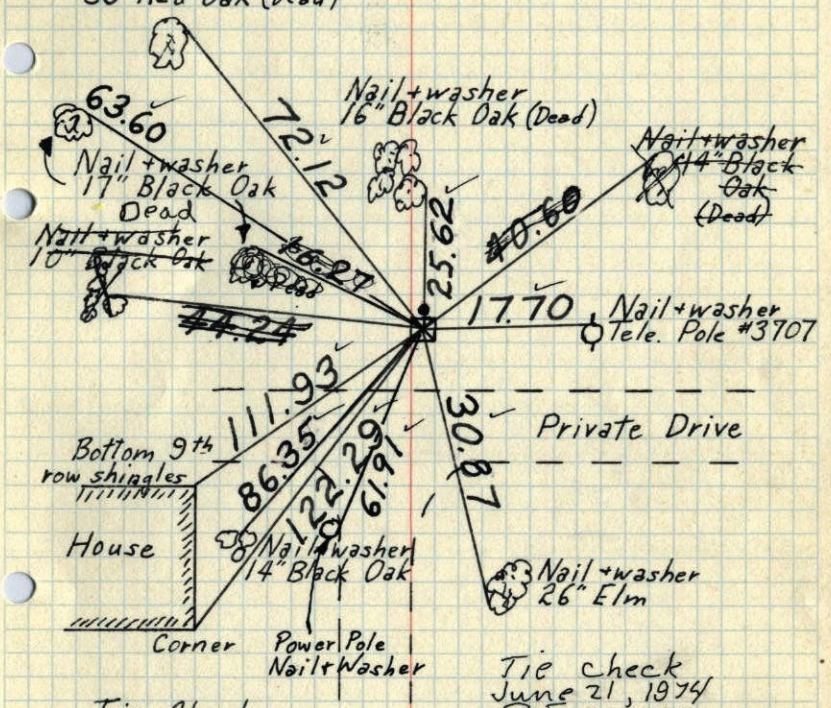

Tie Check
July 7, 1966
H. Larson
D. Potter

Tie check
June 21, 1974
R Farmer
N Dahl
D Dahl

August 20, 1970
D. Powell
R. Brien
B. Olson

TEMPERATURE CORRECTED AND HORIZONTALLY TAPED MEASUREMENTS

ROLAND W. ANDERSON
COUNTY SURVEYOR
ANOKA COUNTY, MINNESOTA

1970 8

NW Cor. Sec. 3-T30-R24

8"x8" Granite up 0.3'
Iron on North

8/20/70
#10-80
D.Powell
R.Brien
B.Olson

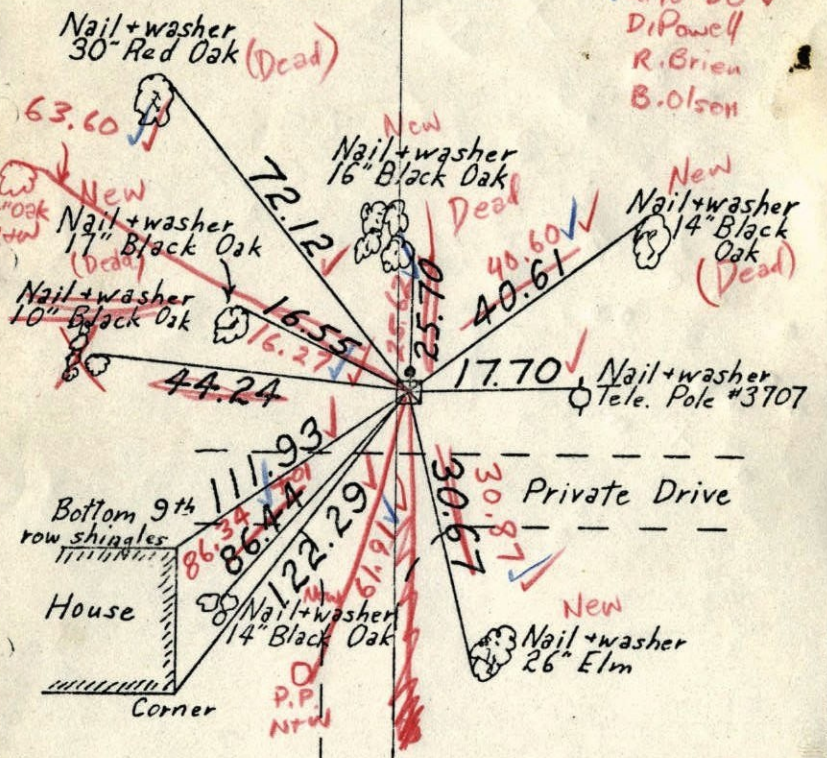

Tie Check
July 7, 1966
H. Larson
D. Potter

TEMPERATURE CORRECTED
AND HORIZONTALLY
TAPED MEASUREMENTS

ROLAND W. ANDERSON
COUNTY SURVEYOR
ANOKA COUNTY, MINNESOTA

X Doxe 1946 6

NW Cor. Sec 3 - T30 - R24

8"x 8" Granite up .3'
Iron on North

Checked 14 May 64, J.O.

Tie-check
7-7-66
H. Larson
D. Potter

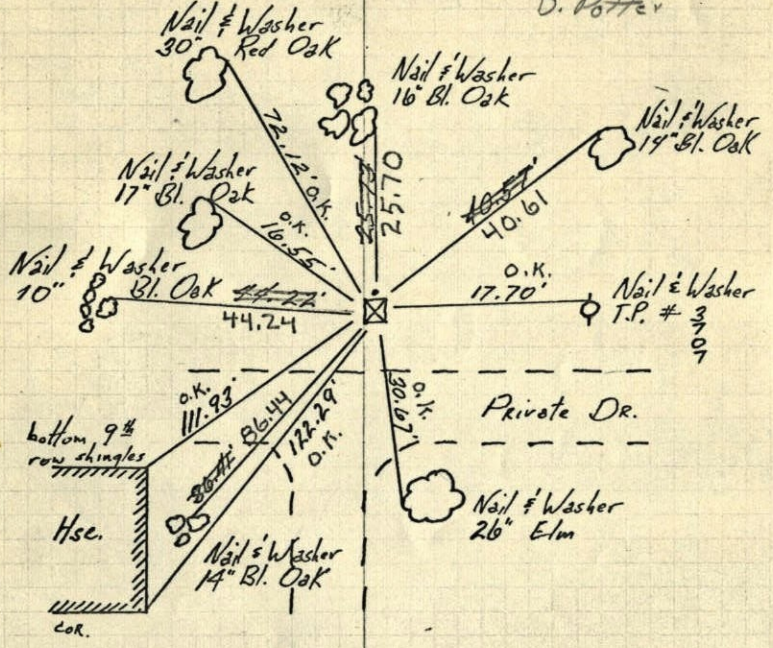

TEMPERATURE CORRECTED
AND HORIZONTALLY
TAPED MEASUREMENTS

6/29/60
O. Potter
K. Robinson

ROLAND W. ANDERSON
COUNTY SURVEYOR
ANOKA COUNTY, MINNESOTA

1960 6

NW Cor. Sec 3 – T30 – R24

8"x8" Granite up .3'
Iron on North

Checked 14 May 64, J.O.

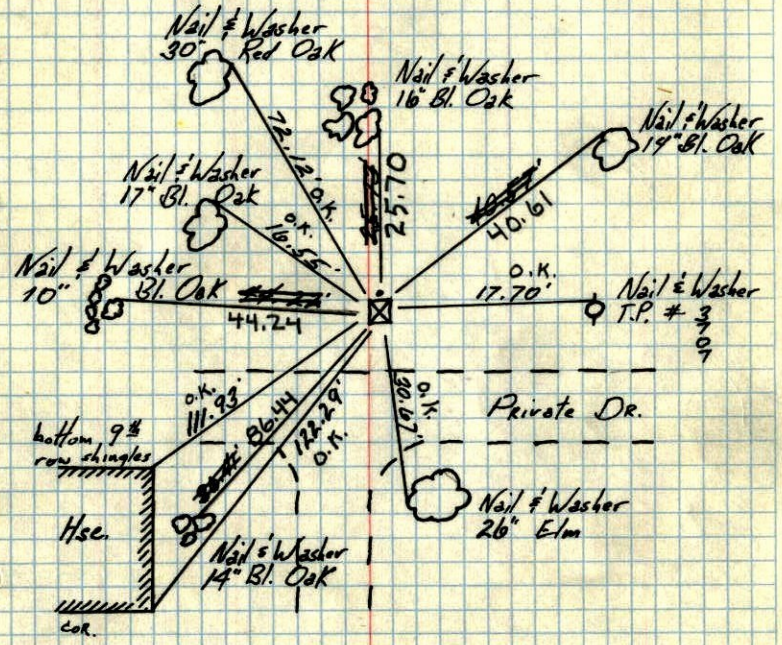

TEMPERATURE CORRECTED AND HORIZONTALLY TAPED MEASUREMENTS

6/29/60
O. Potter
K. Robinson

ROLAND W. ANDERSON
COUNTY SURVEYOR
ANOKA COUNTY, MINNESOTA

1960

NW Cor. Sec. 3, T30, R 24

8"x8" Granite up .3'
Iron on North

6/29/60

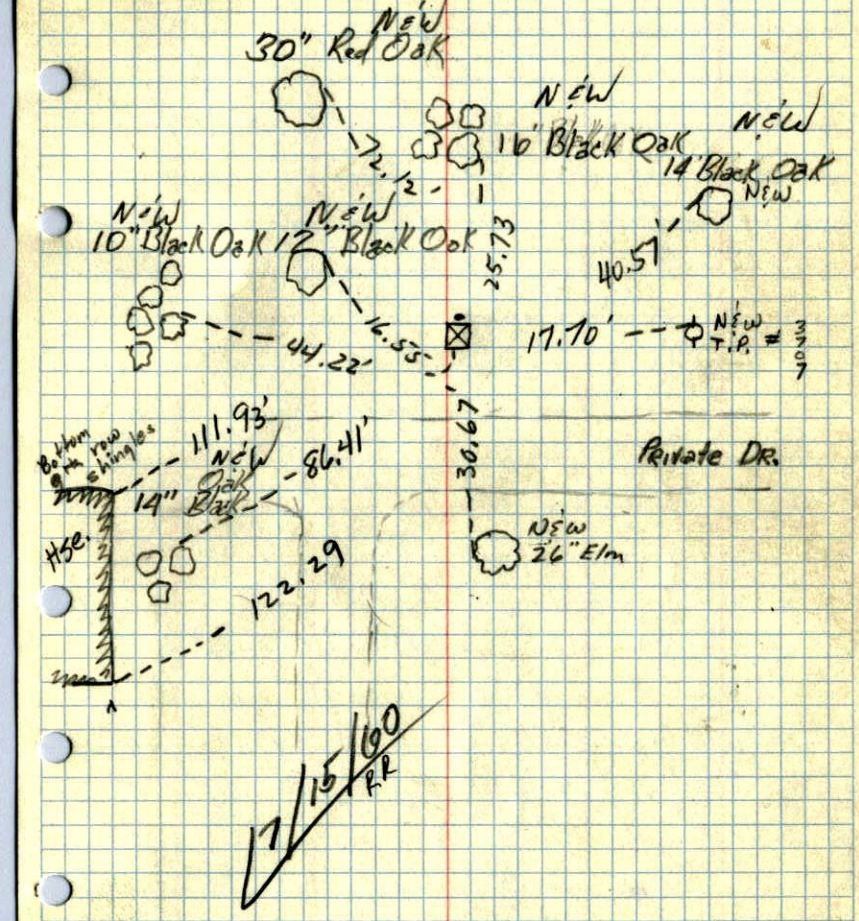

1943 13 ✓

NW. Corner of Sec. 3 T 30 N. R. 24W
Granite 8" x 8" up 4"

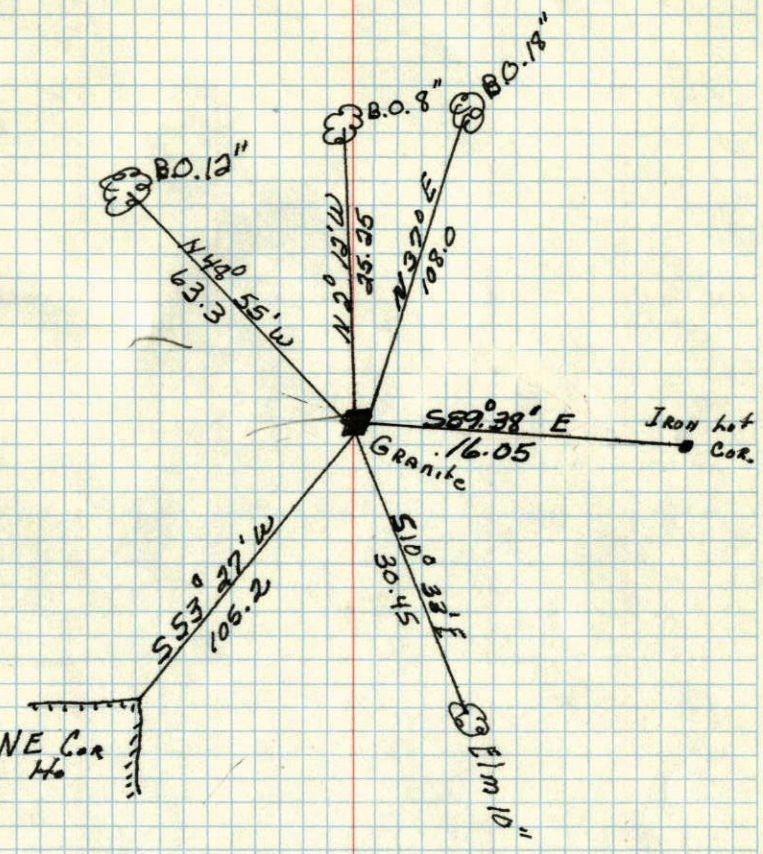

April 10, 1943
Harvey A Cartwright