

# CERTIFICATE OF LOCATION OF GOVERNMENT CORNER

County of Anoka State of Minnesota


## South 1/4 Corner of Sec. 34 Township 30 Range 24

On the 15th day of September, 1960, the described corner was evidenced by a brass monument in concrete

and to perpetuate the location of said corner, at the exact location thereof, a permanent marker was placed consisting of the same brass monument (DOWN 1" IN COVERED TUBE IN CONC.)

AND on the 1st day of October, 2008, said permanent marker was found and the ties were updated

Updated reference ties are as shown below.

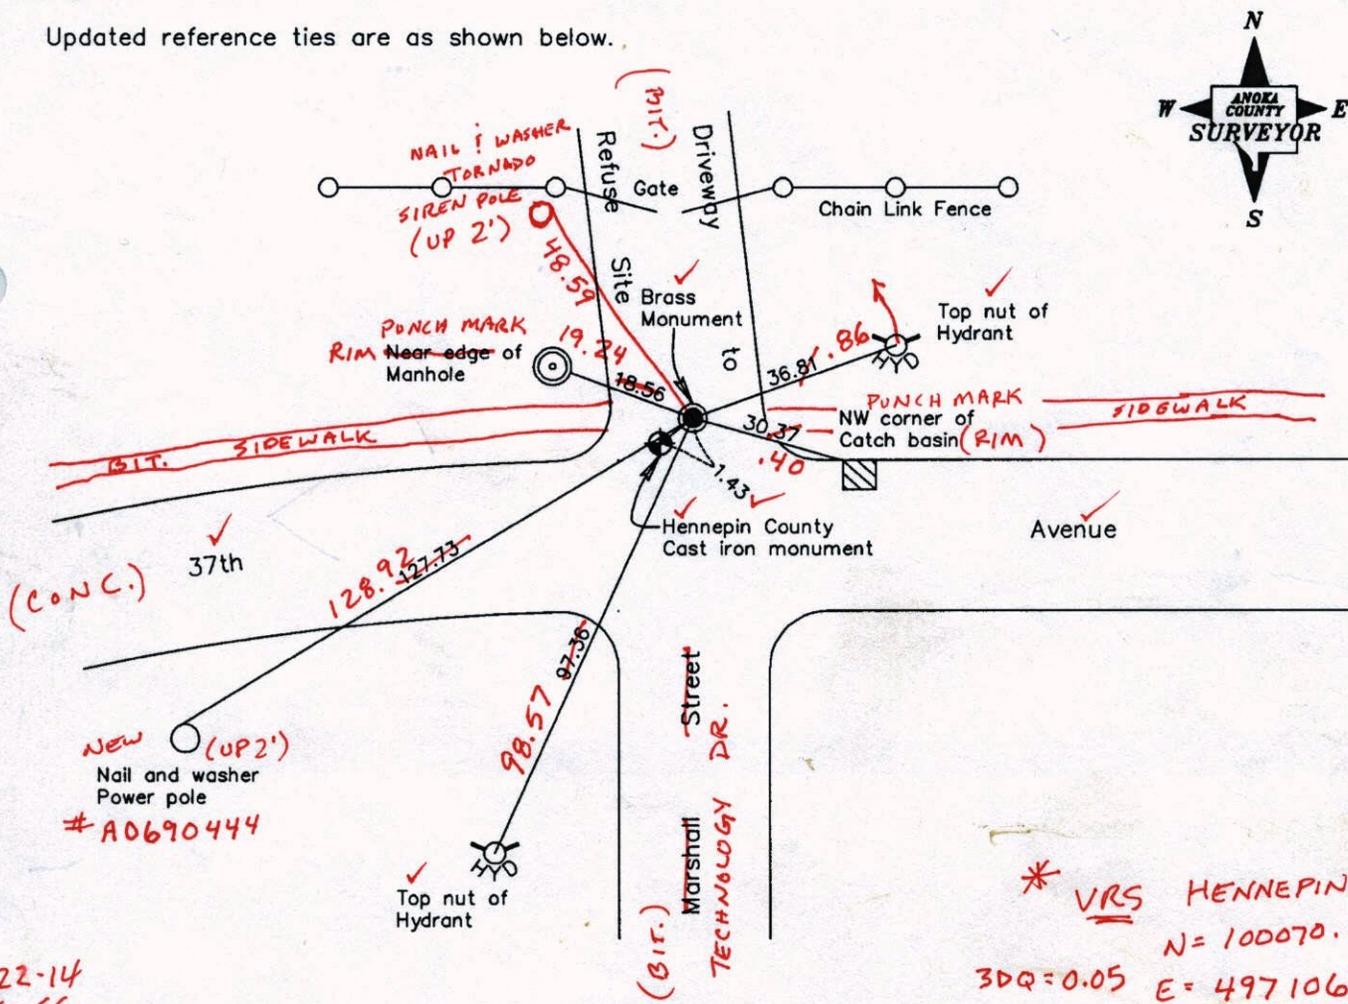

\* VRS HENNEPIN CO. MON.  
 N = 100070.0602  
 3DQ = 0.05 E = 497106.5304

10-22-14  
 BK-55

TOTAL

Revised date
8/02/89
8/01/94
10/01/08

STA. VRS

N.A.D. 1983 Coordinates (1996 Adjustment)	
County Project Coordinates	
Northing	100070.0723
Easting	497106.5480
Date	2/16/05

I hereby certify that this United States public land survey monument record is correct and complete to the best of my knowledge and belief.

*Larry D. Hoium* Date 11/10/08

Larry D. Hoium, Anoka County Surveyor  
 Minnesota License Number 18165

3DQ = 0.06 N = 100071.2280 E = 497107.3470

# CERTIFICATE OF LOCATION OF GOVERNMENT CORNER

County of Anoka

State of Minnesota

## South 1/4 Corner of Sec. 34 Township 30 Range 24



On the 15th day of September, 1960, the described corner was evidenced by a brass monument in concrete

and to perpetuate the location of said corner, at the exact location thereof, a permanent marker was placed consisting of ~~the same brass monument~~ HENNEPIN CO. C.I.M.

AND on the 22nd day of October, 2014, said permanent marker was found down 1'± in concrete and in a covered tube. The ties were updated.

Updated reference ties are as shown below.

4-2-15 DIST.'S TO HENNEPIN CO. C.I.M.

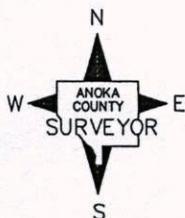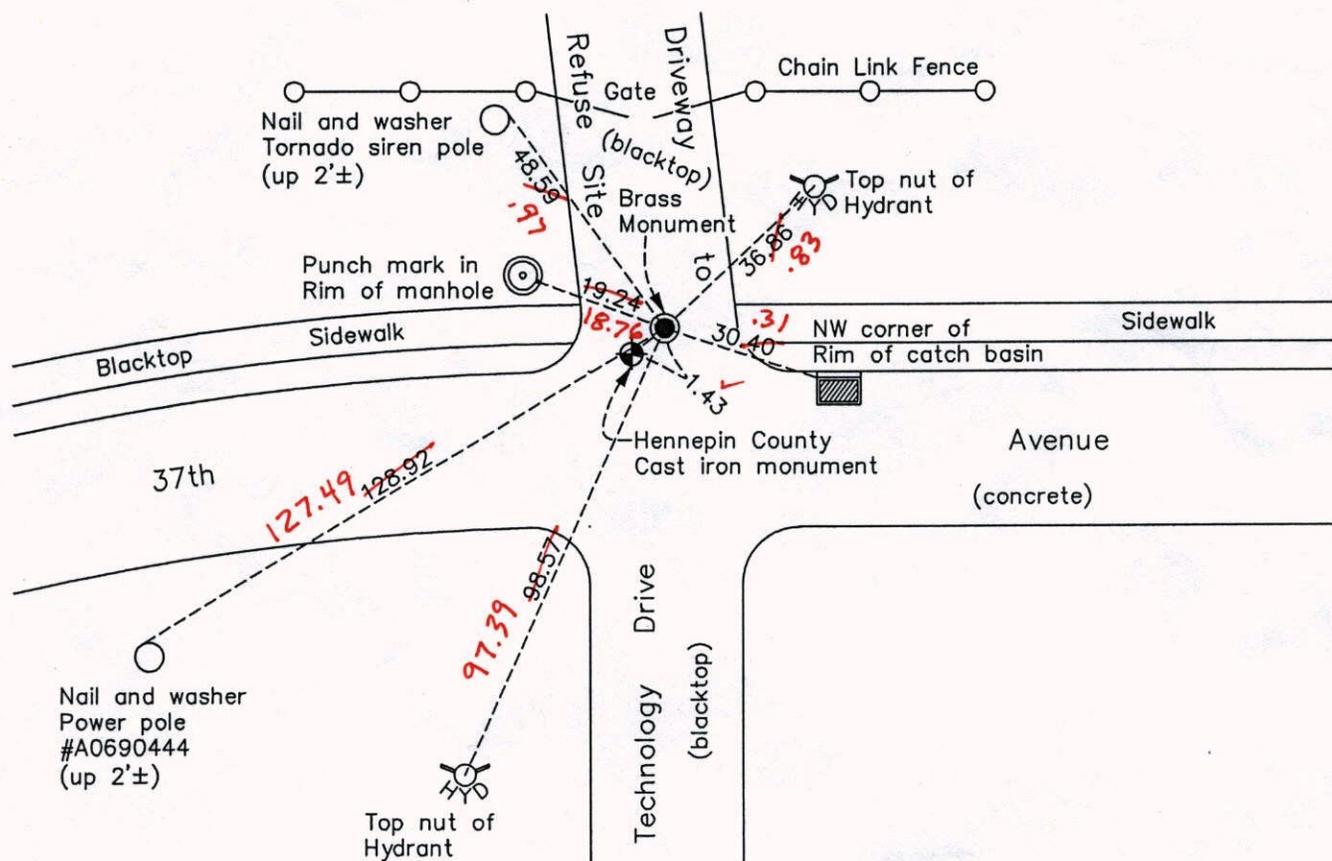

(Hennepin County Cast Iron Monument)  
N.A.D. 1983 Coordinates  
(1996 Adjustment)

County Project Coordinates	
Northing	100070.0723
Easting	497106.5480
Date	2/16/05

Revision Date

4/01/15

I hereby certify that this United States public land survey monument record is correct and complete to the best of my knowledge and belief.

*Larry D. Hoium* Date 4/01/15  
 Larry D. Hoium, Anoka County Surveyor  
 Minnesota License Number 18165

# CERTIFICATE OF LOCATION OF GOVERNMENT CORNER

County of Anoka

State of Minnesota



South  $\frac{1}{4}$  Corner of Sec. 34 Township 30 Range 24

On the 15th day of September, 1960, the described corner was evidenced by a brass monument in concrete

and to perpetuate the location of said corner, at the exact location thereof, a permanent marker was placed consisting of the same brass monument

AND on the 1st day of October, 2008, said permanent marker was found and the ties were updated

Updated reference ties are as shown below.

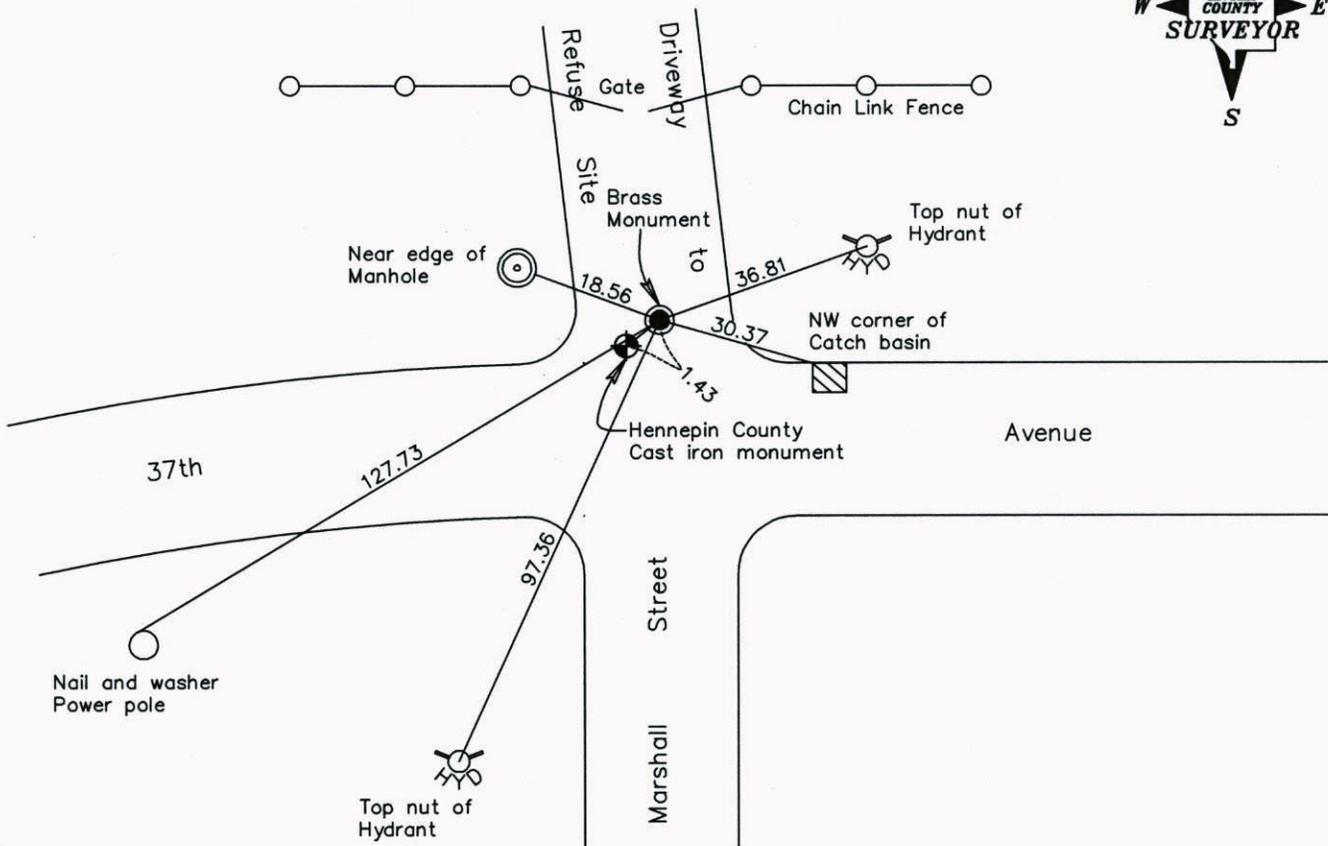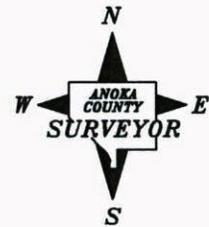

**Revised date**

8/02/89
8/01/94
10/01/08

**N.A.D. 1983 Coordinates  
(1996 Adjustment)**

<b>County Project Coordinates</b>	
Northing	<u>100070.0723</u>
Easting	<u>497106.5480</u>
Date	<u>2/16/05</u>

I hereby certify that this United States public land survey monument record is correct and complete to the best of my knowledge and belief.

*Larry D. Hoium* Date 11/10/08  
 \_\_\_\_\_, Anoka County Surveyor  
 Minnesota License Number 18165

# CERTIFICATE OF LOCATION OF GOVERNMENT CORNER

County of Anoka


State of Minnesota

SOUTH QTR. Corner of Sec. 34 Township 30 Range 24

I hereby certify that on the 15<sup>TH</sup> day of SEPTEMBER, 19 60, I found the described corner which was evidenced by BRASS MONUMENT IN CONCRETE

and I further certify that to perpetuate the location of said corner, I did, at the exact location thereof, place a permanent marker consisting of HENNEPIN COUNTY CAST IRON MONUMENT

which reference or witness monuments are located in the manner following:

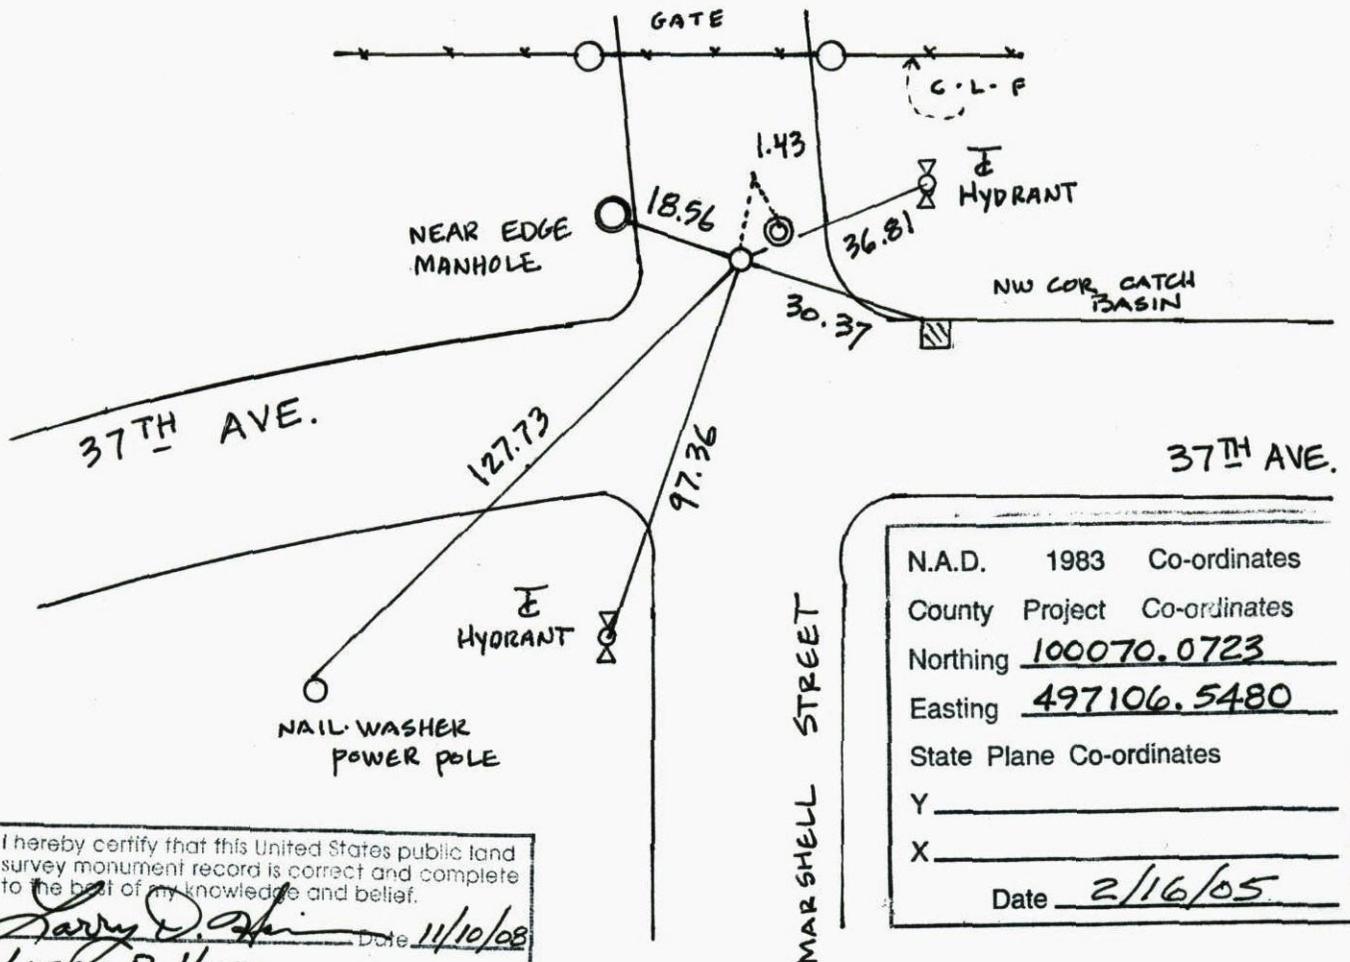


N.A.D.	1983	Co-ordinates
County	Project	Co-ordinates
Northing	<u>100070.0723</u>	
Easting	<u>497106.5480</u>	
State Plane Co-ordinates		
Y	_____	
X	_____	
Date	<u>2/16/05</u>	

I hereby certify that this United States public land survey monument record is correct and complete to the best of my knowledge and belief.

*Larry D. Hoium* Date 11/10/08  
**LARRY D. HOIUM**, Anoka County Surveyor  
 Minnesota License Number 18165

Revised date	Revised date	Revised date
<u>6.24.86</u>		
<u>8.2.89</u>		
<u>8.1.94</u>		
<u>10.1.08</u>		

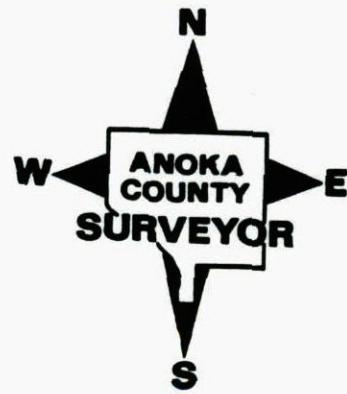

# CERTIFICATE OF LOCATION OF GOVERNMENT CORNER

County of Anoka


State of Minnesota

SOUTH 1/4 Corner of Sec. 34 Township 30 Range 24


I hereby certify that on the 15<sup>TH</sup> day of SEPT., 19 60, I found the described corner which was evidenced by BRASS MONUMENT IN CONCRETE

and I further certify that to perpetuate the location of said corner, I did, at the exact location thereof, place a permanent marker consisting of SAME HENNEPIN CO. CAST IRON MON.

which reference or witness monuments are located in the manner following:

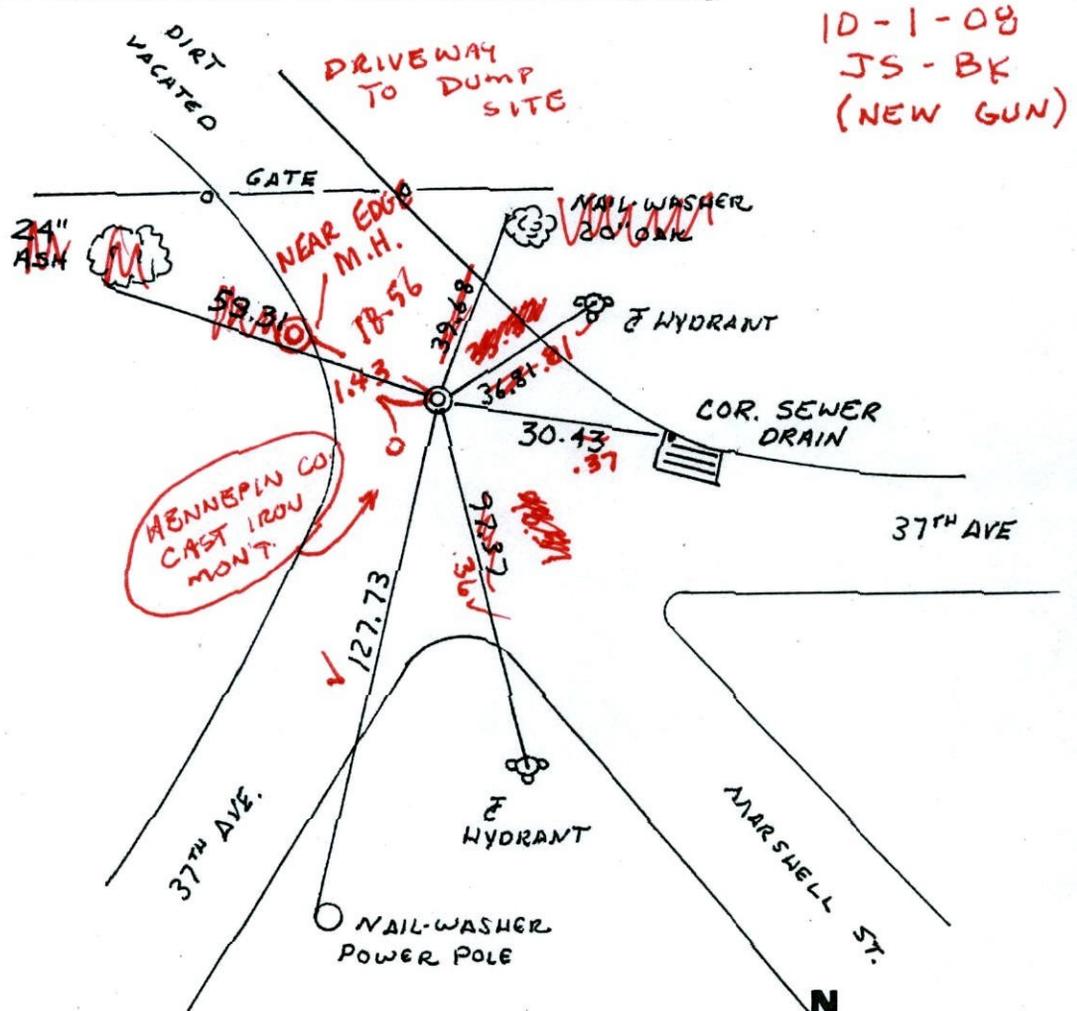


Revised date	Revised date	Revised date
6-24-86		
8-2-89		
8-1-94		

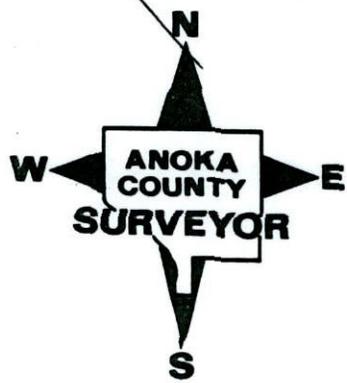

5/4 Sec. 34 Tw. 30 R. 24

RETIE BRASS/CONCRETE  
MONUMENT

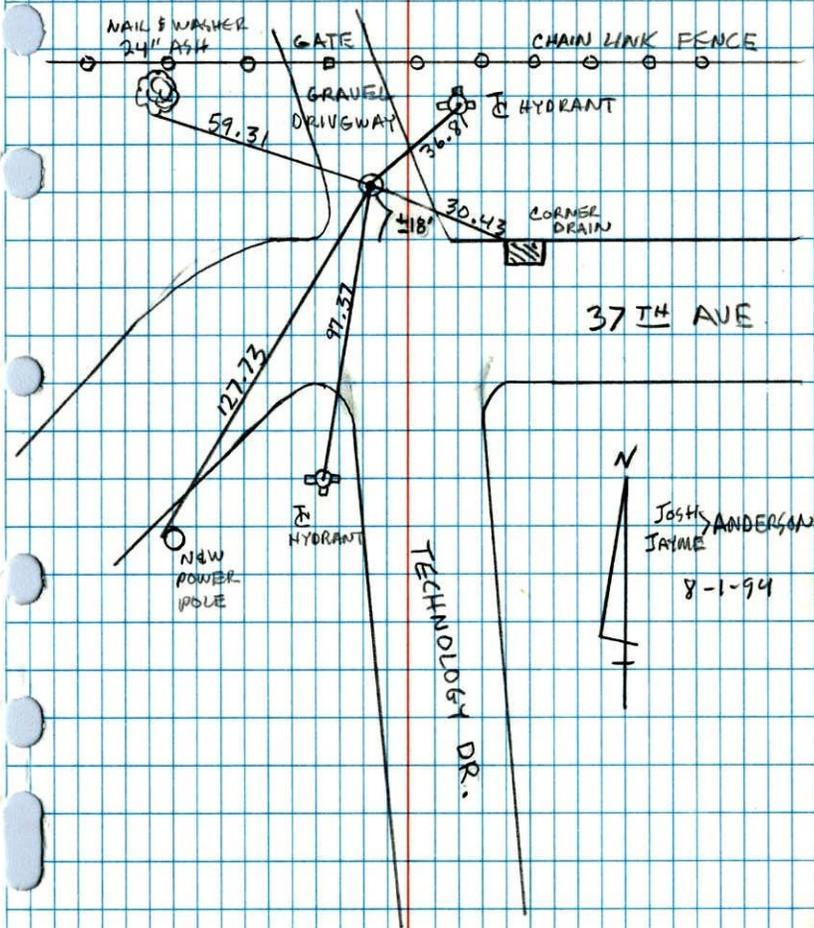


NO. 446 NATIONAL PRINTFAST

5/4 CORNER SECTION 34-T30-R24

BRASS MONUMENT IN CONCRETE, DOWN 1.5\"/>

15 SEP 60  
D. POTTER  
R. CARLSON

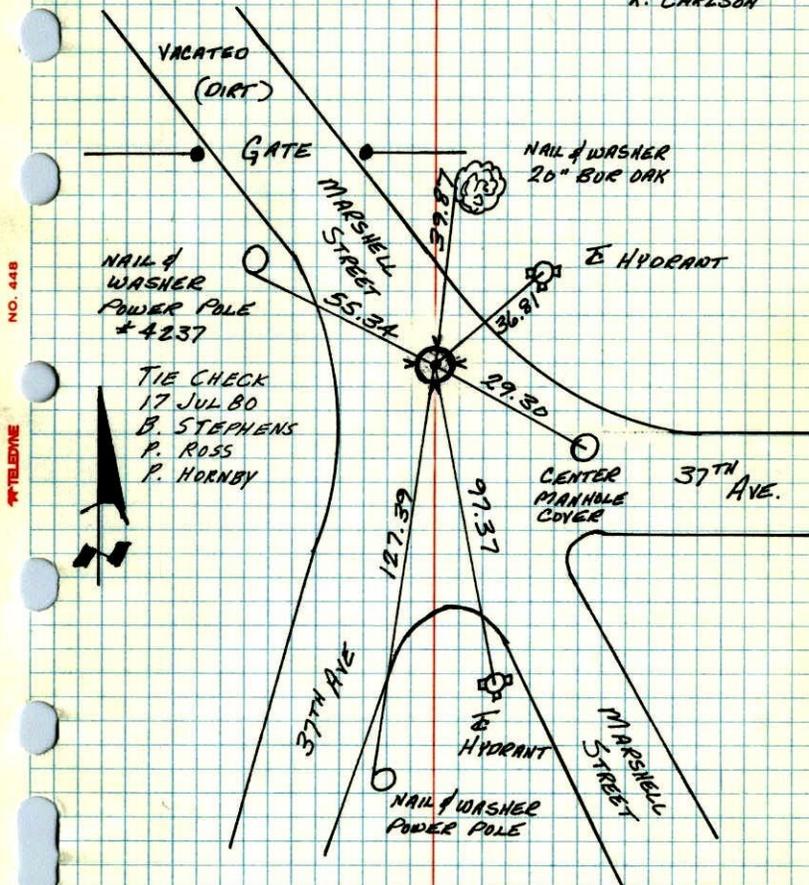

NO. 446 NATIONAL PRINTFAST

TEMPERATURE CORRECTED  
AND HORIZONTALLY  
TAPED MEASUREMENTS


ROLAND W. ANDERSON  
COUNTY SURVEYOR  
ANOKA COUNTY, MINNESOTA

81  
S 1/4 Cor. Sec 34 - T30 - R24

Brass Monument in Concrete down  
1.5' Inside Cast Iron Casing with  
removable cover. of Mpls.

Control Survey # 1001.

Filed "V" Notches in Cast Iron Casing for  
intersecting lines.

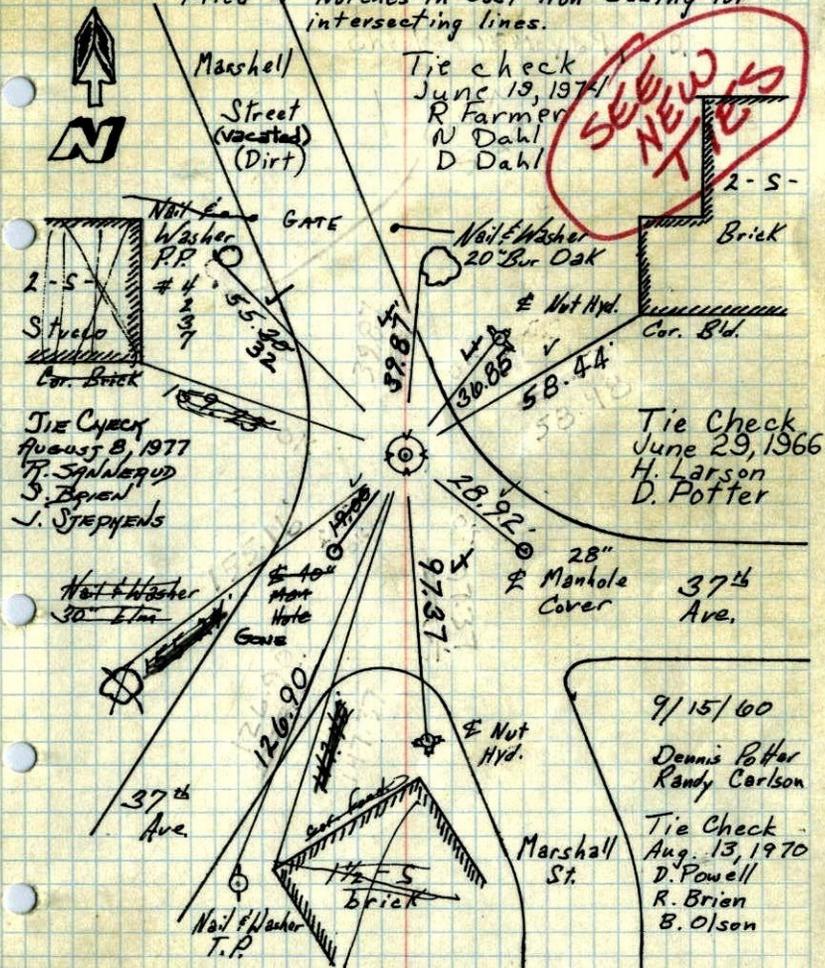


TEMPERATURE CORRECTED ROLAND W. ANDERSON  
AND HORIZONTALLY  
TAPED MEASUREMENTS

COUNTY SURVEYOR  
ANOKA COUNTY, MINNESOTA

73  
1970  
X  
brass mon. in Conc.  
down 1.5' Inside Cast Iron  
casing with Removable Cover  
S 1/4 Cor. Sec 34 - T30 - R24

Cast Iron Mon. - Down 1.5',  
Cement floor of Mpls. Filed "V"  
Control Survey # 1001. Notches in  
C.I. Casing  
for intersecting

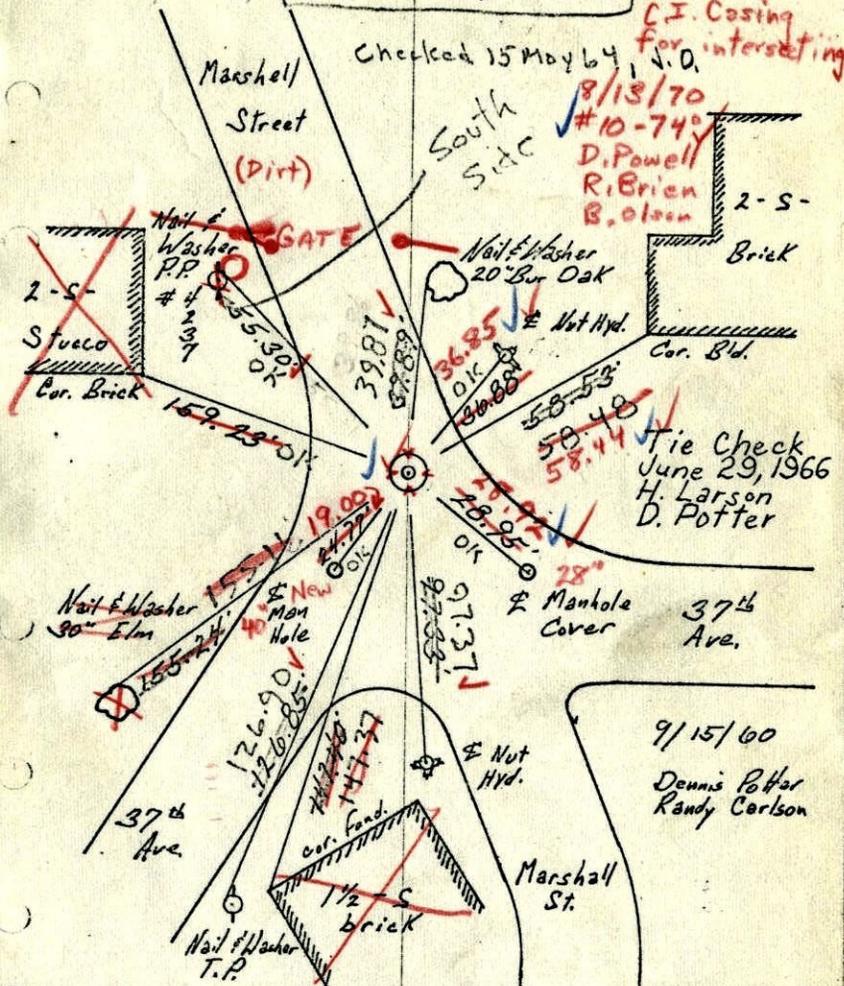

TEMPERATURE CORRECTED ROLAND W. ANDERSON  
AND HORIZONTALLY  
TAPED MEASUREMENTS

COUNTY SURVEYOR  
ANOKA COUNTY, MINNESOTA


1960

S<sup>1</sup>/<sub>4</sub> Sec. 34, T30, R24  
Cast Iron Man. 10" Diameter in  
Cement flush of Minneapolis  
Central Survey #1001

9/15/60


65° TC

Randy Carlson  
Dennis Potter

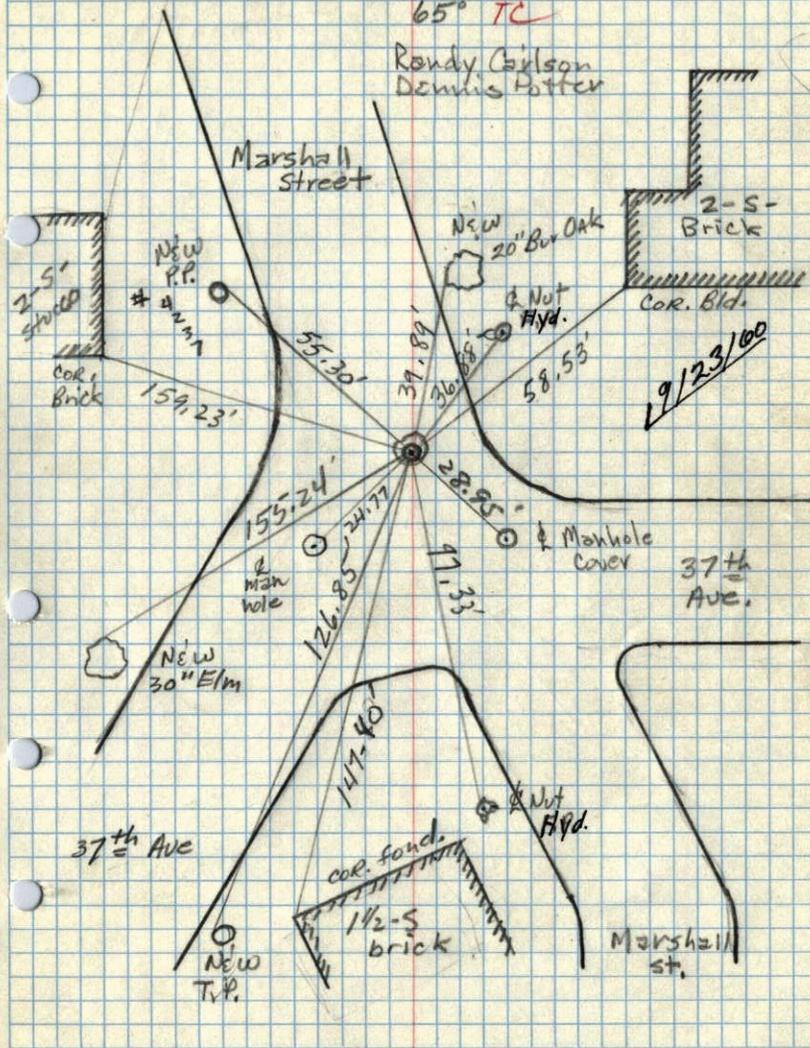

1943<sup>55</sup>

S<sup>1</sup>/<sub>4</sub> CORNER of Section 34, T.30, R.24  
Cast Iron Man. in cement, flush 10" diam. of Mpls.  
Central Survey #1001

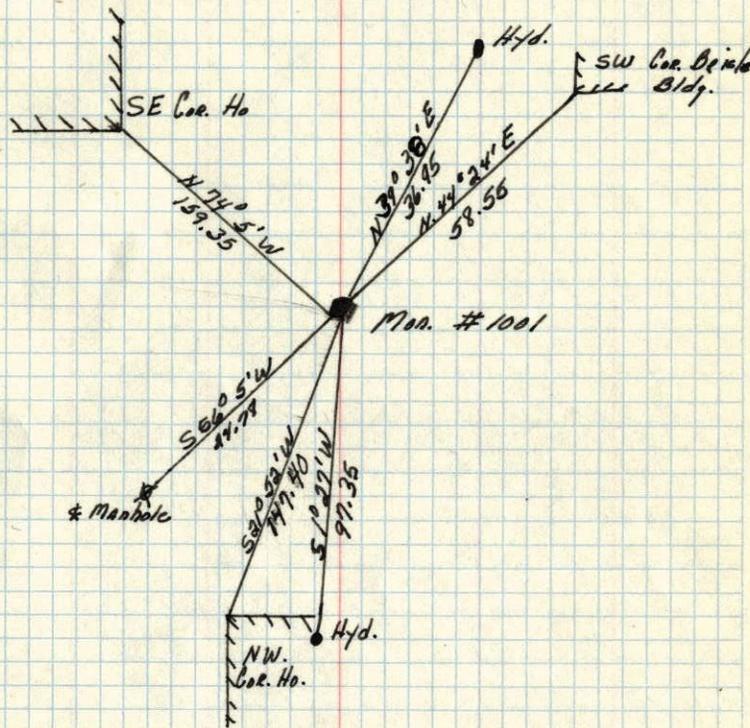

April 10, 1943  
Harvey A. Cartwright