

CERTIFICATE OF LOCATION OF GOVERNMENT CORNER

County of Anoka

State of Minnesota


North 1/4 Corner of Sec. 6 Township 32 Range 23

I hereby certify that on the 21st day of November, 1978, I found the described corner which was evidenced by area resurvey

and I further certify that to perpetuate the location of said corner, I did, at the exact location thereof, place a permanent marker consisting of a red and white iron pipe with tel^spar and sign

(up 5' +/-) TELESPAR - SIGN FACING NORTH

which reference or witness monuments are located in the manner following:

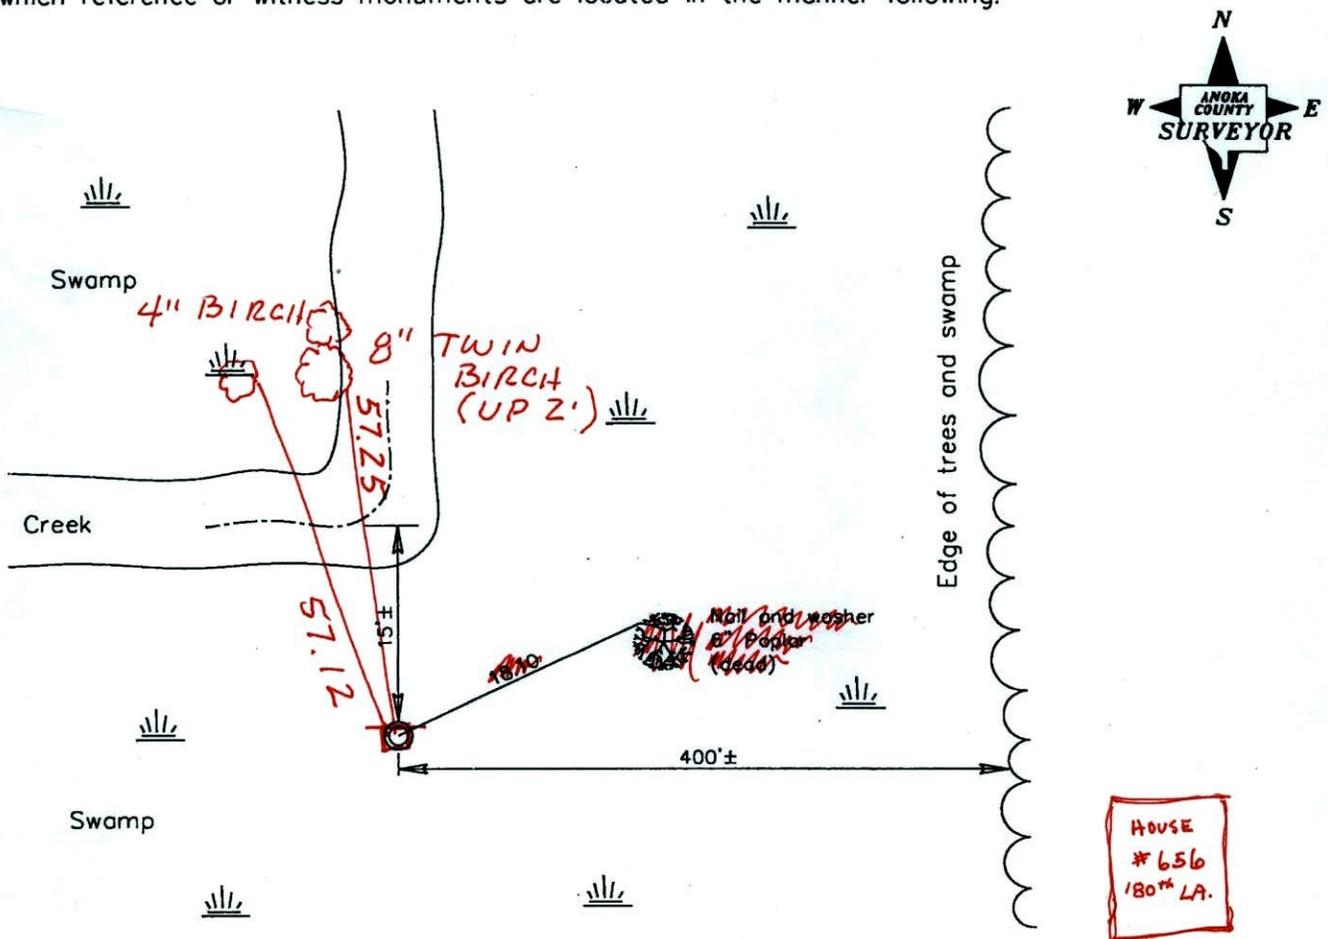

Revised date

6/22/81
7/02/87
12/07/99
1/02/02
3-10-11

BK-SS

TAPED

N.A.D. 1983 Coordinates
(1996 adjustment)

County Project Coordinates	State Plane Coordinates
Northing <u>195826.0137</u>	Y _____
Easting <u>503070.3057</u>	X _____

Date 1/02/02

CERTIFICATE OF LOCATION OF GOVERNMENT CORNER

County of Anoka


State of Minnesota

NORTH 1/4 Corner of Sec. 6 Township 32 Range 23

I hereby certify that on the 21 day of NOVEMBER, 19 78, I found the described corner which was evidenced by RESURVEY


and I further certify that to perpetuate the location of said corner, I did, at the exact location thereof, place a permanent marker consisting of RED AND WHITE I.P. TELSPAR W. SIGN

which reference or witness monuments are located in the manner following:

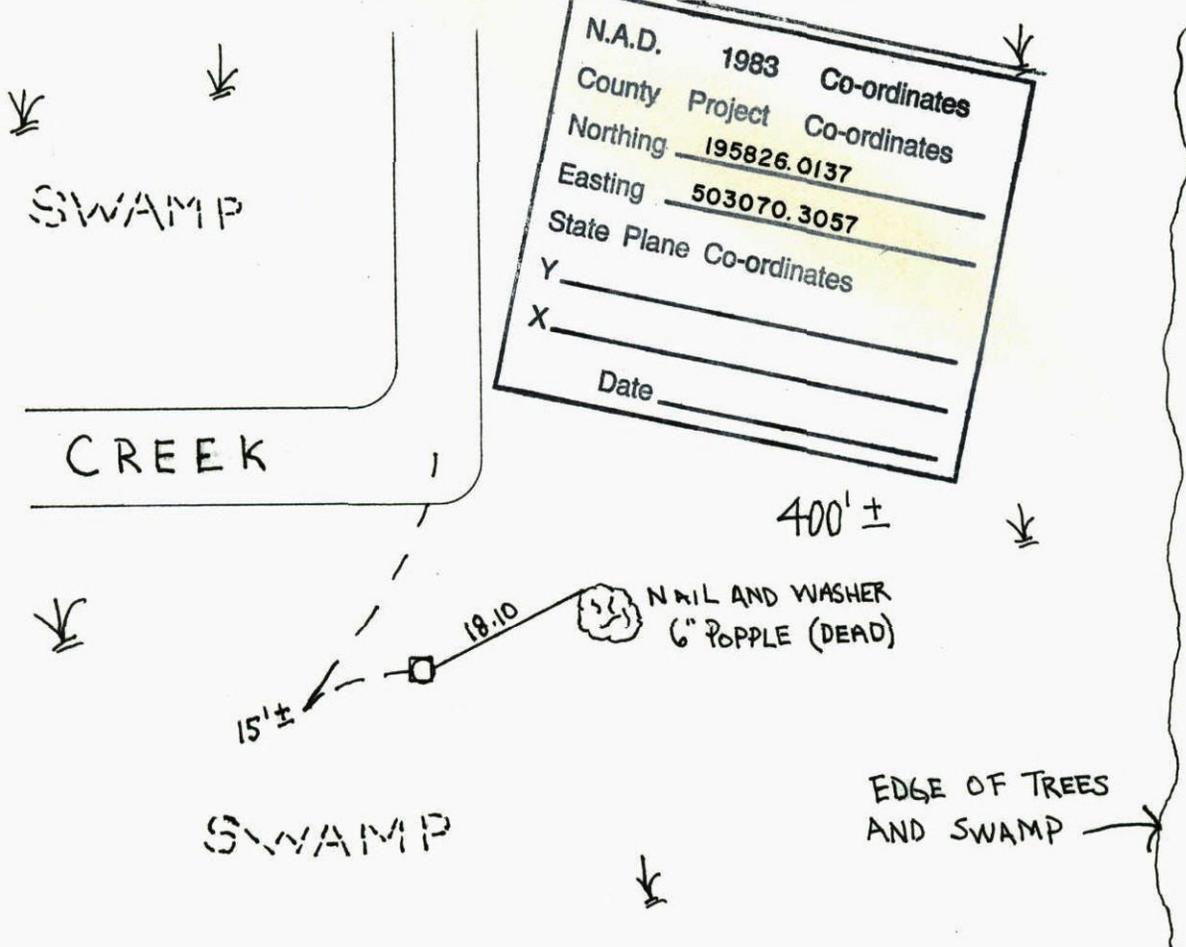


N.A.D.	1983	Co-ordinates
County	Project	Co-ordinates
Northing	195826.0137	
Easting	503070.3057	
State Plane Co-ordinates		
Y		
X		
Date		

Revised date	Revised date	Revised date
6-22-81		
7-2-87		
12-7-99		
1-2-02		

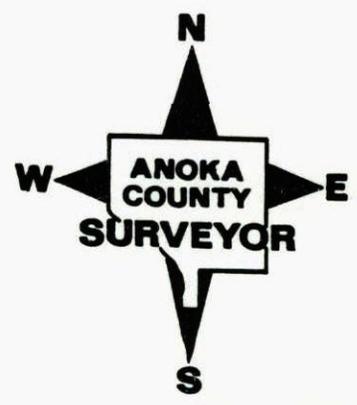


NORTH 1/4 COR. SEC. 6, T.32, R.23

RETIED RED AND WHITE I.P.

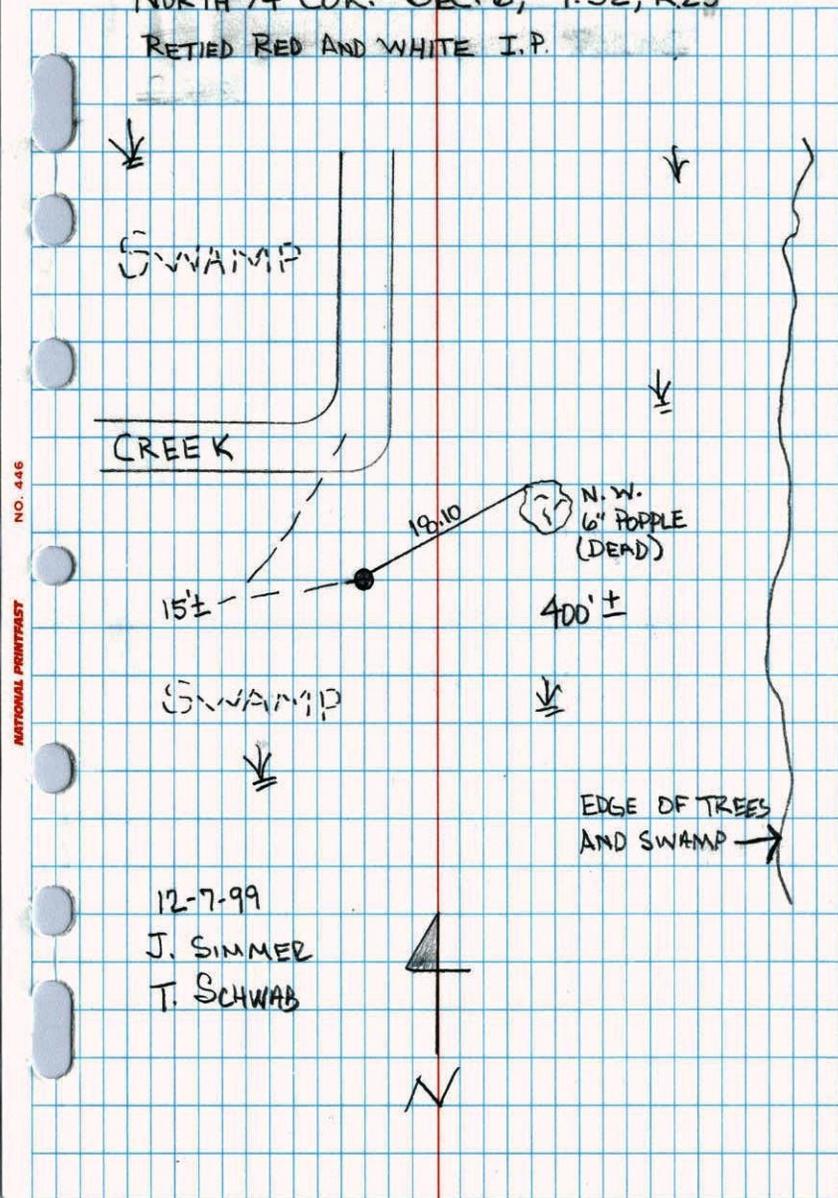


N 1/4 CORNER SECTION 6 - T32 - R23

SET RED AND WHITE IRON PIPE FROM AREA RESURVEY. SIGN ON IRON PIPE.

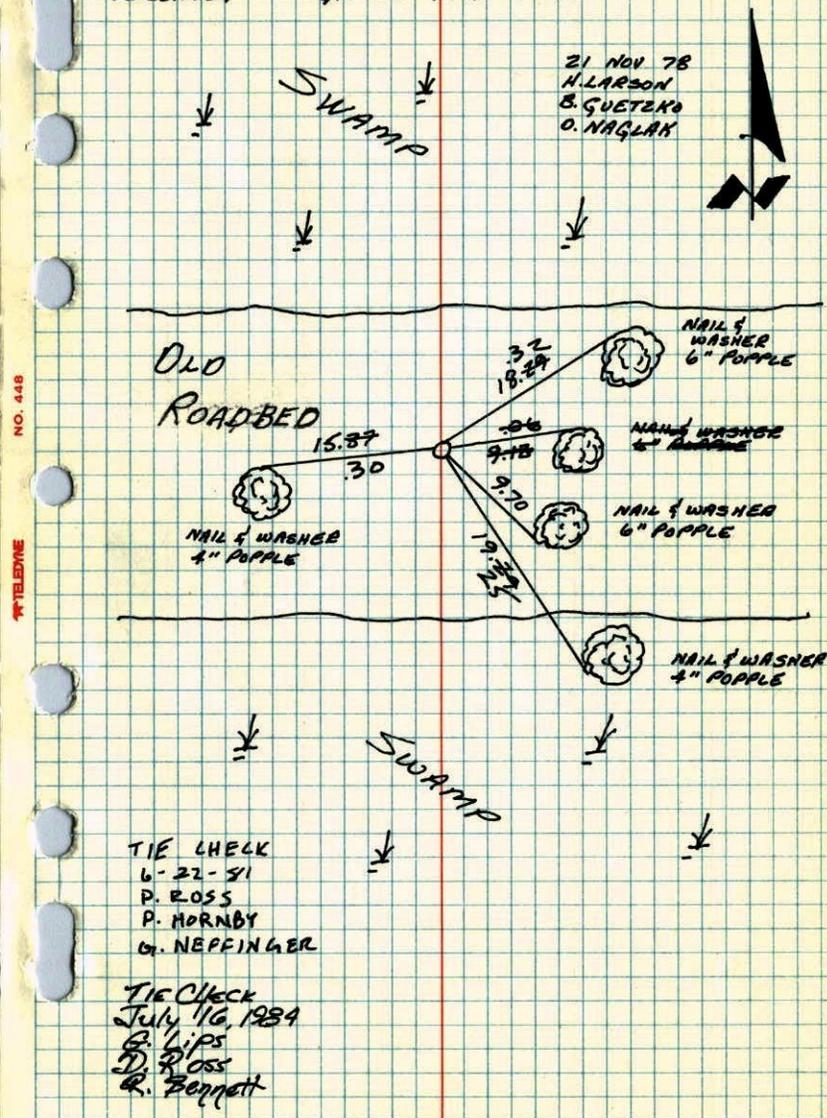

N $\frac{1}{4}$ Cor. Section 6 T32 R23

Set red and white iron pipe
From area resurveyed sign on LR

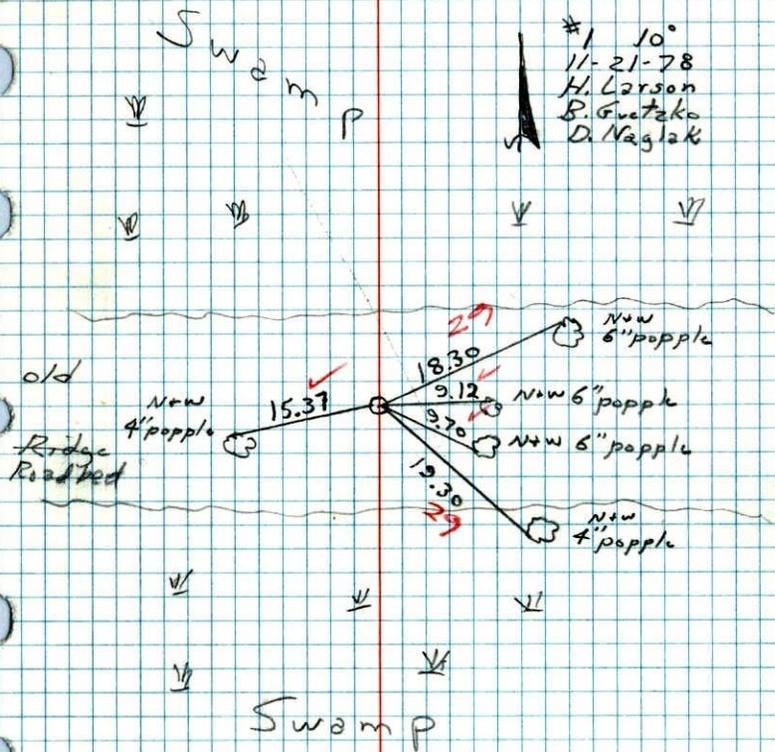

W $\frac{1}{4}$ cor. sec. 6 + 32 R23
Jan. 24, 1910 (Ham Lake)

