N1/4 Cor. Sec 3, T30, R22
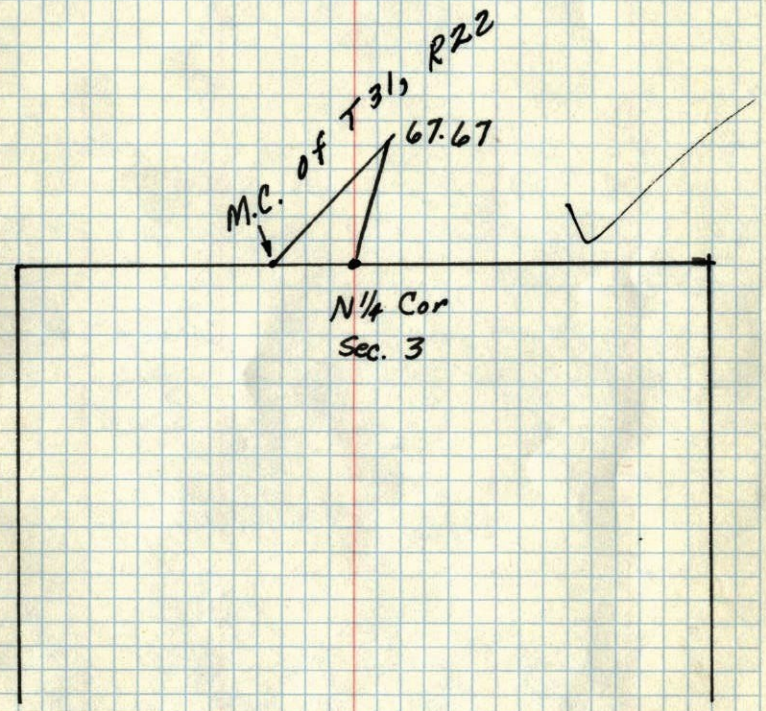
Put in with T31, R22
for future Reference