CERTIFICATE OF LOCATION OF GOVERNMENT CORNER

County of Anoka State of Minnesota

Witness Corner of Sec. 20 Township 31 Range 22

(On north line of NW1/4)

On the 14th day of May, 1963, the described corner was evidenced by a concrete monument

and to perpetuate the location of said corner, at the exact location thereof, a permanent marker was placed consisting of a cast iron monument

AND on the 26th day of July, 2010, said permanent marker was found flush with the surface and the ties were updated

Updated reference ties are as shown below.

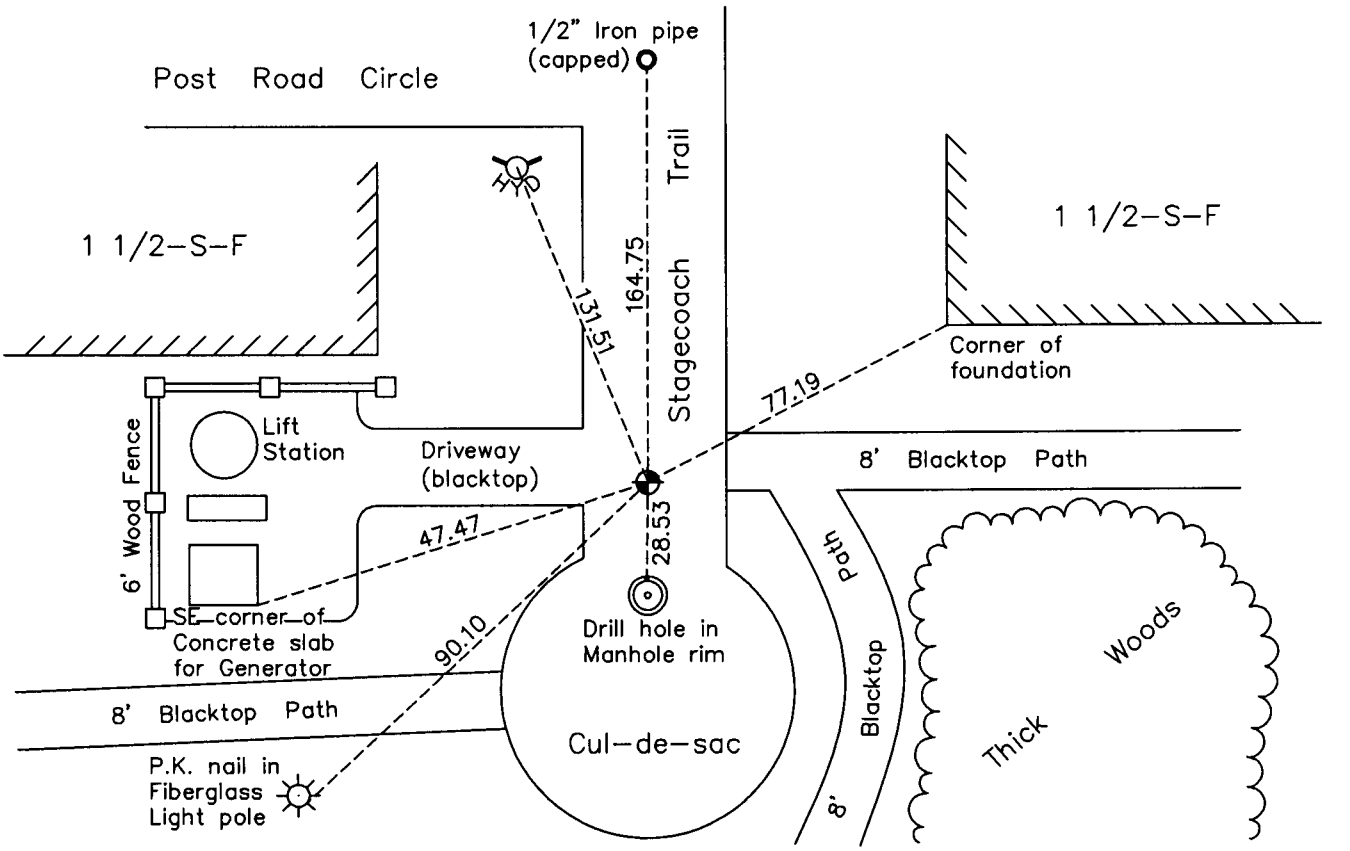

N
W ANOKA COUNTY SURVEYOR E
S

Revision Date
1/10/11

N.A.D. 1983 Coordinates
(1996 Adjustment)

County Project Coordinates	
Northing	148303.1399
Easting	538359.1993
Date	1/28/98

I hereby certify that this United States public land survey monument record is correct and complete to the best of my knowledge and belief.

Larry D. Hoium Date 1/10/11

Larry D. Hoium, Anoka County Surveyor

Minnesota License Number 18165