

CERTIFICATE OF LOCATION OF GOVERNMENT CORNER

County of Anoka

State of Minnesota


Witness Corner of Sec. 28 Township 31 Range 22
 (on north line of section and west side of Ward Lake)

On the 17th day of December, 1980, the described corner was evidenced by area resurvey

and to perpetuate the location of said corner, at the exact location thereof, a permanent marker was placed consisting of a cast iron monument with a sign and post on the north side

AND on the 19th day of August, 2010, said permanent marker was found flush with the surface and the ties were updated

Updated reference ties are as shown below.

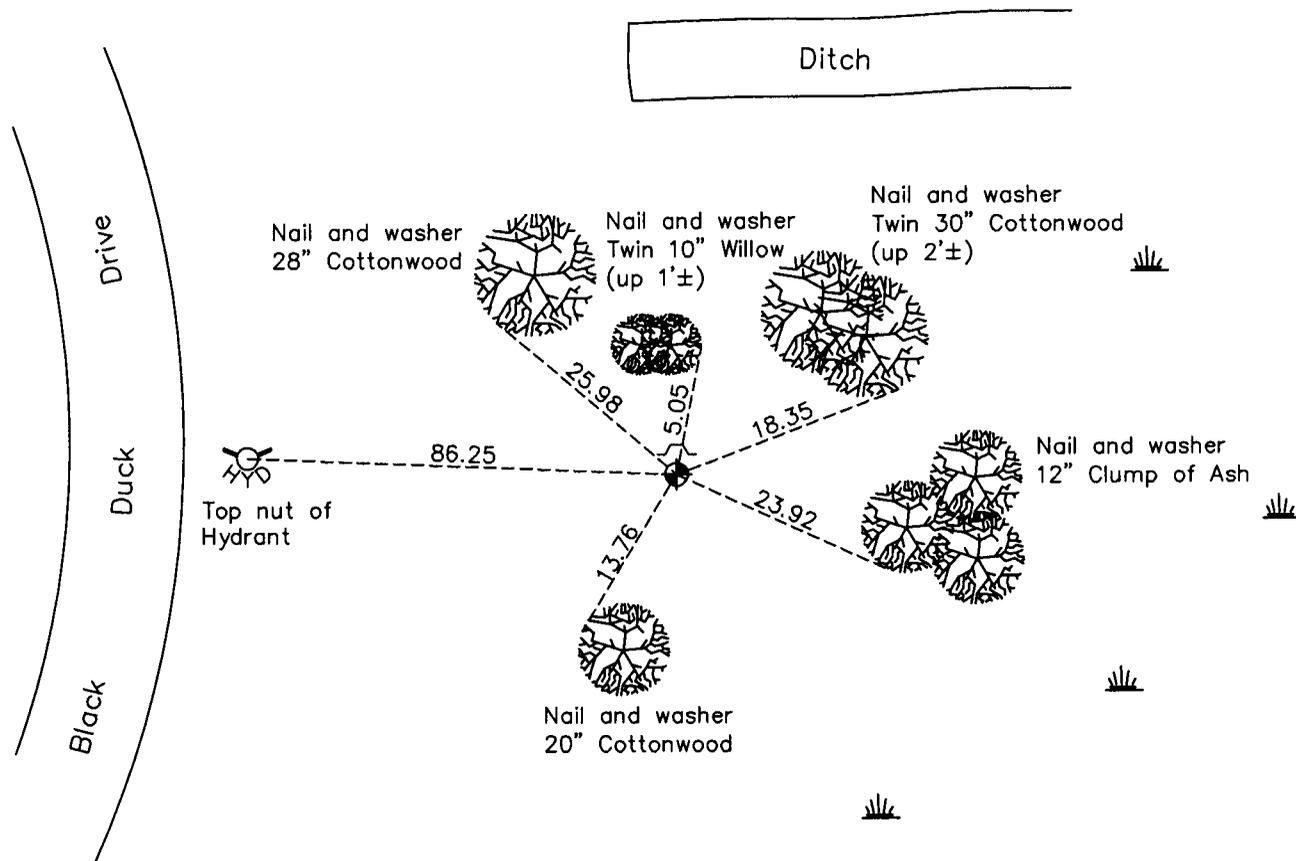

N

 W ANOKA COUNTY SURVEYOR E
 S
 Revision Date
2/02/11

N.A.D. 1983 Coordinates
(1996 Adjustment)

County Project Coordinates	
Northing	143002.8921
Easting	546427.7419
Date	3/17/98

I hereby certify that this United States public land survey monument record is correct and complete to the best of my knowledge and belief.

 Date 2/02/11
 Larry D. Hoium, Anoka County Surveyor
 Minnesota License Number 18165