CERTIFICATE OF LOCATION OF GOVERNMENT CORNER

County of Anoka State of Minnesota

East 1/4 Corner of Sec. 28 Township 31 Range 22

On the 22nd day of April, 1968, the described corner was evidenced by area resurvey

and to perpetuate the location of said corner, at the exact location thereof, a permanent marker was placed consisting of a cast iron monument in bottom of ditch with a sign and post on the north side

AND on the 9th day of July, 2010, said permanent marker was found down 0.4'± and 1'± south of sign and the ties were updated

Updated reference ties are as shown below.

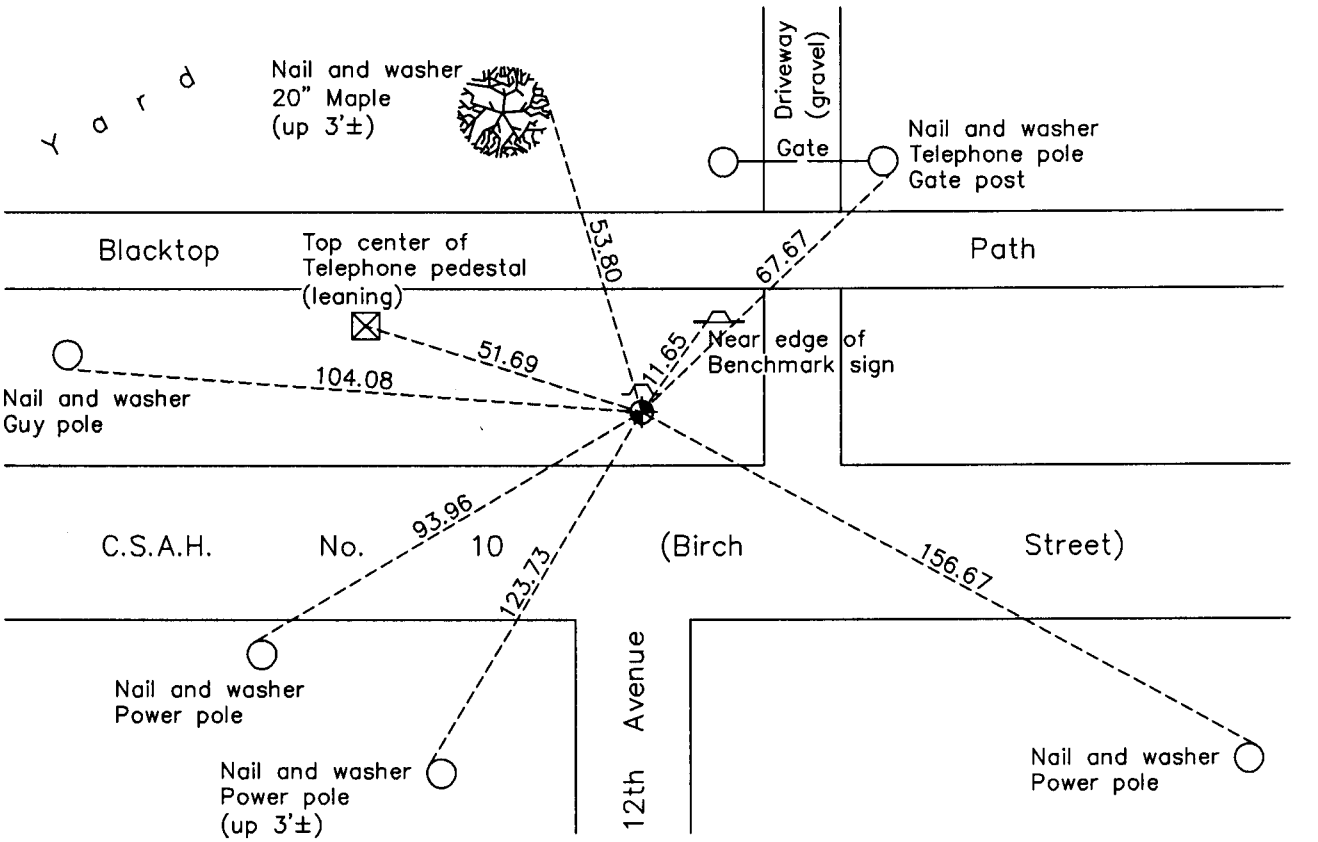

N
W ANOKA COUNTY SURVEYOR E
S

Revision Date
2/04/11

N.A.D. 1983 Coordinates
(1996 Adjustment)

County Project Coordinates	
Northing	140363.4581
Easting	547768.5096
Date	3/17/97

I hereby certify that this United States public land survey monument record is correct and complete to the best of my knowledge and belief.

Larry D. Hoium Date 2/04/11

Larry D. Hoium, Anoka County Surveyor

Minnesota License Number 18165