

CERTIFICATE OF LOCATION OF GOVERNMENT CORNER

County of Anoka

State of Minnesota


Southwest Corner of Sec. 30 Township 33 Range 25

On the 4th day of October, 1963, the described corner was evidenced by a 6"X6" granite monument

and to perpetuate the location of said corner, at the exact location thereof, a permanent marker was placed consisting of a cast iron monument

AND on the 6th day of November, 2013, said permanent marker was found up 0.1'± and the ties were updated

Updated reference ties are as shown below.

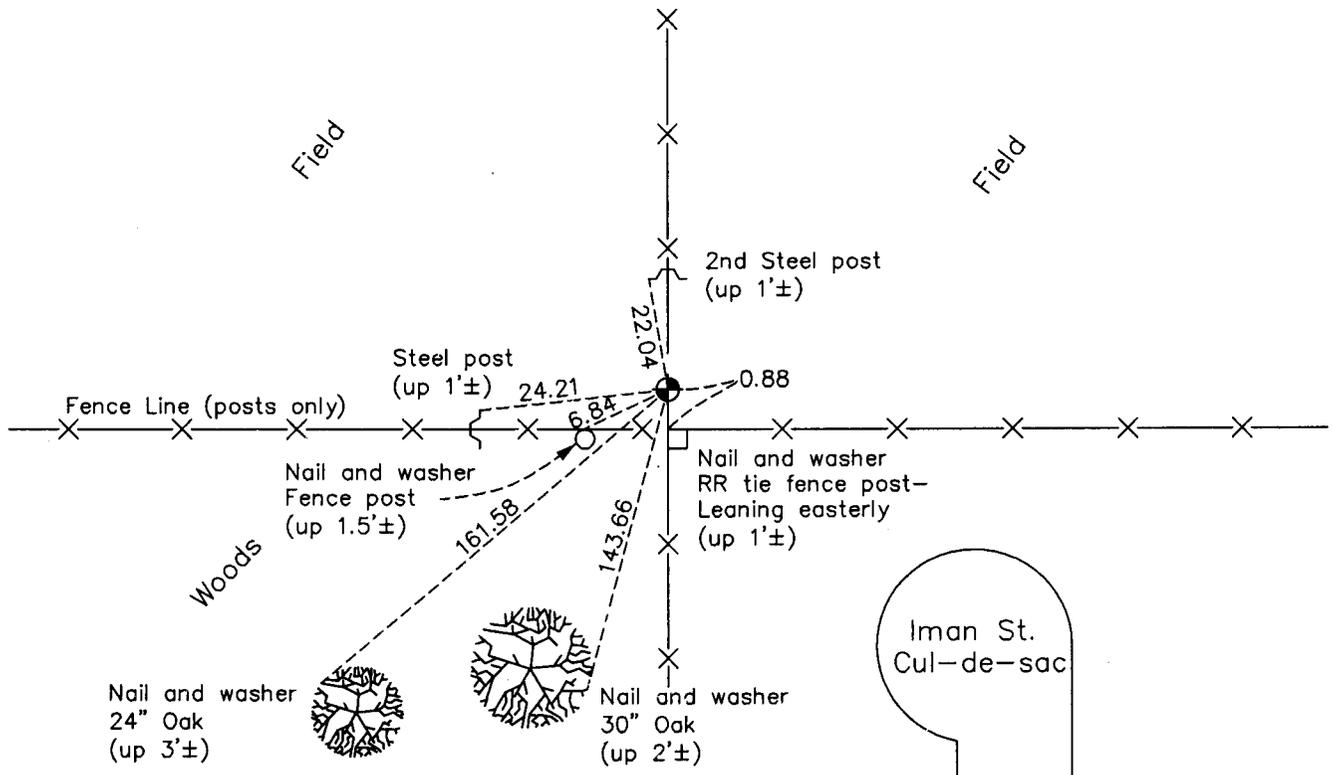

Revision Date
3/21/14

N.A.D. 1983 Coordinates
(1996 Adjustment)

County Project Coordinates	
Northing	201658.9604
Easting	437185.0395
Date	2/20/03

I hereby certify that this United States public land survey monument record is correct and complete to the best of my knowledge and belief.

Larry D. Hoium Date 3/21/14

Larry D. Hoium, Anoka County Surveyor

Minnesota License Number 18165