CERTIFICATE OF LOCATION OF GOVERNMENT CORNER

County of Anoka State of Minnesota

Northwest Corner of Sec. 34 Township 32 Range 25

On the 17th day of April, 1962, the described corner was evidenced by a 3/4" iron pipe

and to perpetuate the location of said corner, at the exact location thereof, a permanent marker was placed consisting of a P.K. nail

AND on the 21st day of April, 2010, said permanent marker was not found. The corner will be set at a later date.

Updated reference ties are as shown below.

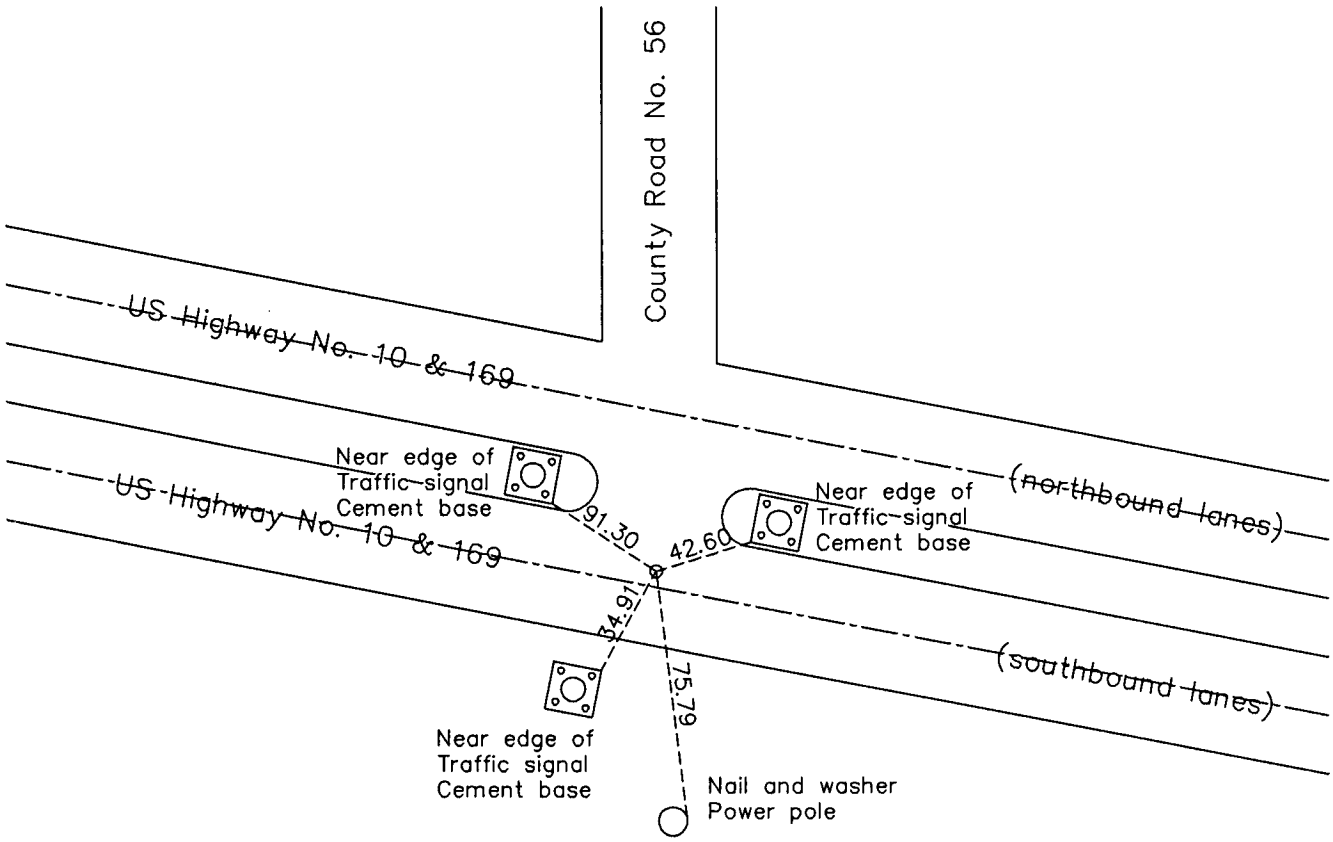

N
W ANOKA COUNTY SURVEYOR E
S

Revision Date
8/09/10

N.A.D. 1983 Coordinates
(1996 Adjustment)

County Project Coordinates	
Northing	169815.4937
Easting	452836.0148
Date	11/29/00

I hereby certify that this United States public land survey monument record is correct and complete to the best of my knowledge and belief.

Larry D. Hoium Date 8/09/10

Larry D. Hoium, Anoka County Surveyor

Minnesota License Number 18165