

CERTIFICATE OF LOCATION OF GOVERNMENT CORNER

County of Anoka State of Minnesota


Southeast Corner of Sec. 27 Township 34 Range 24

On the 7th day of January, 1971, the described corner was evidenced by area resurvey

and to perpetuate the location of said corner, at the exact location thereof, a permanent marker was placed consisting of a cast iron monument *ON ϕ*

AND on the 24th day of April, 2003, said permanent marker was found and the ties were updated

Updated reference ties are as shown below.

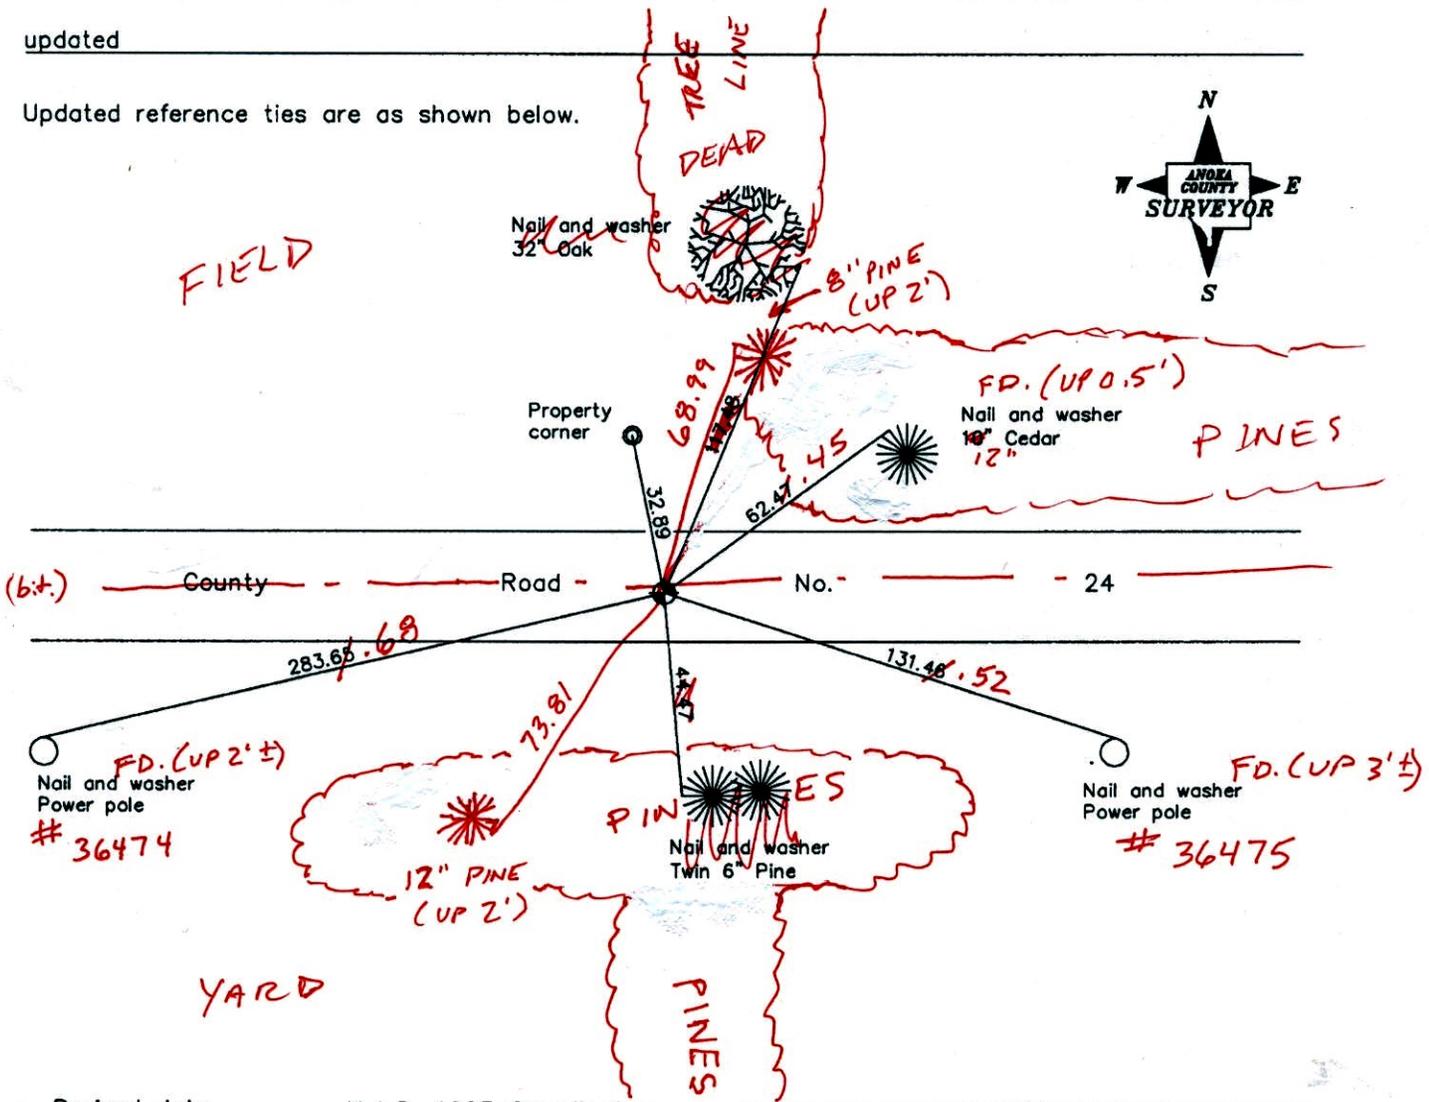

*3-14-14
BK-55
T/T-VRS*

Revised date	
7/11/97	
5/14/99	
4/24/03	

N.A.D. 1983 Coordinates (1996 Adjustment)	
County Project Coordinates	
Northing	232683.0036
Easting	489813.5926
Date	4/24/03

I hereby certify that this United States public land survey monument record is correct and complete to the best of my knowledge and belief.

Larry D. Holum Date 4/24/03

Larry D. Holum, Anoka County Surveyor

Minnesota License Number 18165

VRS 3DQ = 0.05 N = 232683.0104 E = 489813.5708

CERTIFICATE OF LOCATION OF GOVERNMENT CORNER

County of Anoka

State of Minnesota


Southeast Corner of Sec. 27 Township 34 Range 24

On the 7th day of January, 1971, the described corner was evidenced by area resurvey

and to perpetuate the location of said corner, at the exact location thereof, a permanent marker was placed consisting of a cast iron monument

AND on the 24th day of April, 2003, said permanent marker was found and the ties were updated

Updated reference ties are as shown below.

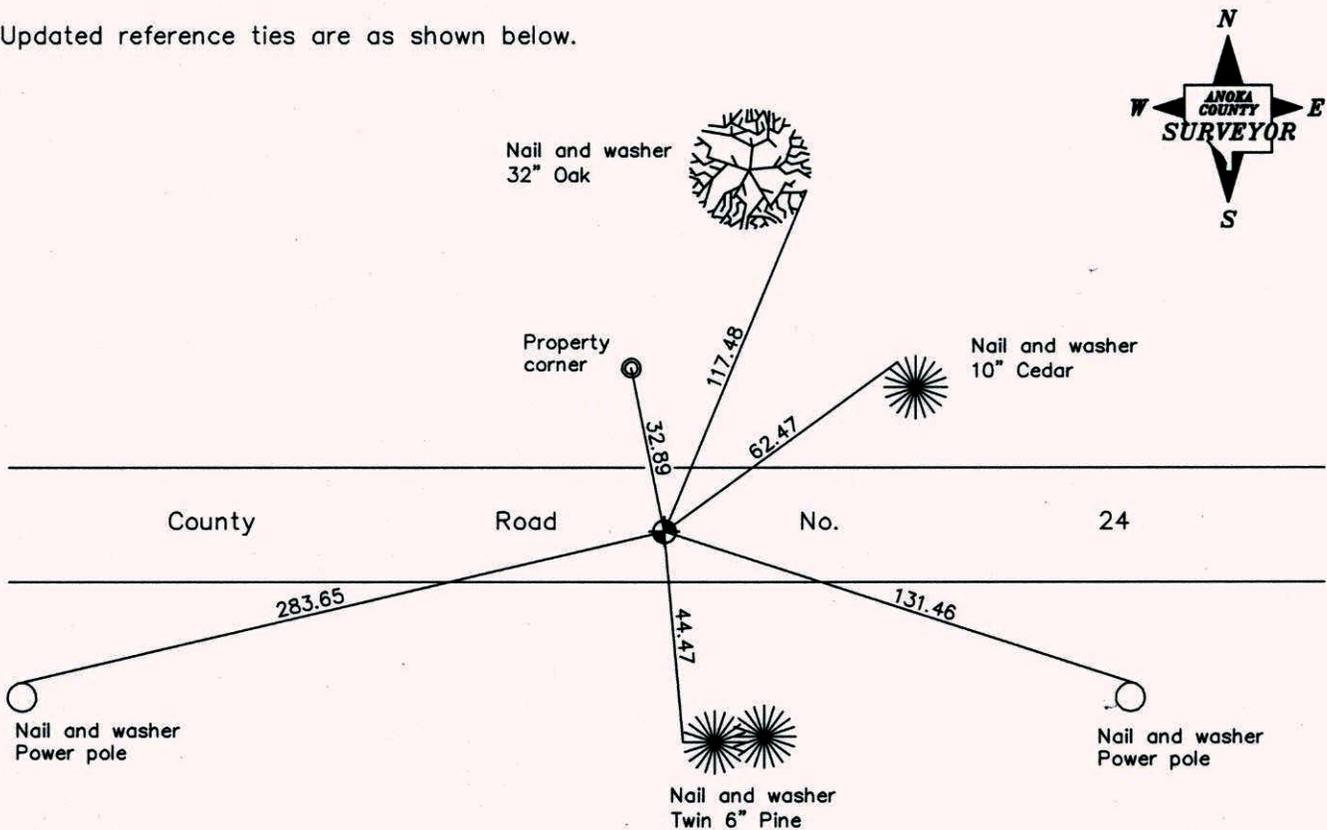

Revised date
7/11/97
5/14/99
4/24/03

N.A.D. 1983 Coordinates (1996 Adjustment)	
County Project Coordinates	
Northing	<u>232683.0036</u>
Easting	<u>489813.5926</u>
Date	<u>4/24/03</u>

I hereby certify that this United States public land survey monument record is correct and complete to the best of my knowledge and belief.

Larry D. Hoiium Date 4/24/03

Larry D. Hoiium, Anoka County Surveyor

Minnesota License Number 18165

CERTIFICATE OF LOCATION OF GOVERNMENT CORNER

County of Anoka


State of Minnesota

Southeast Corner of Sec. 27 Township 34 Range 24


I hereby certify that on the 7 day of JANUARY, 1971, I found the described corner which was evidenced by AREA RESURVEY

and I further certify that to perpetuate the location of said corner, I did, at the exact location thereof, place a permanent marker consisting of CAST IRON MONUMENT


which reference or witness monuments are located in the manner following:

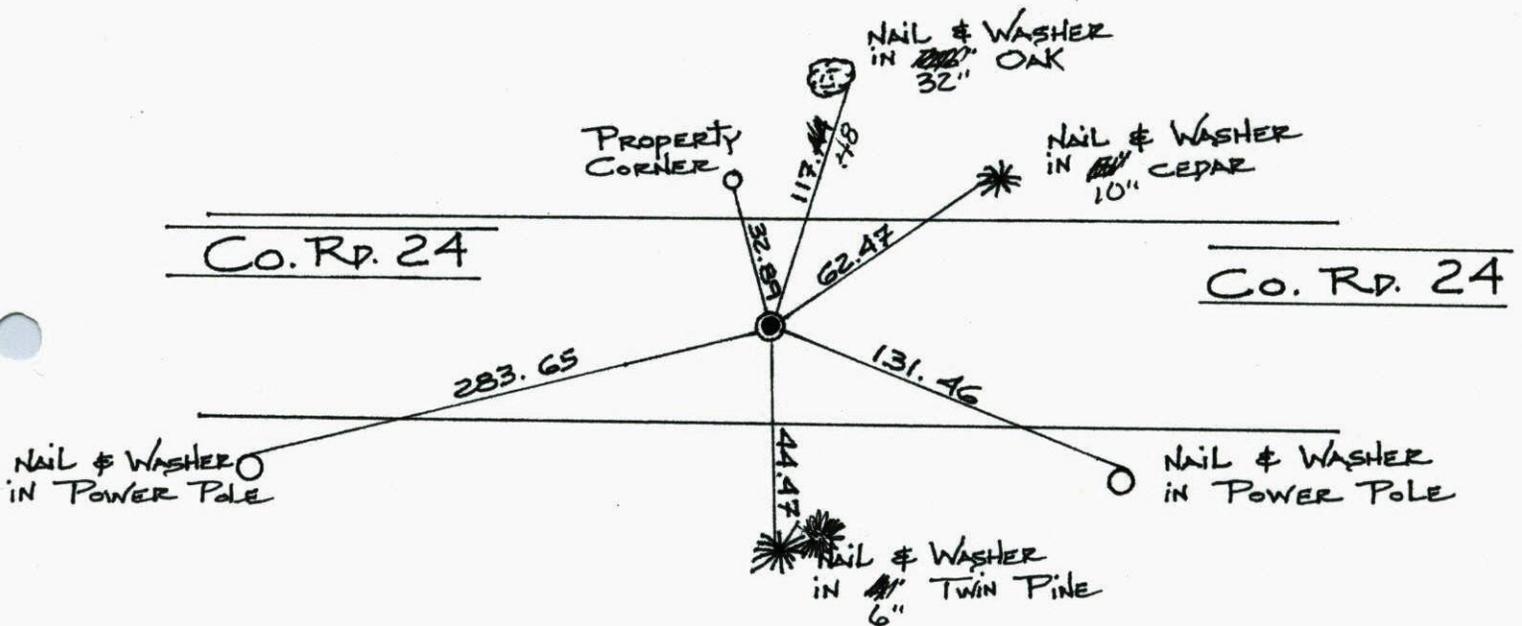

Revised date	Revised date	Revised date
06/05/74	05/14/99	
05/04/77	4-24-03	
08/27/80		
06/15/87		
10/14/91		
07/21/92		
07/11/97		

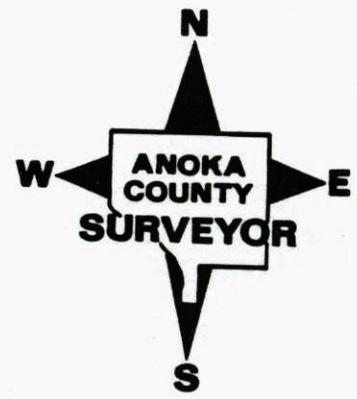


SE COR. OF SEC. 27, T34, R24
 Replaced & Retied C.I.M.

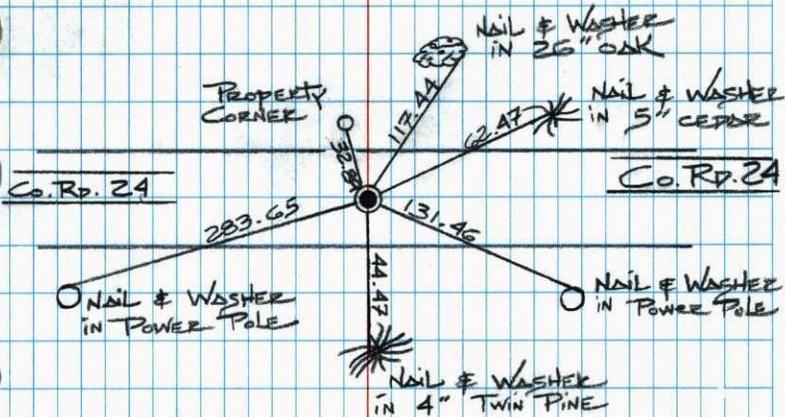

05/14/99
 J. SIMMER
 T. SCHWAB
 A. NAEVE

NATIONAL PRINTFAST NO. 446

TRANSIT TIE
 S.E. COR. SEC 27 T 34 R 24
 REMOVED C.I.M. FOR GRIND
 AND OVERLAY

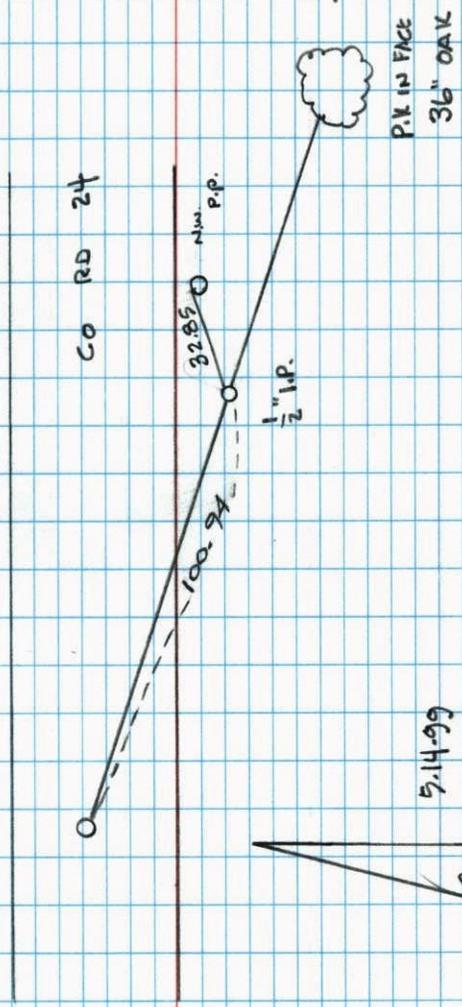


5.14.99
 J. SIMMER
 A. NAEVE
 T. SCHWAB

NATIONAL PRINTFAST NO. 446

S.E. Corner Section 27-T34-R24

Set Cast Iron Monument from area resurvey, monument
flush on centerline of road. P.K.'s 2.00' North &
East.

7 Jan 71
H. Larson
W. Westerland

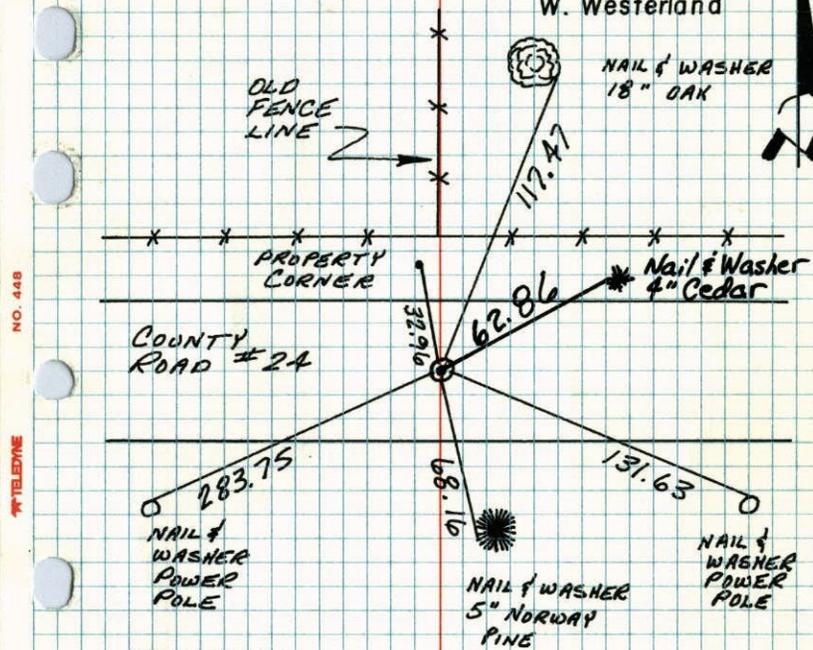

TIE CHECK
5 JUN 74
R. FARMER
N. DAHL
D. DAHL

TIE CHECK
4 MAY 77
D. DAHL
S. BRIEN

TIE CHECK
8-27-80
B. STEPHENS
P. ROSS
P. HORNBY

TEMPERATURE CORRECTED
AND HORIZONTALLY
TAPED MEASUREMENTS

ROLAND W. ANDERSON
COUNTY SURVEYOR
ANOKA COUNTY, MINNESOTA