

# CERTIFICATE OF LOCATION OF GOVERNMENT CORNER

County of Anoka State of Minnesota


## Northeast Corner of Sec. 31 Township 34 Range 25

On the 14th day of January, 1964, the described corner was evidenced by a 1" iron pipe from old ties

and to perpetuate the location of said corner, at the exact location thereof, a permanent marker was placed consisting of a cast iron monument FLUSH W/GROUND  
SIGN ON WEST SIDE.

AND on the \_\_\_ day of \_\_\_\_\_, \_\_\_\_\_, said permanent marker was \_\_\_\_\_

Updated reference ties are as shown below.

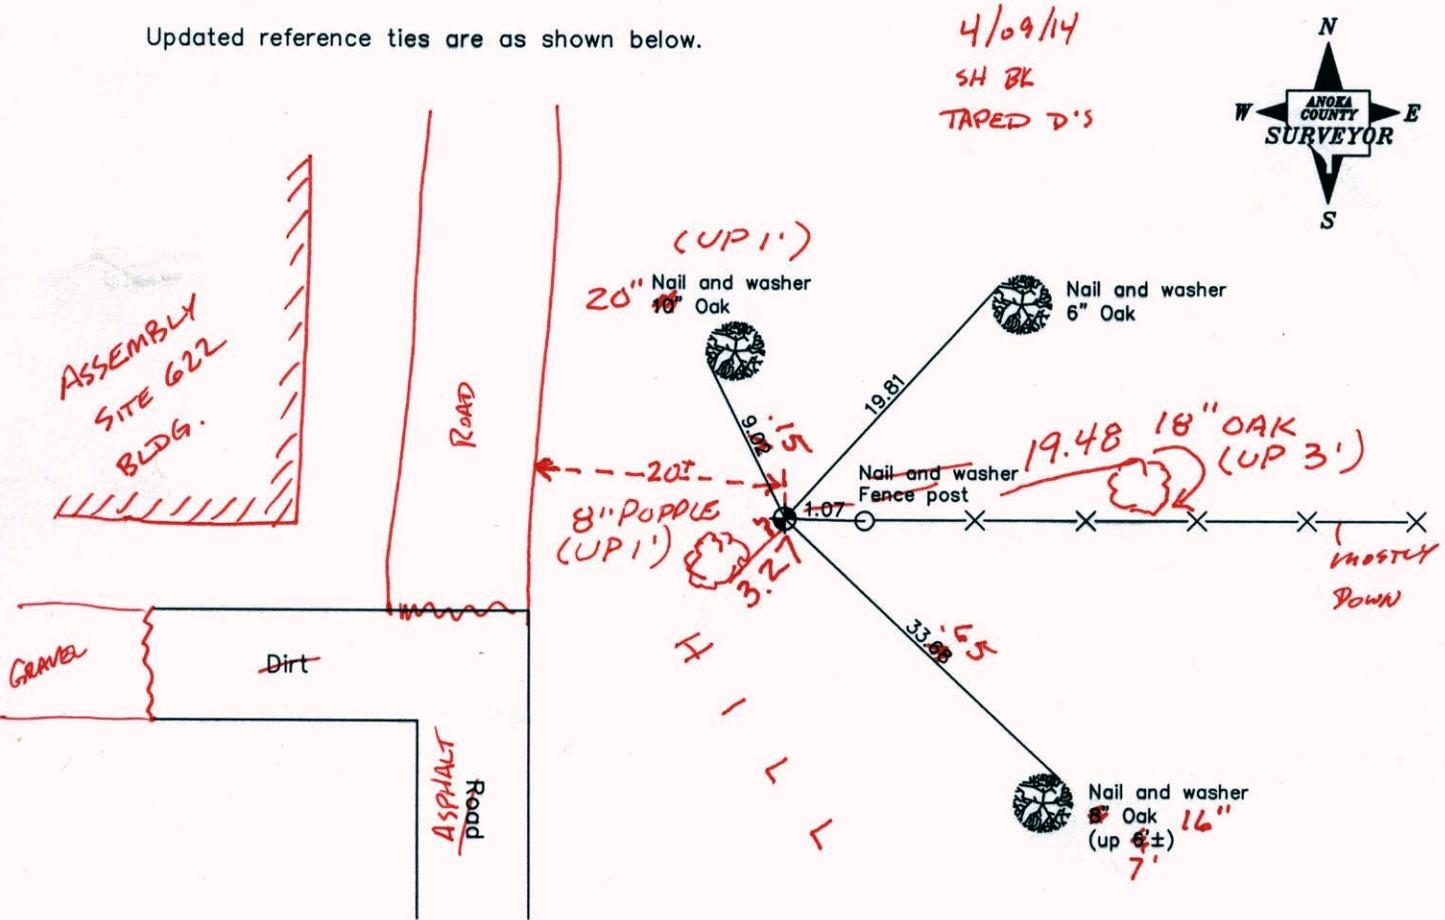

Revised date
7/25/84
6/18/87
2/03/94

N.A.D. 1983 Coordinates (1996 Adjustment)	
County Project Coordinates	
Northing	<u>233008.0536</u>
Easting	<u>442381.6596</u>
Date	<u>5/28/03</u>

I hereby certify that this United States public land survey monument record is correct and complete to the best of my knowledge and belief.

\_\_\_\_\_, Date \_\_\_\_\_

\_\_\_\_\_, Anoka County Surveyor

Minnesota License Number \_\_\_\_\_

# CERTIFICATE OF LOCATION OF GOVERNMENT CORNER

County of Anoka

State of Minnesota


Northeast Corner of Sec. 31 Township 34 Range 25

On the 14th day of January, 1964, the described corner was evidenced by a 1" iron pipe from old ties

and to perpetuate the location of said corner, at the exact location thereof, a permanent marker was placed consisting of a cast iron monument

AND on the \_\_\_ day of \_\_\_\_\_, \_\_\_\_\_, said permanent marker was \_\_\_\_\_

Updated reference ties are as shown below.

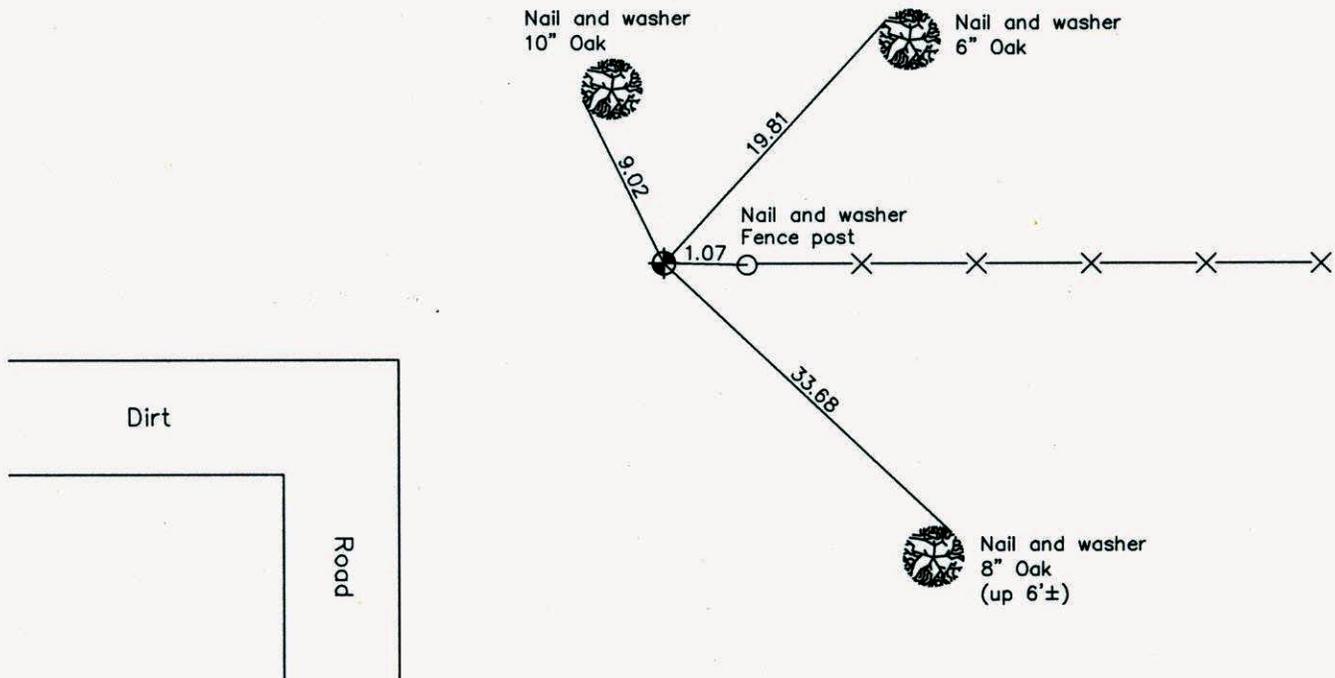

Revised date
7/25/84
6/18/87
2/03/94

N.A.D. 1983 Coordinates (1996 Adjustment)	
County Project Coordinates	
Northing	<u>233008.0536</u>
Easting	<u>442381.6596</u>
Date	<u>5/28/03</u>

I hereby certify that this United States public land survey monument record is correct and complete to the best of my knowledge and belief.

\_\_\_\_\_ Date \_\_\_\_\_

\_\_\_\_\_, Anoka County Surveyor

Minnesota License Number \_\_\_\_\_

# CERTIFICATE OF LOCATION OF GOVERNMENT CORNER

County of Anoka


State of Minnesota

NORTHEAST Corner of Sec. 31 Township 34 Range 25


I hereby certify that on the 14 day of JAN, 1964, I found the described corner which was evidenced by 1" IRON PIPE FROM OLD TIES

and I further certify that to perpetuate the location of said corner, I did, at the exact location thereof, place a permanent marker consisting of CAST IRON MONUMENT

which reference or witness monuments are located in the manner following:

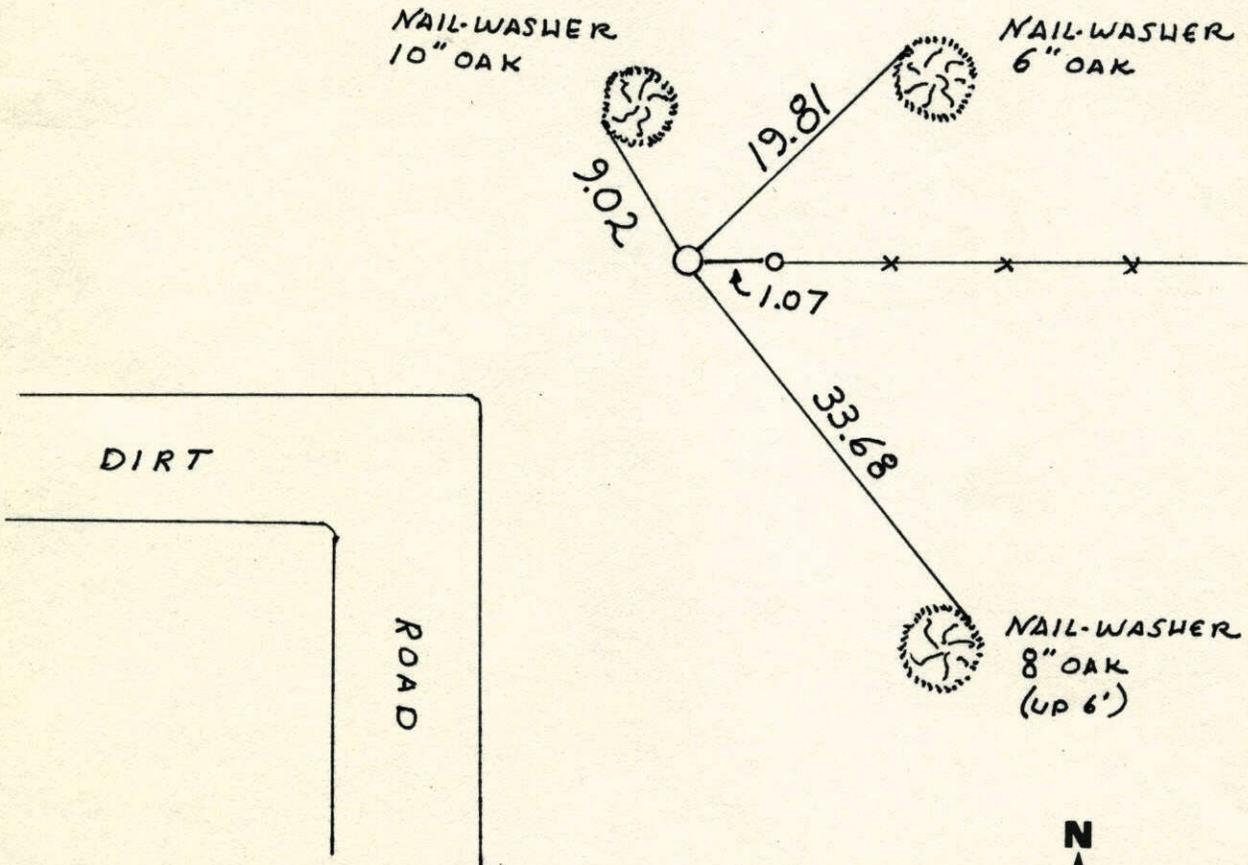


Revised date	Revised date	Revised date
7-25-84		
6-18-87		
REDRAWN 2-3-94 ML		

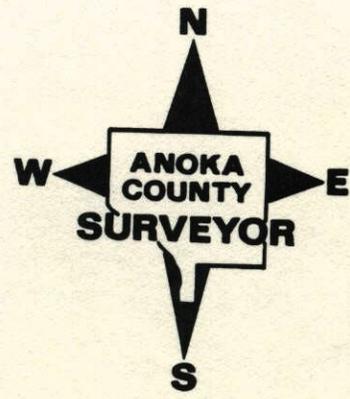


N.E. Cor Sec 31-34 R-25  
CAST IRON Monument

75

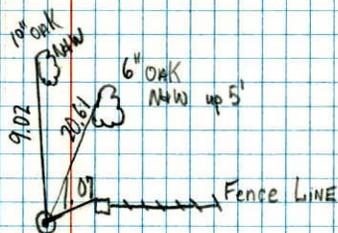

Nothing else to TIE too

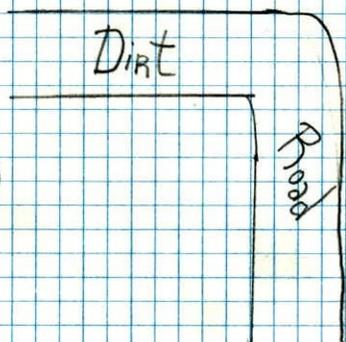


TIE Check  
 7-25-84 #200  
 G. Lips 75°  
 D. Ross  
 D. Vogel

N.E. Cor. Sec. 31-34-25

75

Found 1" iron pipe up 0.3" from old ties  
 Replaced iron pipe with cast iron monument.

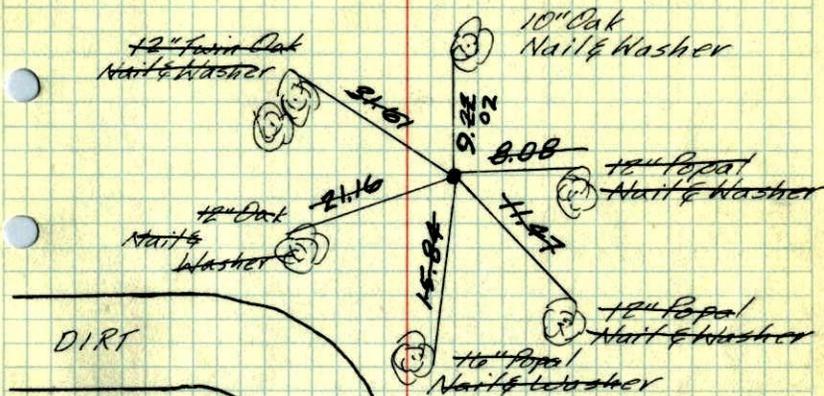

Sept. 7 1965  
 H. Larson  
 J. Dunlop

Jan. 14, 1964


J. Oliver  
 M. D. Anderson  
 M. Nordin

Tie Check  
 6-181  
 P. Ross  
 P. Harby

**ROLAND W. ANDERSON**  
 COUNTY SURVEYOR  
 ANOKA COUNTY, MINNESOTA  
 TEMPERATURE CORRECTED  
 AND HORIZONTALLY  
 TAPED MEASUREMENTS

17  
N.E. Cor. Sec. 31-34-25

Found 1" iron pipe up 0.3' from old ties

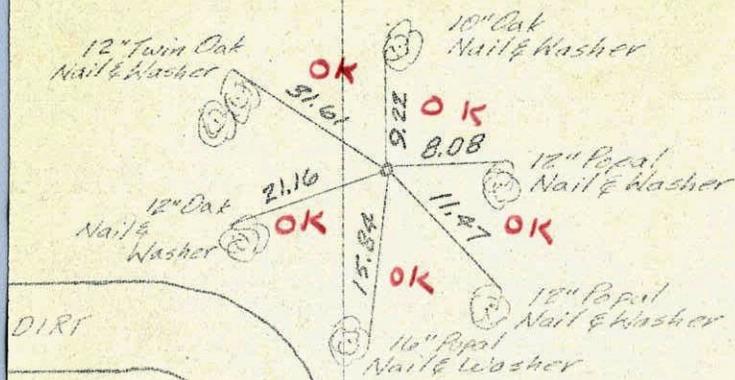

DIRT

Checked  
Sept. 7 1965  
H. LARSON  
S. Dunlop

Replaced  
IRON pipe  
with CAST  
IRON MONUMENT.  
Flush

Jan. 14, 1964


J. Oliver  
M.D. Anderson  
M. Nordin

ROLAND W. ANDERSON  
COUNTY SURVEYOR  
ANOKA COUNTY, MINNESOTA  
TEMPERATURE CORRECTED  
AND HORIZONTALLY  
TAPED MEASUREMENTS

ENTERED  
HL

NE Cor. Sec. 31, T34, R25

Found 1" I.P. up 0.3' From H.A.C.'s ties.

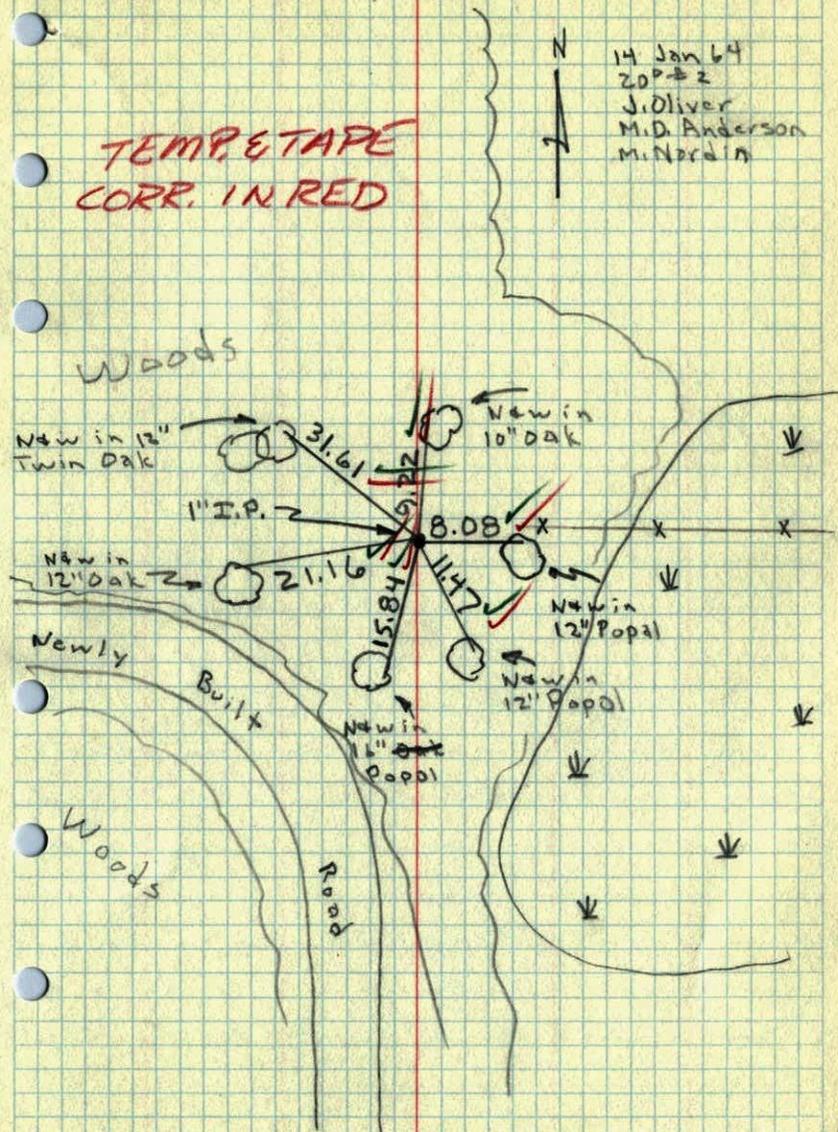

TEMP. & TAPE  
CORR. IN RED

N

14 Jan 64

20P-2

J. Oliver

M.D. Anderson

M. Nordin

NE Corn. Sec. 34, 34-25

