

# CERTIFICATE OF LOCATION OF GOVERNMENT CORNER

County of Anoka                      State of Minnesota

## West 1/4 Corner of Sec. 31 Township 34 Range 25


On the 15th day of January, 1964, the described corner was evidenced by a 1 1/2" iron pipe

and to perpetuate the location of said corner, at the exact location thereof, a permanent marker was placed consisting of a cast iron monument

(UP 0.2) **★ VERY STEEP SLOPE ★**

AND on the \_\_\_ day of \_\_\_\_\_, \_\_\_\_\_, said permanent marker was \_\_\_\_\_

Updated reference ties are as shown below.

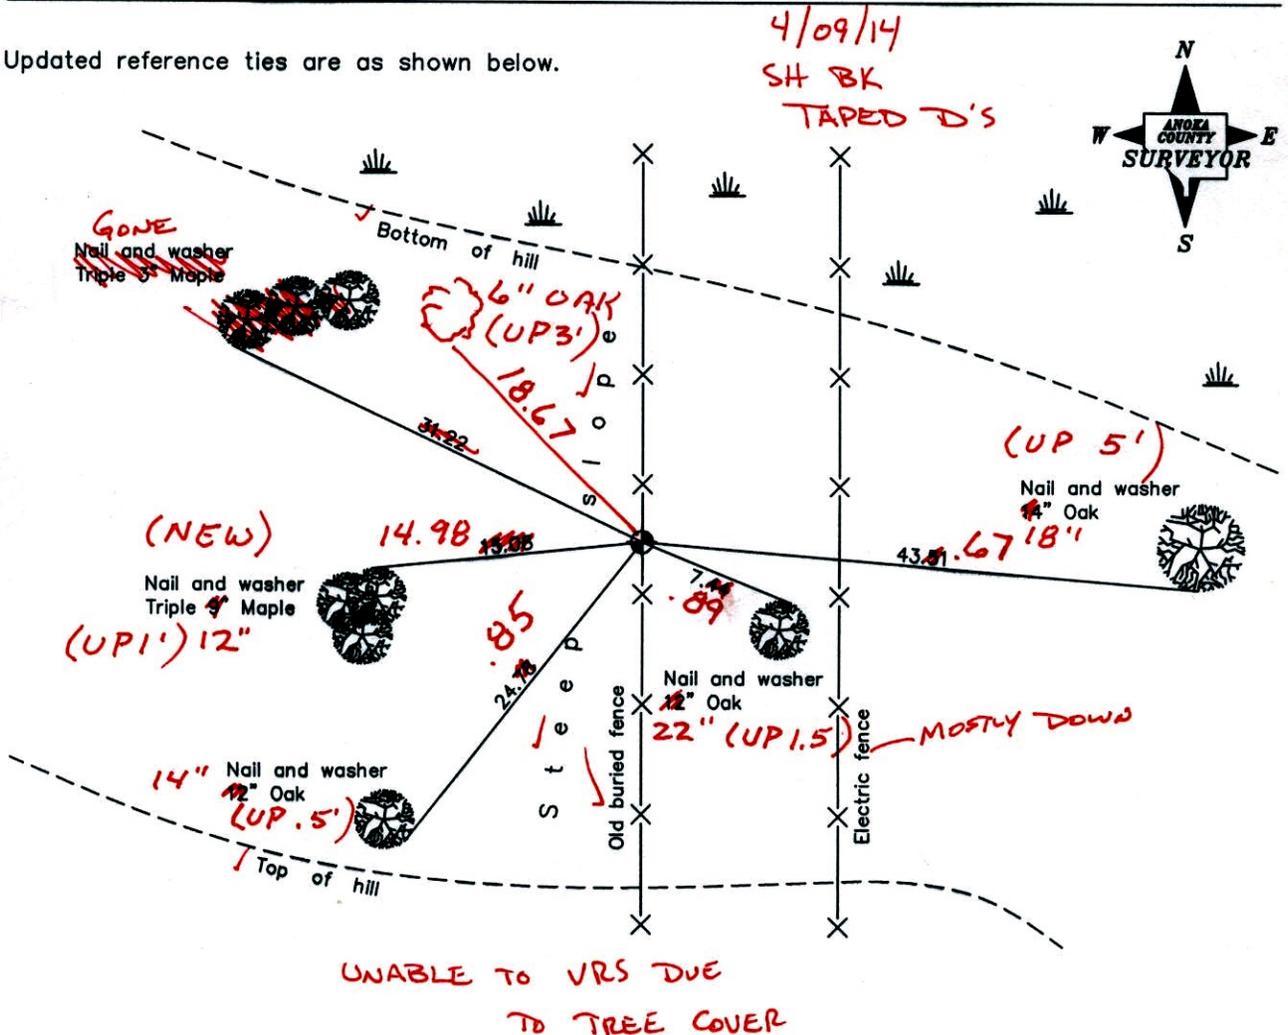

Revised date
6/18/87

N.A.D. 1983 Coordinates (1996 Adjustment)	
County Project Coordinates	
Northing	230424.8517
Easting	437507.4653
Date	1/24/05

I hereby certify that this United States public land survey monument record is correct and complete to the best of my knowledge and belief.

\_\_\_\_\_  
Date \_\_\_\_\_

\_\_\_\_\_, Anoka County Surveyor

Minnesota License Number \_\_\_\_\_

# CERTIFICATE OF LOCATION OF GOVERNMENT CORNER

County of Anoka

State of Minnesota


West 1/4 Corner of Sec. 31 Township 34 Range 25

On the 15th day of January, 1964, the described corner was evidenced by a 1 1/2" iron pipe

and to perpetuate the location of said corner, at the exact location thereof, a permanent marker was placed consisting of a cast iron monument

AND on the \_\_\_ day of \_\_\_\_\_, \_\_\_\_\_, said permanent marker was \_\_\_\_\_

Updated reference ties are as shown below.

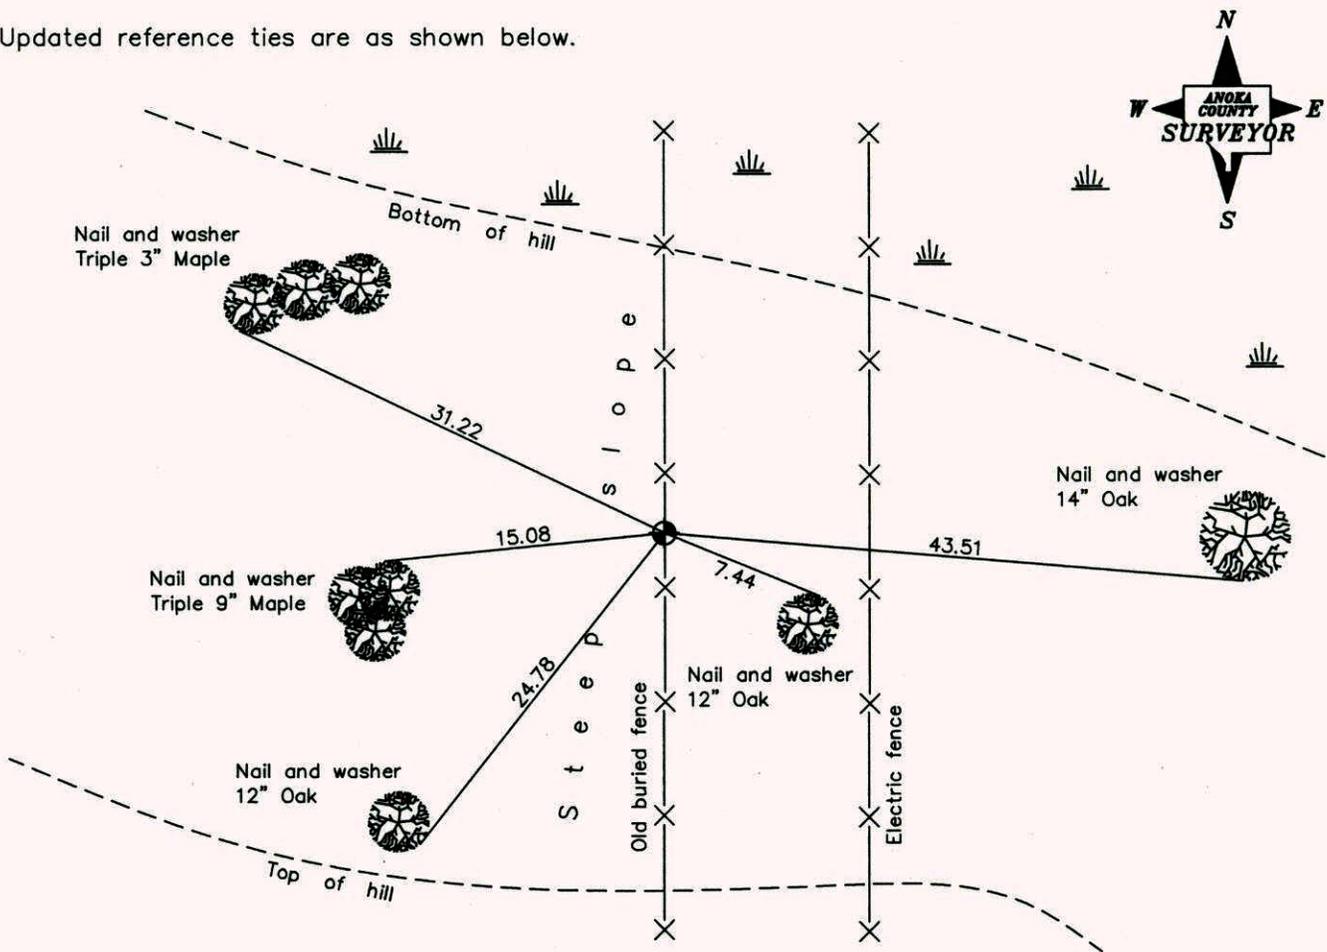

Revised date
6/18/87

N.A.D. 1983 Coordinates (1996 Adjustment)	
County Project Coordinates	
Northing	<u>230424.8517</u>
Easting	<u>437507.4653</u>
Date	<u>1/24/05</u>

I hereby certify that this United States public land survey monument record is correct and complete to the best of my knowledge and belief.

\_\_\_\_\_ Date \_\_\_\_\_

\_\_\_\_\_, Anoka County Surveyor

Minnesota License Number \_\_\_\_\_

# CERTIFICATE OF LOCATION OF GOVERNMENT CORNER

County of Anoka


State of Minnesota

WEST QTR. Corner of Sec. 31 Township 34 Range 25


I hereby certify that on the 15 day of JAN., 1964, I found the described corner which was evidenced by 1 1/2" I.P.

and I further certify that to perpetuate the location of said corner, I did, at the exact location thereof, place a permanent marker consisting of CAST IRON

which reference or witness monuments are located in the manner following:

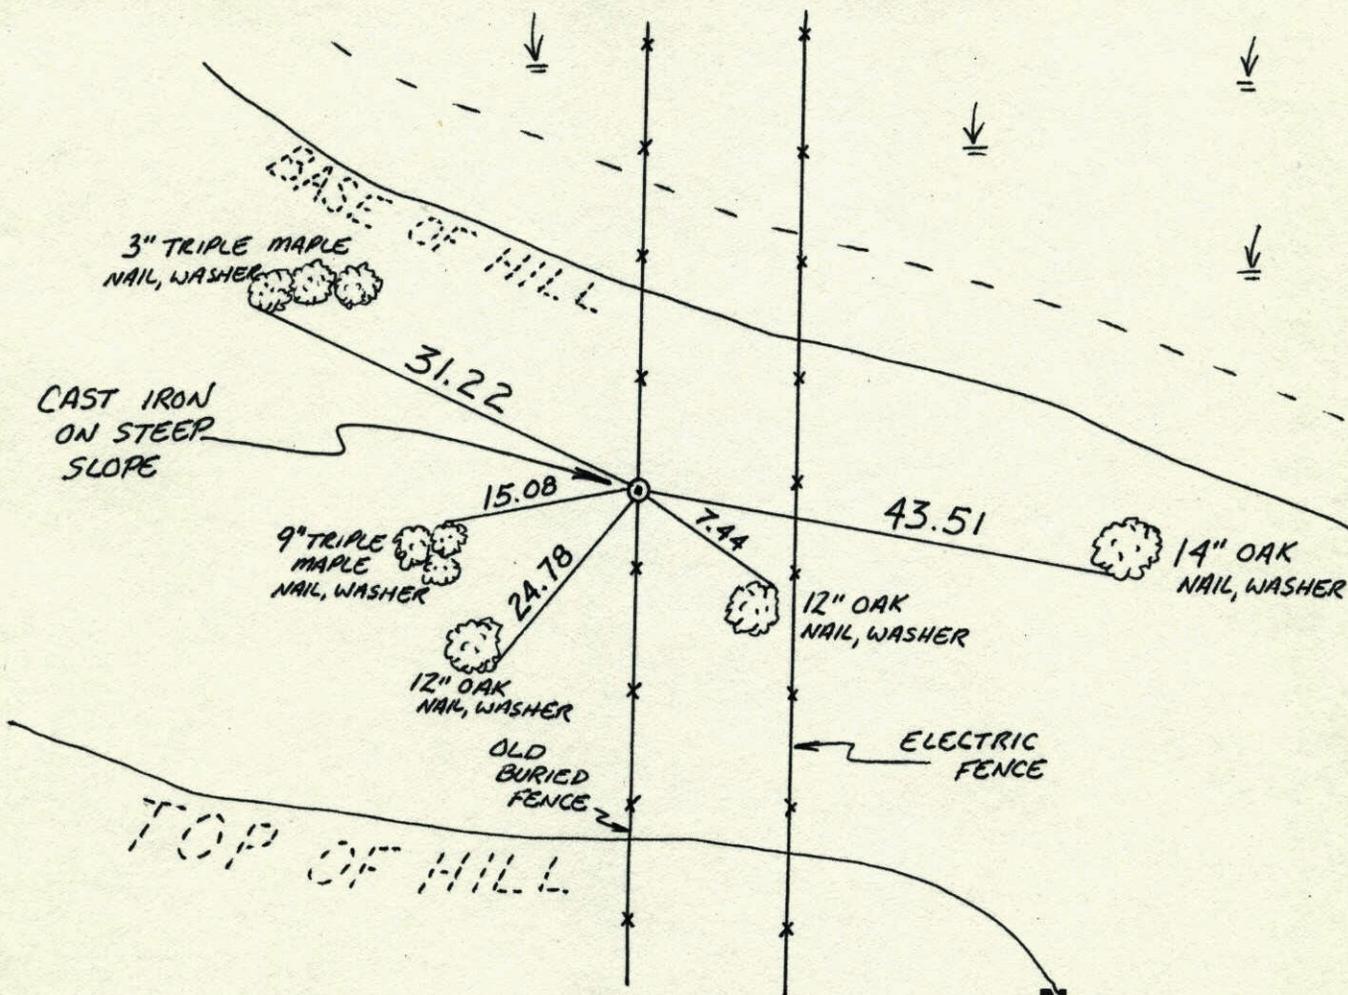

Revised date	Revised date	Revised date
6-18-87		

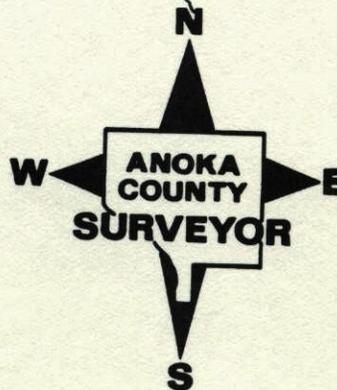


# W 1/4 Corner Section 31-T34-R25

Cast Iron Monument (Reg. #5333) In Place, Up 0.3'±.

Cast Iron Set Where 1 1/2" Iron Pipe Was Found From

Old Cartwright Ties.

15 Jan. 64  
J. Oliver  
M.D. Anderson  
M. Nordin

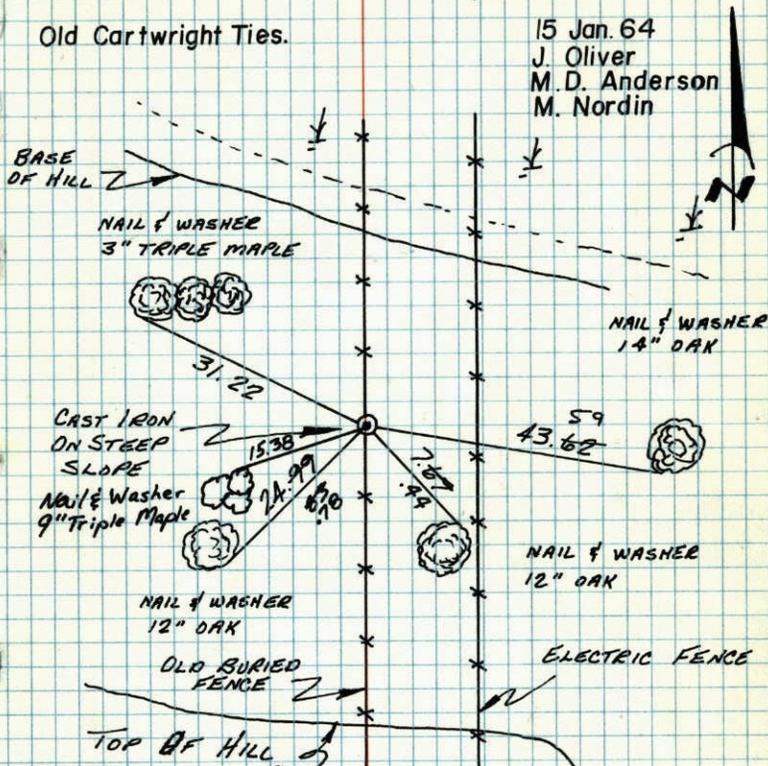

TIE CHECK 9 SEP 65 H. LARSON J. DUNLOP	TIE CHECK 10 MAY 77 R. SANNERUD D. DAHL S. BRIEN
TIE CHECK 19 JUN 74 R. FARMER D. DAHL H. DAHL	Tie Check 7-27-84 G. Lips D. Röss D. Vogel


Tie Check  
6-5-81  
P. Ross  
P. Horuby

TEMPERATURE CORRECTED  
AND HORIZONTALLY  
TAPED MEASUREMENTS

ROLAND W. ANDERSON  
COUNTY SURVEYOR  
ANOKA COUNTY, MINNESOTA

# W 1/4 Cor. Sec. 31-34-25

Found ~~1 1/2" iron pipe~~ from old  
Cartwright ties  
Found Cast Iron Monument (Reg. #5333) up  
0.3'±.  
July 17, 1970  
D. Powell  
R. Brien

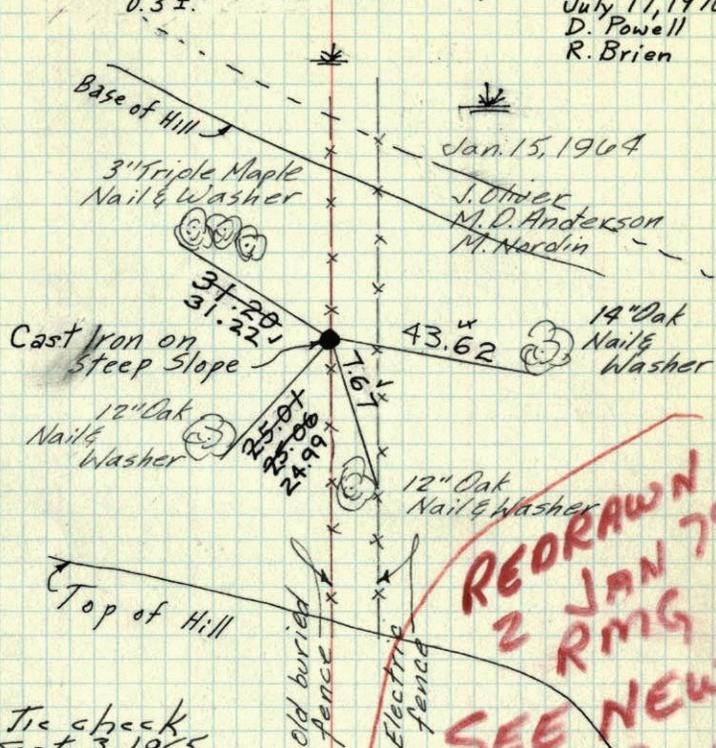

Tie check  
Sept. 3, 1965  
H. Larson  
J. Dunlop

Tie check  
June 10, 1974  
R. Farmer  
N. Dahl  
D. Dahl


TIE CHECK  
MAY 10, 1977  
R. SANNERUD  
D. DAHL  
S. BRIEN

ROLAND W. ANDERSON  
COUNTY SURVEYOR  
ANOKA COUNTY, MINNESOTA  
TEMPERATURE CORRECTED  
AND HORIZONTALLY  
TAPED MEASUREMENTS

REDRAWN  
2 JAN 79  
RMG  
SEE NEW  
TIE BOOK

XX W 1/4 Cor. Sec. 31-34-25

Found 1 1/2" iron pipe from old Cartwright ties  
Found C.I. Mon #5223 in place up 0.3±  
pipe up 0.5"

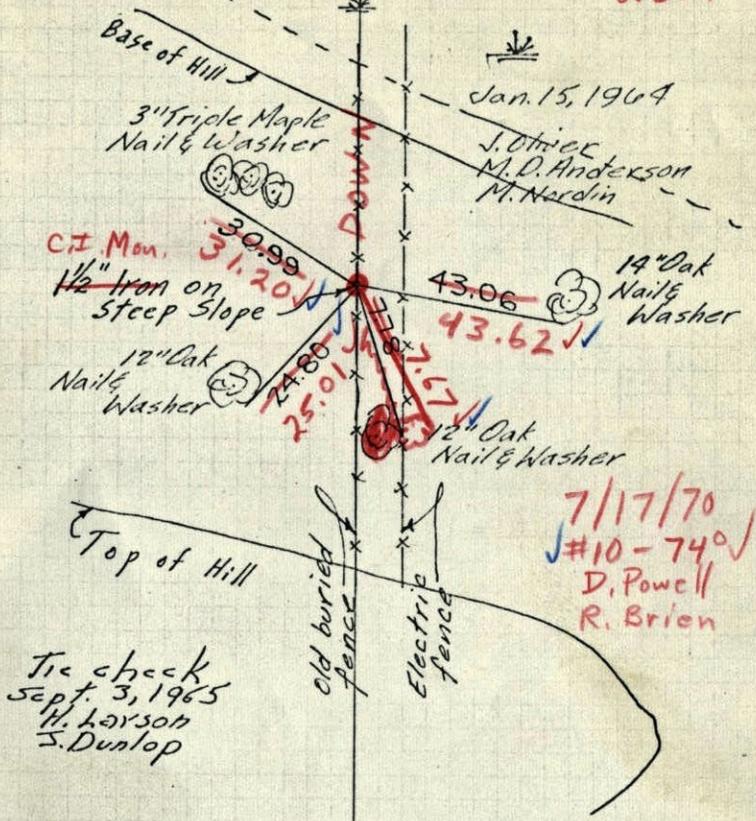

Jan. 15, 1964  
J. Oliver  
M.D. Anderson  
M. Nordin


7/17/70  
#10-740  
D. Powell  
R. Brien

Tie check  
Sept. 3, 1965  
H. Larson  
S. Dunlop

ROLAND W. ANDERSON  
COUNTY SURVEYOR  
ANOKA COUNTY, MINNESOTA  
TEMPERATURE CORRECTED  
AND HORIZONTALLY  
TAPED MEASUREMENTS

W 1/4 Cor. Sec. 31, T34, R25

Found 1 1/2" I.P. up 0.5' from Cartwright's Ties.  
Pipe is leaning about 0.1' E. & 0.1' N. - H.A.C.'s ties  
indicate Top center was used - Tied Same.

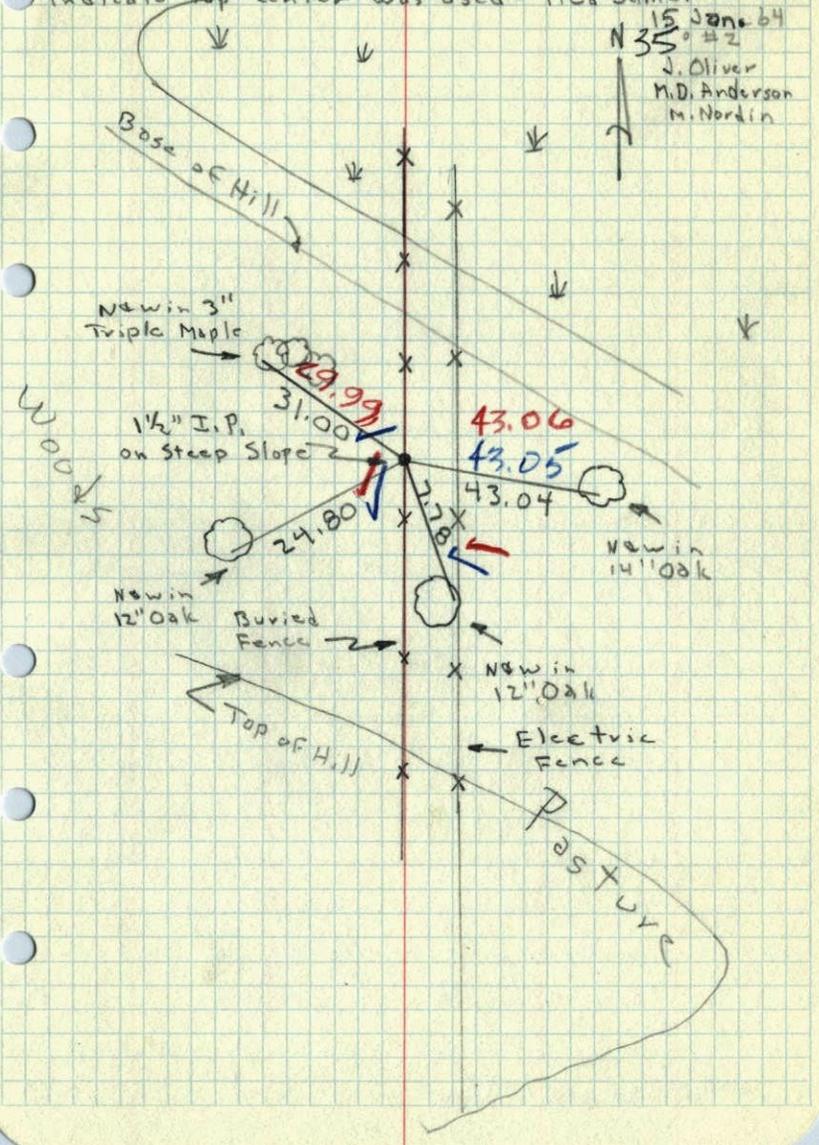

15 June 64  
N 35° 22'  
J. Oliver  
M.D. Anderson  
M. Nordin

PASTURE

W 1/4 Corn. Sec 31, 34-25

