

CERTIFICATE OF LOCATION OF GOVERNMENT CORNER

County of Anoka

State of Minnesota


Northeast Corner of Sec. 27 Township 34 Range 24

On the 16th day of April, 1971, the described corner was evidenced by area resurvey

and to perpetuate the location of said corner, at the exact location thereof, a permanent marker was placed consisting of a red and white iron pipe up 3'±

AND on the 17th day of March, 2014, said permanent marker was found and the ties were updated. Two Wildlife Management signs were found on the south side facing west.

Updated reference ties are as shown below.

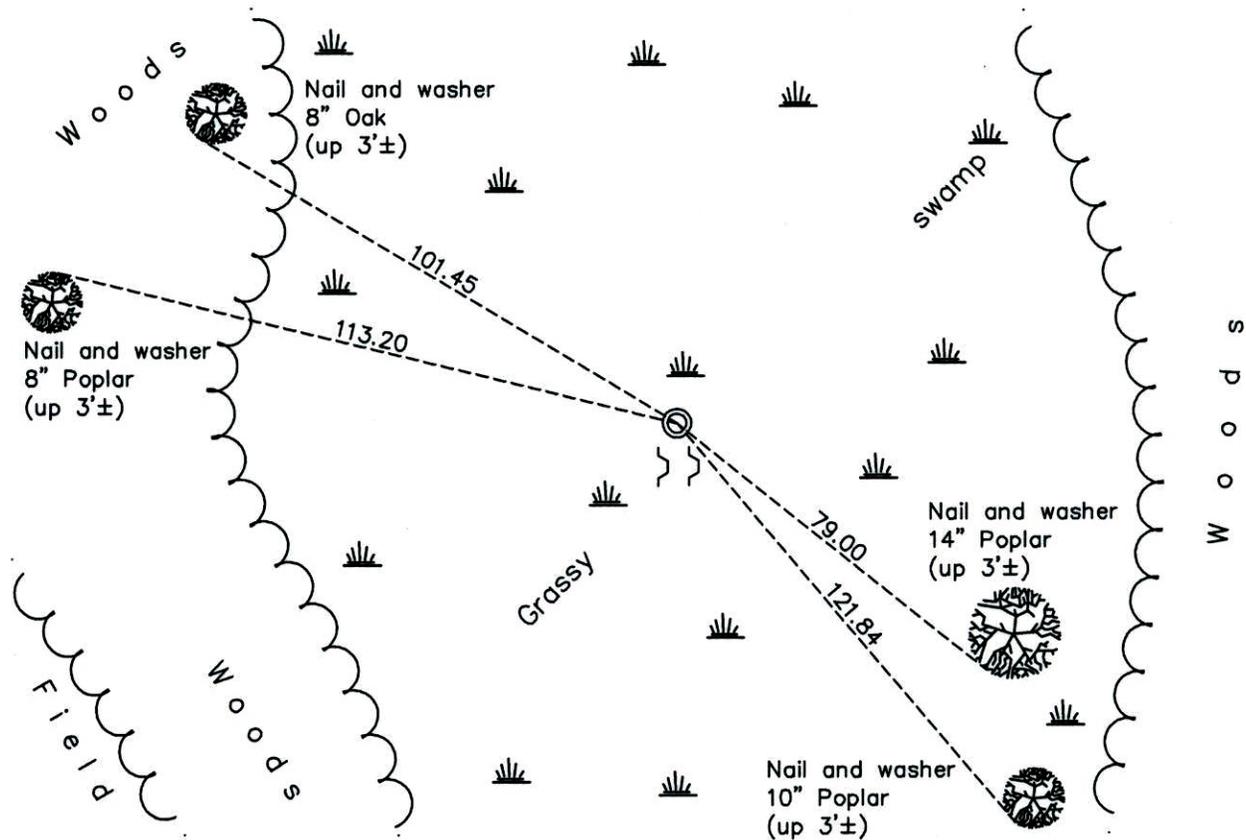

N

S

Revision Date

10/24/14

N.A.D. 1983 Coordinates
(1996 Adjustment)

County Project Coordinates	
Northing	237951.2795
Easting	489834.8883
Date	4/23/03

I hereby certify that this United States public land survey monument record is correct and complete to the best of my knowledge and belief.

Date 10/24/14

Larry D. Hoium, Anoka County Surveyor
 Minnesota License Number 18165