

CERTIFICATE OF LOCATION OF GOVERNMENT CORNER

County of Anoka

State of Minnesota


North 1/4 Corner of Sec. 35 Township 34 Range 24

On the 1st day of January, 1971, the described corner was evidenced by an iron pipe on top of a 1 1/2" bolt

and to perpetuate the location of said corner, at the exact location thereof, a permanent marker was placed consisting of a cast iron monument

AND on the 14th day of March, 2014, said permanent marker was found and the ties were updated

Updated reference ties are as shown below.

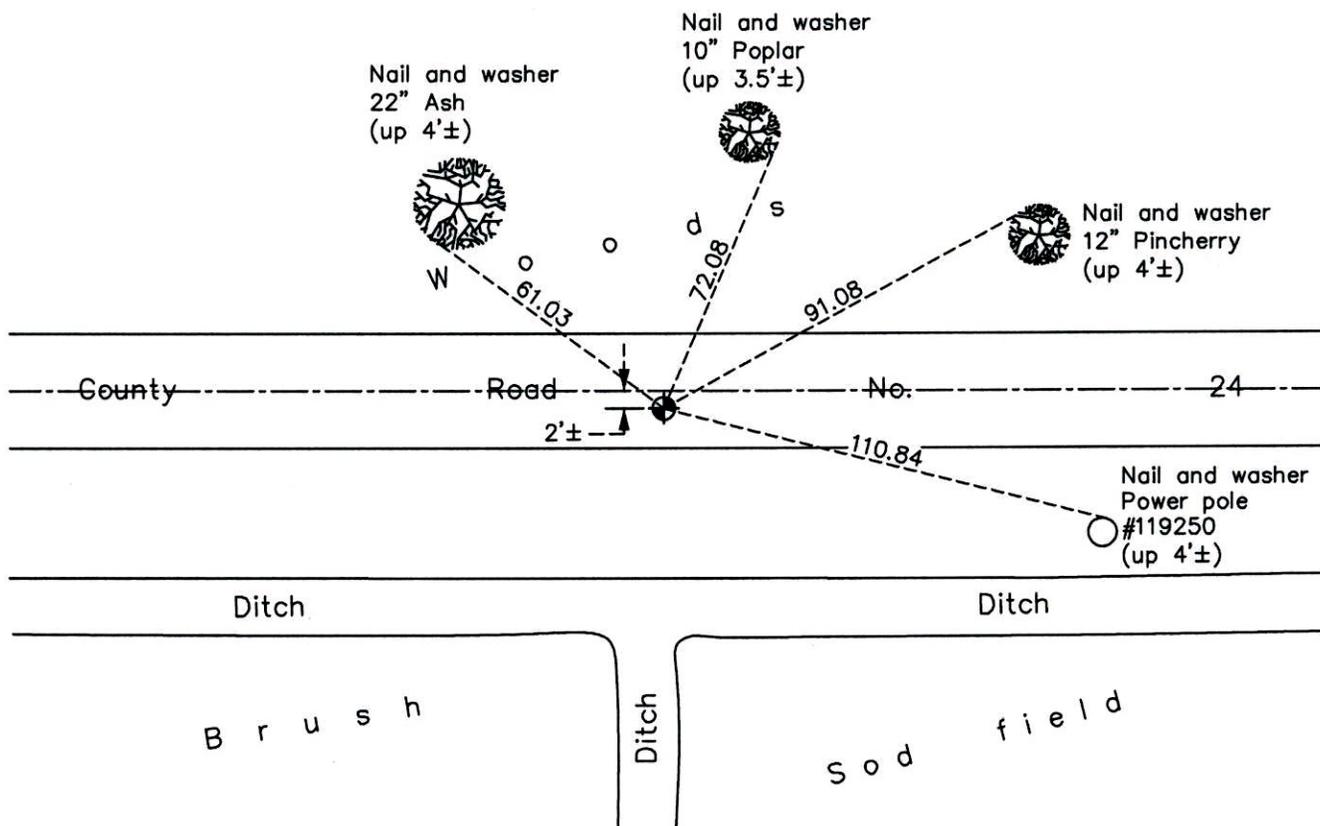

Revision Date

11/03/14

N.A.D. 1983 Coordinates
(1996 Adjustment)

County Project Coordinates	
Northing	<u>232674.7114</u>
Easting	<u>492457.8350</u>
Date	<u>4/24/03</u>

I hereby certify that this United States public land survey monument record is correct and complete to the best of my knowledge and belief.

Larry D. Hoium Date 11/03/14

Larry D. Hoium, Anoka County Surveyor

Minnesota License Number 18165