

CERTIFICATE OF LOCATION OF GOVERNMENT CORNER

County of Anoka

State of Minnesota


South 1/4 Corner of Sec. 27 Township 34 Range 24

On the 7th day of January, 1971, the described corner was evidenced by area resurvey

and to perpetuate the location of said corner, at the exact location thereof, a permanent marker was placed consisting of a cast iron monument

AND on the 12th day of March, 2014, said permanent marker was found and the ties
were updated

Updated reference ties are as shown below.

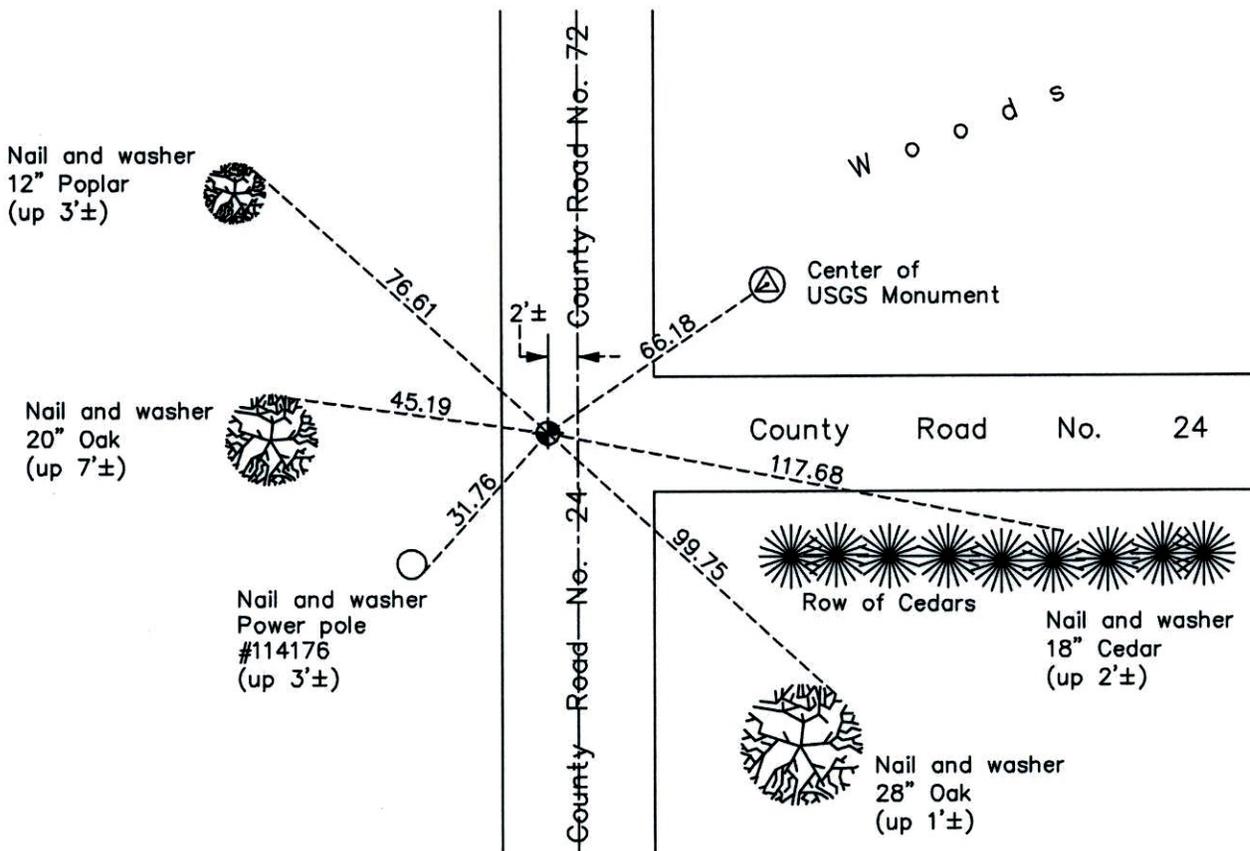

Revision Date

11/04/14

N.A.D. 1983 Coordinates
(1996 Adjustment)

County Project Coordinates	
Northing	<u>232700.2626</u>
Easting	<u>487169.2407</u>
Date	<u>4/24/03</u>

I hereby certify that this United States public land survey monument record is correct and complete to the best of my knowledge and belief.

Larry D. Hoium Date 11/04/14

Larry D. Hoium, Anoka County Surveyor
Minnesota License Number 18165