

CERTIFICATE OF LOCATION OF GOVERNMENT CORNER

County of Anoka

State of Minnesota



North 1/4 Corner of Sec. 31 Township 34 Range 24

On the 1st day of June, 1961, the described corner was evidenced by a 6" X 6" granite monument

and to perpetuate the location of said corner, at the exact location thereof, a permanent marker was placed consisting of a cast iron monument

AND on the 22nd day of October, 2014, said permanent marker was found broken. Replaced with a cast iron monument and the ties were updated.

Updated reference ties are as shown below.

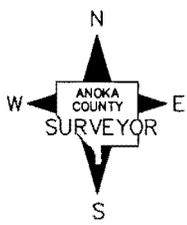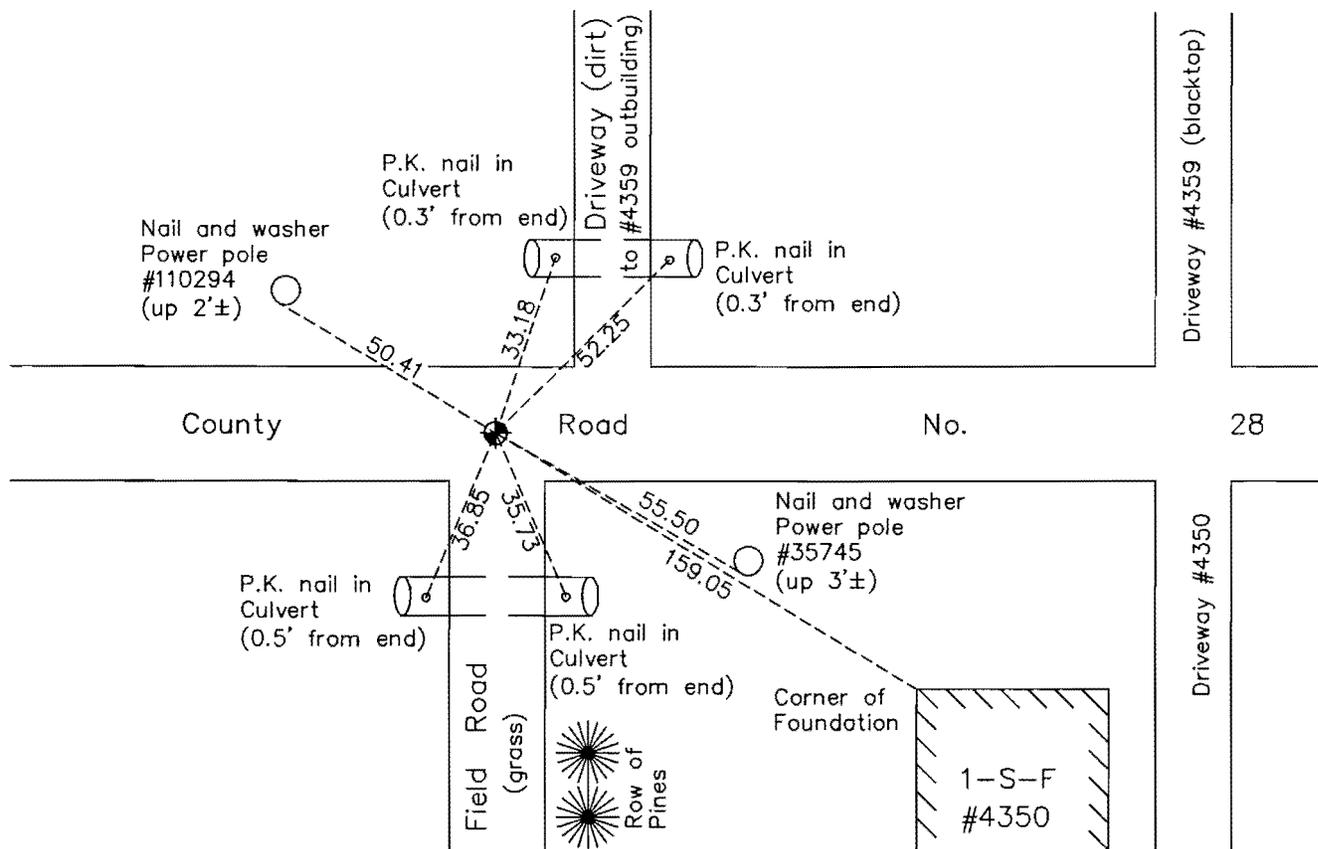

Revision Date 5/26/16

N.A.D. 1983 Coordinates
(1996 Adjustment)

County Project Coordinates	
Northing	232708.8496
Easting	471365.1815
Date	4/29/03

I hereby certify that this United States public land survey monument record is correct and complete to the best of my knowledge and belief.

Larry D. Hoium Date 5/26/16

Larry D. Hoium, Anoka County Surveyor
Minnesota License Number 18165