

CERTIFICATE OF LOCATION OF GOVERNMENT CORNER

County of Anoka

State of Minnesota


Northwest Corner of Sec. 31 Township 34 Range 24

On the 14th day of December, 1971, the described corner was evidenced by area resurvey

and to perpetuate the location of said corner, at the exact location thereof, a permanent marker was placed consisting of a cast iron monument

AND on the 7th day of April, 2014, said permanent marker was found and was raised to the surface and the ties were updated

Updated reference ties are as shown below.

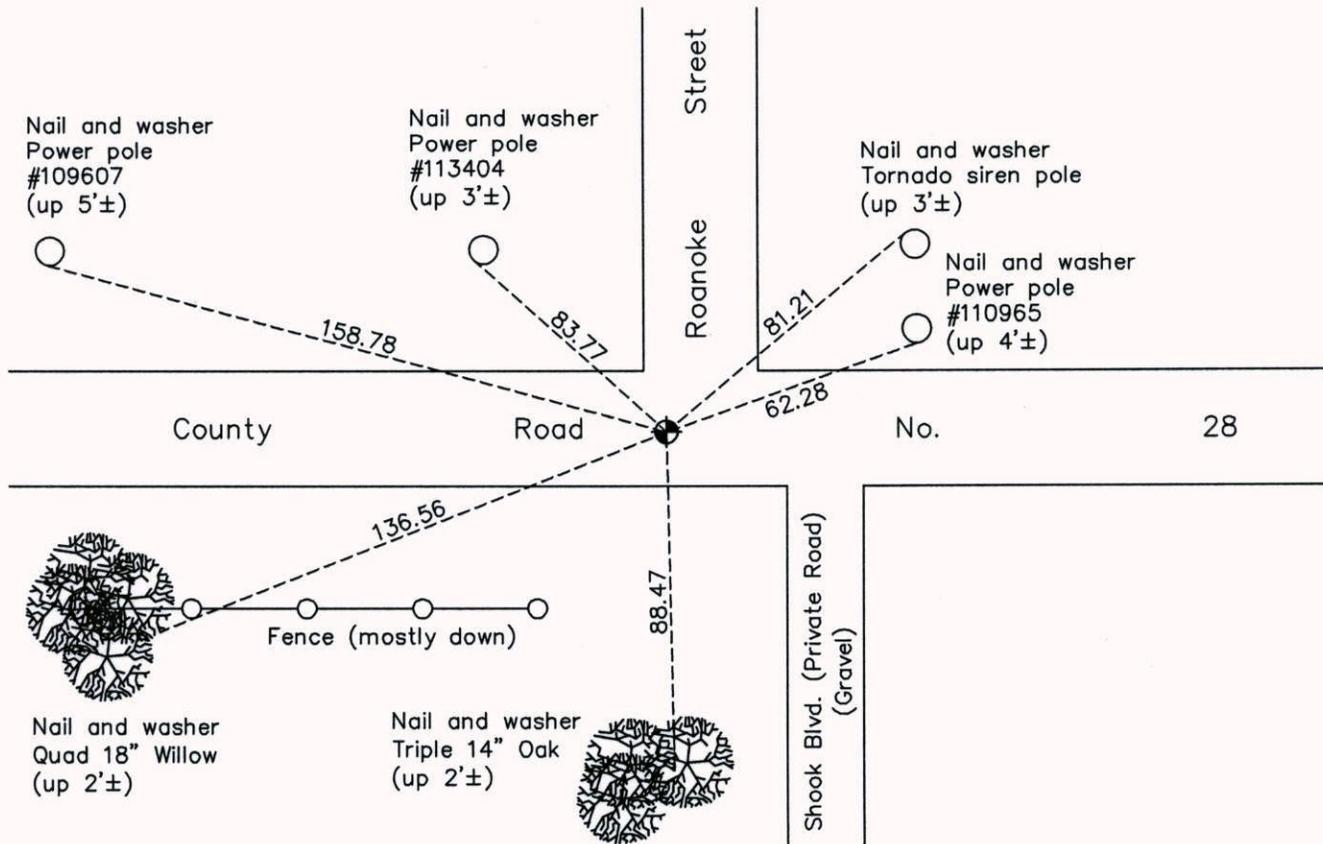

Revision Date
11/06/14

N.A.D. 1983 Coordinates
(1996 Adjustment)

County Project Coordinates	
Northing	232714.2485
Easting	468718.5164
Date	4/30/03

I hereby certify that this United States public land survey monument record is correct and complete to the best of my knowledge and belief.

Larry D. Hoium Date 11/06/14

Larry D. Hoium, Anoka County Surveyor

Minnesota License Number 18165