CERTIFICATE OF LOCATION OF GOVERNMENT CORNER

County of Anoka State of Minnesota

West 1/4 Corner of Sec. 31 Township 34 Range 24

On the 7th day of December, 1971, the described corner was evidenced by area resurvey

and to perpetuate the location of said corner, at the exact location thereof, a permanent marker was placed consisting of a cast iron monument with a sign and post on the north side

AND on the 25th day of March, 2014, said permanent marker was found and the ties were updated

Updated reference ties are as shown below.

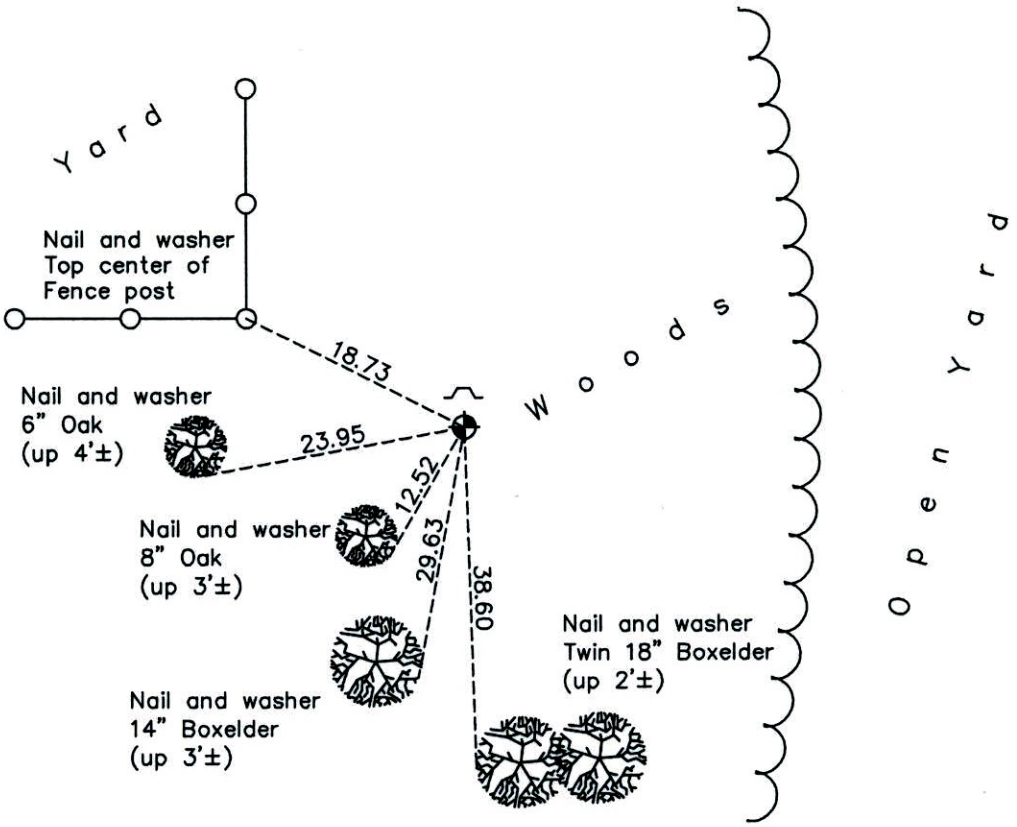

N
W ANOKA COUNTY SURVEYOR E
S

Revision Date
11/07/14

N.A.D. 1983 Coordinates
(1996 Adjustment)

County Project Coordinates	
Northing	230072.2062
Easting	468700.6237
Date	4/15/03

I hereby certify that this United States public land survey monument record is correct and complete to the best of my knowledge and belief.

Larry D. Hoium Date 11/07/14

Larry D. Hoium, Anoka County Surveyor

Minnesota License Number 18165