

CERTIFICATE OF LOCATION OF GOVERNMENT CORNER

County of Anoka

State of Minnesota


East 1/4 Corner of Sec. 32 Township 34 Range 24

On the 7th day of November, 1963, the described corner was evidenced by a 1" iron pipe

and to perpetuate the location of said corner, at the exact location thereof, a permanent marker was placed consisting of a cast iron monument with a sign and post on the north side

AND on the 7th day of April, 2014, said permanent marker was found down 0.5'± and the ties were updated

Updated reference ties are as shown below.

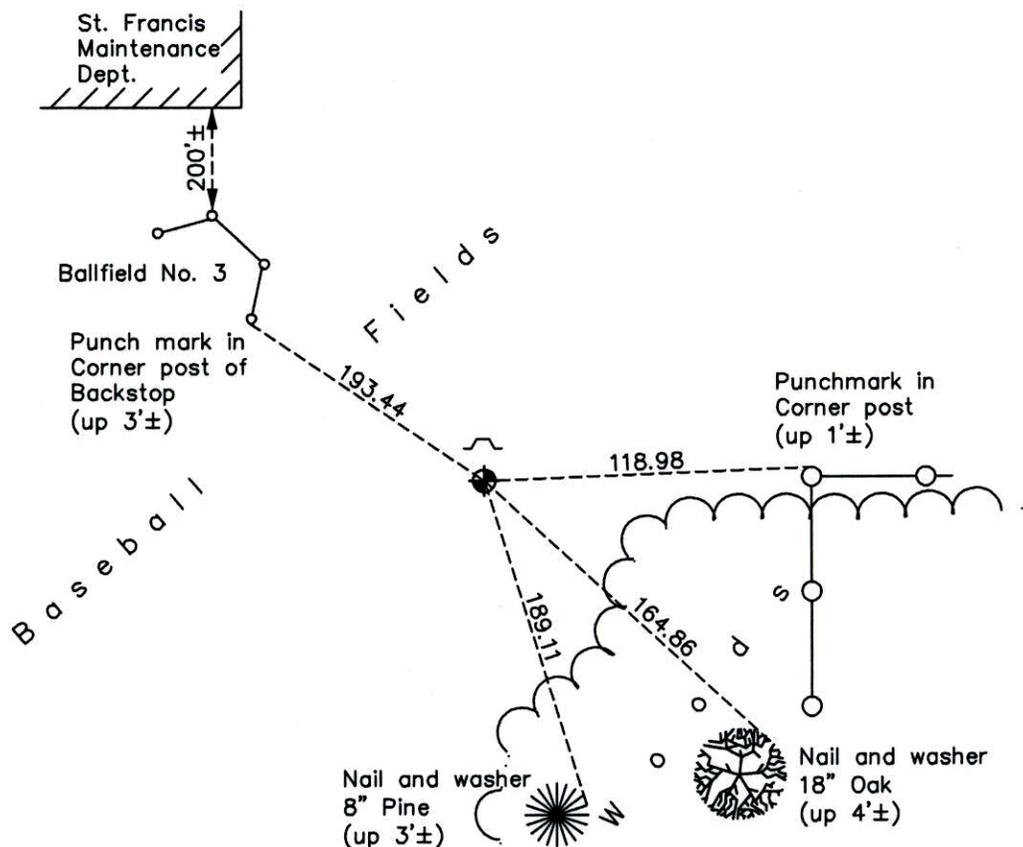

Revision Date

11/13/14

N.A.D. 1983 Coordinates
(1996 Adjustment)

County Project Coordinates

Northing 230073.4458

Easting 479261.6006

Date 8/15/01

I hereby certify that this United States public land survey monument record is correct and complete to the best of my knowledge and belief.

[Signature] Date 11/13/14

Larry D. Hoium, Anoka County Surveyor

Minnesota License Number 18165