

CERTIFICATE OF LOCATION OF GOVERNMENT CORNER

County of Anoka

State of Minnesota


North 1/4 Corner of Sec. 27 Township 34 Range 25

On the 31st day of August, 1976, the described corner was evidenced by area resurvey

and to perpetuate the location of said corner, at the exact location thereof, a permanent marker was placed consisting of a cast iron monument

AND on the 31st day of March, 2014, said permanent marker was found down 0.5'± and the ties were updated

Updated reference ties are as shown below.

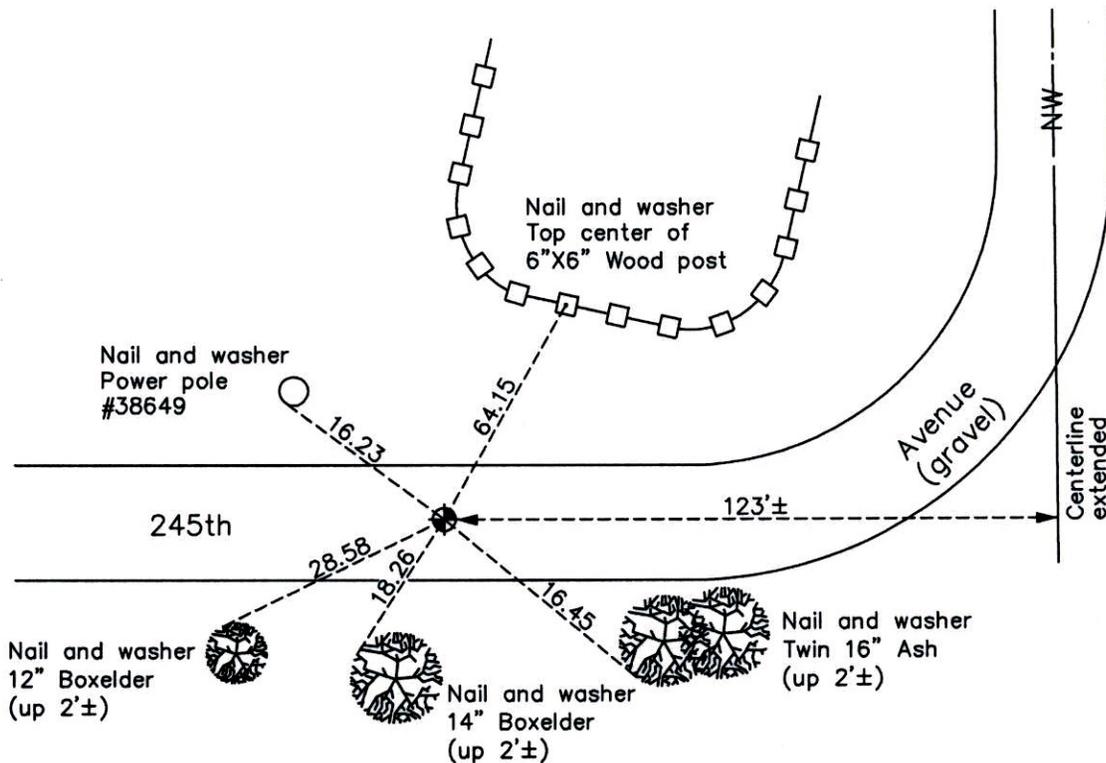

Revision Date
11/21/14

N.A.D. 1983 Coordinates
(1996 Adjustment)

County Project Coordinates	
Northing	238011.4496
Easting	455621.1518
Date	4/29/03

I hereby certify that this United States public land survey monument record is correct and complete to the best of my knowledge and belief.

Larry D. Hoium Date 11/21/14

Larry D. Hoium, Anoka County Surveyor
Minnesota License Number 18165