

CERTIFICATE OF LOCATION OF GOVERNMENT CORNER

County of Anoka

State of Minnesota


West 1/4 Corner of Sec. 30 Township 34 Range 25

On the 14th day of January, 1964, the described corner was evidenced by a 3/4" iron pipe

and to perpetuate the location of said corner, at the exact location thereof, a permanent marker was placed consisting of a cast iron monument with a sign and post on the north side

AND on the 9th day of April, 2014, said permanent marker was found and the ties were updated

Updated reference ties are as shown below.

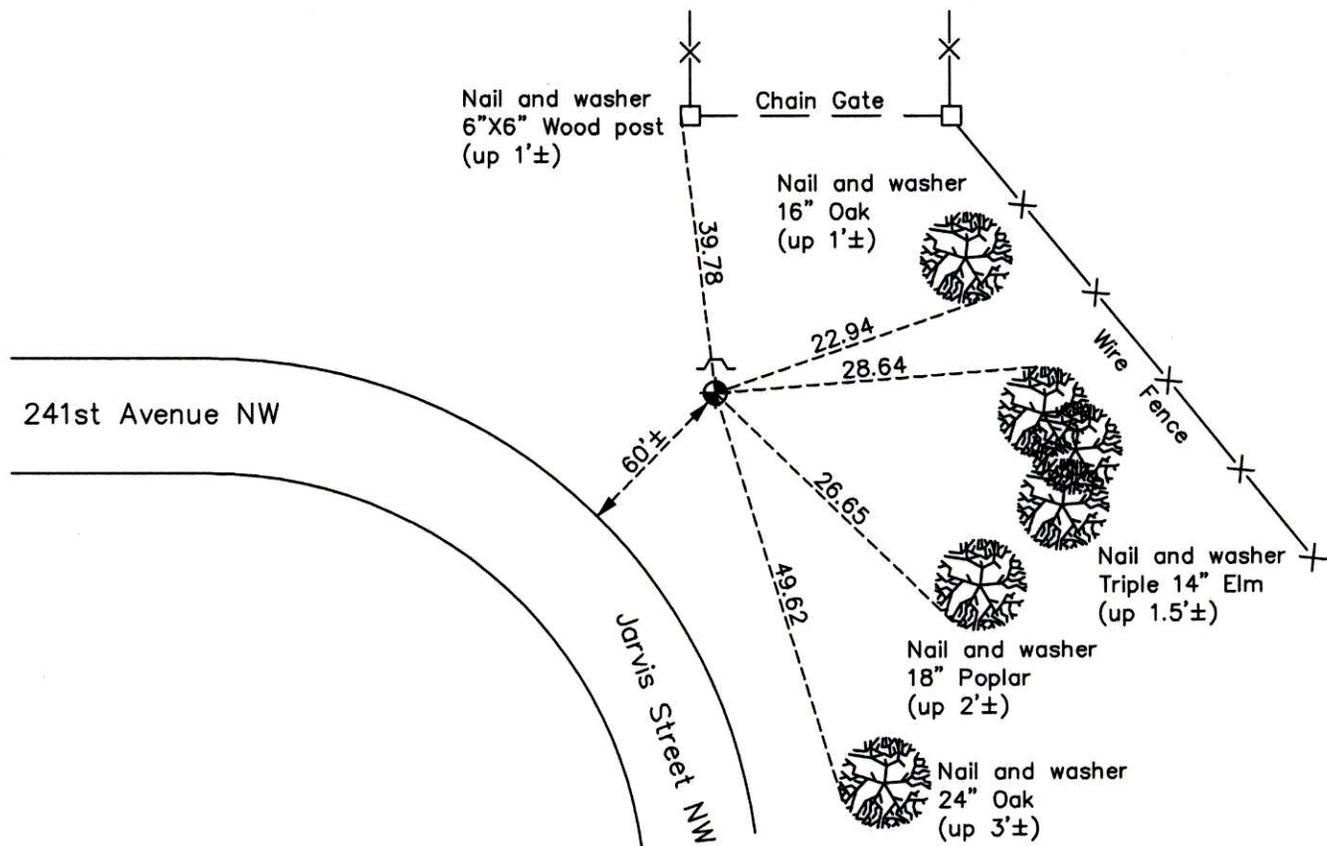

Revision Date
11/26/14

N.A.D. 1983 Coordinates
(1996 Adjustment)

County Project Coordinates	
Northing	235766.0531
Easting	437490.3514
Date	5/12/03

I hereby certify that this United States public land survey monument record is correct and complete to the best of my knowledge and belief.

Larry D. Hoium Date 11/26/14

Larry D. Hoium, Anoka County Surveyor
Minnesota License Number 18165