

CERTIFICATE OF LOCATION OF GOVERNMENT CORNER

County of Anoka

State of Minnesota


Southeast Corner of Sec. 28 Township 34 Range 25

On the 28th day of March, 1969, the described corner was evidenced by area resurvey

and to perpetuate the location of said corner, at the exact location thereof, a permanent marker was placed consisting of a cast iron monument

AND on the 28th day of March, 2014, said permanent marker was found down 0.6'± and the ties were updated

Updated reference ties are as shown below.

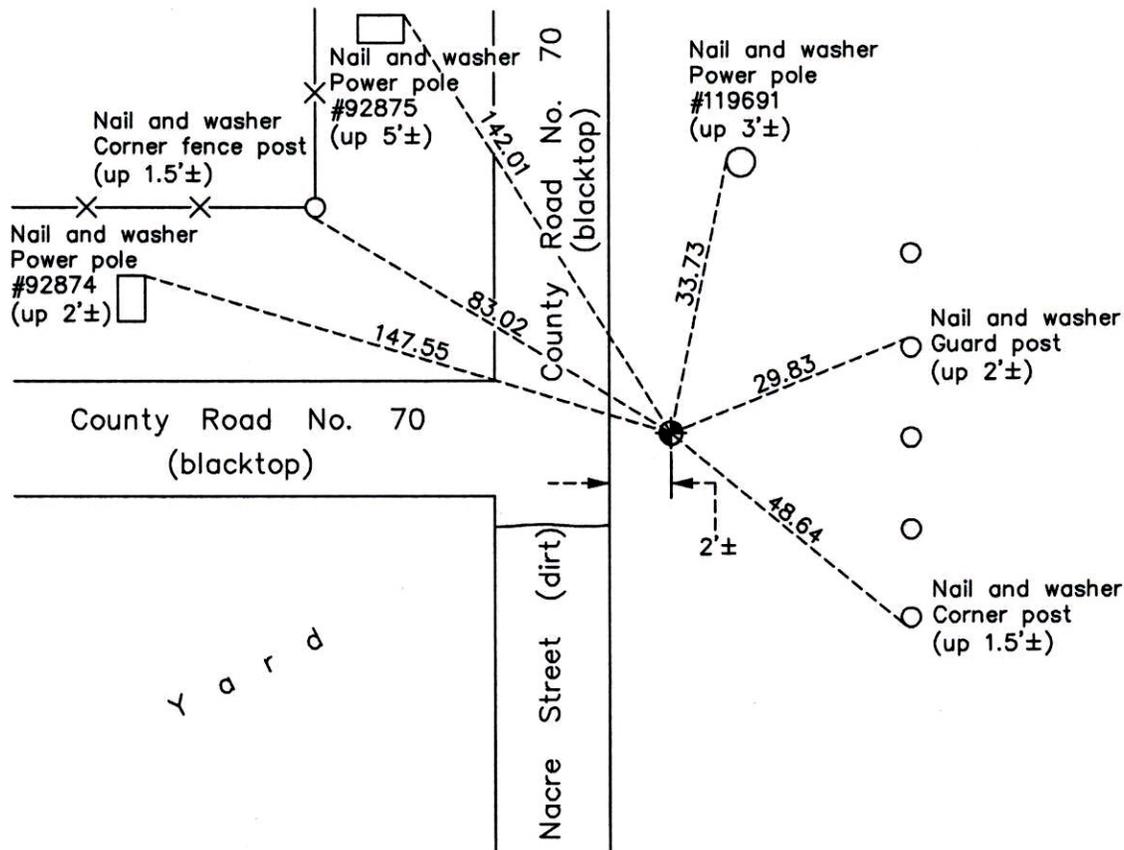

N
W ANOKA COUNTY SURVEYOR E
S

Revision Date
12/02/14

N.A.D. 1983 Coordinates
(1996 Adjustment)

County Project Coordinates	
Northing	232845.8941
Easting	452915.8393
Date	4/29/03

I hereby certify that this United States public land survey monument record is correct and complete to the best of my knowledge and belief.

Larry D. Hoium Date 12/02/14

Larry D. Hoium, Anoka County Surveyor
Minnesota License Number 18165