

# CERTIFICATE OF LOCATION OF GOVERNMENT CORNER

County of Anoka

State of Minnesota


## Northeast Corner of Sec. 31 Township 34 Range 25

On the 14th day of January, 1964, the described corner was evidenced by a 1" iron pipe  
from old ties

and to perpetuate the location of said corner, at the exact location thereof, a permanent marker  
 was placed consisting of a cast iron monument

AND on the 9th day of April, 2014, said permanent marker was found flush with the  
surface and with a sign and post on the west side. The ties were updated.

Updated reference ties are as shown below.

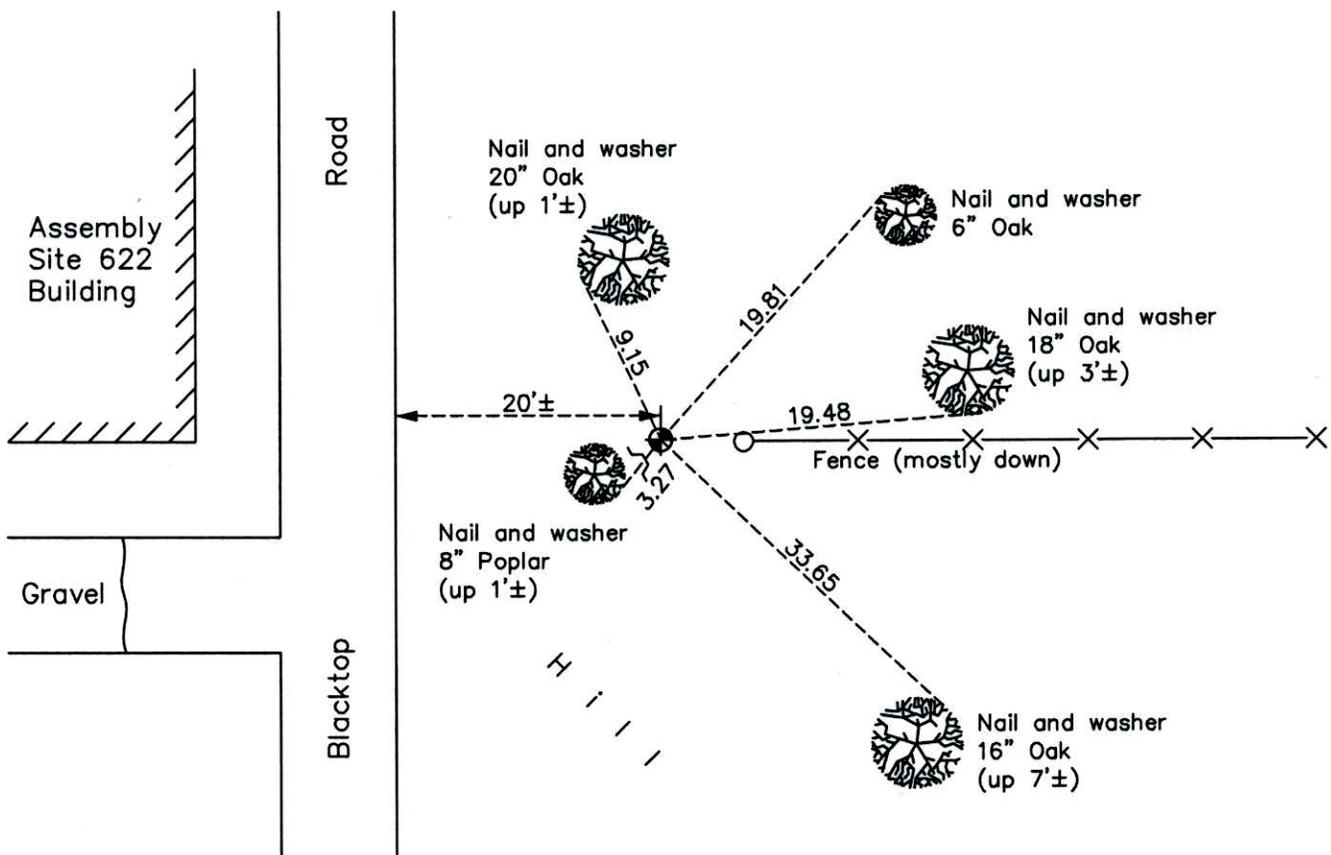

Revision Date

12/04/14

N.A.D. 1983 Coordinates  
 (1996 Adjustment)

County Project Coordinates

Northing 233008.0536

Easting 442381.6596

Date 5/28/03

I hereby certify that this United States public  
 land survey monument record is correct and  
 complete to the best of my knowledge and belief.

*Larry D. Hoium* Date 12/04/14

Larry D. Hoium, Anoka County Surveyor

Minnesota License Number 18165