

CERTIFICATE OF LOCATION OF GOVERNMENT CORNER

County of Anoka

State of Minnesota



North 1/4 Corner of Sec. 31 Township 34 Range 25

On the 15th day of January, 1964, the described corner was evidenced by Cartwright ties

and to perpetuate the location of said corner, at the exact location thereof, a permanent marker was placed consisting of a cast iron monument

AND on the 9th day of April, 2014, said permanent marker was found flush with the surface and with a sign and post 30'± south of monument. The ties were updated.

Updated reference ties are as shown below.

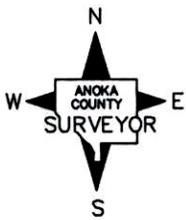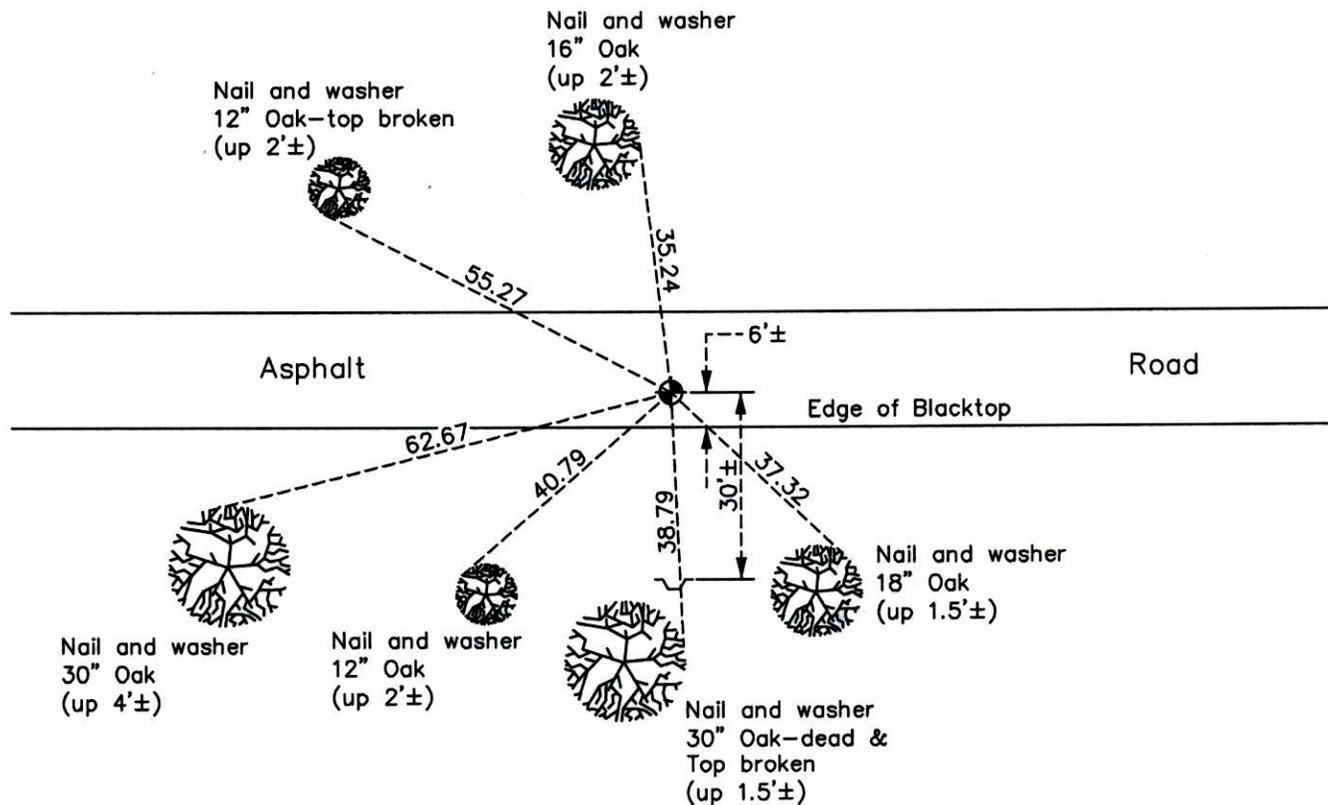

Revision Date
12/04/14

N.A.D. 1983 Coordinates
(1996 Adjustment)

County Project Coordinates	
Northing	<u>233076.3357</u>
Easting	<u>439810.9852</u>
Date	<u>4/03/06</u>

I hereby certify that this United States public land survey monument record is correct and complete to the best of my knowledge and belief.

Larry D. Hoium Date 12/04/14

Larry D. Hoium, Anoka County Surveyor

Minnesota License Number 18165