

CERTIFICATE OF LOCATION OF GOVERNMENT CORNER

County of Anoka

State of Minnesota


Northwest Corner of Sec. 31 Township 34 Range 25

On the 8th day of January, 1964, the described corner was evidenced by a 3/4" iron pipe

and to perpetuate the location of said corner, at the exact location thereof, a permanent marker was placed consisting of a cast iron monument with a sign and post on the south side labeled "PROP. COR. OW2"

AND on the 1st day of April, 2014, said permanent marker was found and the ties were updated

Updated reference ties are as shown below.

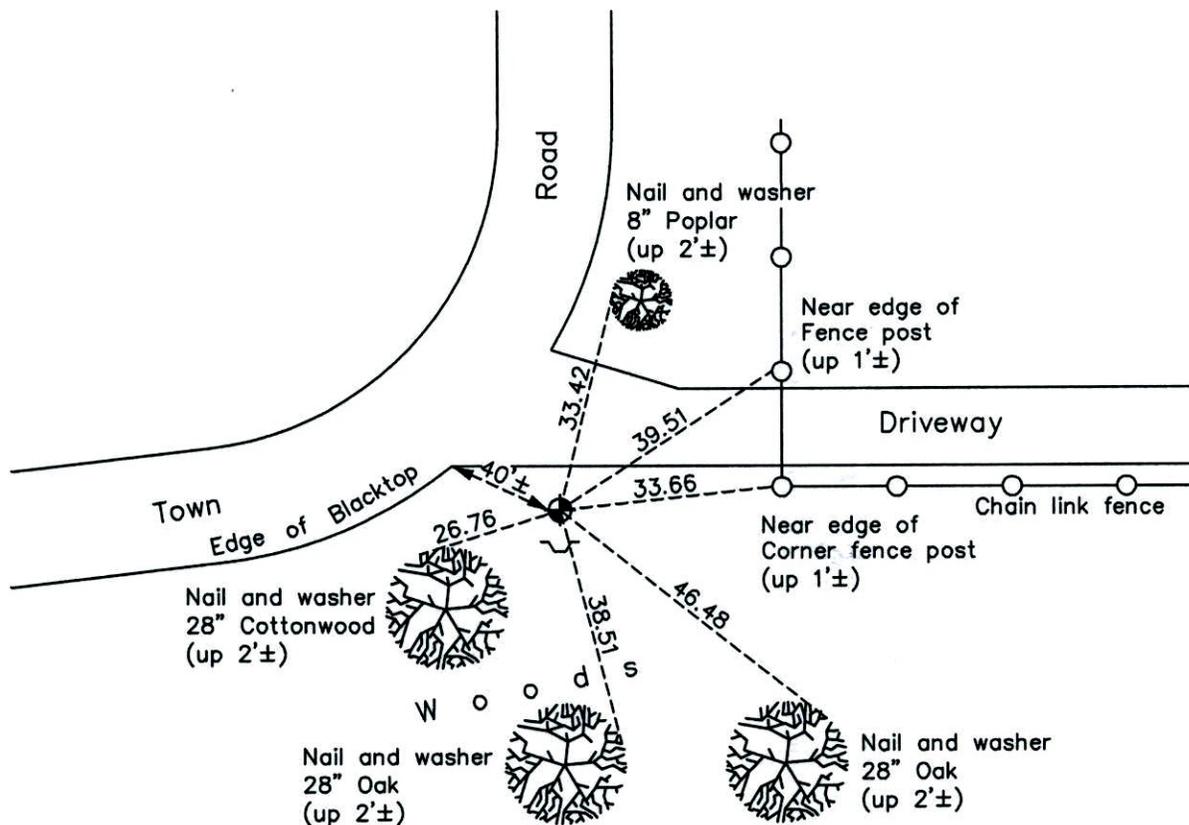

Revision Date
12/04/14

N.A.D. 1983 Coordinates
(1996 Adjustment)

County Project Coordinates	
Northing	<u>233137.2450</u>
Easting	<u>437496.4632</u>
Date	<u>5/15/03</u>

I hereby certify that this United States public land survey monument record is correct and complete to the best of my knowledge and belief.

Larry D. Hoium Date 12/04/14

Larry D. Hoium, Anoka County Surveyor
Minnesota License Number 18165