

CERTIFICATE OF LOCATION OF GOVERNMENT CORNER

County of Anoka

State of Minnesota



East 1/4 Corner of Sec. 31 Township 34 Range 25

On the 8th day of January, 1964, the described corner was evidenced by a 1" iron pipe

and to perpetuate the location of said corner, at the exact location thereof, a permanent marker was placed consisting of a cast iron monument

AND on the 9th day of April, 2014, said permanent marker was found up 0.1'± and with a sign and post on north side facing west. The ties were updated.

Updated reference ties are as shown below.

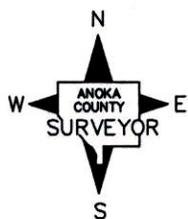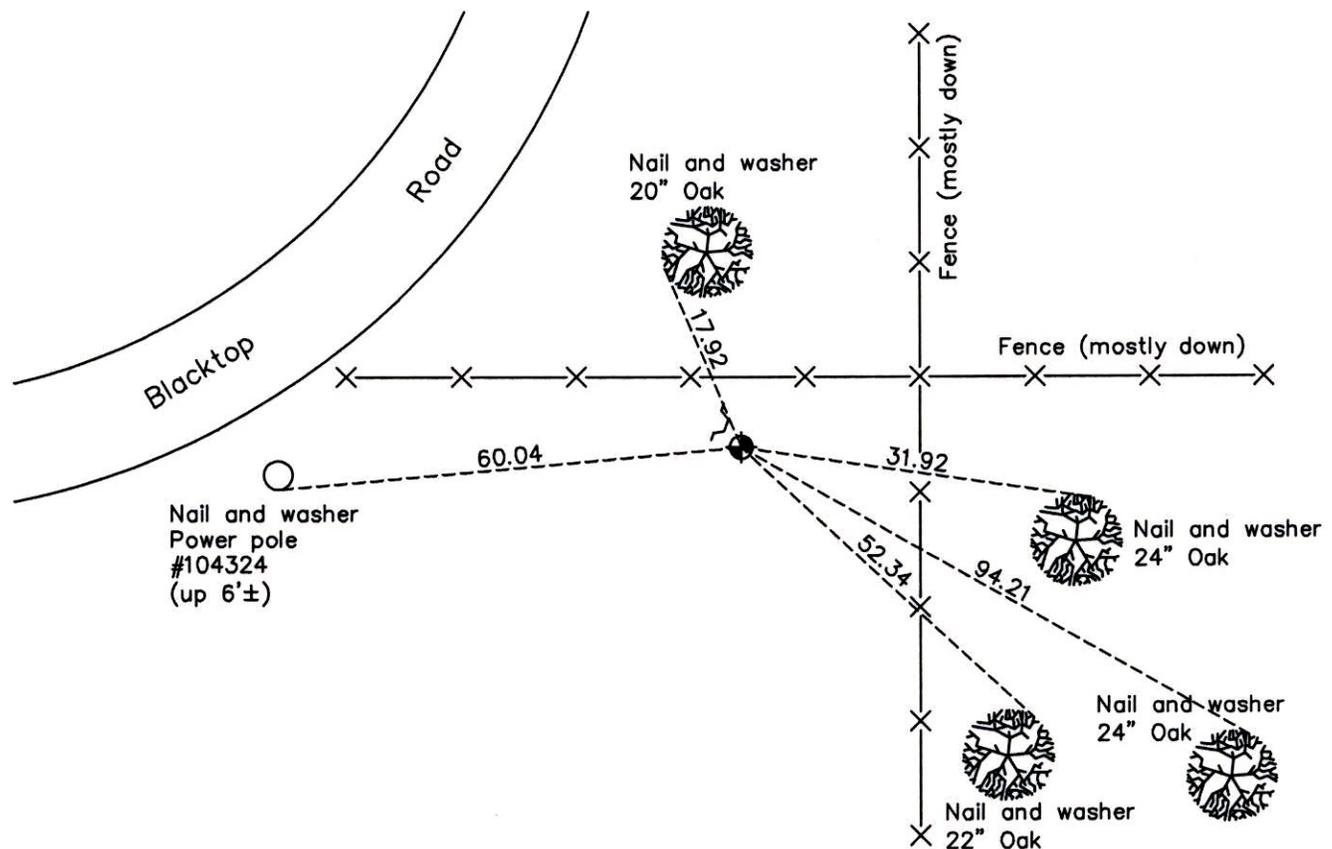

Revision Date
12/05/14

N.A.D. 1983 Coordinates
(1996 Adjustment)

County Project Coordinates	
Northing	<u>230388.1791</u>
Easting	<u>442346.7738</u>
Date	<u>5/14/03</u>

I hereby certify that this United States public land survey monument record is correct and complete to the best of my knowledge and belief.

Larry D. Hoium Date 12/05/14

Larry D. Hoium, Anoka County Surveyor

Minnesota License Number 18165