

COON RAPIDS BLVD.

FLINTWOOD

ST. N.W.

93RD AVE. N.W.

RESTAURANT



OFFICE

OFFICE

SPRINGBROOK DRIVE


DRIVE

PLEASURE CREEK

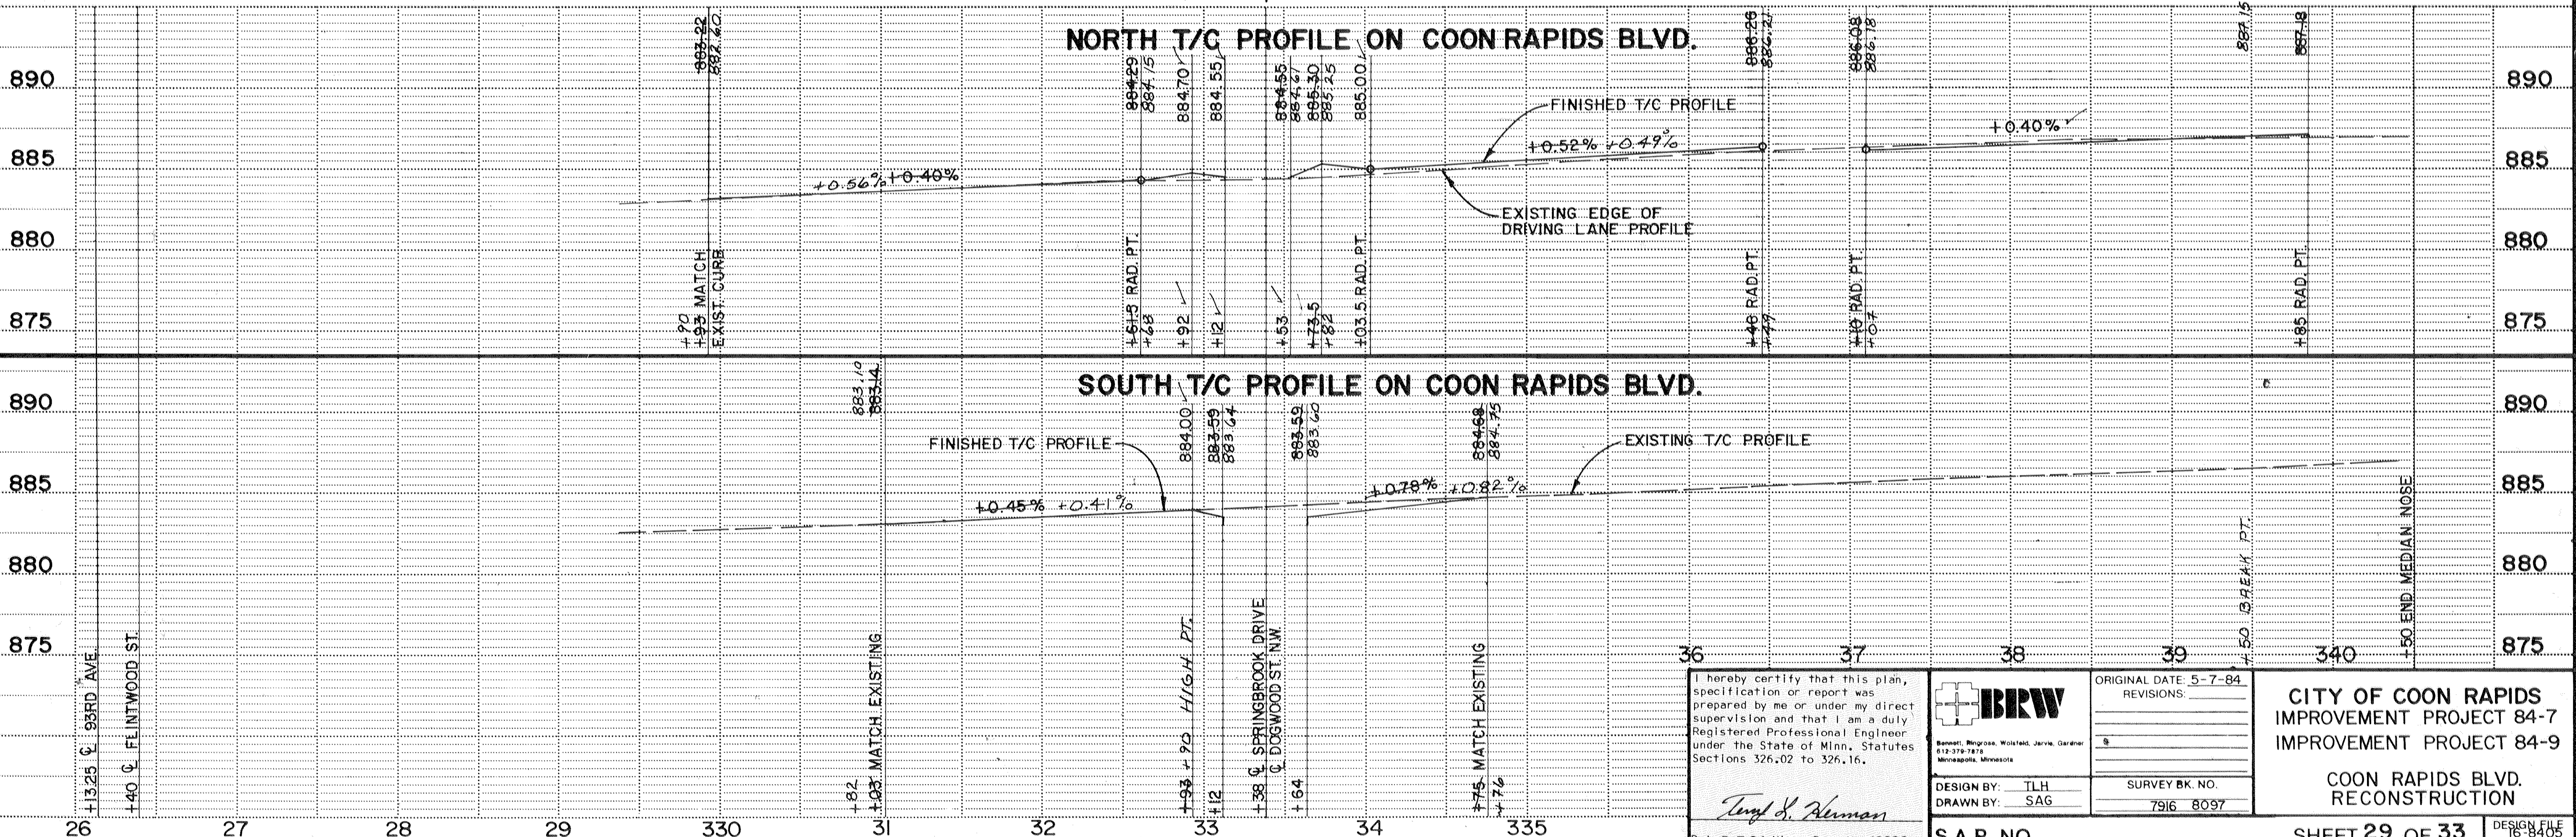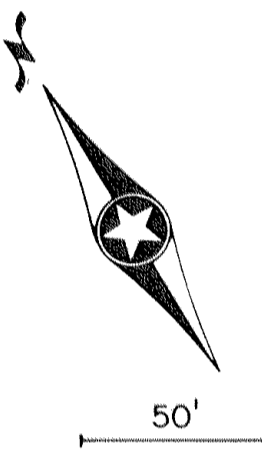

I hereby certify that this plan, specification or report was prepared by me or under my direct supervision and that I am a duly Registered Professional Engineer under the State of Minn. Statutes Sections 326.02 to 326.16.

Tony S. Alaman
Date 5-7-84 Minn. Reg. No. 12699

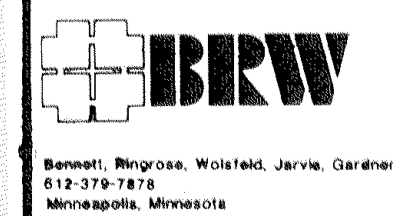

ORIGINAL DATE: 5-7-84
REVISIONS:

DESIGN BY: TLH
DRAWN BY: SAG

SURVEY BK. NO.
7916 8097

CITY OF COON RAPIDS
IMPROVEMENT PROJECT 84-7
IMPROVEMENT PROJECT 84-9

COON RAPIDS BLVD.
RECONSTRUCTION

S.A.P. NO. SHEET 29 OF 33

AS-BUILT - 1/3/84 - DRV