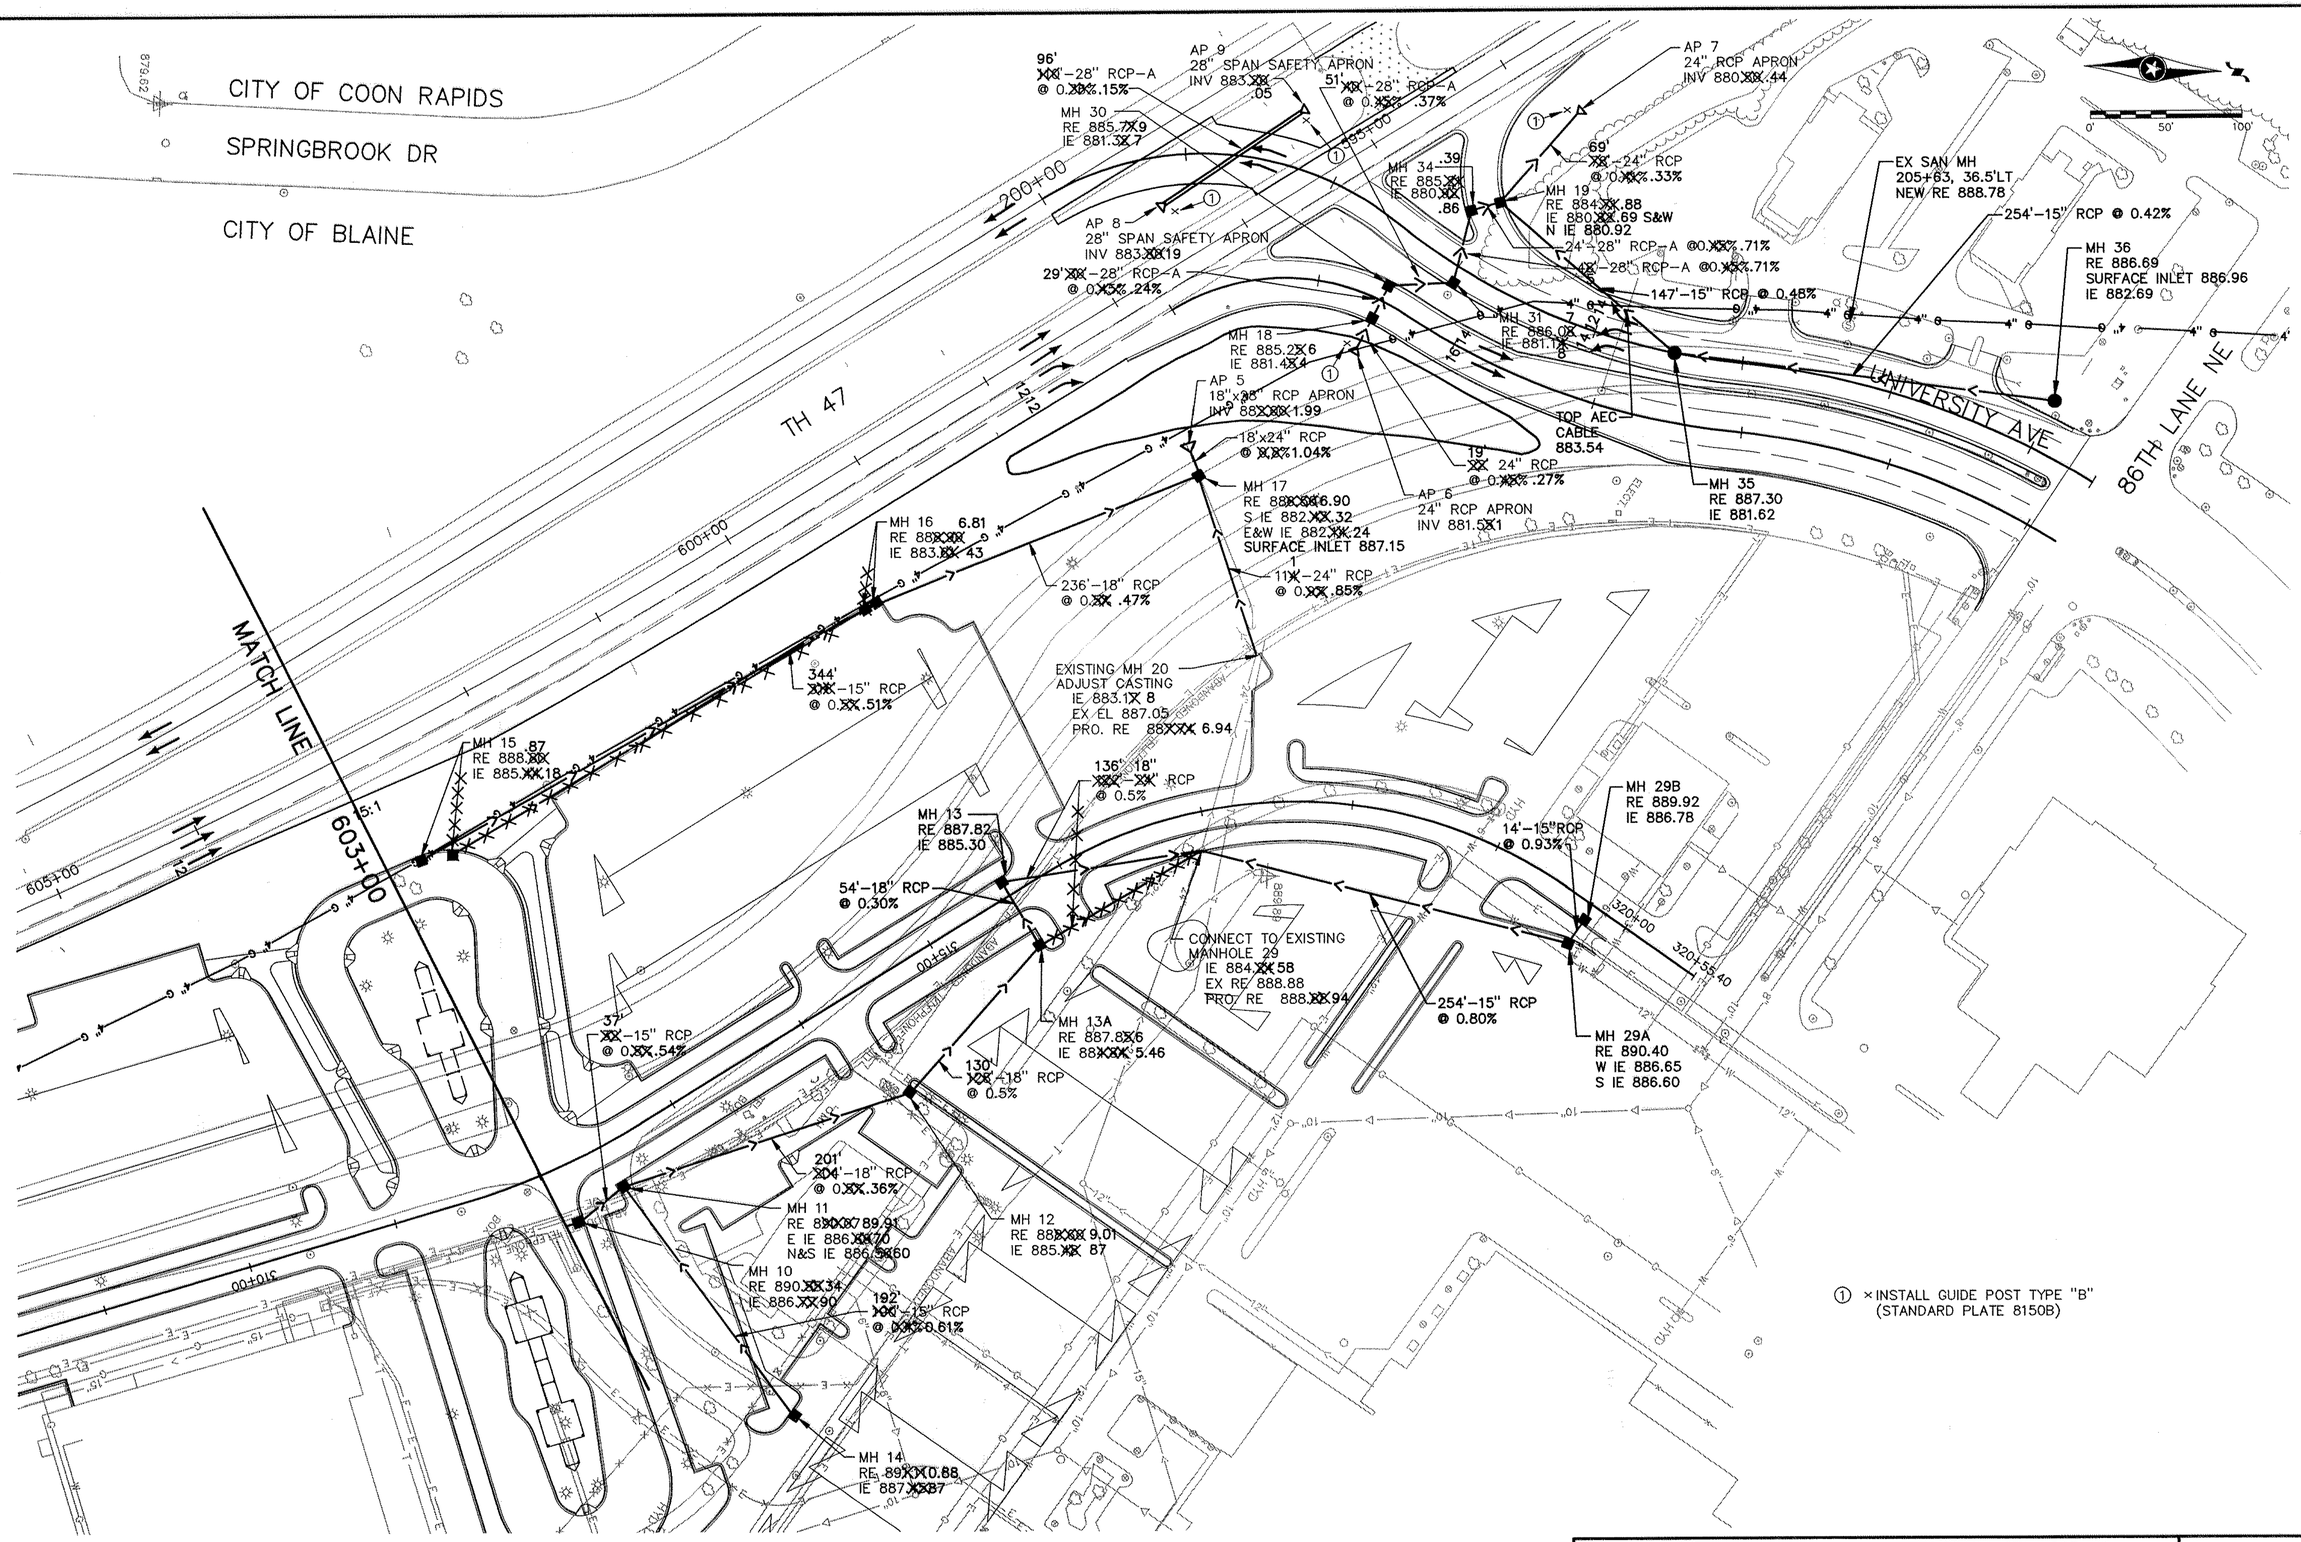

REVISION NO. DATE	EXPLANATION
01-09-97	AS BUILT

SCALE: AS NOTED
PLAN BY: JMB
DESIGN BY: TJG
CHECKED BY:
COMM.NO.:
RECORD COPY BY:
DATE: 10-14-94

I HEREBY CERTIFY THAT THIS PLAN, SPECIFICATION OR REPORT WAS MADE BY ME OR UNDER MY DIRECT SUPERVISION AND THAT I AM A DULY REGISTERED PROFESSIONAL ENGINEER UNDER THE LAWS OF THE STATE OF MINNESOTA.

DATE Feb 7, 1997 REG. NO. 10753

BRW
PLANNING • TRANSPORTATION • ENGINEERING • URBAN DESIGN
Traveler Square, 700 Third Street South, Hpls, MN 55415

DRAWING NAME: DRAIN2.DWG PLOT DATE: 1-17-97 (AS BUILT)

STATE PROJECT NO. 02-600-11

STA. 595+00 TO STA. 603+00
DRAINAGE PLAN