

CIC NUMBER 27

MARSHAN LAKE CONDOMINIUMS, A COMMON INTEREST COMMUNITY

SECOND SUPPLEMENTAL CIC PLAT

This CIC plat is prt of the Declaration recorded as Document Number 1289137 on the 28 day of July, 1997

I, Jeffrey N. Caine, do hereby certify that the work was undertaken by or reviewed and approved by me for this SECOND SUPPLEMENTAL CIC NUMBER 27, MARSHAN LAKE CONDOMINIUMS, A COMMON INTEREST COMMUNITY, being located upon:

That part of Government Lot 2, Section 20, Township 31, Range 22, Anoka County, Minnesota, described as follows:

Commencing at the southeast corner of the north 849.40 feet of the west 240.00 feet of said Government Lot 2 (for the purposes of this description the west line of said Government Lot 2 is assumed to have a bearing of South 00 degrees 18 minutes 08 seconds West); thence North 82 degrees 52 minutes 55 seconds East, a distance of 38.49 feet; thence South 00 degrees 18 minutes 08 seconds West, parallel with the west line of said Government Lot 2, a distance of 417.58 feet to the north line of the south 60.00 feet of said Government Lot 2; thence North 00 degrees 18 minutes 08 seconds East, parallel with said west line, a distance of 314.19 feet; thence northeasterly along a tangential curve, concave to the southeast, having a radius of 230.00 feet and a central angle of 17 degrees 39 minutes 52 seconds, a distance of 70.91 feet; thence North 17 degrees 58 minutes 00 seconds East, tangent to said curve, a distance of 213.84 feet to the point of beginning of the property to be described; thence North 17 degrees 58 minutes 00 seconds East a distance of 55.79 feet; thence North 71 degrees 00 minutes 13 seconds West, a distance of 141.17 feet; thence South 18 degrees 59 minutes 47 seconds West a distance of 55.78 feet to the intersection with a line which bears North 71 degrees 00 minutes 13 seconds West from the point of beginning; thence South 71 degrees 00 minutes 13 seconds East, a distance of 142.17 feet to the point of beginning.

And the Additional Real Estate described as follows:

That part of Government Lot 2, Section 20, Township 31, Range 22, Anoka County, Minnesota, lying easterly of the easterly right-of-way line of Lake Drive, formerly known as State Trunk Highway No. 49, said easterly right-of-way line is described as follows:

Beginning at a point on the north line of said Government Lot 2, distant 354.43 feet easterly of the northwest corner thereof, for the purposes of this description, the west line of said Government Lot 2 is assumed to bear South 00 degrees 18 minutes 08 seconds West; thence South 25 degrees 48 minutes 00 seconds West, a distance of 118.98 feet; thence southwesterly along a tangential curve, concave to the southeast, having a radius of 2819.22 feet and a central angle of 07 degrees 50 minutes 00 seconds, a distance of 385.44 feet; thence South 17 degrees 58 minutes 00 seconds West, tangent to said curve, a distance of 532.41 feet to the west line of said Government Lot 2, and there terminating.

EXCEPT the following five parcels:

Exception No. 1:

That part of Government Lot 2, Section 20, Township 31, Range 22, Anoka County, Minnesota, described as follows:

Beginning at the southeast corner of the north 849.40 feet of the west 240.00 feet of said Government Lot 2 (for the purposes of this description the west line of said Government Lot 2 is assumed to have a bearing of South 00 degrees 18 minutes 08 seconds West); thence North 82 degrees 52 minutes 55 seconds East, a distance of 38.49 feet; thence South 00 degrees 18 minutes 08 seconds West, parallel with the west line of said Government Lot 2, a distance of 417.58 feet to the north line of the south 60.00 feet of said Government Lot 2; thence North 89 degrees 20 minutes 25 seconds West, along said north line, a distance of 278.18 feet to the west line of said Government Lot 2; thence northerly along said west line, a distance of 287.02 feet to said easterly right-of-way line of Lake Drive; thence North 17 degrees 58 minutes 00 seconds East along said easterly right-of-way line, a distance of 130.76 feet to the intersection with a line drawn westerly, parallel with the north line of said Government Lot 2, from the point of beginning; thence South 89 degrees 29 minutes 07 seconds East, along said parallel line, a distance of 200.33 feet to the point of beginning.

Exception No. 2:

That part of Government Lot 2, Section 20, Township 31, Range 22, Anoka County, Minnesota, lying easterly of the following described line:

Beginning at a point on the south line of said Government Lot 2, distant 1130.00 feet east of the southwest corner thereof; thence North 13 degrees 21 minutes 20 seconds East, a distance of 690 feet, more or less, to a point of intersection with the shoreline of Marshan Lake and there terminating. For the purposes of this description, the south line of said Government Lot 2 is assumed to have a bearing of East.

Exception No. 3:

The South 60.00 feet of said Government Lot 2, Section 20, Township 31, Range 22.

Exception No. 4:

That part of Government Lot 2, Section 20, Township 31, Range 22, Anoka County, Minnesota, described as follows:

Commencing at the southeast corner of the north 849.40 feet of the west 240.00 feet of said Government Lot 2 (for the purposes of this description the west line of said Government Lot 2 is assumed to have a bearing of South 00 degrees 18 minutes 08 seconds West); thence North 82 degrees 52 minutes 55 seconds East, a distance of 38.49 feet; thence South 00 degrees 18 minutes 08 seconds West, parallel with the west line of said Government Lot 2, a distance of 417.58 feet to the north line of the south 60.00 feet of said Government Lot 2; thence North 00 degrees 18 minutes 08 seconds East, parallel with said west line, a distance of 314.19 feet; thence northerly along a tangential curve, concave to the east, having a radius of 230.00 feet and a central angle of 17 degrees 39 minutes 52 seconds, a distance of 70.91 feet; thence North 17 degrees 58 minutes 00 seconds East, tangent to said curve, a distance of 353.97 feet; thence northeasterly along a tangential curve, concave to the southeast, having a radius of 2572.72 feet and a central angle of 06 degrees 44 minutes 00 seconds, a distance of 302.35 feet; thence northeasterly along a compound curve, concave to the southeast, having a radius of 130.00 feet and a central angle of 65 degrees 48 minutes 53 seconds, a distance of 149.33 feet; thence South 89 degrees 29 minutes 07 seconds East, tangent to said curve, a distance of 241.66 feet; thence South 17 degrees 01 minutes 26 seconds West, tangent to said curve, a distance of 321.75 feet; thence southerly along a tangential curve, concave to the east, having a radius of 100.00 feet and a central angle of 09 degrees 33 minutes 17 seconds, a distance of 16.68 feet; thence South 07 degrees 28 minutes 09 seconds West, tangent to said curve, a distance of 367.77 feet to the point of beginning of the property to be described; thence North 82 degrees 35 minutes 08 seconds West, a distance of 60.00 feet; thence South 07 degrees 28 minutes 09 seconds West, a distance of 233.80 feet to the north line of the south 60.00 feet of said Government Lot 2; thence South 89 degrees 20 minutes 25 seconds East along said north line, a distance of 190.22 feet; thence North 07 degrees 24 minutes 52 seconds East, a distance of 211.42 feet to the intersection with a line which bears South 82 degrees 35 minutes 08 seconds East from the point of beginning; thence North 82 degrees 35 minutes 08 seconds West, a distance of 128.68 feet to the point of beginning.

Exception No. 5:

That part of Government Lot 2, Section 20, Township 31, Range 22, Anoka County, Minnesota, described as follows:

Commencing at the southeast corner of the north 849.40 feet of the west 240.00 feet of said Government Lot 2 (for the purposes of this description the west line of said Government Lot 2 is assumed to have a bearing of South 00 degrees 18 minutes 08 seconds West); thence North 82 degrees 52 minutes 55 seconds East, a distance of 38.49 feet; thence South 00 degrees 18 minutes 08 seconds West, parallel with the west line of said Government Lot 2, a distance of 417.58 feet to the north line of the south 60.00 feet of said Government Lot 2; and to the point of beginning of a line to be hereinafter known as "Line B"; thence North 00 degrees 18 minutes 08 seconds East, parallel with said west line, a distance of 314.19 feet; thence northeasterly along a tangential curve, concave to the southeast, having a radius of 230.00 feet and a central angle of 17 degrees 39 minutes 52 seconds, a distance of 70.91 feet; thence North 17 degrees 58 minutes 00 seconds East, tangent to said curve, a distance of 199.84 feet to a point to be hereinafter known as "Point A"; thence North 17 degrees 58 minutes 00 seconds East, a distance of 139.45 feet to the point of beginning of the property to be described, and said "Line A" there terminating; thence North 71 degrees 00 minutes 13 seconds West, a distance of 246.54 feet to the easterly right-of-way line of Lake Drive, formerly known as State Trunk Highway No. 49, said easterly right-of-way line is described as follows:

Beginning at a point on the north line of said Government Lot 2, distant 354.43 feet easterly of the northwest corner thereof, for the purposes of this description, the west line of said Government Lot 2 is assumed to bear South 00 degrees 18 minutes 08 seconds West; thence South 25 degrees 48 minutes 00 seconds West, a distance of 118.98 feet; thence southwesterly along a tangential curve, concave to the southeast, having a radius of 2819.22 feet and a central angle of 07 degrees 50 minutes 00 seconds, a distance of 385.44 feet; thence South 17 degrees 58 minutes 00 seconds West, tangent to said curve, a distance of 532.41 feet to the west line of said Government Lot 2, and there terminating.

thence southerly along said easterly right-of-way line, a distance of 139.45 feet to the intersection with a line which bears North 71 degrees 00 minutes 13 seconds West from said "Point A"; thence South 71 degrees 00 minutes 13 seconds East, a distance of 246.54 feet to the intersection with said "Line B"; thence southerly along said "Line B" a distance of 584.94 feet to the north line of said south 60.00 feet; thence easterly along said north line a distance of 60.00 feet to the intersection with a line drawn parallel with and distant 60.00 feet easterly of, as measured at right angles to said "Line B, thence northerly along said parallel line a distance of 705.18 feet to the intersection with a line which bears South 71 degrees 00 minutes 13 seconds E from the point of beginning; thence North 71 degrees 00 minutes 13 seconds West a distance of 60.01 feet to the point of beginning.

Fully and accurately depicts all information described by Minnesota Statutes, Section 515B.2-110.

Dated this 24th day of July, 1997

Jeffrey N. Caine
Jeffrey N. Caine, Land Surveyor
Minnesota License No. 12251

STATE OF MINNESOTA
COUNTY OF Anoka

The foregoing instrument was acknowledged before me this 24th day of July, 1997 by Jeffrey N. Caine, a Licensed Land Surveyor.

Bill McKent
Notary Public, Anoka County, Minnesota
My Commission Expires 01-31-00

Pursuant to Minnesota Statutes, Chapter 389.09, Subd. 2, this CIC Plat has been reviewed and is approved this 25th day of July, 1997

By: MERLYN D. ANDERSON
ANOKA County Surveyor

by Larry D. Anderson
deputy

1289137
OFFICE OF COUNTY RECORDER
STATE OF MINNESOTA, COUNTY OF ANOKA
I hereby certify that the within instrument was filed in this office for record on the 28th July A.D., 1997 at 3:40 o'clock P.M. and was duly recorded in book 3 page 14
Edward M. Treska
County Recorder
By CAB



I HEREBY CERTIFY THAT THE CURRENT AND DELINQUENT TAXES ON THE LANDS DESCRIBED WITHIN ARE PAID AND THE TRANSFER IS ENTERED
July 28 1997
EDWARD M. TRESKA
PROPERTY TAX ADMINISTRATOR
BY S. Culver
DEPUTY PROPERTY TAX ADMINISTRATOR

CIC NUMBER 27

MARSHAN LAKE CONDOMINIUMS, A COMMON INTEREST COMMUNITY

SECOND SUPPLEMENTAL CIC PLAT

SITE PLAN

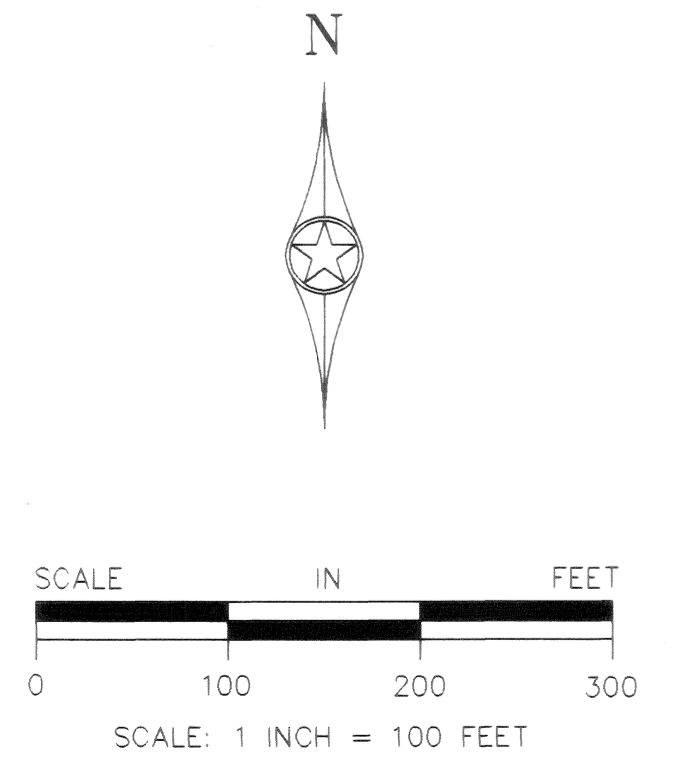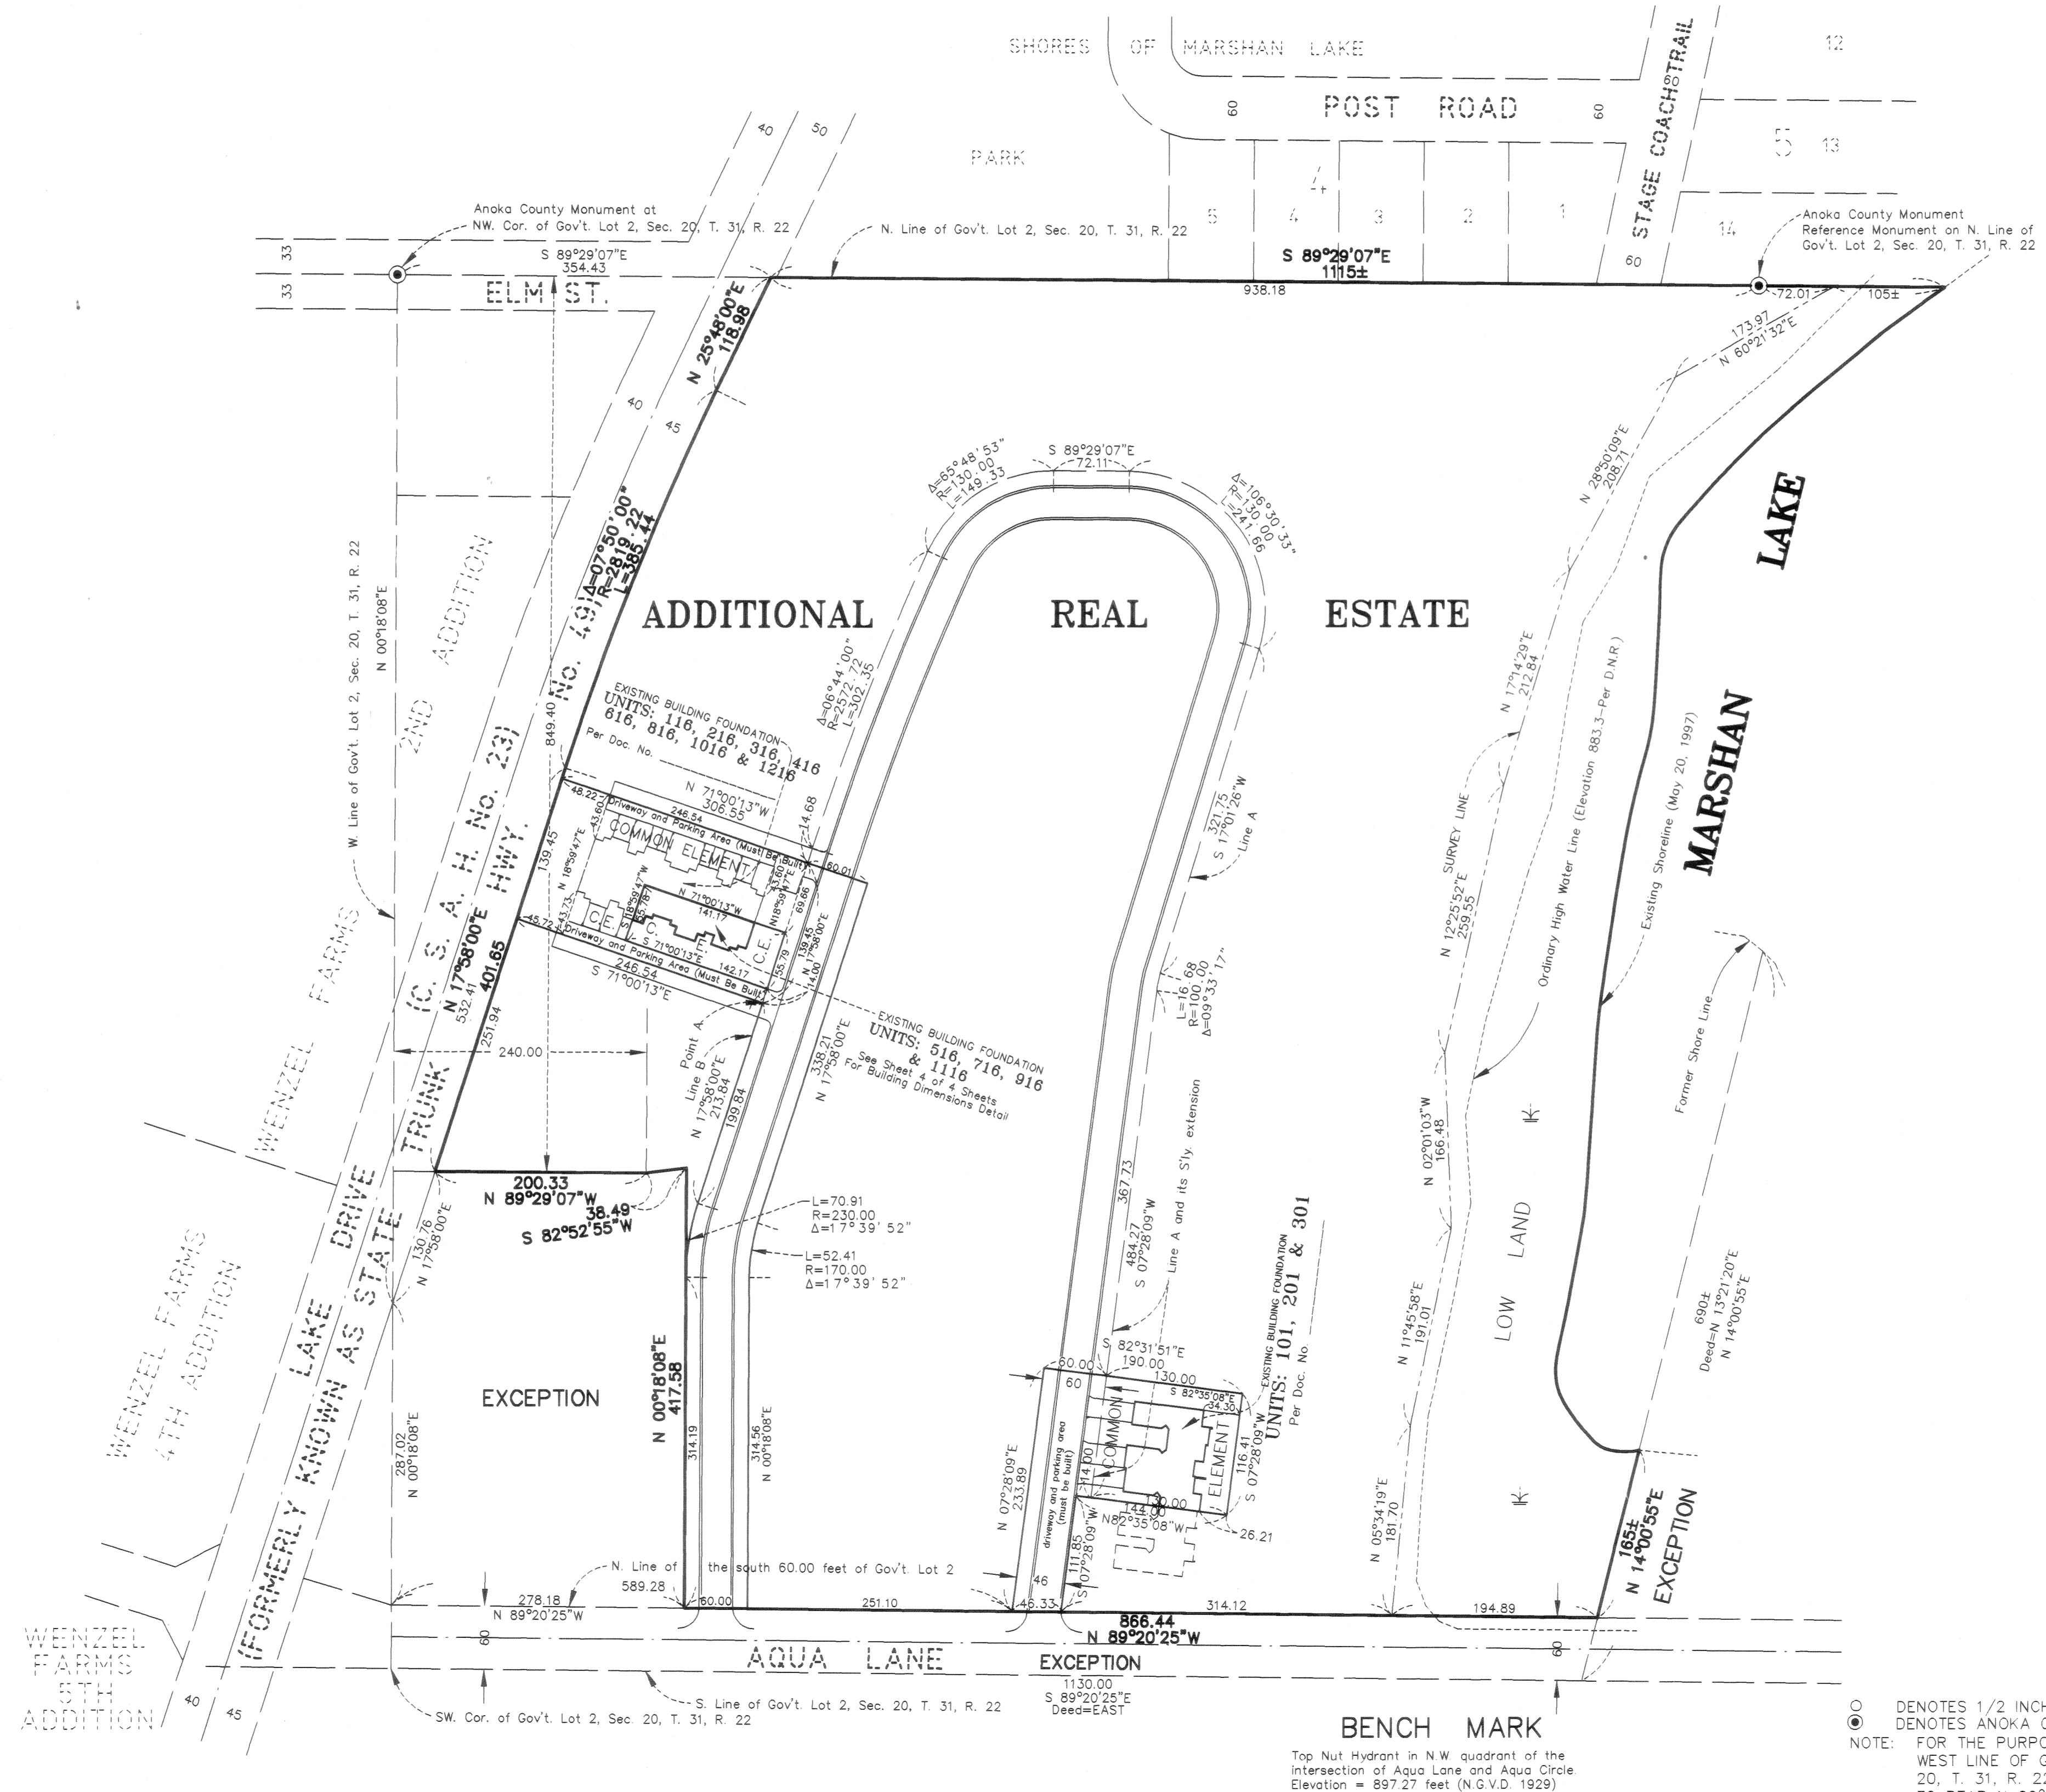

○ DENOTES 1/2 INCH IRON PIPE SET.
 ● DENOTES ANOKA COUNTY MONUMENT.
 NOTE: FOR THE PURPOSES OF THIS PLAT, THE WEST LINE OF GOV'T. LOT 2, SEC. 20, T. 31, R. 22 IS ASSUMED TO BEAR N 00°18'08"E.


CAINE & ASSOCIATES
LAND SURVEYORS, INC.

CIC NUMBER 27


MARSHAN LAKE CONDOMINIUMS, A COMMON INTEREST COMMUNITY

SECOND SUPPLEMENTAL CIC PLAT

AS - BUILT

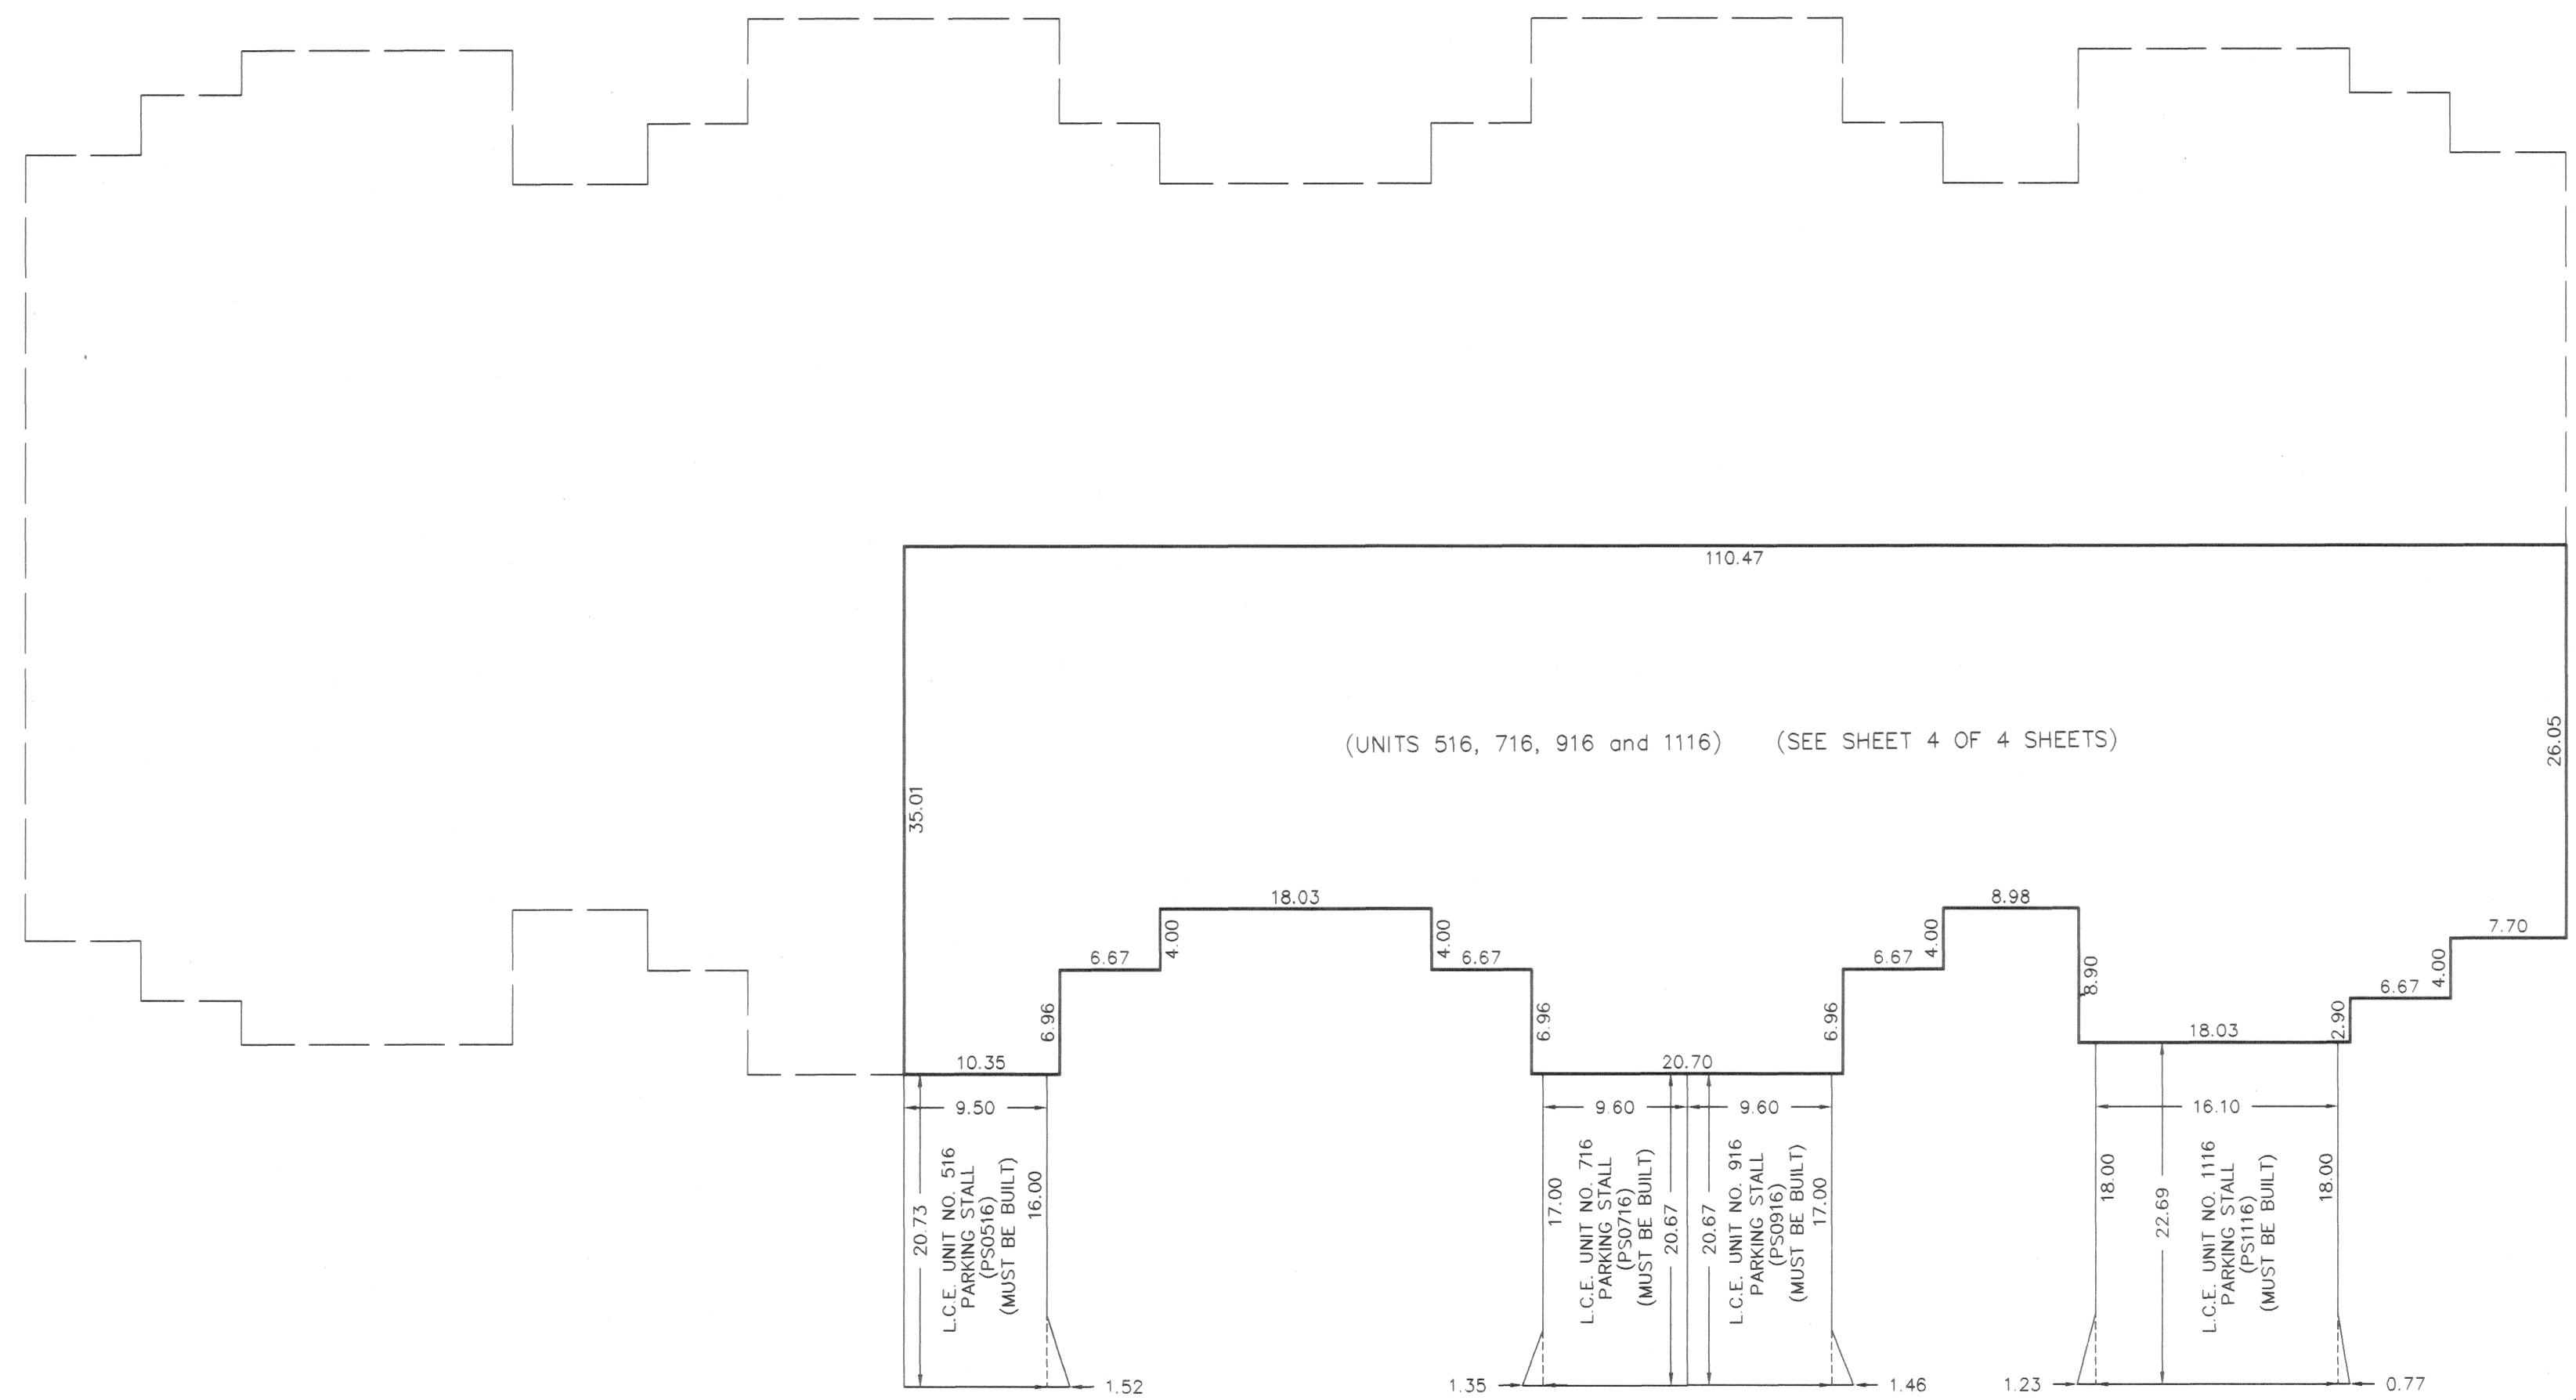

C O M M O N T E M P L A T E

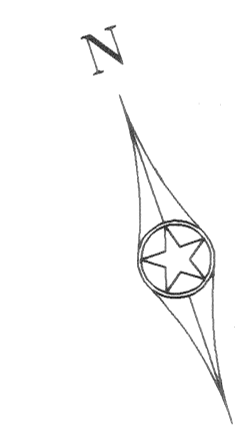




CAINE & ASSOCIATES
LAND SURVEYORS, INC.

CIC NUMBER 27

MARSHAN LAKE CONDOMINIUMS, A COMMON INTEREST COMMUNITY

SECOND SUPPLEMENTAL CIC PLAT

FLOOR PLAN

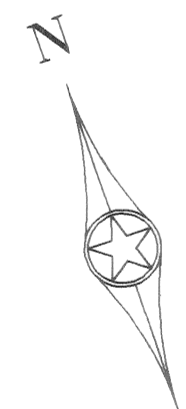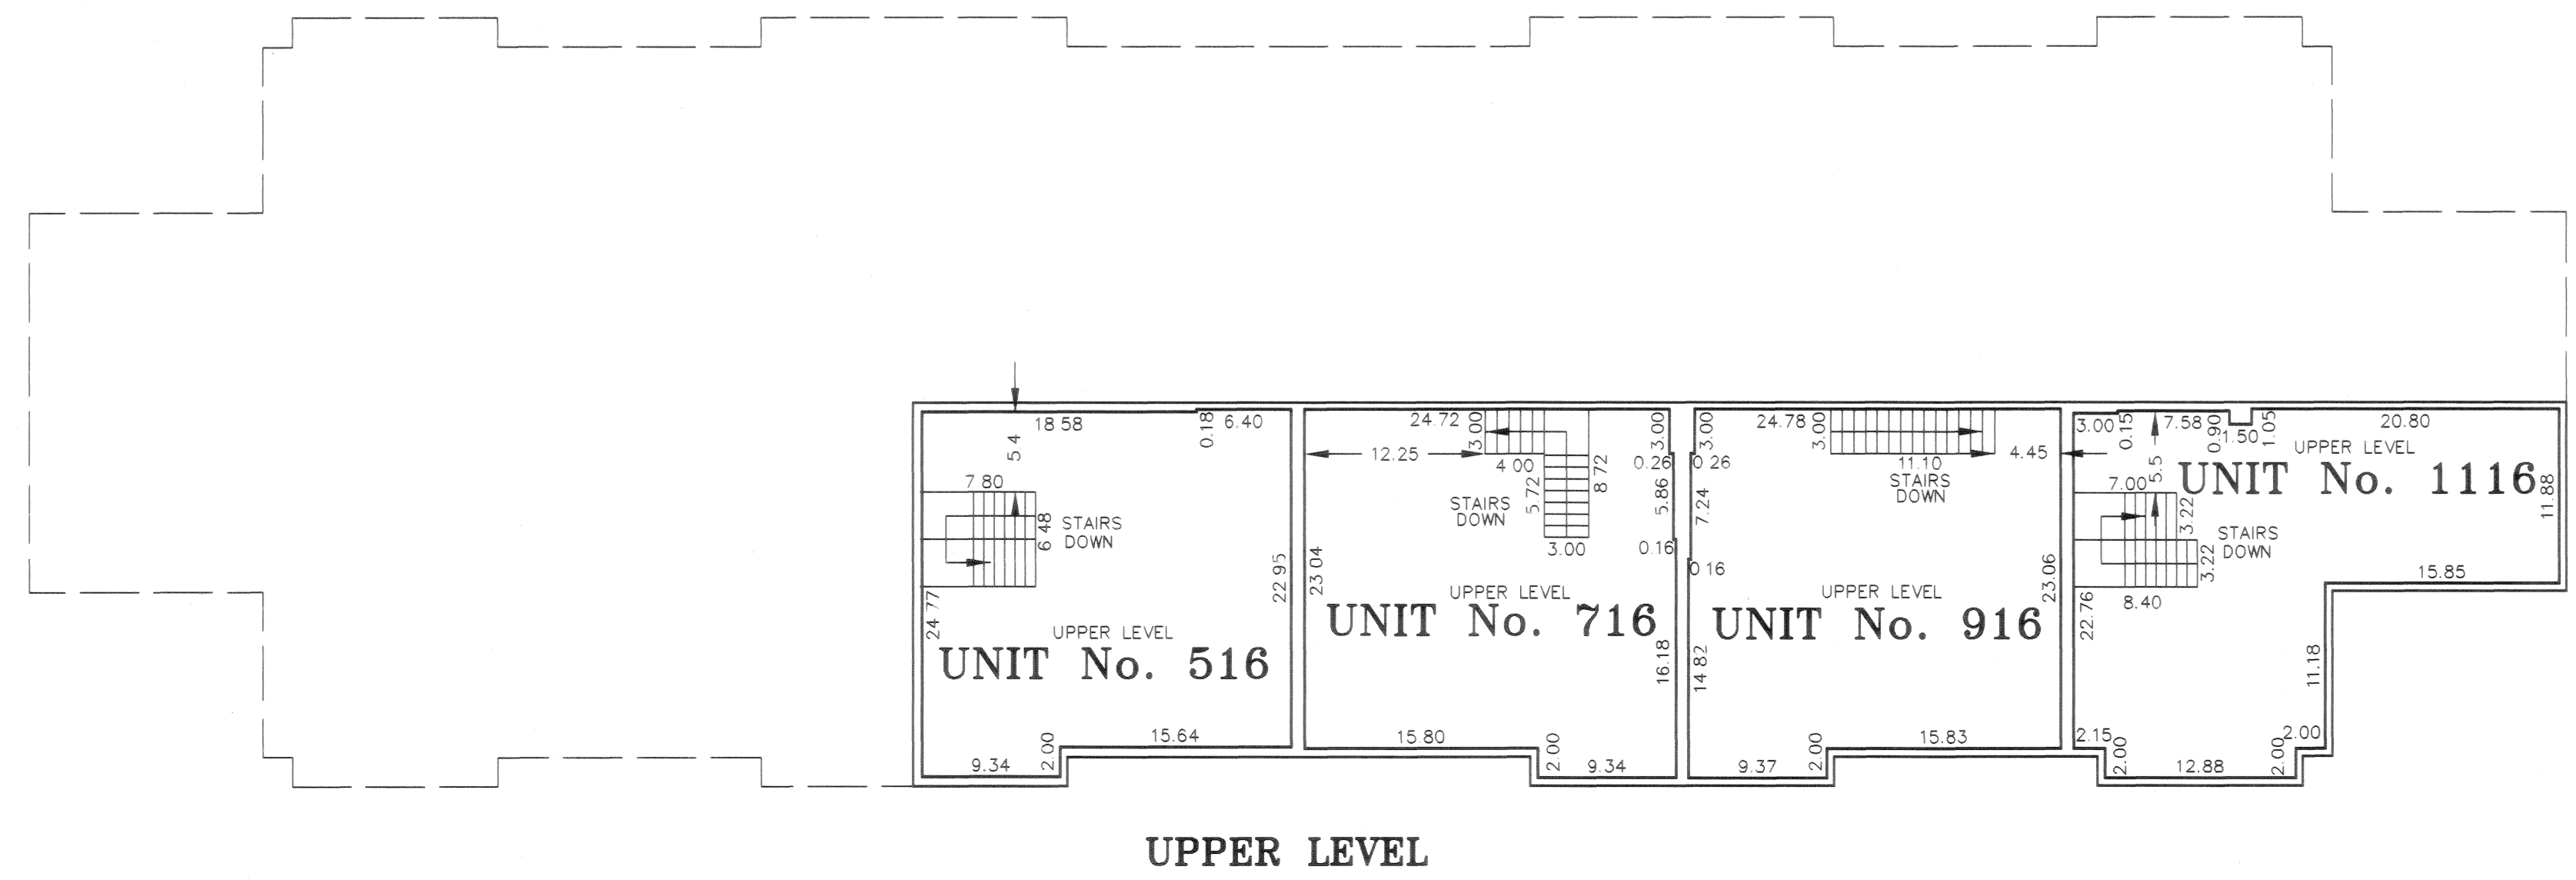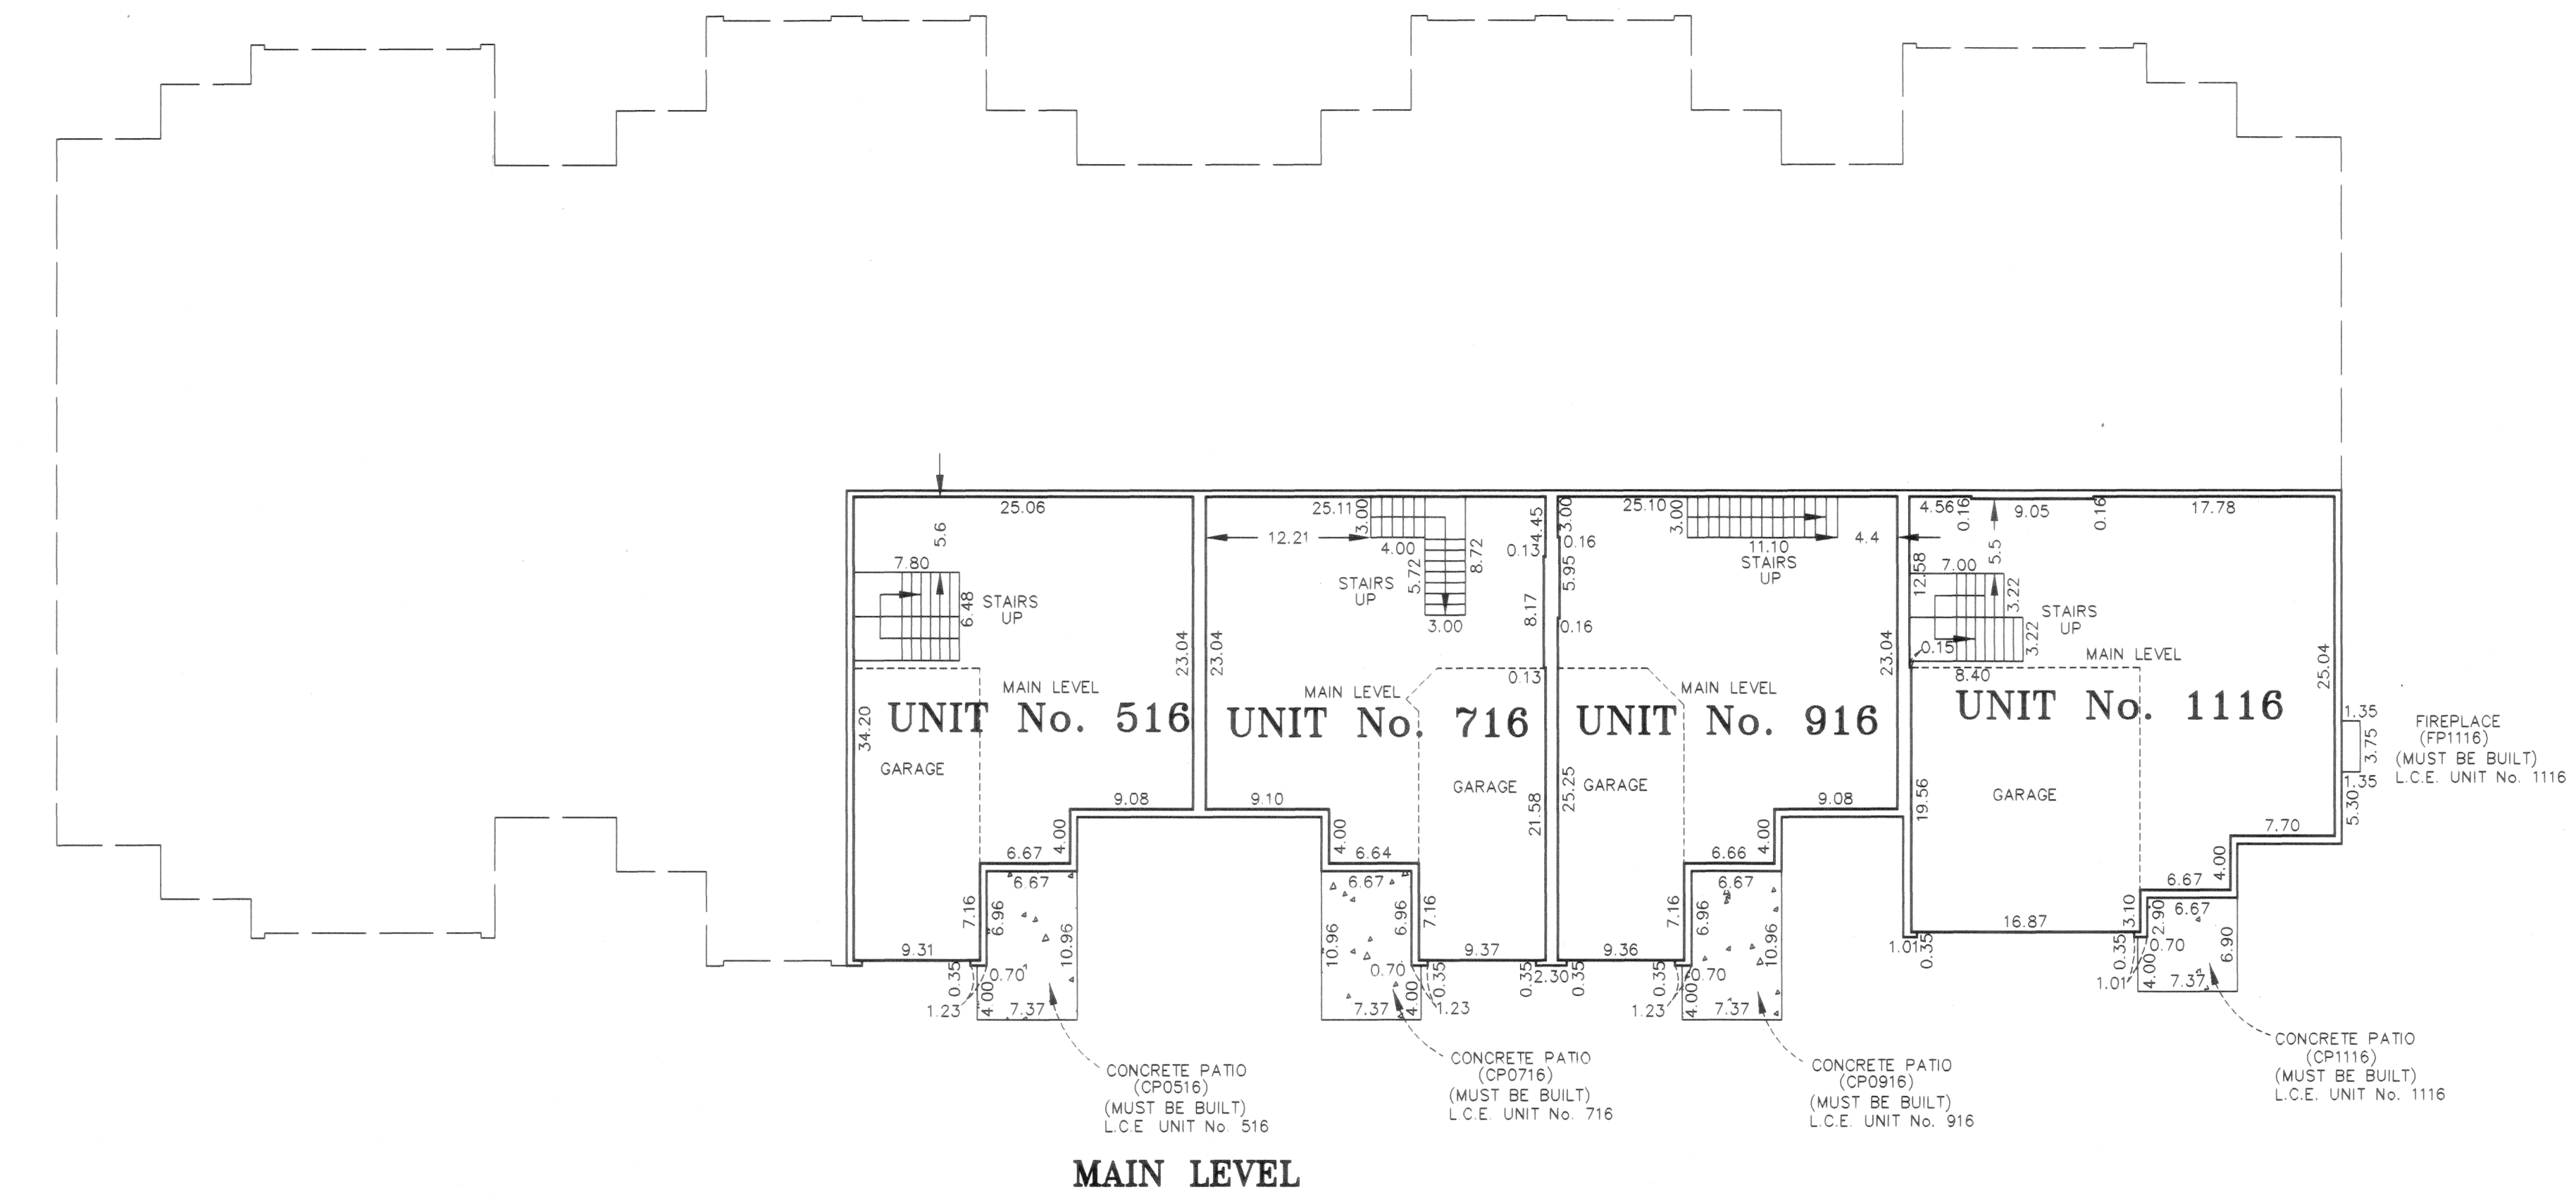


All main level floor elevations = 901.33 feet.
 All main level ceiling elevations vary from 909.38 feet to 917.67 feet.
 All upper level floor elevations = 910.48 feet.
 All upper level ceiling elevations = 918.54 feet.
 All garage floor elevations = 900.97 feet.

Interior dimensions shown are measured to the unfinished surface of the walls, floors and ceilings.

L.C.E. Denotes Limited Common Element

Elevations are referred to Benchmark as noted on site plan and are shown in feet and hundredths of a foot.

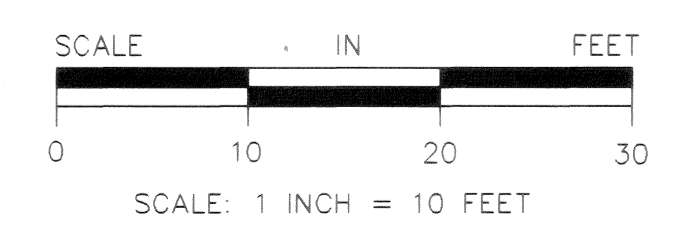

CAINE & ASSOCIATES
LAND SURVEYORS, INC.