

CONDOMINIUM NUMBER 13 WILLOW COURT COACH HOMES, A CONDOMINIUM

FIRST SUPPLEMENT SITE PLAN

These first Supplemental Floor Plans are part of Declaration filed or recorded as Document No. 633976 on this 20th day of January 1984.

LOT SURVEYS COMPANY, INC. LAND SURVEYORS

The undersigned, being first duly sworn under oath, certifies and deposes that these first supplemental Floor Plans of Condominium Number 13, Willow Court Coach Homes, a Condominium, being located upon

Lot 3, Block 1, WILLOW COURT COACH HOMES, according to the plat thereof on file and of record in the office of the County Recorder in and for Anoka County, Minnesota.

and the Additional Real Estate described as follows:

Lot 2 Block 1, WILLOW COURT COACH HOMES, according to the plat thereof on file and of record in the office of the County Recorder in and for Anoka County, Minnesota. fully and accurately depicts all information required by Minnesota Statutes Section 515A. 2-110. Dated this 11th day of NOVEMBER 1983.

Raymond A. Prasch

Raymond A. Prasch, Registered Land Surveyor
Minnesota Registration No. 6743

State of Minnesota
County of Hennepin The foregoing instrument was acknowledged before me this 11th day of NOVEMBER 1983, by Raymond A. Prasch, a registered professional land surveyor.

Milton E. Hyland

Milton E. Hyland, Notary Public, Hennepin County, Minnesota
My Commission Expires November 19, 1987

CHARLES NOVAK a registered professional architect for the State of Minnesota pursuant to Minnesota Statutes Section 515A. 2-101 (b) and (c) does hereby certify that all structural components and mechanical systems serving more than one unit of all buildings containing or comprising any units hereby created are substantially completed consistent with the first supplemental Floor Plans for Condominium Number 13, Willow Court Coach Homes, a Condominium, and that all the units are entirely completed consistent with said Floor Plans. Dated this 22nd day of NOVEMBER 1983.

Charles Novak

CHARLES NOVAK, REGISTERED ARCHITECT
Minnesota Registration No. 8687

State of Minnesota
County of Anoka The foregoing instrument was acknowledged before me this 22nd day of November 1983, by CHARLES NOVAK a registered professional architect.

Joyce V. Zumberge

Notary Public, Anoka County, Minnesota
My Commission Expires 12-29-85

"NO DELINQUENT TAXES AND TRANSFER ENTERED"
Jan 20th 1984
Charles R. Thorne
Auditor, Anoka County
BY *J.R. Leminski*
Deputy

I HEREBY CERTIFY THAT THE TAXES PAYABLE IN THE YEAR 1984 ON THE LANDS DESCRIBED WITHIN ARE PAID
Donald C. Bailey by M. Dayden
Anoka County Treasurer

JOYCE V. ZUMBERGE
NOTARY PUBLIC - MINNESOTA
ANOKA COUNTY
My Commission Expires Dec. 29, 1985

633976

OFFICE OF COUNTY RECORDER
STATE OF MINNESOTA, COUNTY OF ANOKA

I hereby certify that the within instrument was filed in this office for record on the JAN 20, 1984 A.D., 19




at 11:30 o'clock A.M., and was duly recorded in book 105 page 30

Red Dahl
County Recorder
By *A. D. Swanson*
Deputy

Checked and approved this 11th day of January 1984.

Olaf W. Anderson
Anoka County Surveyor

ACRD 21665 JAN 20 84 15.00A

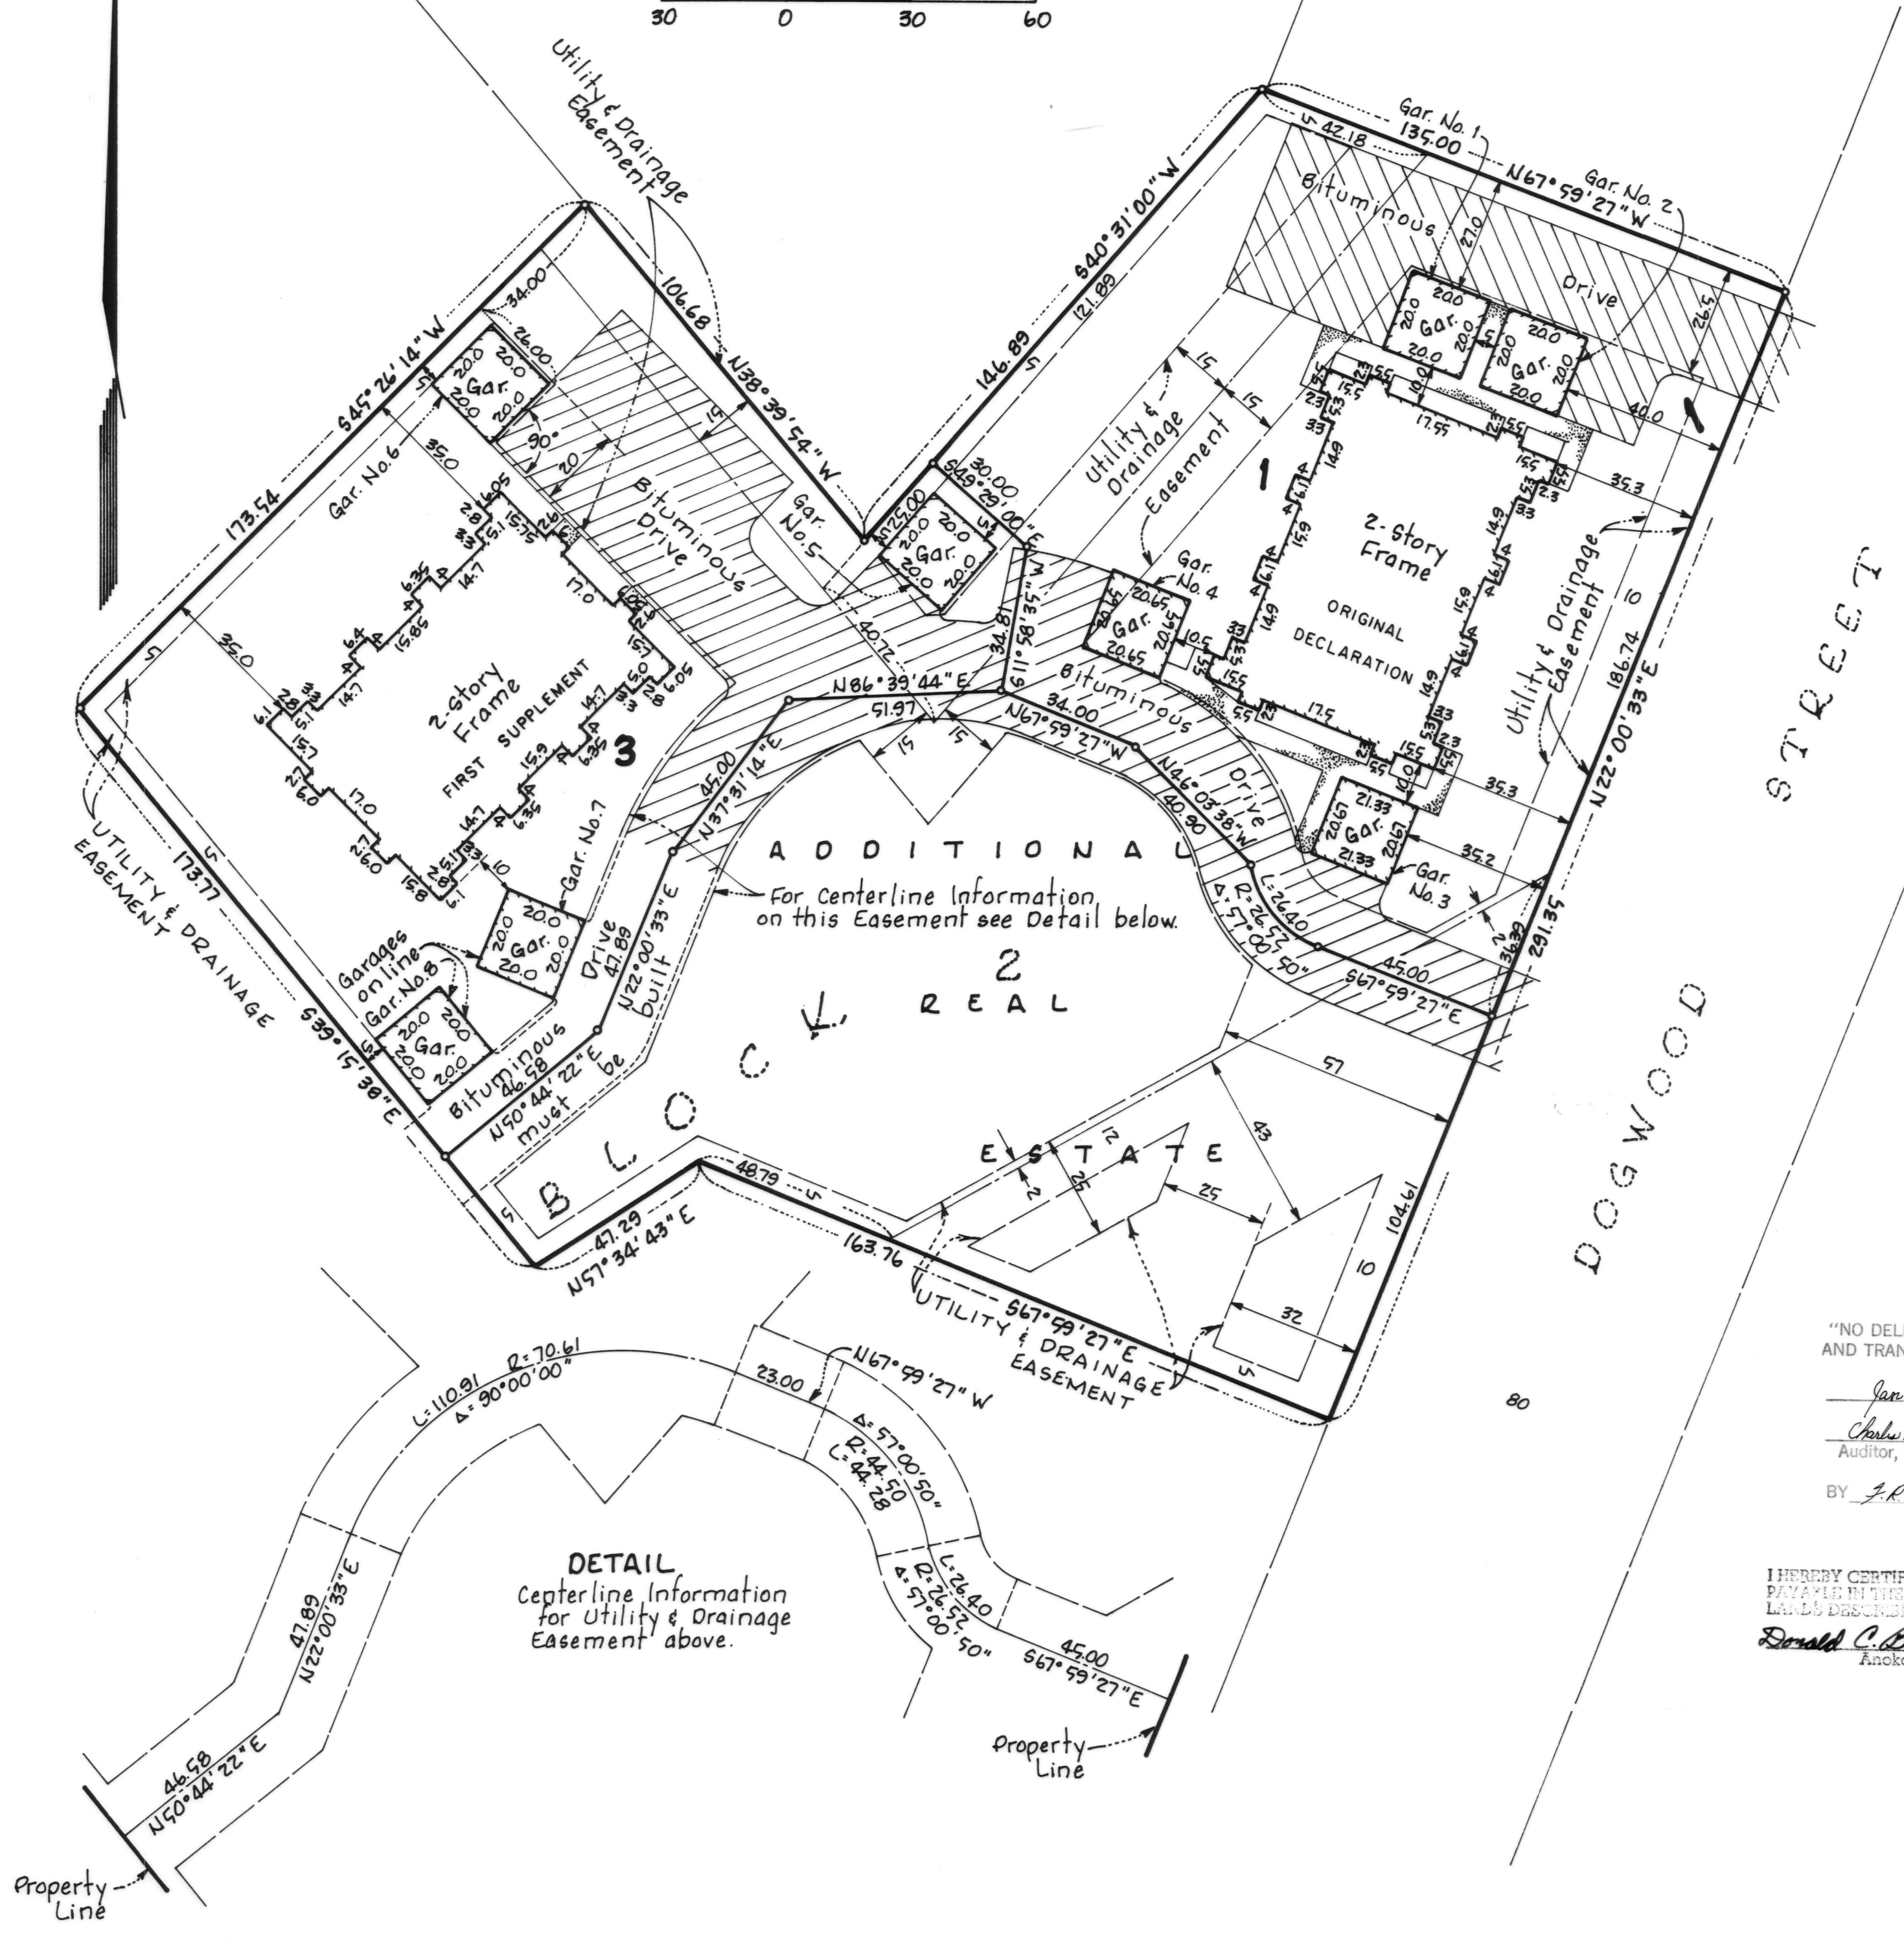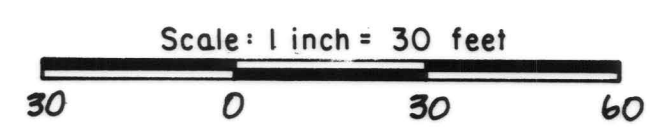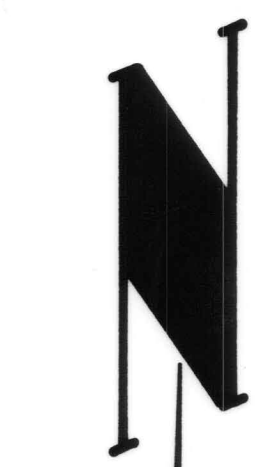


ADDITIONAL REAL ESTATE
For Centerline Information on this Easement see Detail below.

DETAIL
Centerline Information for Utility & Drainage Easement above.




CONDOMINIUM NUMBER 13 WILLOW COURT COACH HOMES, A CONDOMINIUM


BUILDING NO. 2

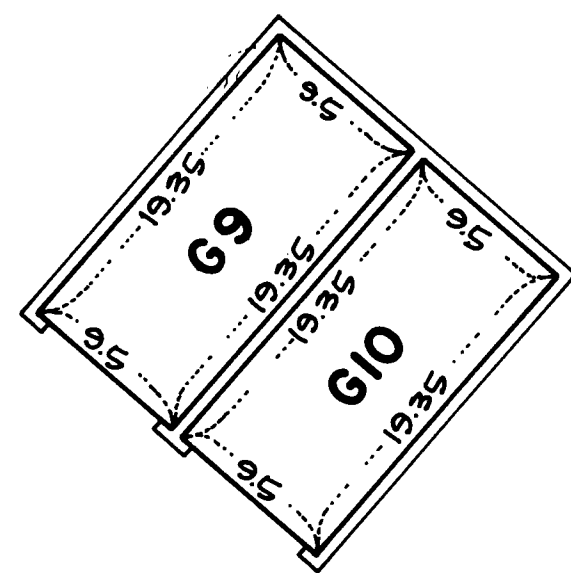


GARAGE NO. 5
GARAGE FLOOR ELEVATIONS:
Floor Level - 902.20 feet
(NGVD 29)

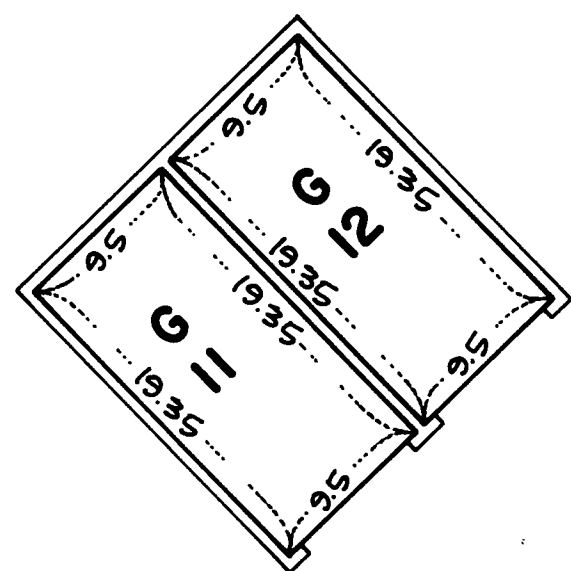



GARAGE NO. 6
GARAGE FLOOR ELEVATIONS:
Floor Level - 902.90 feet
(NGVD 29)

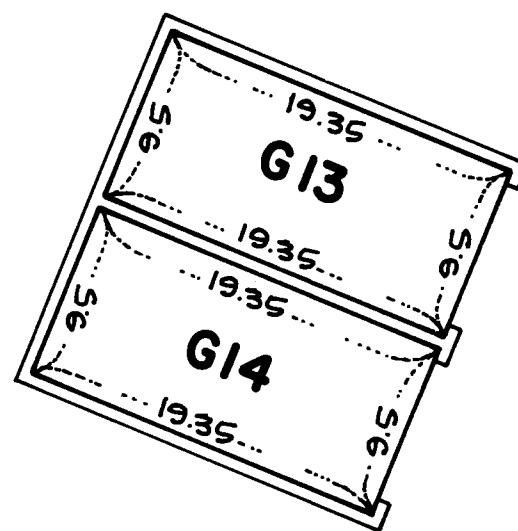



GARAGE NO. 7
GARAGE FLOOR ELEVATIONS:
Floor Level - 900.77 feet
(NGVD 29)

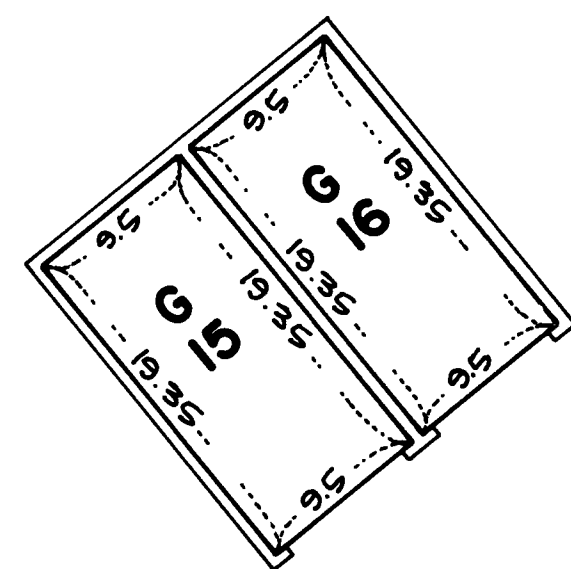

GARAGE NO. 8
GARAGE FLOOR ELEVATIONS:
Floor Level - 900.74 feet
(NGVD 29)

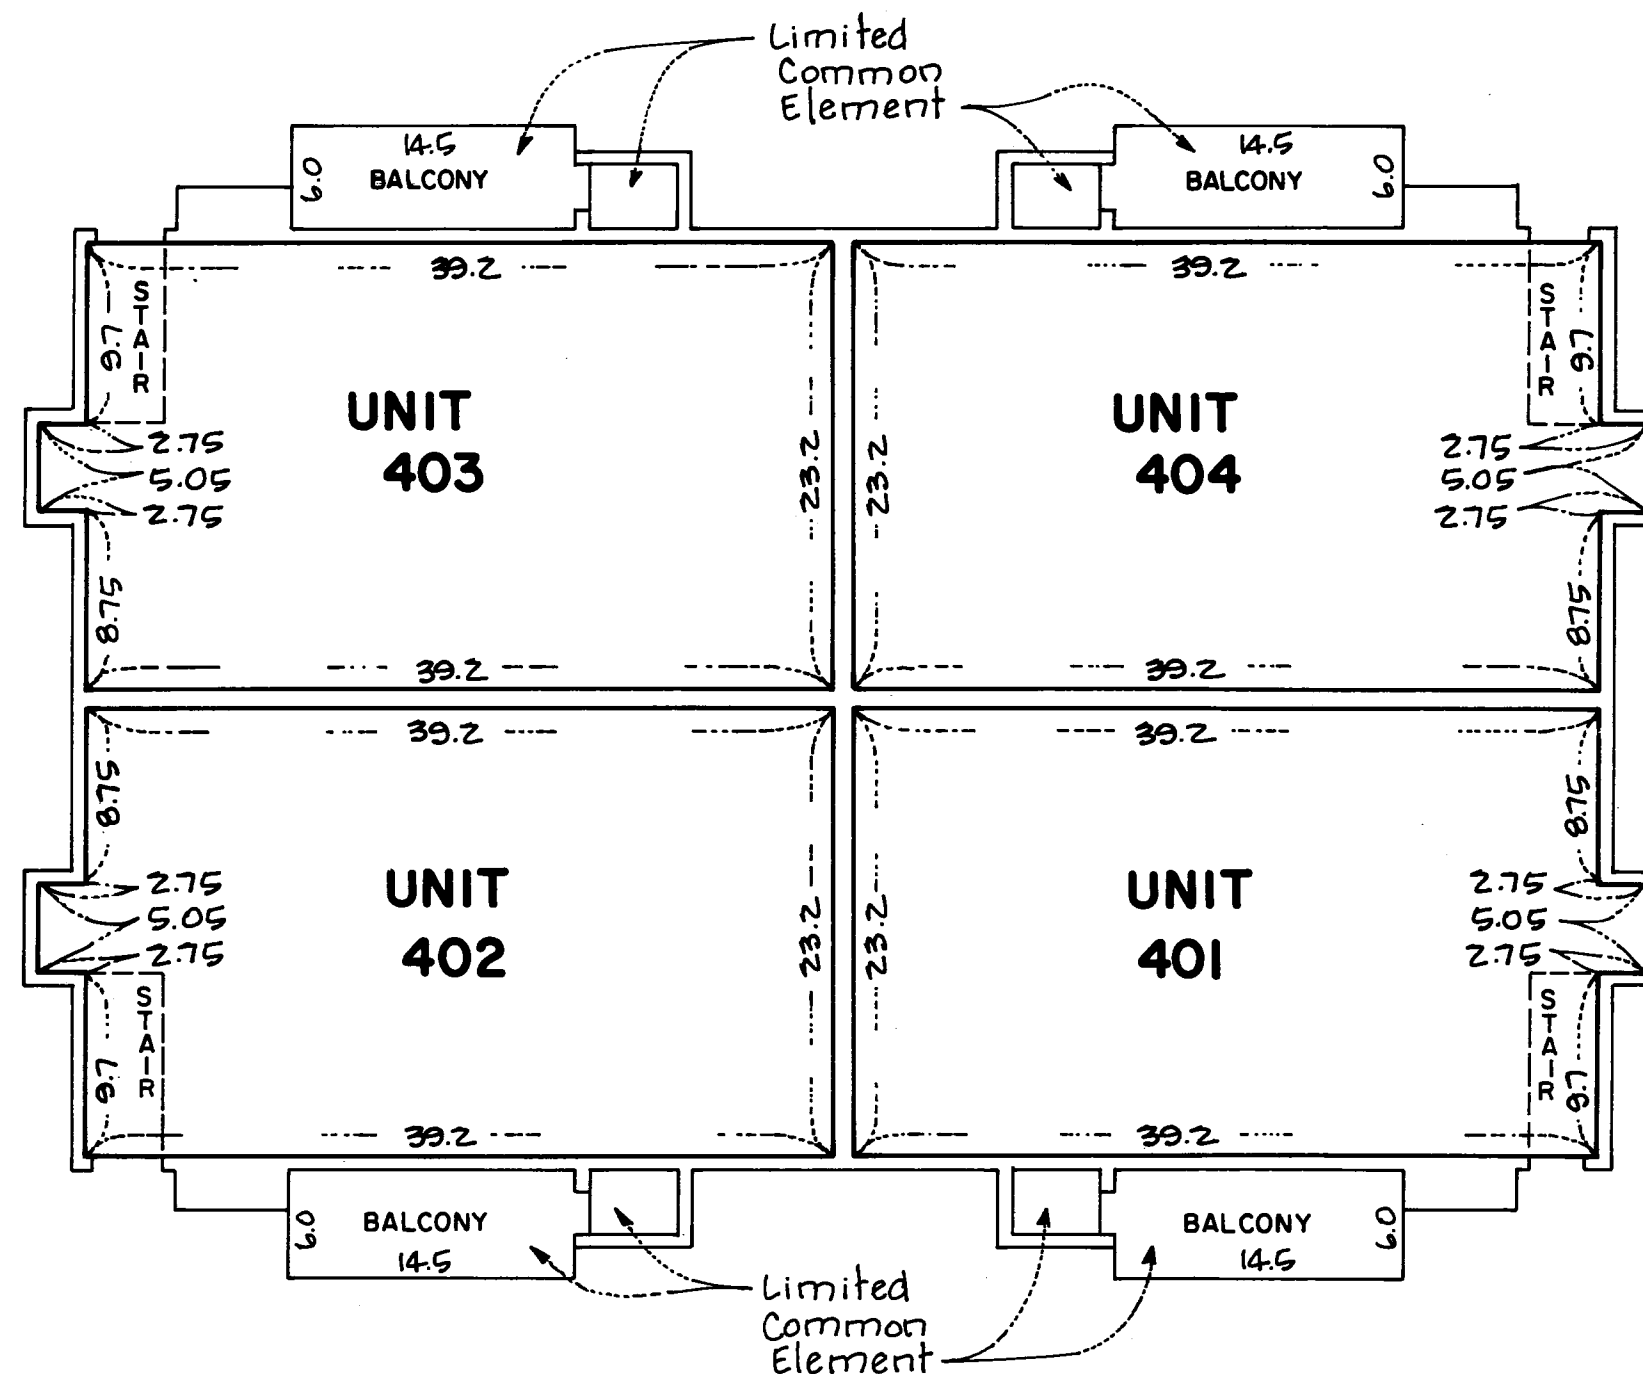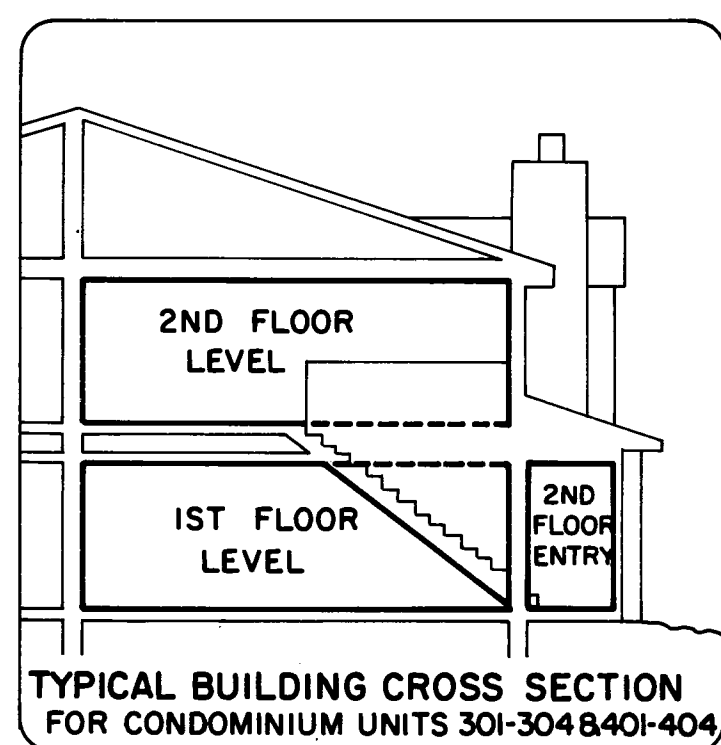

2ND FLOOR LEVEL
2ND FLOOR ELEVATIONS:
Ceiling Level - 920.53 feet
Floor Level - 912.44 feet
(NGVD 29)

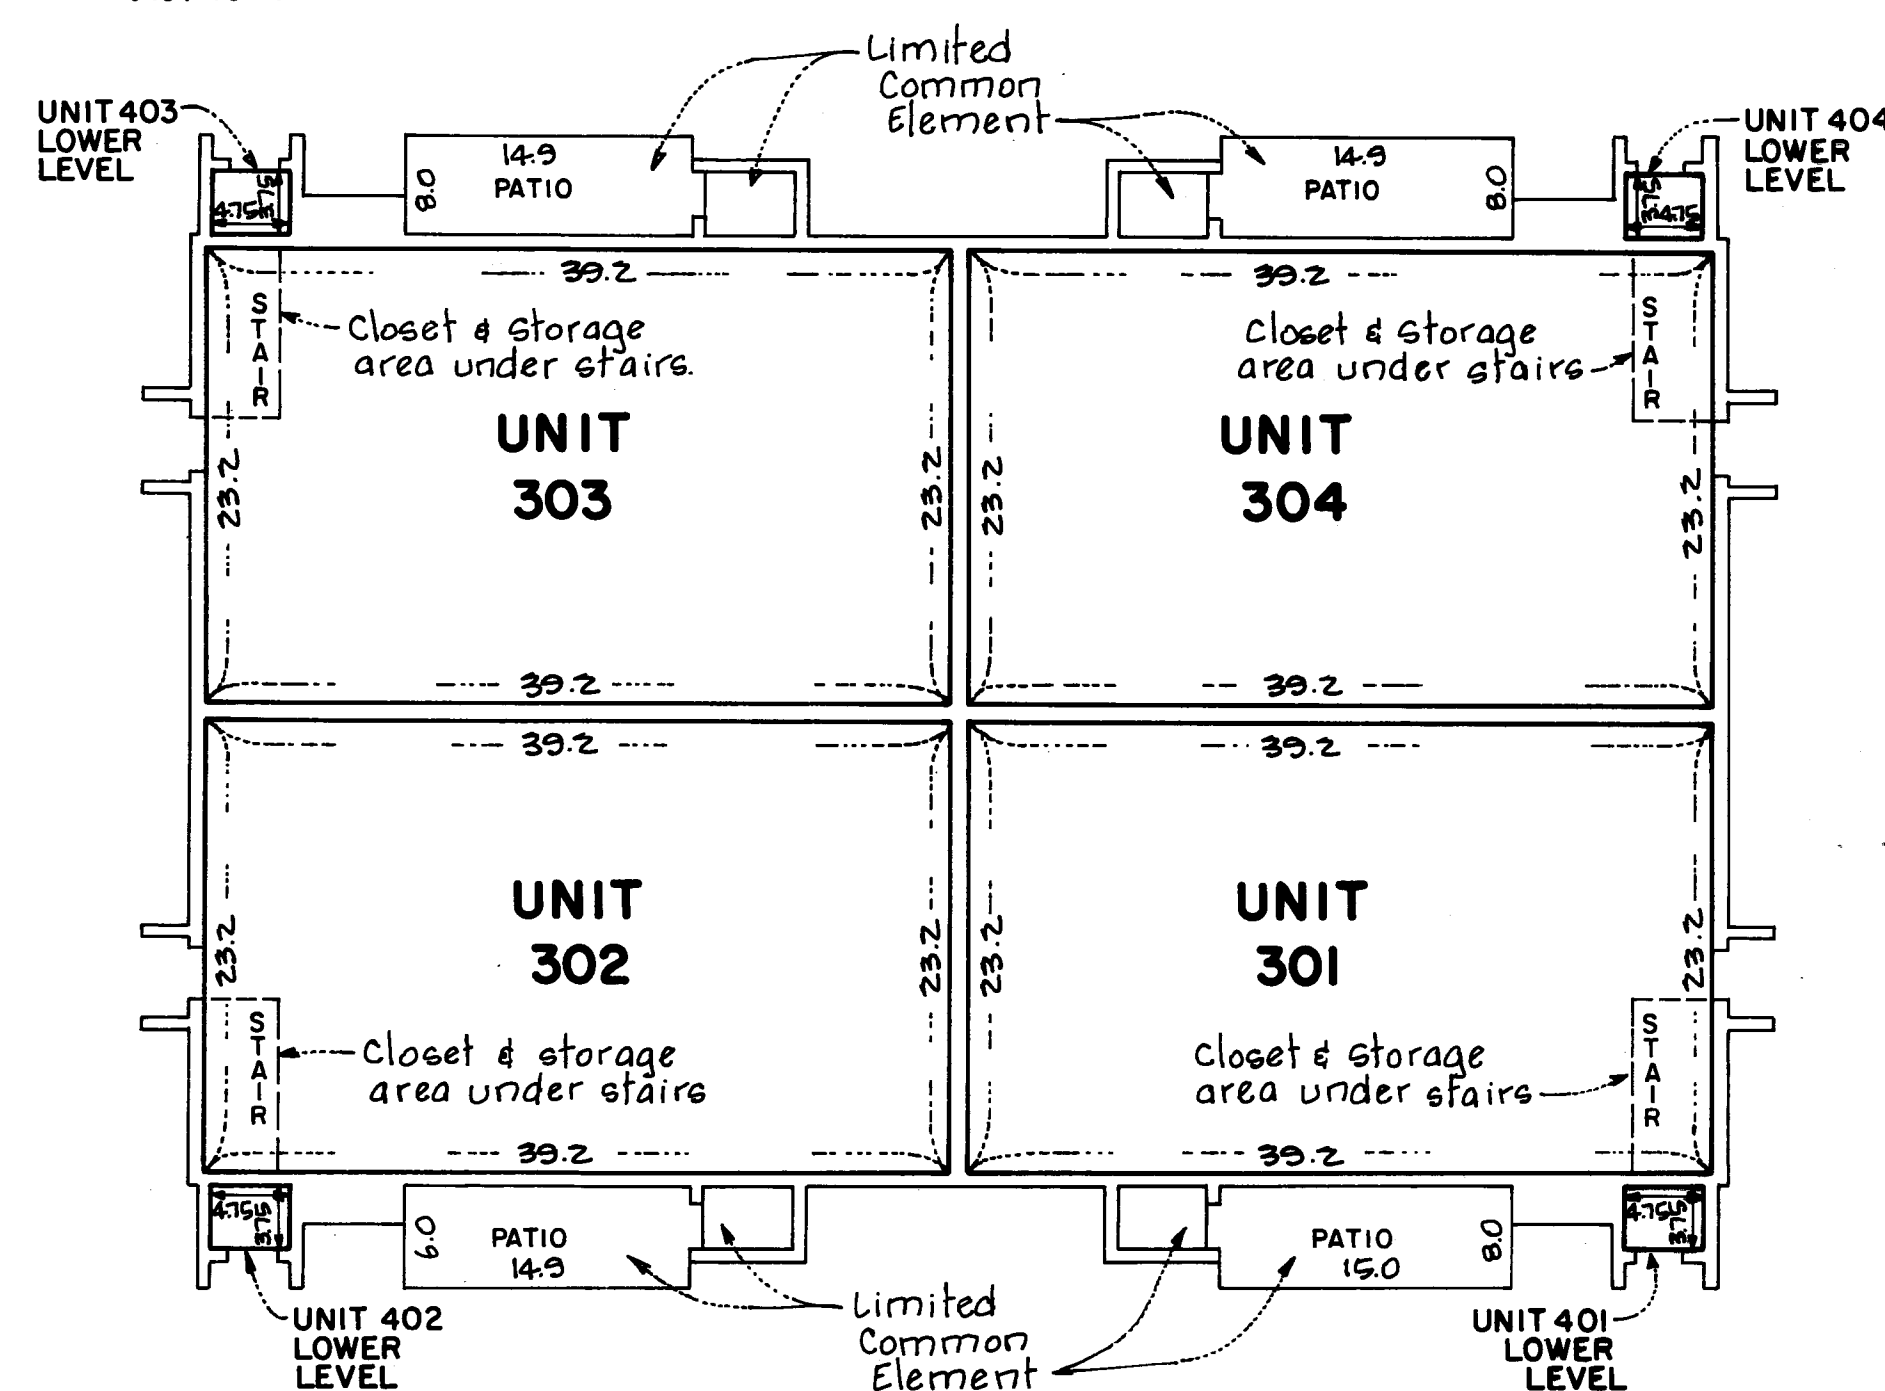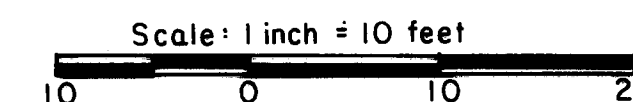

1ST FLOOR LEVEL
1ST FLOOR ELEVATIONS:
Ceiling Level - 911.01 feet
Floor Level - 902.84 feet
(NGVD 29)

LOT SURVEYS COMPANY, INC.
LAND SURVEYORS