


CONDOMINIUM NUMBER 37 CREEK MEADOWS CARRIAGE HOMES A CONDOMINIUM

These Fourth Supplemental Floor Plans are part of the Declaration filed or recorded as Document No. 150245 on this 16th day of April, 1986.

LOT SURVEYS COMPANY, INC.
LAND SURVEYORS

SITE PLAN

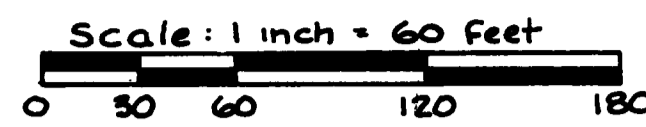


For the purpose of this plat the West Line of the SW 1/4, Section 14, T31, R24, is Assumed to bear N1° 22' 36" W.

o Denotes Iron Monument

FOURTH SUPPLEMENTAL FLOOR PLANS

Utility & Drainage Easements are shown thus:

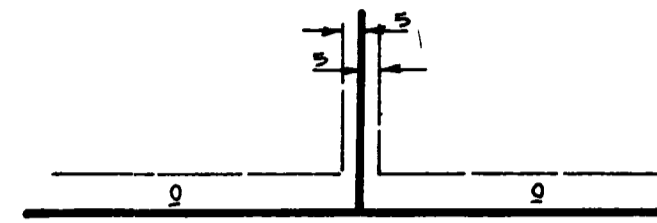


Being 5 feet in width and adjoining lot lines, unless otherwise indicated, and 10 feet in width and adjoining right-of-way lines, as shown on the plat.

The undersigned, being first duly sworn under oath, certifies and deposes that these Fourth Supplemental Floor Plans of Condominium No. 37, CREEK MEADOWS CARRIAGE HOMES, A CONDOMINIUM, being located upon

Lot 2, Block 1, CREEK MEADOWS
and the Additional Real Estate described as follows:

Lots 1, 3, 4, and 5, Block 1, CREEK MEADOWS

fully and accurately depicts all information required by Minnesota Statutes Section 515A. 2-110. Dated this 28th day of March, 1986.

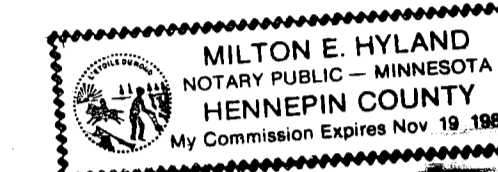

Raymond A. Prasch
Raymond A. Prasch, Registered Land Surveyor
Minnesota Registration No. 6743

State of Minnesota
County of Hennepin The foregoing instrument was acknowledged before me this 28th day of March, 1986, by Raymond A. Prasch, a registered professional land surveyor.

Milton E. Hyland
Milton E. Hyland, Notary Public, Hennepin County, Minnesota
My Commission Expires November 19, 1987

NORMAN WELLS, a registered professional ARCHITECT for the State of Minnesota pursuant to Minnesota Statutes Section 515A. 2-101 (b) and (c) does hereby certify that all structural components and mechanical systems serving more than one unit of all buildings containing or comprising any units hereby created are substantially completed consistent with the Fourth Supplemental Floor Plans for Condominium No. 37 CREEK MEADOWS CARRIAGE HOMES, A CONDOMINIUM, and that all the units are entirely completed consistent with said Floor Plans. Dated this 28th day of MARCH, 1986.

Norman Wells
Minnesota Registration No. 11782

State of Minnesota
County of HENNEPIN The foregoing instrument was acknowledged before me this 28th day of MARCH, 1986, by NORMAN WELLS, a registered professional ARCHITECT



Milton E. Hyland
Notary Public, HENNEPIN County, Minnesota
My Commission Expires Nov. 19, 1987

Checked and approved this 2nd day of April, 1986.

Robert M. Anderson
Anoka County Surveyor

Benchmark:
Top of Hydrant 11.95 feet South of
SE Corner Lot 6, Block 1, Creek Meadows
Elevation - 862.60 feet N.G.V.D. 1929


"NO DELINQUENT TAXES
AND TRANSFER ENTERED"

April 16 1986

Charles P. Johnson
Auditor, Anoka County

By Joell M. Sawyer
Deputy

150245
Office of REGISTRAR OF TITLES
STATE OF MINNESOTA
COUNTY OF ANOKA
I hereby certify that the within instrument was filed in this office on the 16 day of APR 1986 A.D. 1986 at 3:30 o'clock P.M.
Joell M. Sawyer Registrar of Titles
By Arthur Bein DEPUTY REGISTRAR OF TITLES



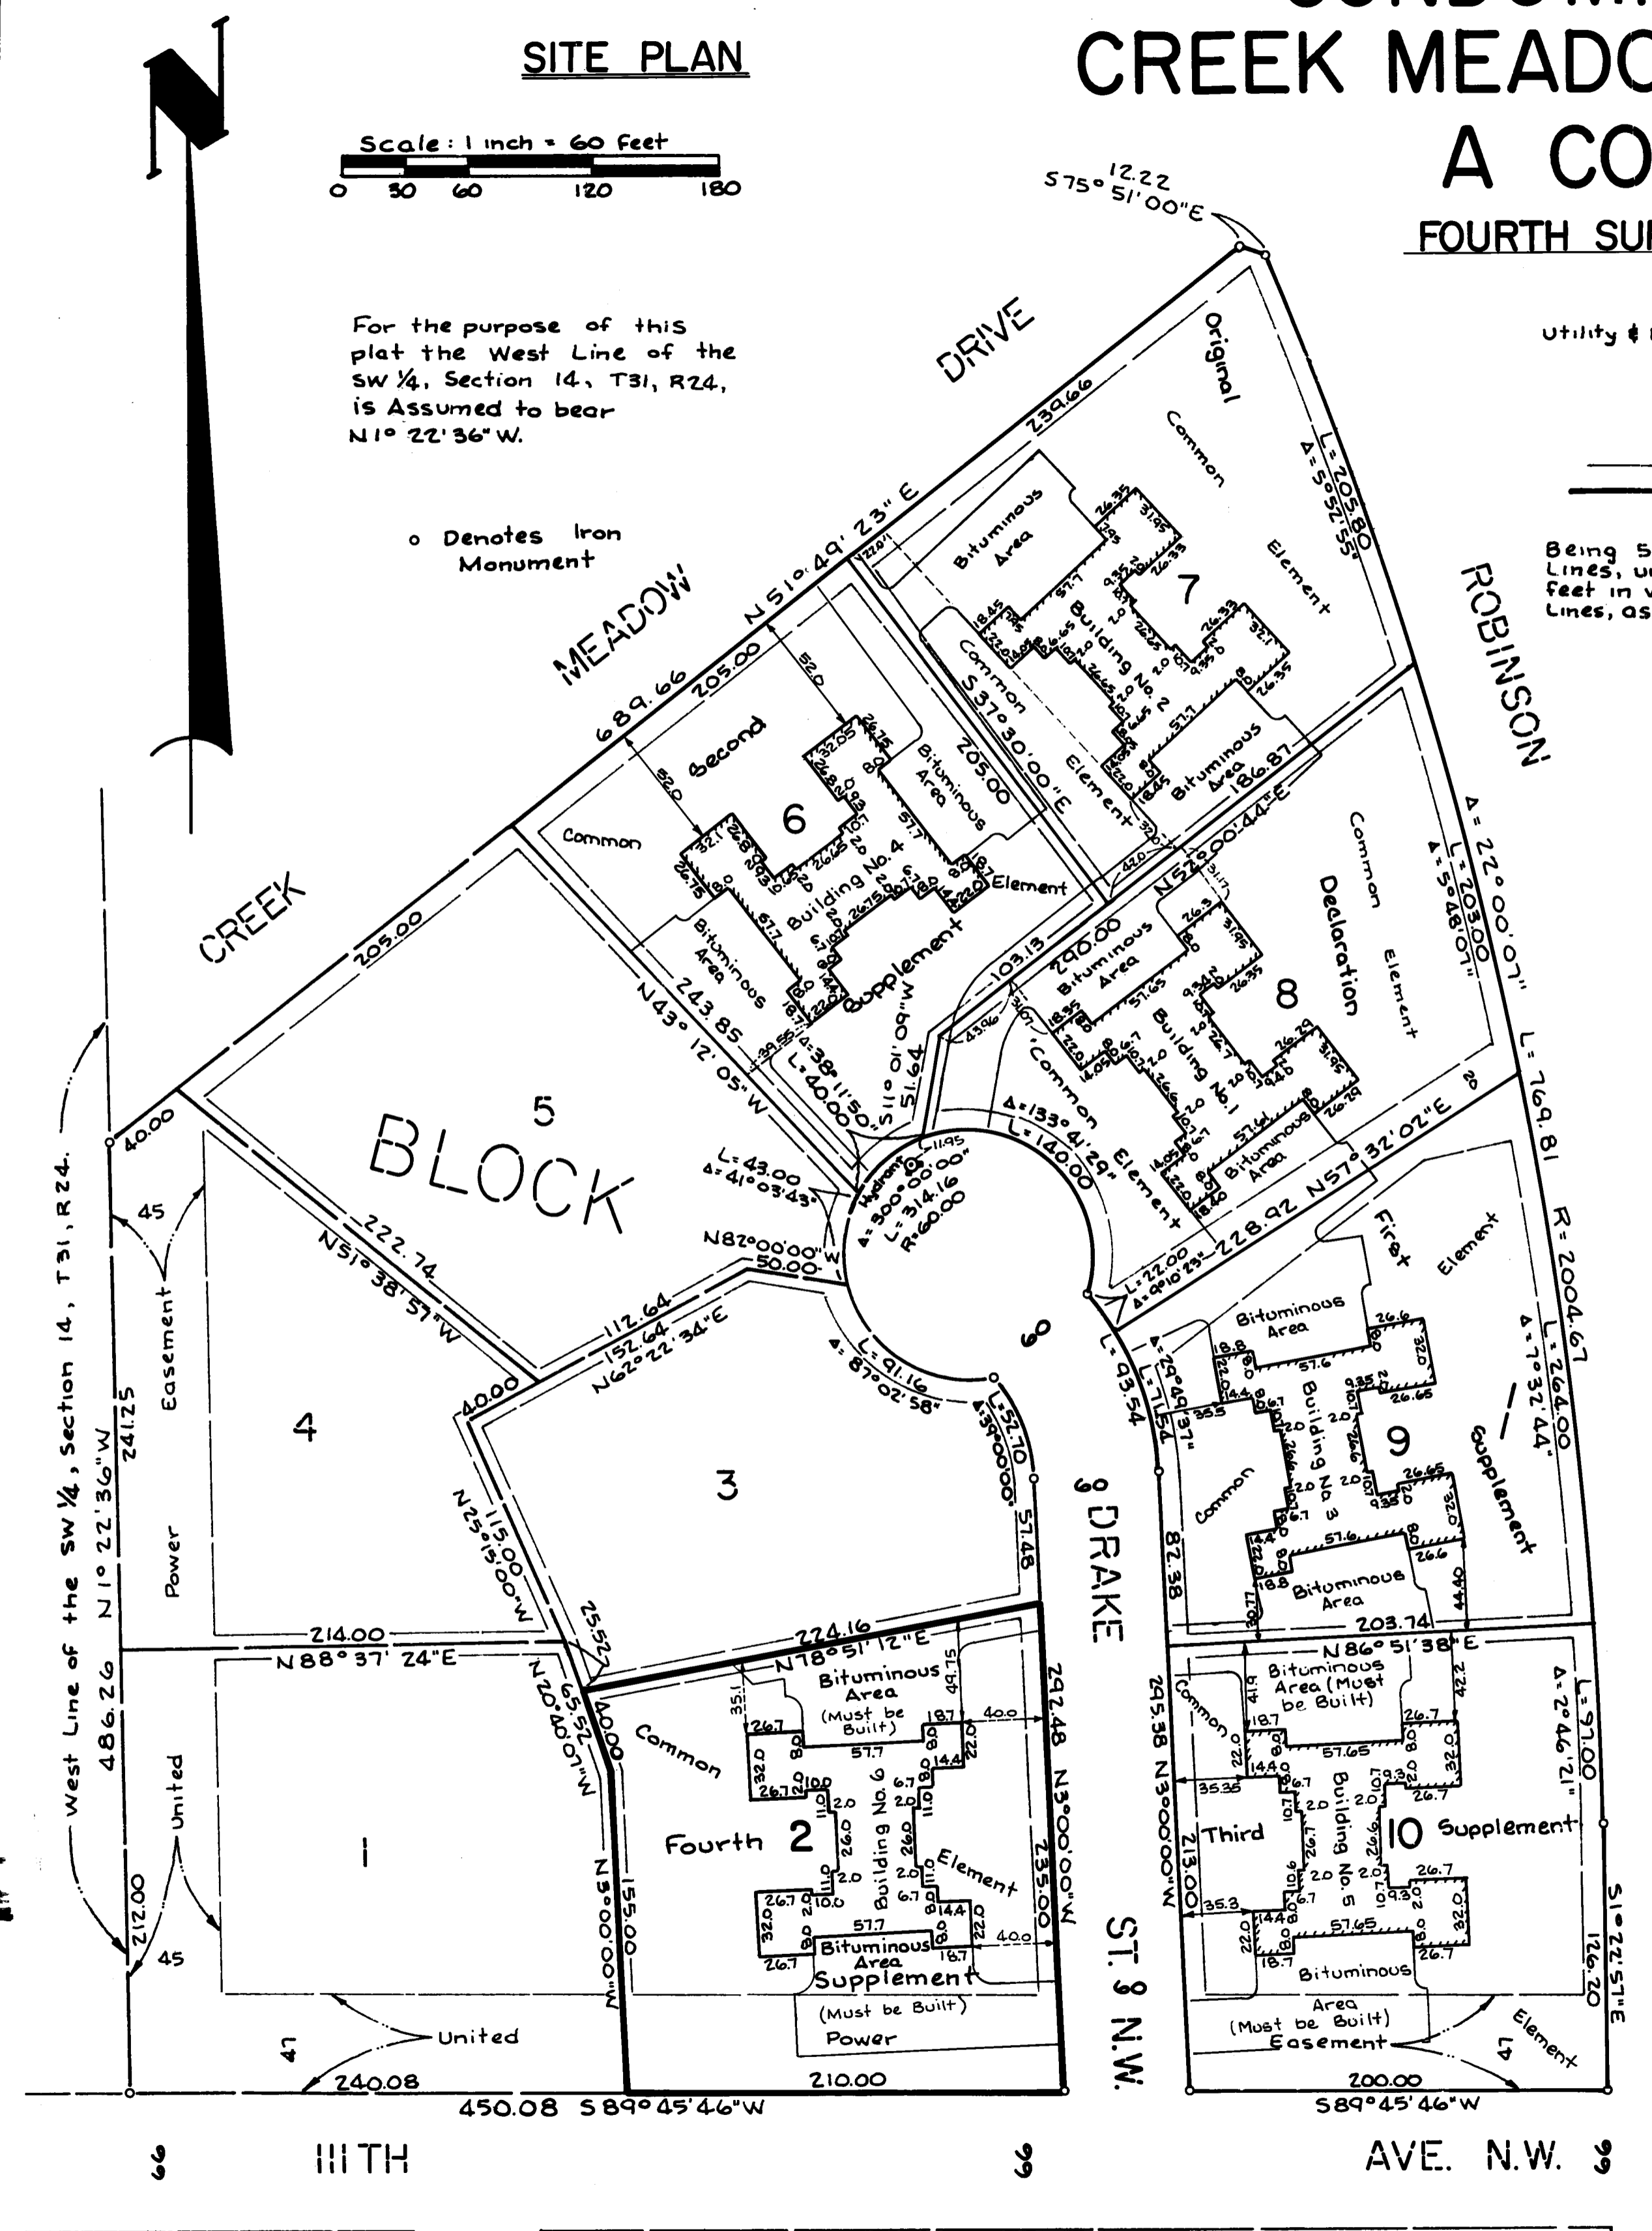


CONDOMINIUM NUMBER 37 CREEK MEADOWS CARRIAGE HOMES A CONDOMINIUM

FOURTH SUPPLEMENTAL FLOOR PLANS

LOT SURVEYS COMPANY, INC.
LAND SURVEYORS

BUILDING NO. 6

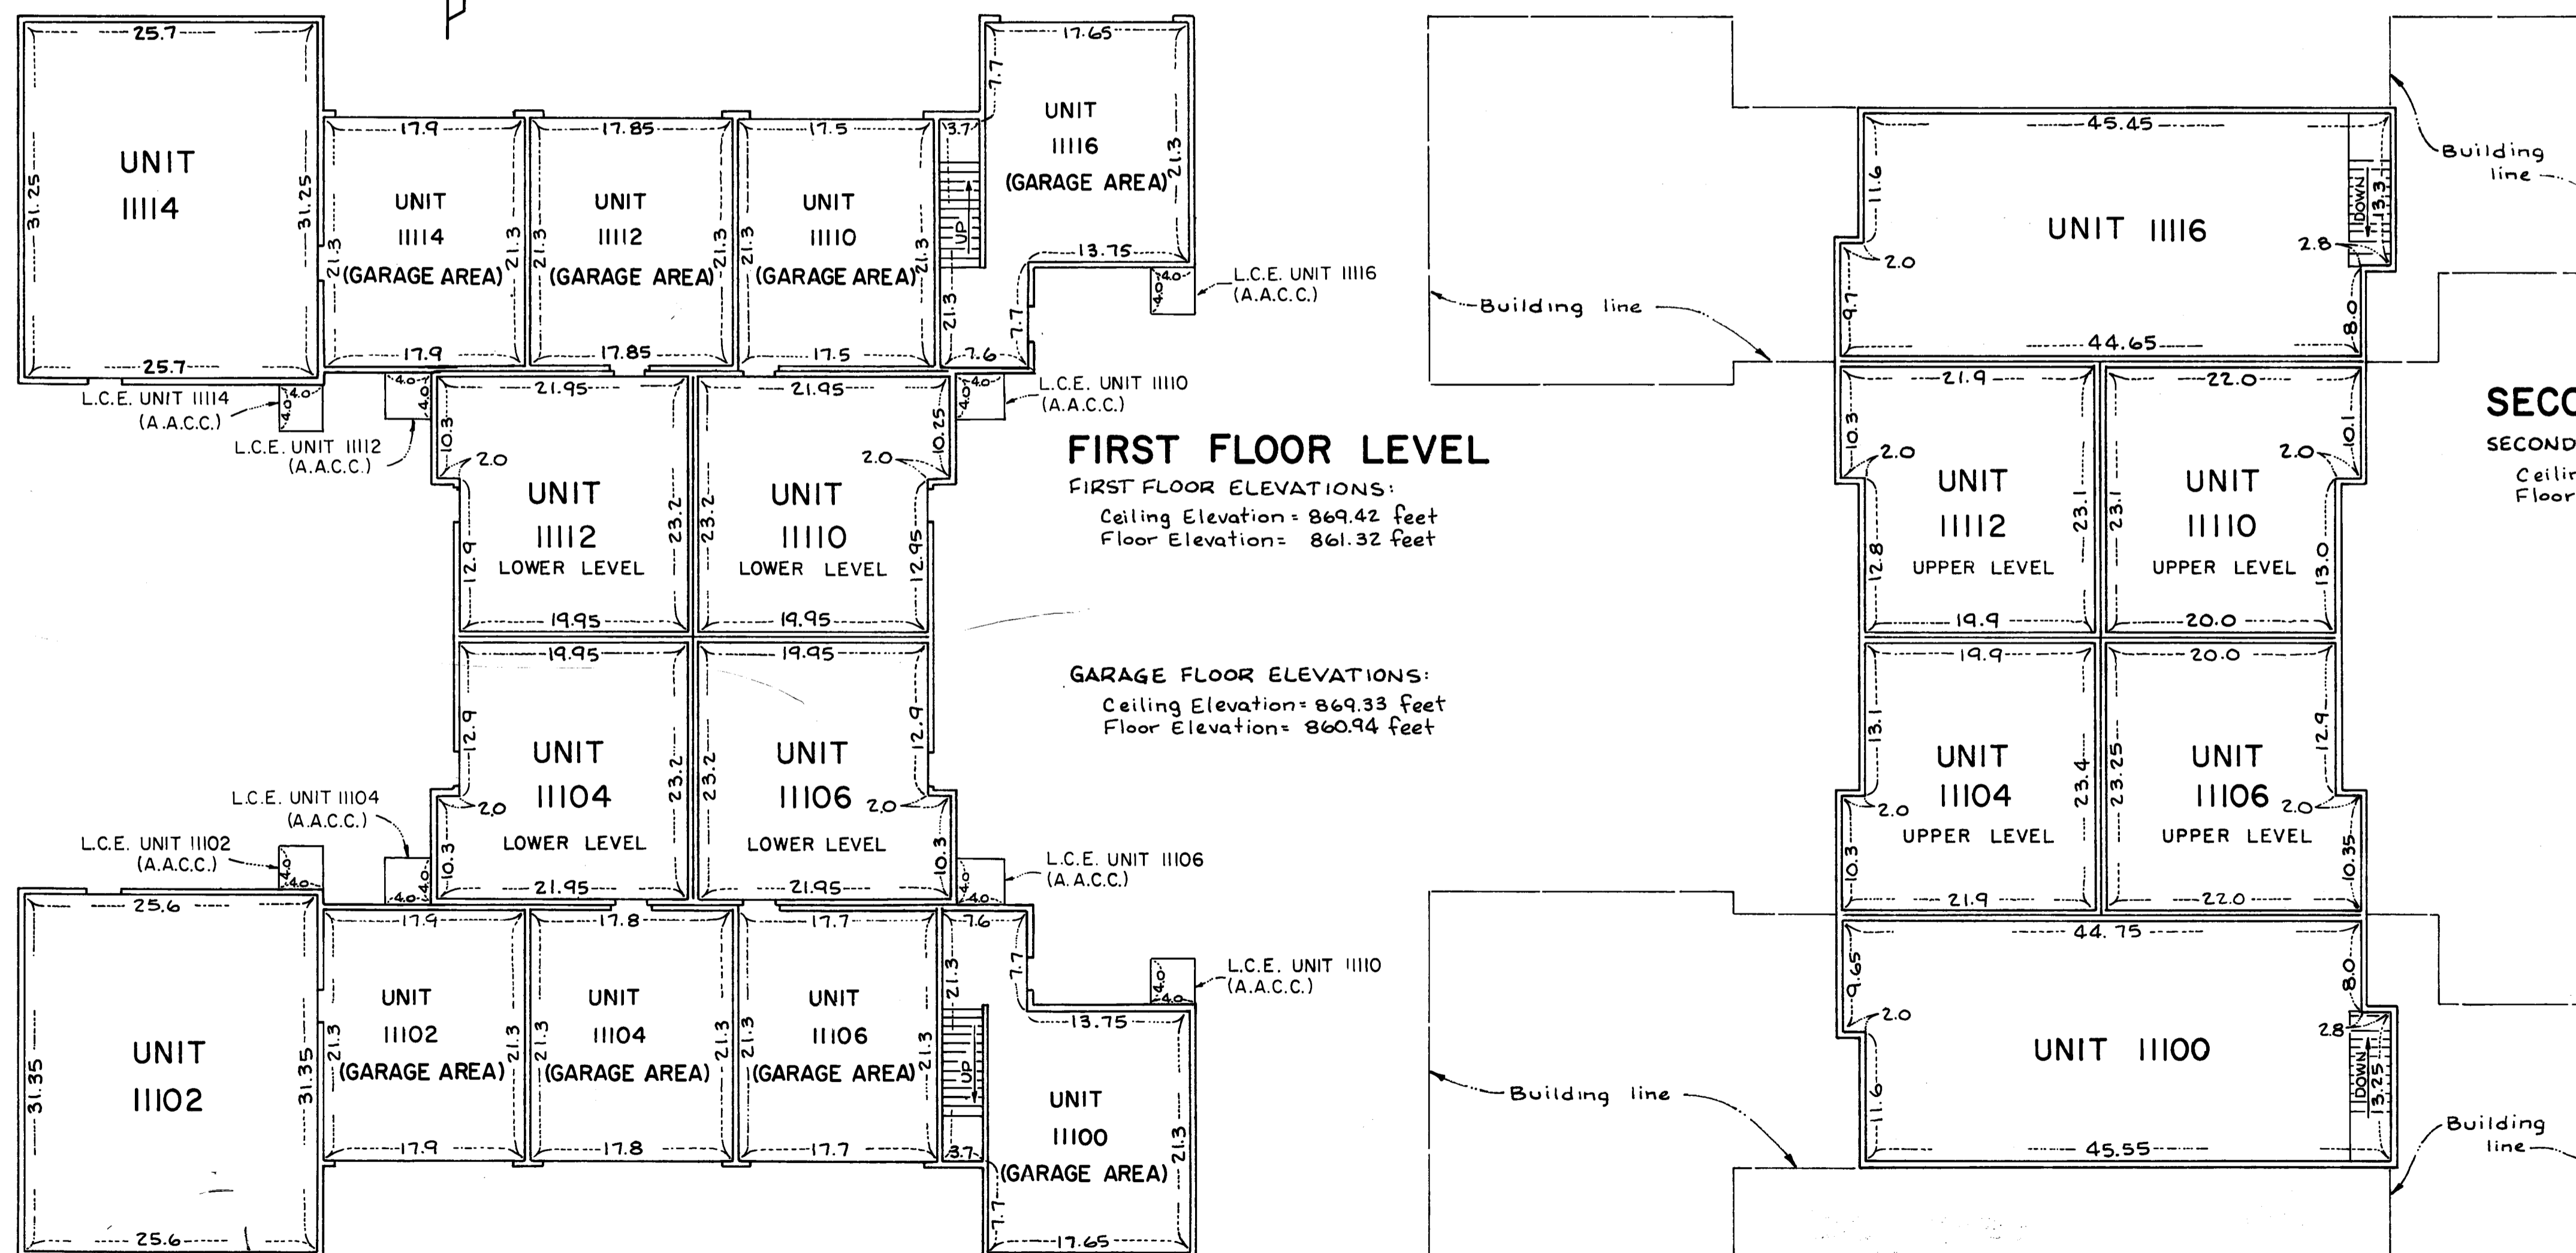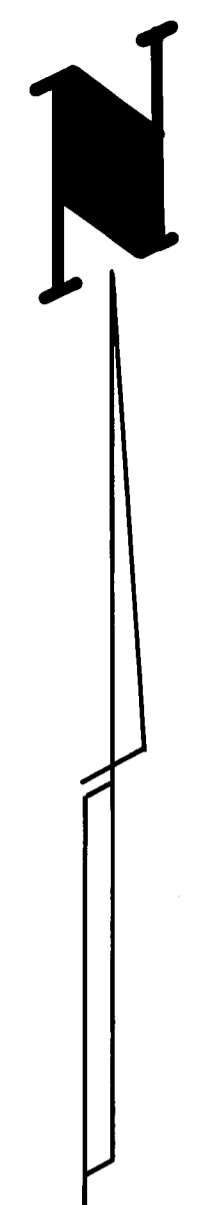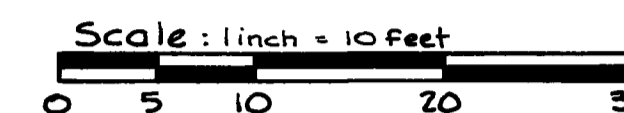

FIRST FLOOR LEVEL

FIRST FLOOR ELEVATIONS:
Ceiling Elevation = 869.42 feet
Floor Elevation = 861.32 feet

GARAGE FLOOR ELEVATIONS:
Ceiling Elevation = 869.33 feet
Floor Elevation = 860.94 feet

SECOND FLOOR LEVEL

SECOND FLOOR ELEVATIONS:
Ceiling Elevation = 878.92 feet
Floor Elevation = 870.82 feet

Measurements shown are from inside stud wall to inside stud wall.

L.C.E. Denotes Limited Common Element
(A.A.C.C.) Denotes Area for Air Conditioner Compressor

Elevations shown are referenced to a Benchmark shown on the site plan.