


LOT SURVEYS COMPANY, INC.
LAND SURVEYORS

CONDOMINIUM NUMBER 49 TRALEE TERRACE CONDOMINIUMS

SECOND SUPPLEMENTAL CONDOMINIUM PLAT

This Second Supplemental Condominium Plat is part of the Declaration filed for recorded as Document No. 842863 on this 10th day of MARCH, 1989.

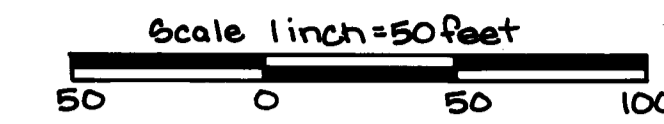

o Denotes Iron Monument
Utility & Drainage Easements per plat of Tralee Terrace Addition

The undersigned, being first duly sworn under oath certifies and deposes that this Second Supplemental Condominium Plat of Condominium No. 49, TRALEE TERRACE CONDOMINIUMS, being located upon

Lot 5, Block 1, TRALEE TERRACE ADDITION

and the Additional Real Estate is described as follows:


Lots 2, 6, 7, 8 and 9, Block 1, TRALEE TERRACE ADDITION

fully and accurately depicts all information required by Minnesota Statutes Section 515A. 2-110.

Dated this 18th day of JANUARY, 1989.

Raymond A. Prasch
Raymond A. Prasch, Registered Land Surveyor
Minnesota Registration No. 6743

State of Minnesota) s.s.
County of Hennepin) The foregoing instrument was acknowledged before me this 18th day of JANUARY, 1989,
by Raymond A. Prasch, a registered professional land surveyor.

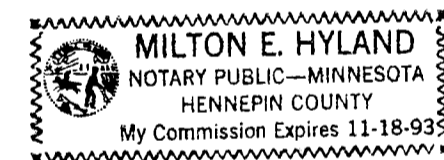


Milton E. Hyland
Milton E. Hyland, Notary Public, Hennepin County, Minnesota
My Commission Expires November 18, 1993

DONALD J. BAKER, a registered professional ARCHITECT for the State of Minnesota pursuant to Minnesota Statutes Section 515A. 2-101 (b) and (c) does hereby certify that all structural components and mechanical systems serving more than one unit of all buildings containing or comprising any units hereby created are substantially completed consistent with the Second Supplemental Condominium Plat of Condominium No. 49, TRALEE TERRACE CONDOMINIUMS, and that all units are entirely completed consistent with said Condominium Plat.

Dated this 6th day of MARCH, 1989.

Donald J. Baker
Minnesota Registration No. 9861

State of Minnesota) s.s.
County of Anoka) The foregoing instrument was acknowledged before me this 6th day of MARCH, 1989, by
Donald J. Baker, a registered professional Architect.

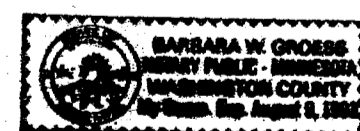

Barbara W. Gross
Notary Public, Washington County, Minnesota
My Commission Expires August 9, 1993

Checked and approved this 10th day of MARCH, 1989.

MERLYN D. ANDERSON
Anoka County Surveyor
by *Larry D. Brown* deputy


"NO DELINQUENT TAXES AND TRANSFER ENTLRED"

March 10th 1989
Charles R. Lohme
Auditor, Anoka County
BY *S. R. [Signature]* Deputy

Benchmark: Spike in west face of 24" Oak 20 feet southwest of the northeast corner of Lot 3, Block 1 Tralee Terrace Add Elev. = 874.00 feet (N.G.V.D 1929 adj.)

For the purposes of this plat the East line of Sec. 26, T31, R24 is assumed to bear 50°00'39"E

OFFICE OF COUNTY RECORDER
STATE OF MINNESOTA, COUNTY OF ANOKA
I hereby certify that the within instrument was filed in this office for record on the MAR 10 A.D., 1989 at 10:40 o'clock A.M., and was duly recorded in book 4 of Condo page 8
Ted J. Dondell
County Recorder
By *Dreta Kayler* Deputy

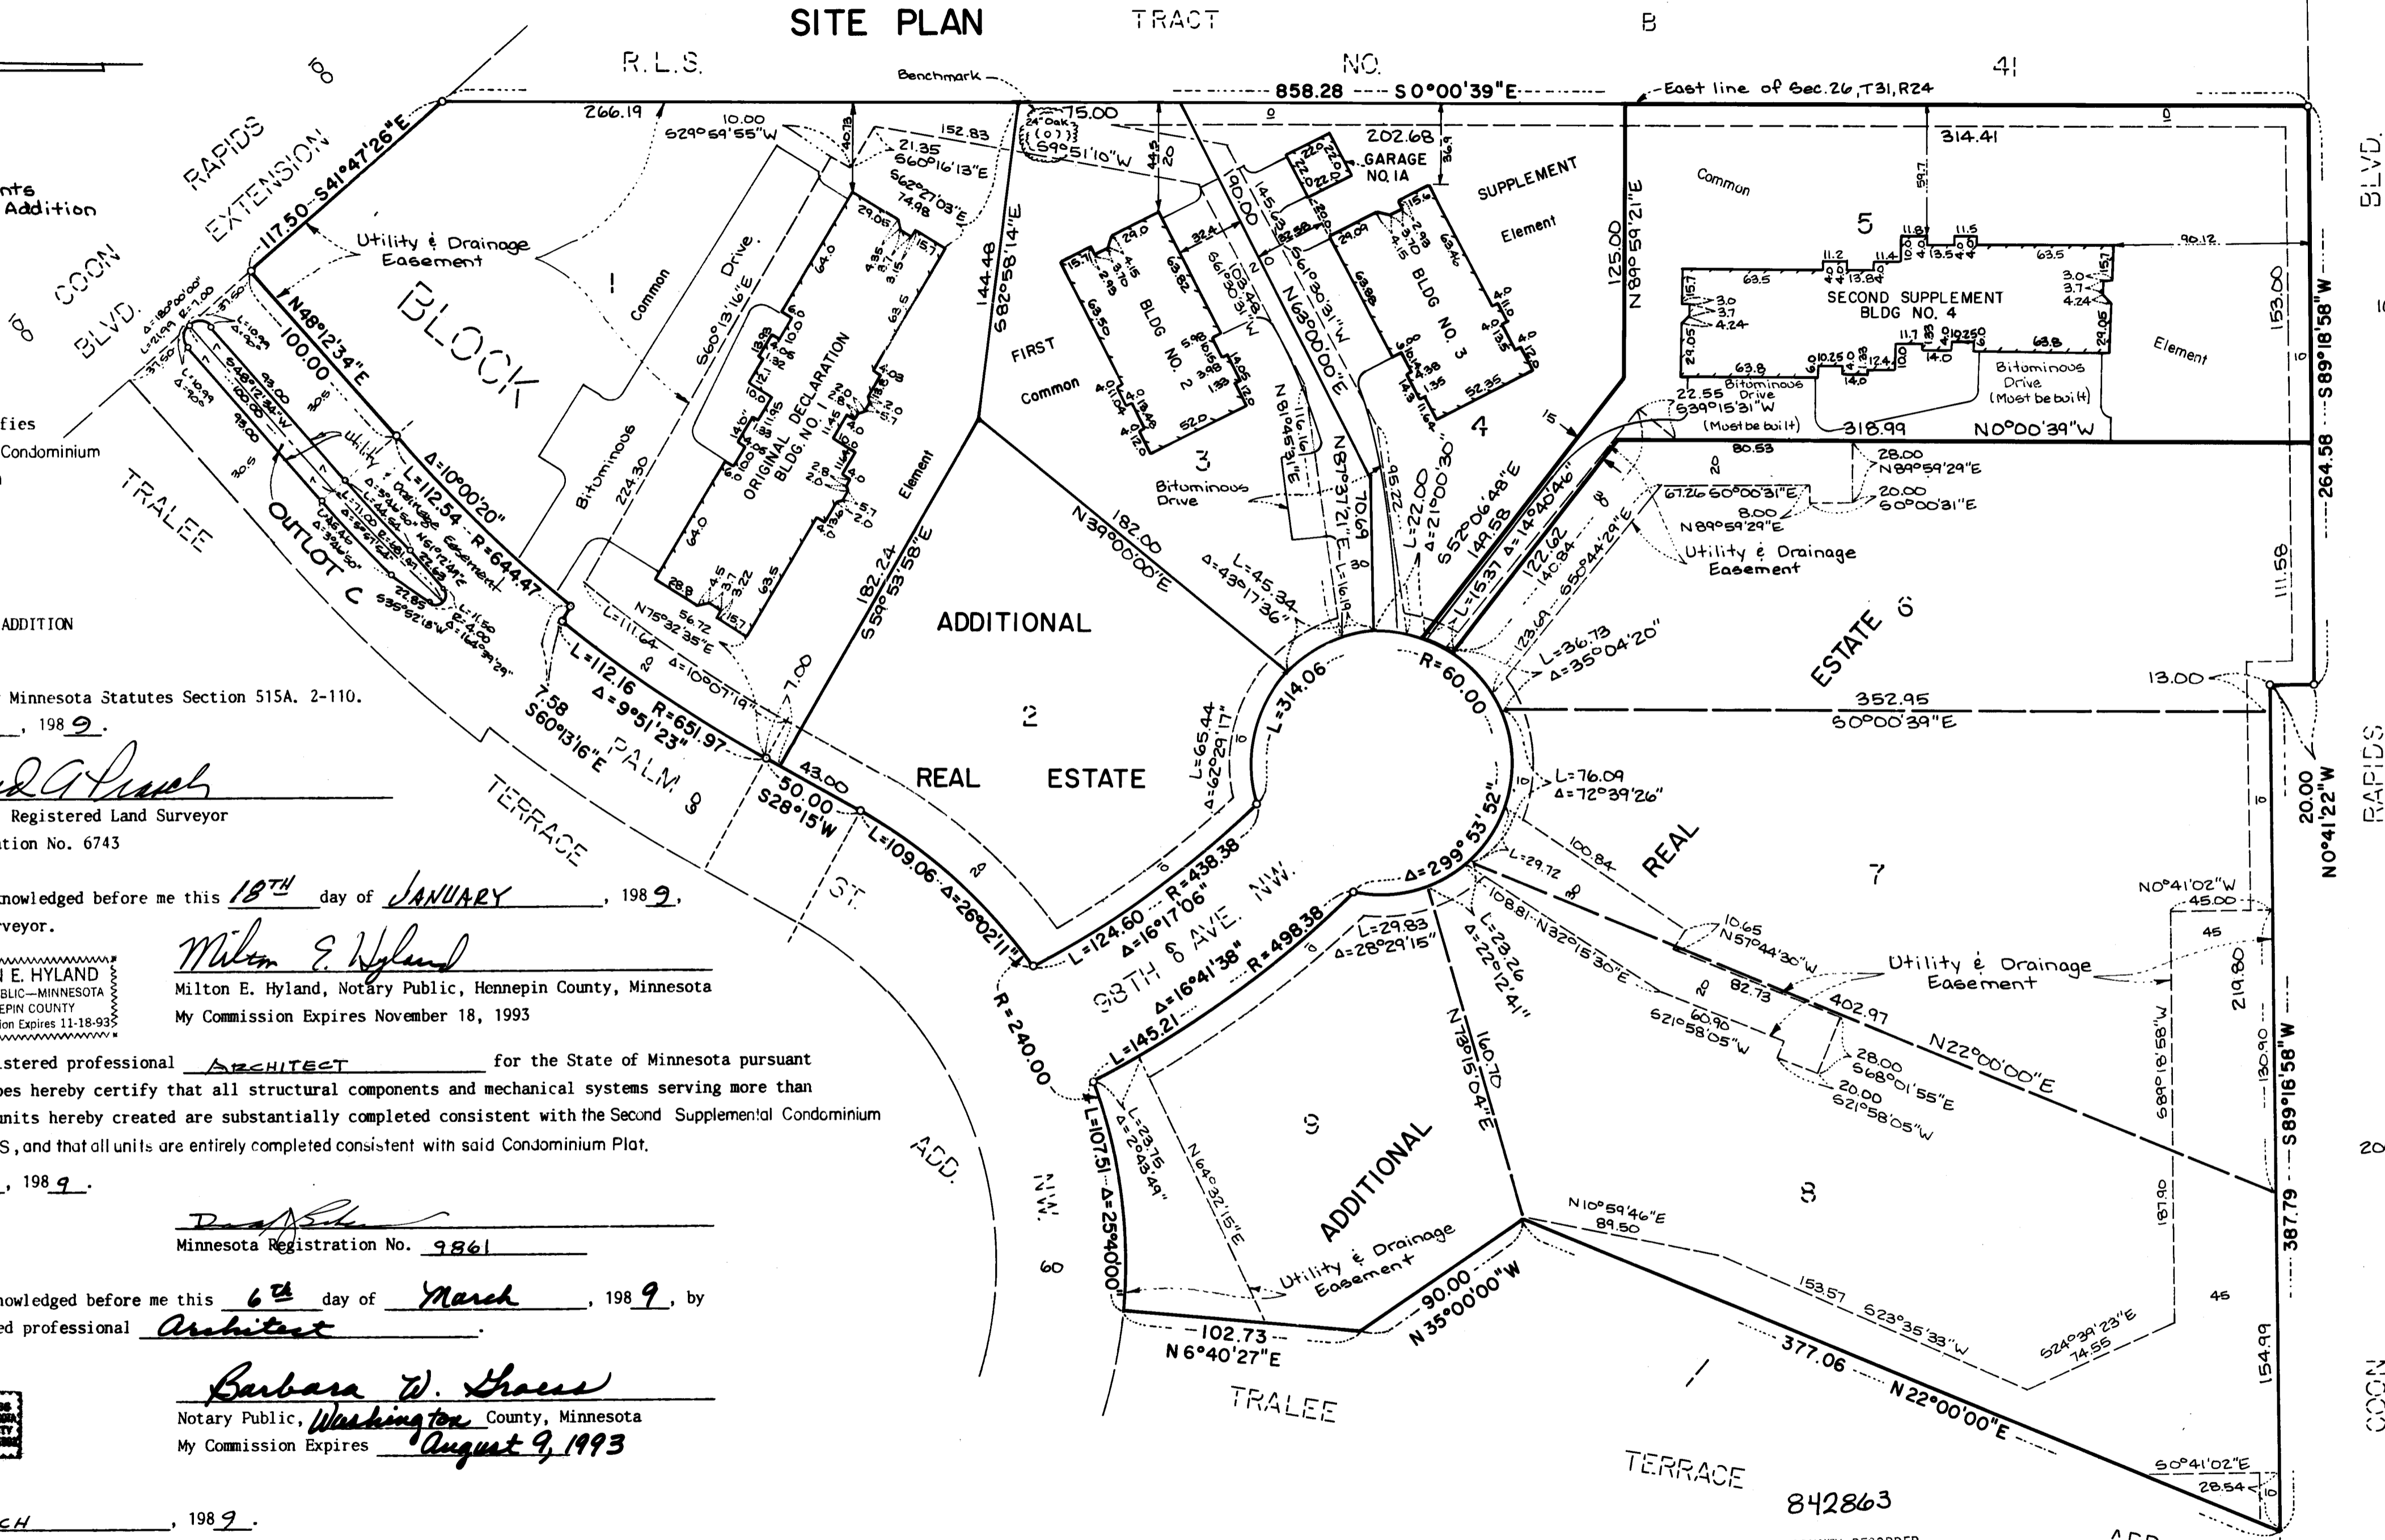


CONDOMINIUM NUMBER 49 TRALEE TERRACE CONDOMINIUMS

LOT SURVEYS COMPANY, INC.
LAND SURVEYORS

SECOND SUPPLEMENTAL CONDOMINIUM PLAT

FLOOR PLAN


BUILDING NO. 4

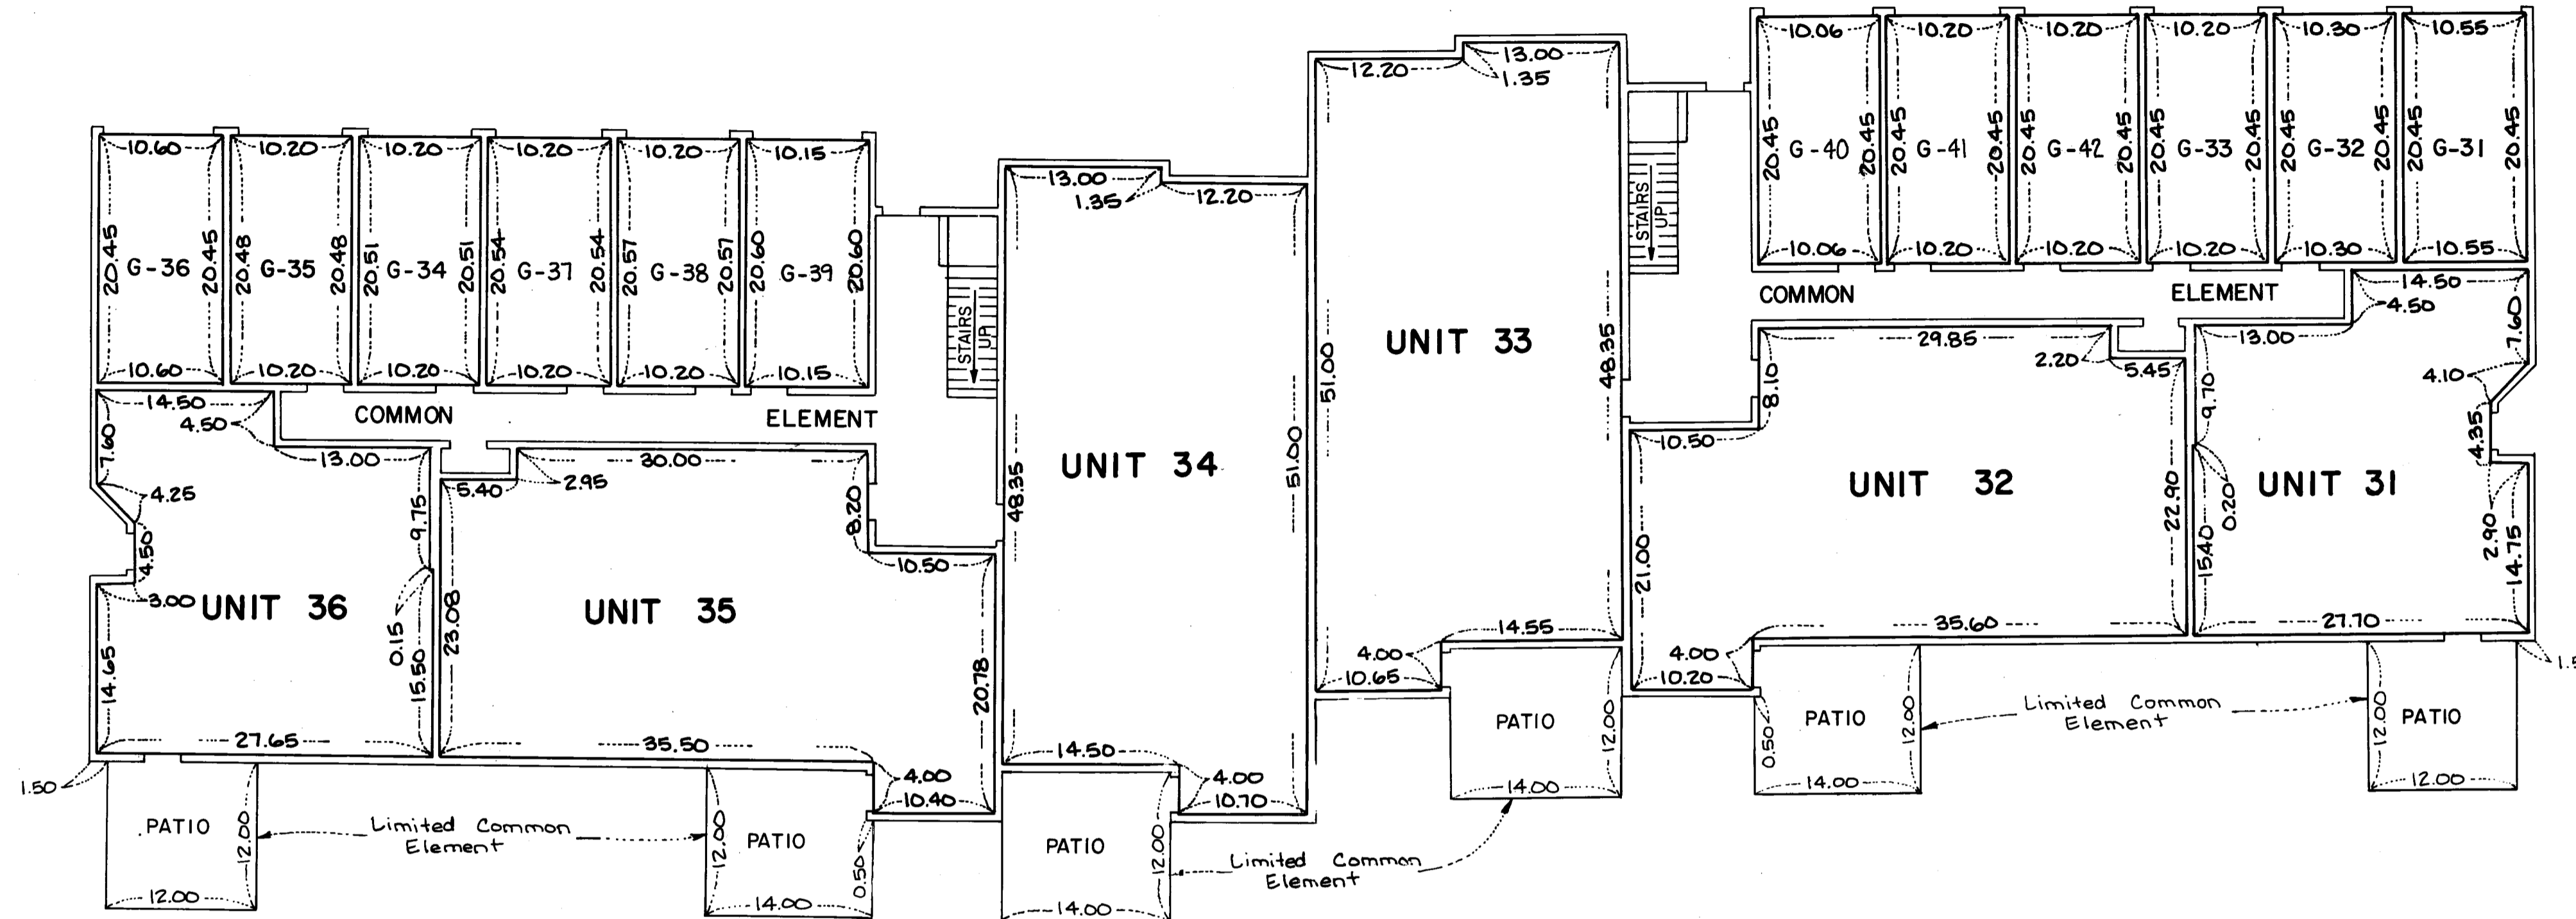

FIRST FLOOR LEVEL


FIRST FLOOR ELEVATIONS:
 Units 31-33
 Ceiling Elevation = 881.63 feet
 Floor Elevation = 873.53 feet
 Units 34-36
 Ceiling Elevation = 882.63 feet
 Floor Elevation = 874.53 feet

GARAGE FLOOR ELEVATIONS:
 Units G-31-G-33 and G-37-G-39
 Ceiling Elevation = 881.63 feet
 Floor Elevation = 873.08 feet
 Units G-40-G-42 and G-34-G-36
 Ceiling Elevation = 882.63 feet
 Floor Elevation = 874.08 feet

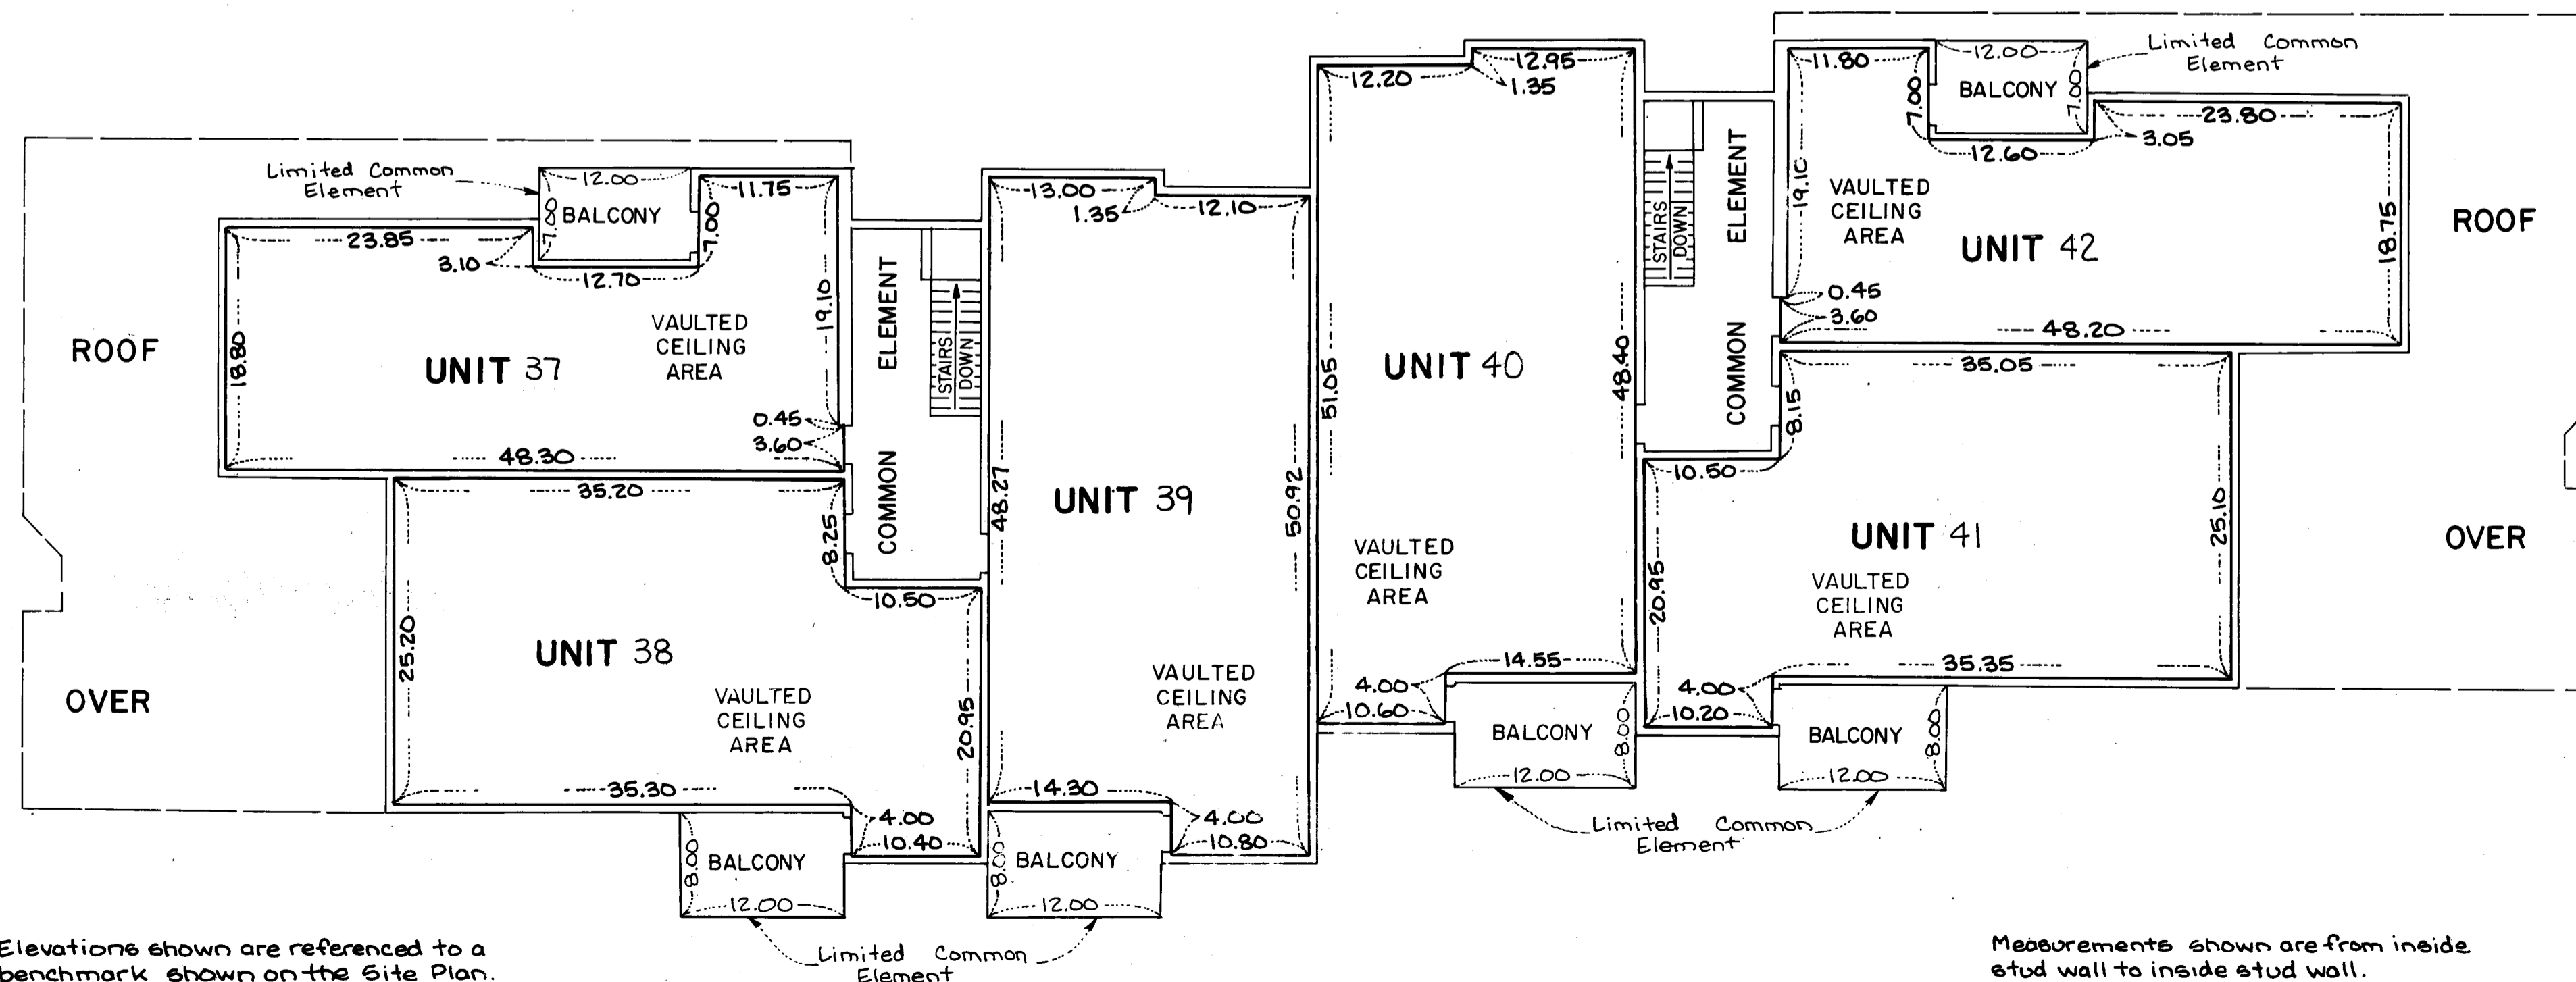

SECOND FLOOR LEVEL

SECOND FLOOR ELEVATIONS:
 Units 37-39
 Ceiling Elevation = 891.45 feet
 Floor Elevation = 883.35 feet
 Units 40-42
 Ceiling Elevation = 892.45 feet
 Floor Elevation = 884.35 feet

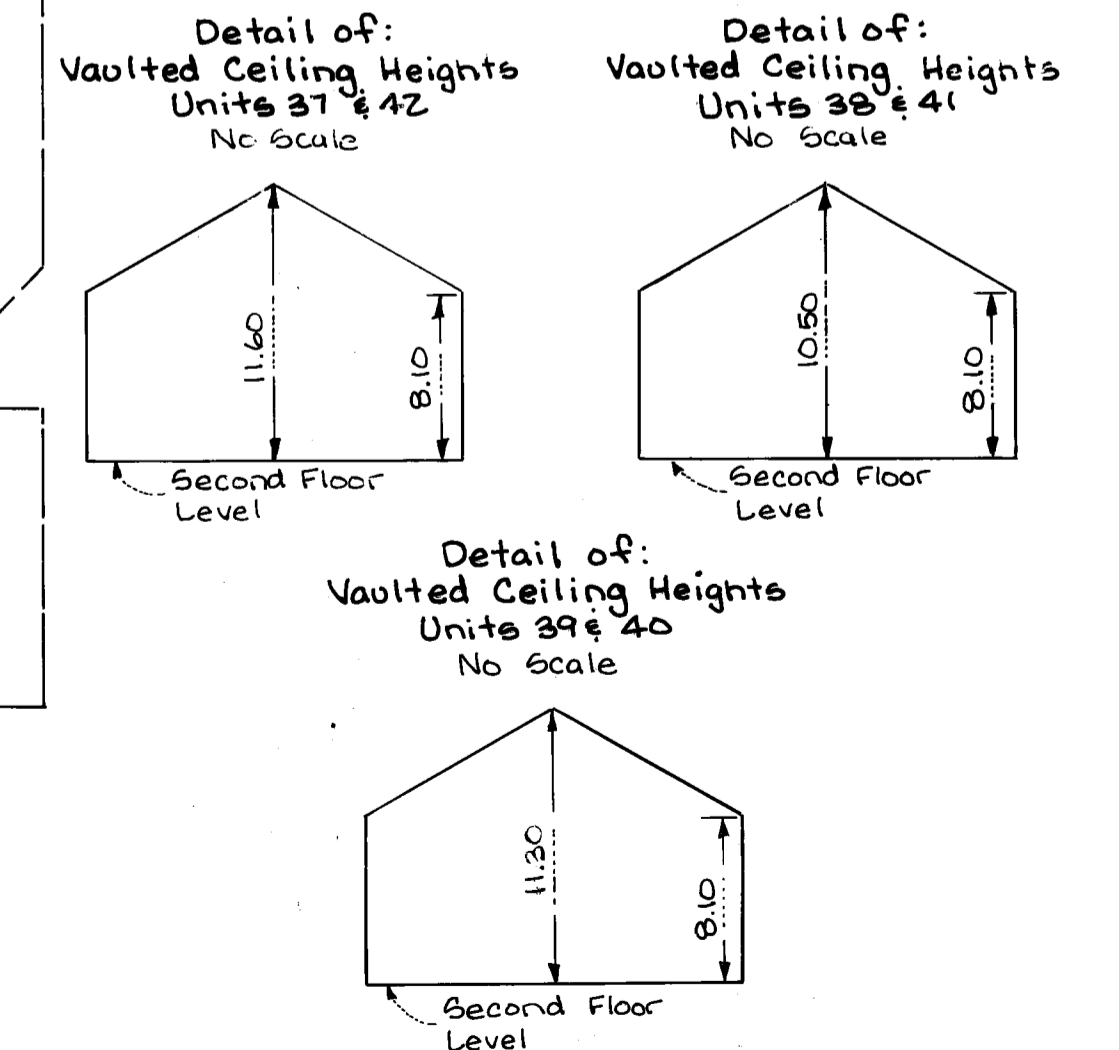

Elevations shown are referenced to a benchmark shown on the Site Plan.

Measurements shown are from inside stud wall to inside stud wall.