


LOT SURVEYS COMPANY, INC.
LAND SURVEYORS

CONDOMINIUM NUMBER 49 TRALEE TERRACE CONDOMINIUMS

FOURTH SUPPLEMENTAL CONDOMINIUM PLAT

This Fourth Supplemental Condominium Plat is part of the Declaration filed
or recorded as Document No. 892816 on this
15 day of MAY, 1990.

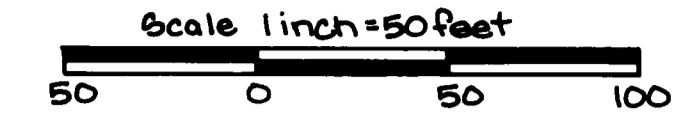

o Denotes Iron Monument
Utility & Drainage Easements
per plat of Tralee Terrace Addition

The undersigned, being first duly sworn under oath certifies
and deposes that this Fourth Supplemental Condominium Plat of Condominium
No. 49, TRALEE TERRACE CONDOMINIUMS, being located upon

Lot 2, Block 1, TRALEE TERRACE ADDITION

and the Additional Real Estate is described as follows:

Lots 7, 8 and 9, Block 1, TRALEE TERRACE ADDITION

fully and accurately depicts all information required by Minnesota Statutes Section 515A, 2-110.

Dated this 6TH day of MARCH, 1990.

Raymond A. Prasch
Raymond A. Prasch, Registered Land Surveyor
Minnesota Registration No. 6743

State of Minnesota) s.s.
County of Hennepin) The foregoing instrument was acknowledged before me this 6TH day of MARCH, 1990,
by Raymond A. Prasch, a registered professional land surveyor.

MILTON E. HYLAND
NOTARY PUBLIC—MINNESOTA
HENNEPIN COUNTY
My Commission Expires 11-18-93

Milton E. Hyland
Milton E. Hyland, Notary Public, Hennepin County, Minnesota
My Commission Expires November 18, 1993

DONALD J. BAKER, a registered professional ARCHITECT for the State of Minnesota pursuant
to Minnesota Statutes Section 515A, 2-101 (b) and (c) does hereby certify that all structural components and mechanical systems serving more than
one unit of all buildings containing or comprising any units hereby created are substantially completed consistent with the Fourth Supplemental Condominium
Plat of Condominium No. 49, TRALEE TERRACE CONDOMINIUMS, and that all units are entirely completed consistent with said Condominium Plat.

Dated this 19TH day of APRIL, 1990.

Donald J. Baker
Minnesota Registration No. 9861

State of Minnesota) s.s.
County of Anoka) The foregoing instrument was acknowledged before me this 19th day of April, 1990, by
Donald J. Baker, a registered professional Architect.

BARBARA W. THOESS
NOTARY PUBLIC—MINNESOTA
WASHINGTON COUNTY
My Comm. Exp. August 9, 1993

Barbara W. Thoess
Notary Public, Washington County, Minnesota
My Commission Expires Aug 9, 1993

Checked and approved this 3rd day of May, 1990.

Mauf D. Anselm
Anoka County Surveyor

I HEREBY CERTIFY THAT THE TAXES
PAYABLE IN THIS YEAR 1990 ON THE
LANDS DESCRIBED WITHIN ARE PAID

Donald C. Bailey
Anoka County Treasurer
Z. Henry - Deputy

"NO DELINQUENT TAXES
AND TRANSFER ENTL'RD"

May 15 1990

Charles R. Rosell
Auditor, Anoka County


By: [Signature]
Deputy

Benchmark: Spike in west face of 24" Oak
20 feet southwest of the northeast corner
of Lot 3, Block 1, Tralee Terrace Add Elev. =
874.00 feet (N.G.V.D 1929 adj.)

For the purposes of this plat the East line
of Sec. 26, T31, R24 is assumed to bear
S0°00'39"E

OFFICE OF COUNTY RECORDER
STATE OF MINNESOTA, COUNTY OF ANOKA
I hereby certify that the within instru-
ment was filed in this office for record
on the MAY 15, 1990 A.D., 1990
at 1:55 o'clock P.M., and was duly recorded
in book 40 of CONDO page 19

Neil J. Omdahl
County Recorder
By: [Signature]
Deputy

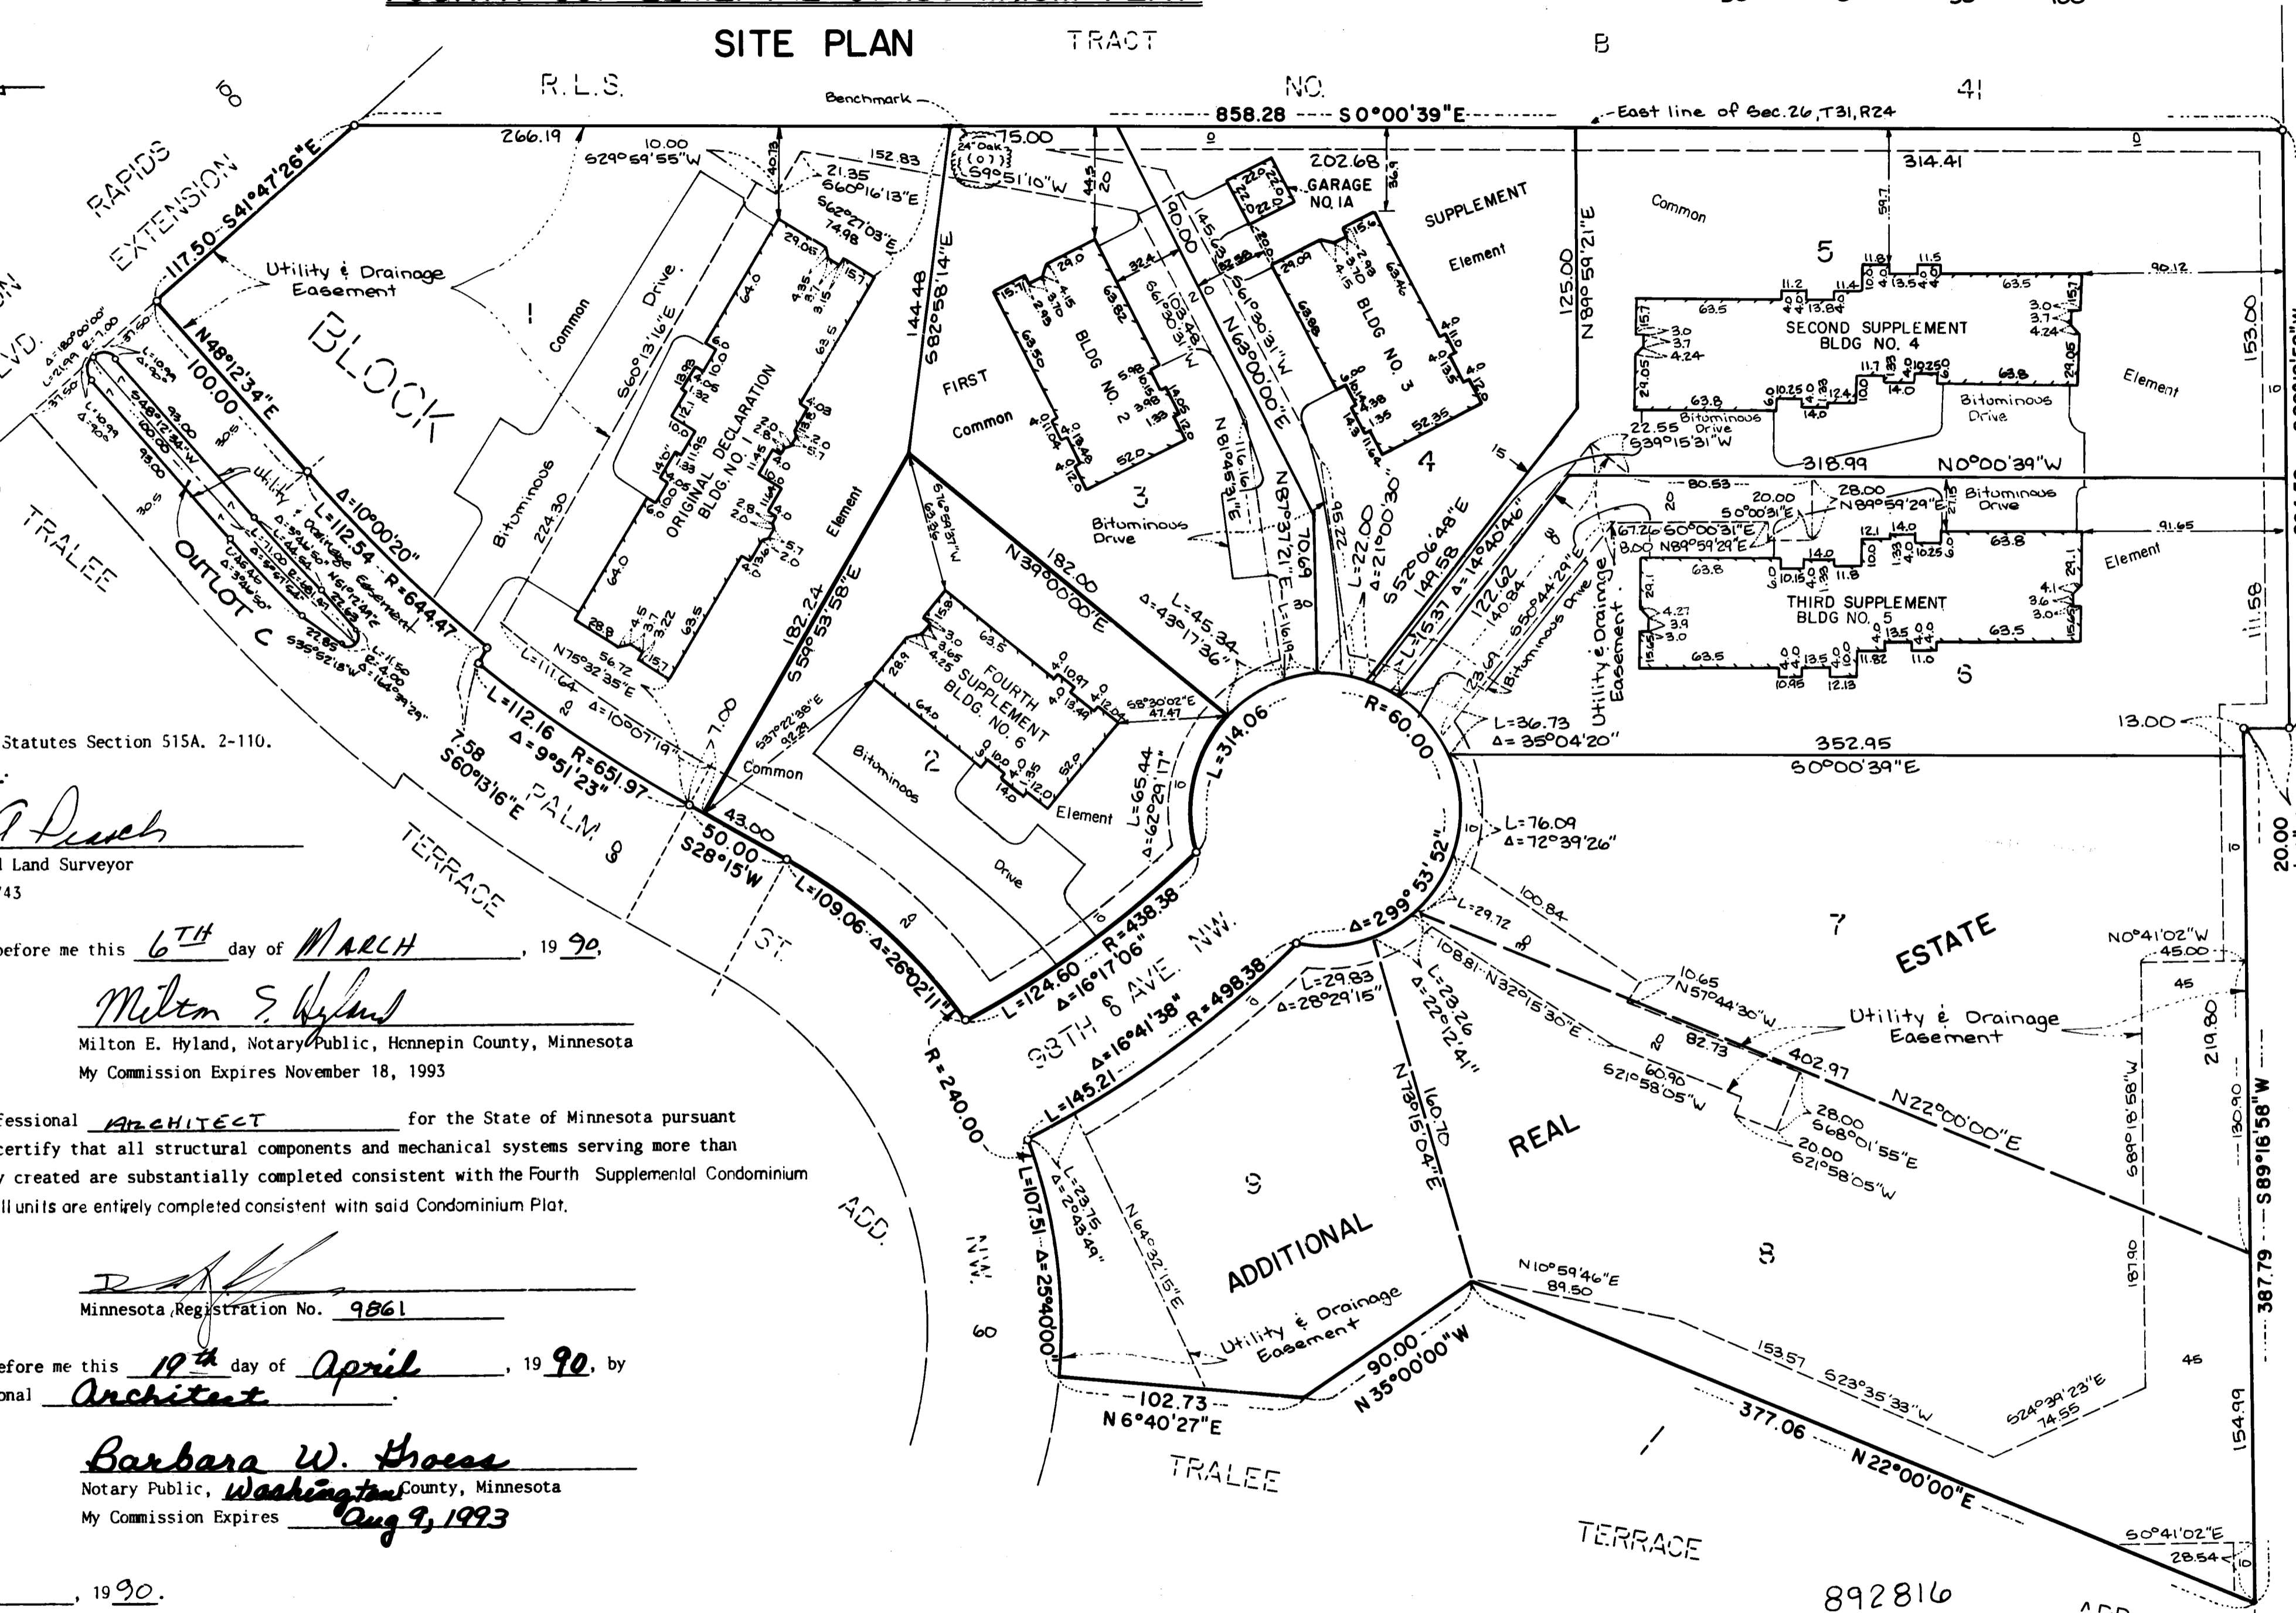

CONDOMINIUM NUMBER 49 TRALEE CONDOMINIUMS

FOURTH SUPPLEMENTAL CONDOMINIUM PLAT

LOT SURVEYS COMPANY, INC.
LAND SURVEYORS


FLOOR PLANS

BUILDING NO. 6


SECOND FLOOR LEVEL

SECOND FLOOR ELEVATIONS:
Ceiling Elevation = 886.71 feet
Floor Elevation = 878.61 feet



Detail of:
Vaulted Ceiling Elevations
Unit 28
No Scale

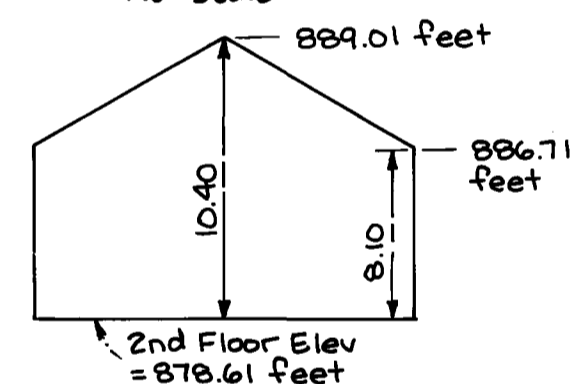

Detail of:
Vaulted Ceiling Elevations
Unit 29
No Scale

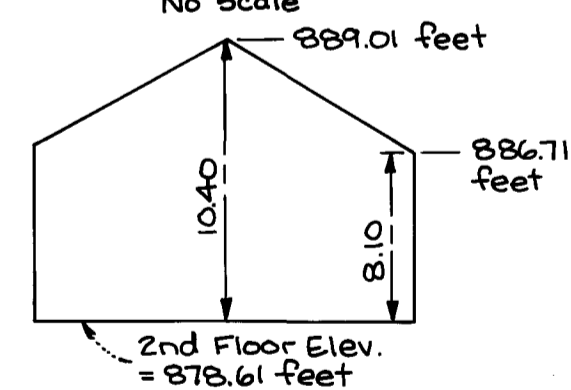

Detail of:
Vaulted Ceiling Elevations
Unit 30
No Scale

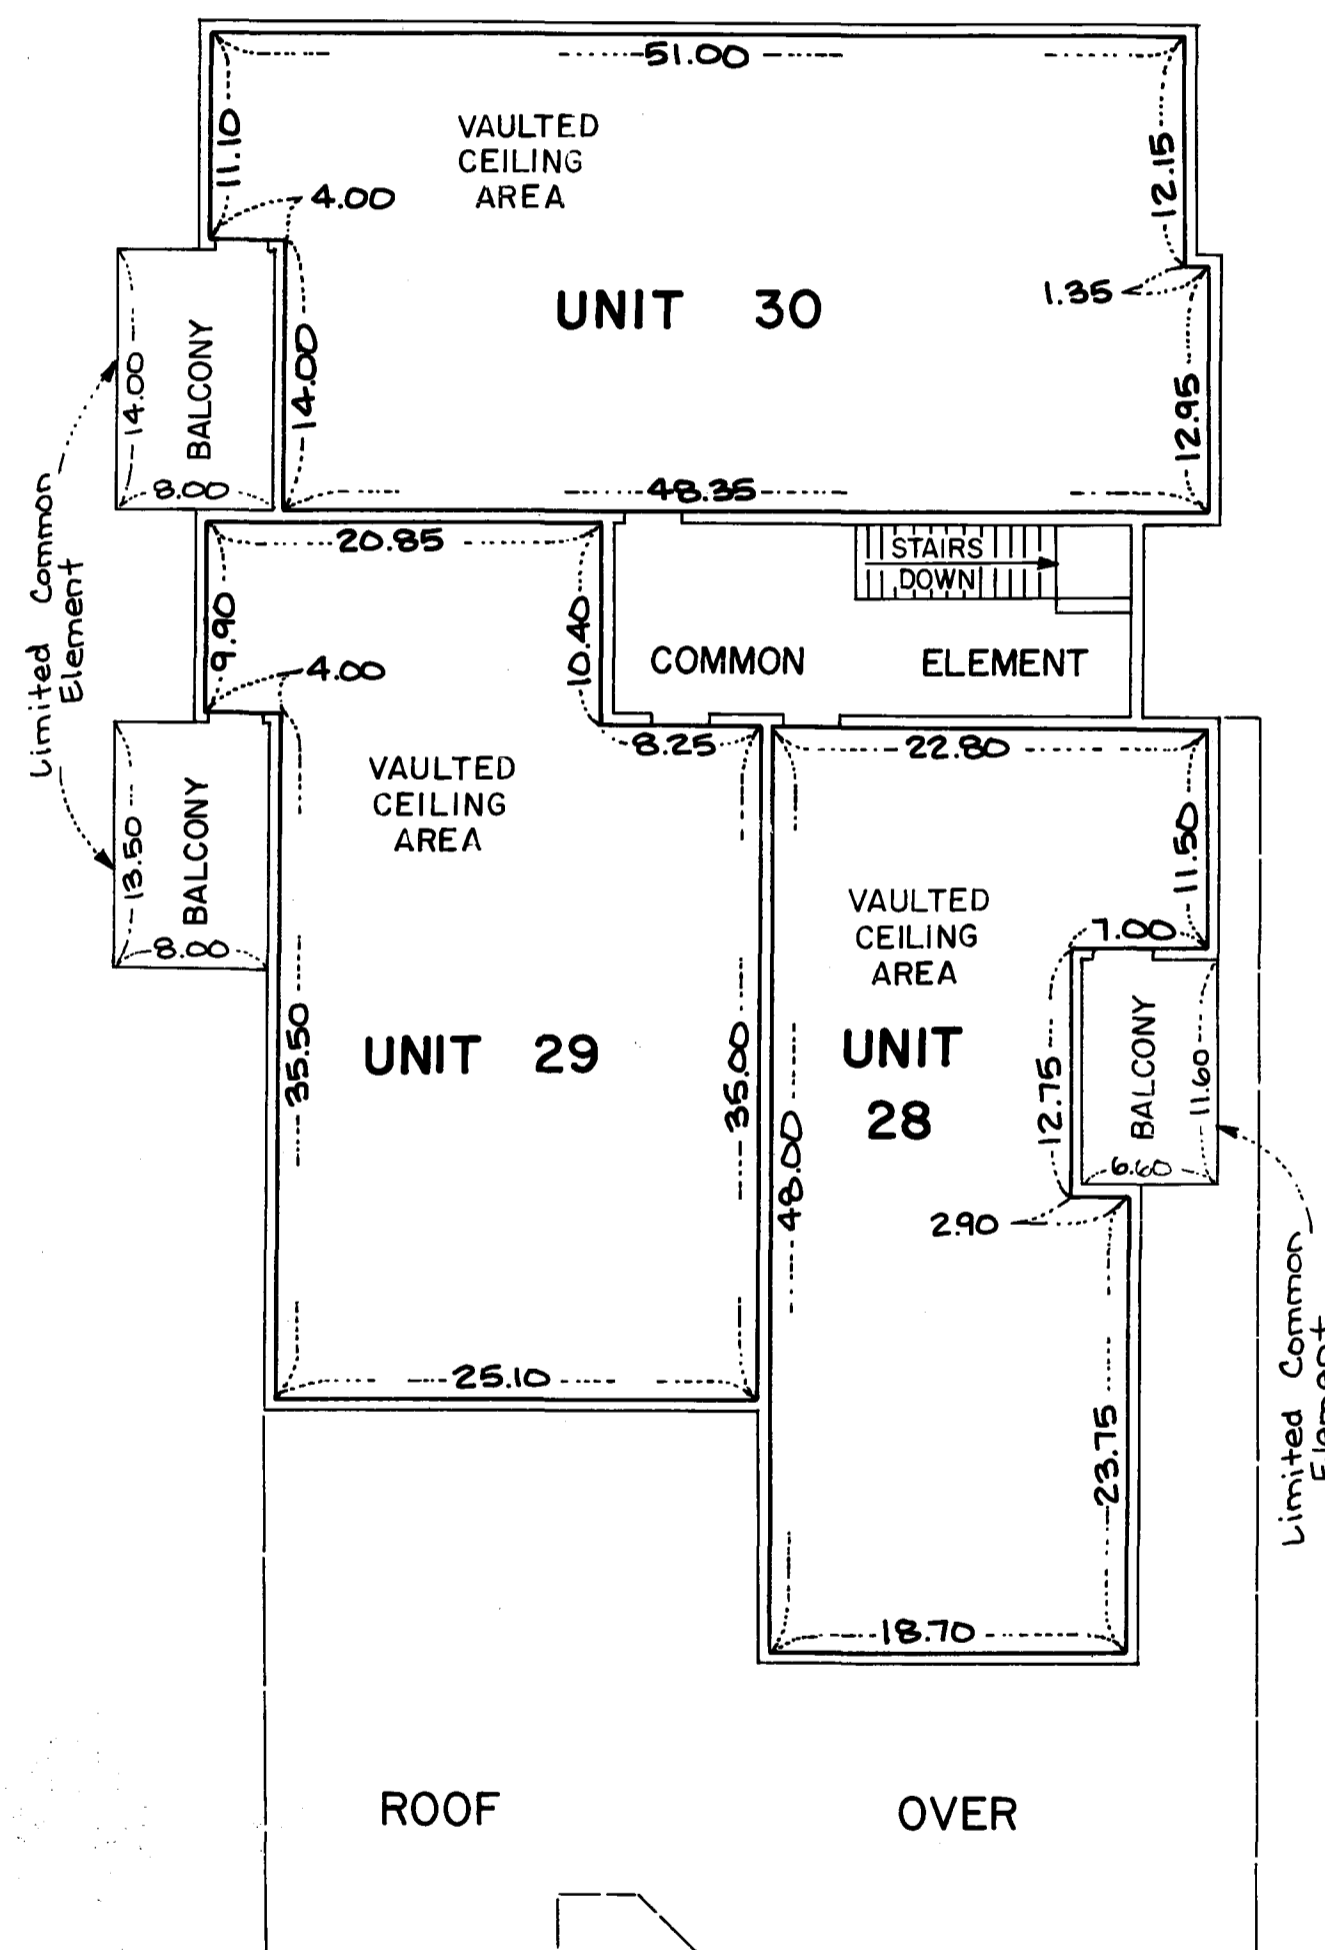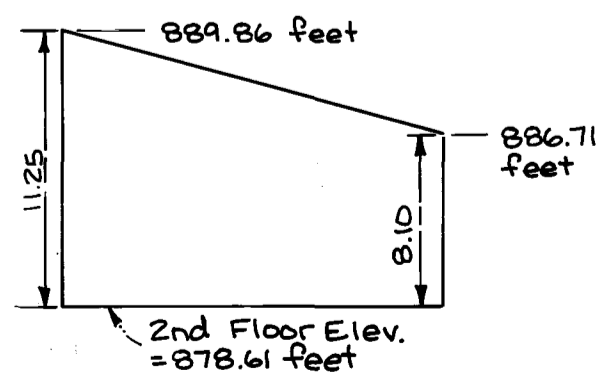


Elevations shown are referenced to a benchmark shown on the Site Plan.

FIRST FLOOR LEVEL

FIRST FLOOR ELEVATIONS:
Ceiling Elevation = 876.86 feet
Floor Elevation = 868.76 feet

GARAGE UNIT ELEVATIONS:
Ceiling Elevation = 876.86 feet
Floor Elevation = 868.41 feet

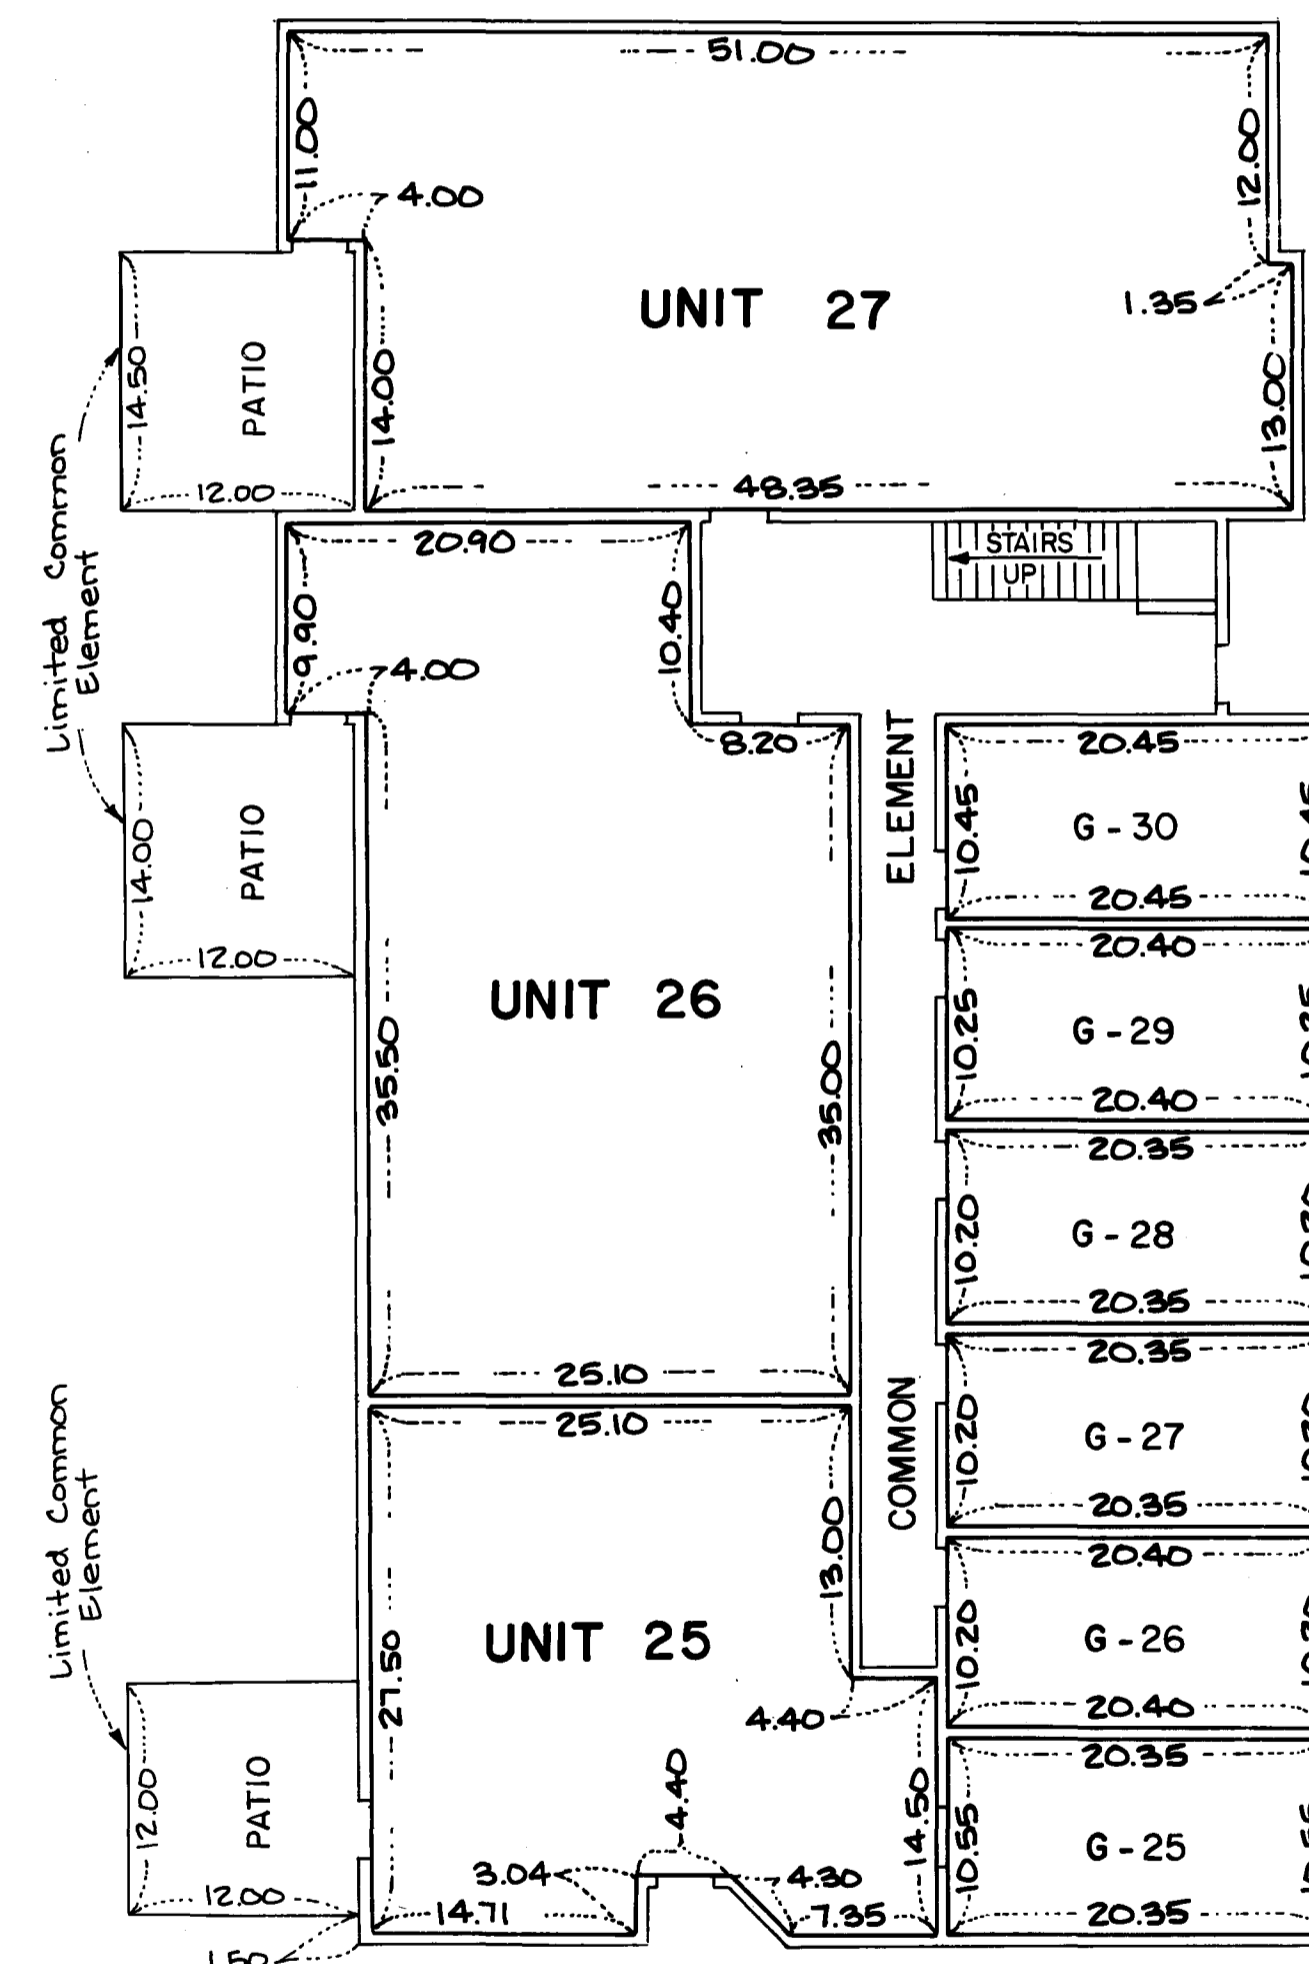

Measurements shown are from inside stud wall to inside stud wall.

