
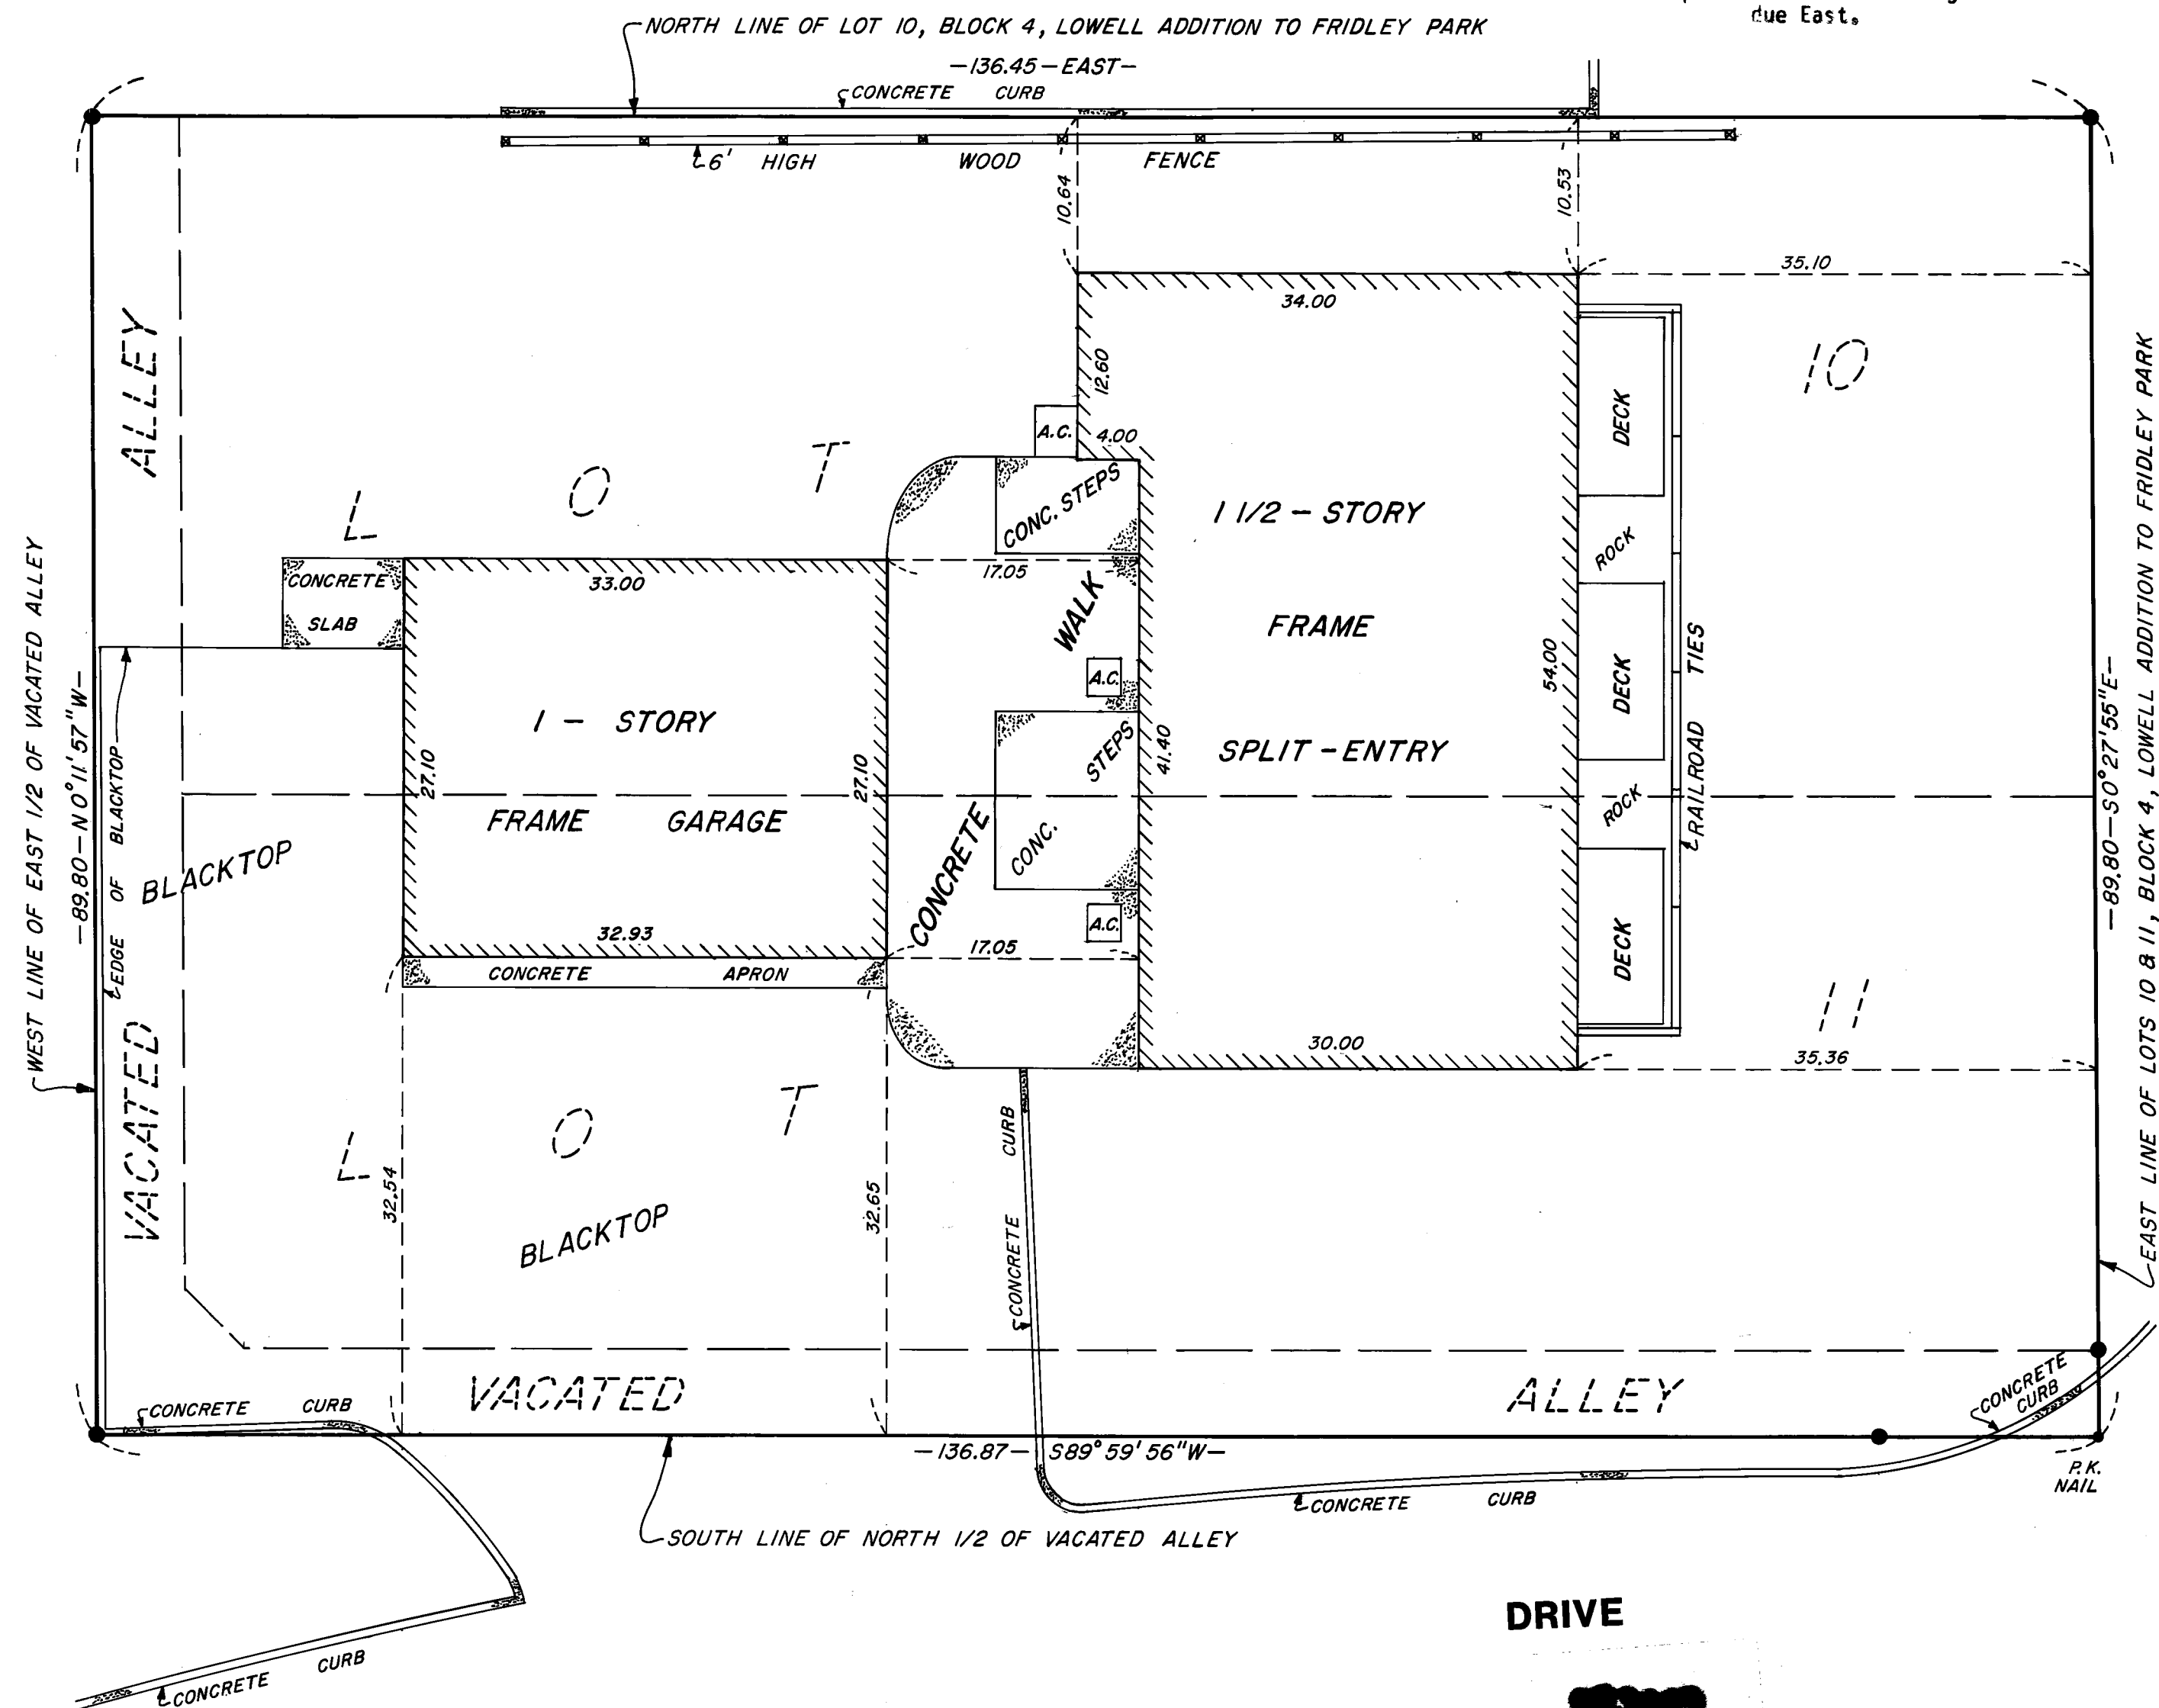


# CONDOMINIUM NUMBER 9

## 6500, 6510, 6520 2ND STREET N.E. CONDOMINIUM ASSOCIATION, INC.

These Floor Plans have been recorded as part of the Declaration filed as Document No. 583249 on the 16TH day of DEC, 1981, Anoka County, Minnesota.

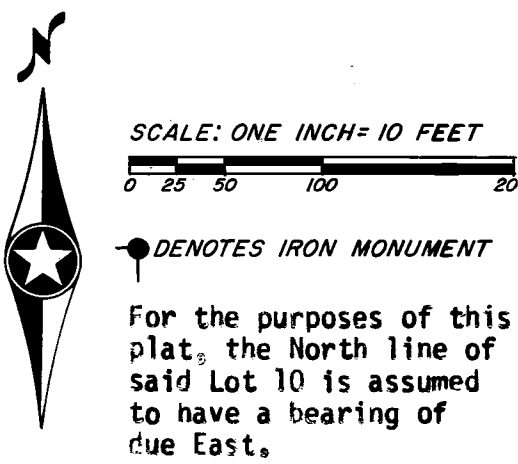

N.E. STREET 2ND


The undersigned, being first duly sworn under oath, certifies and disposes that these Floor Plans of Condominium No. 9, 6500, 6510, 6520 2nd Street N. E. Condominium Association, Inc., being located upon Lots 10 and 11, Block 4, Lowell Addition to the City of Fridley, Anoka County, Minnesota together with the East 1/2 of the vacated alley lying adjacent to said Lots 10 and 11 and the North 1/2 of the vacated alley lying adjacent to said Lot 11, fully and accurately depicts all information required by Minnesota Statutes Section 515A.2-110.

Dated this 14TH day of DECEMBER, 1981.

N. C. Hoium  
N. C. Hoium, Registered Land Surveyor  
Minnesota Registration No. 4427

State of Minnesota )  
County of Anoka )  
The foregoing instrument was acknowledged before me this 14TH day of DECEMBER, 1981 by N. C. Hoium, a registered professional land surveyor.

Larry D. Hoium  
Larry D. Hoium, Notary Public, Anoka County, Minnesota  
My Commission Expires September 24, 1988.

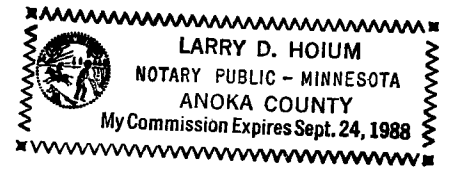


Robert B. Baker, a registered professional architect for the State of Minnesota pursuant to Minnesota Statutes Section 515A.2-101(b) does hereby certify that all structural components and mechanical systems serving more than one unit of all buildings containing or comprising any units hereby created are substantially completed consistent with the Floor Plans for Condominium No. 9, 6500, 6510, 6520 2nd Street N. E. Condominium Association, Inc.

Dated this 14TH day of DECEMBER, 1981.

Robert B. Baker  
Robert B. Baker, Registered Architect  
Minnesota Registration No. 6847

State of Minnesota )  
County of ANOKA )  
The foregoing instrument was acknowledged before me this 14TH day of DECEMBER, 1981 by Robert B. Baker, a registered professional architect.

Larry D. Hoium  
Notary Public, ANOKA County, Minnesota  
My Commission expires SEPT. 24, 1988

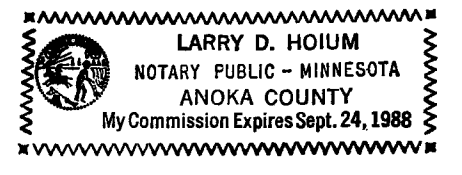

Checked and approved this 16th day of Dec., 1981 A.D.  
Robert W. Anderson  
Anoka County Surveyor

N. C. HOIUM & ASSOC., INC.  
LAND SURVEYORS

### SITE PLAN



OFFICE OF COUNTY RECORDER  
STATE OF MINNESOTA, COUNTY OF ANOKA  
I hereby certify that the within instrument was filed in this office for record on the DEC 16 1981 A.D., 1981 at 2:10 o'clock P.M., and was duly recorded in book 1 OF page 8 CONDOMINIUMS  
Red J. Omdahl  
County Recorder  
By N. C. Hoium  
Duty

THE DEPARTMENT OF  
AND TRANSFER SERVICE  
Dec 16 1981  
Spencer R. Johnson  
Auditor, Anoka County  
BY SK

ACRD 71572 DEC 16 81 39.00


# CONDOMINIUM NUMBER 9

## 6500, 6510, 6520 2ND STREET N.E. CONDOMINIUM ASSOCIATION, INC.

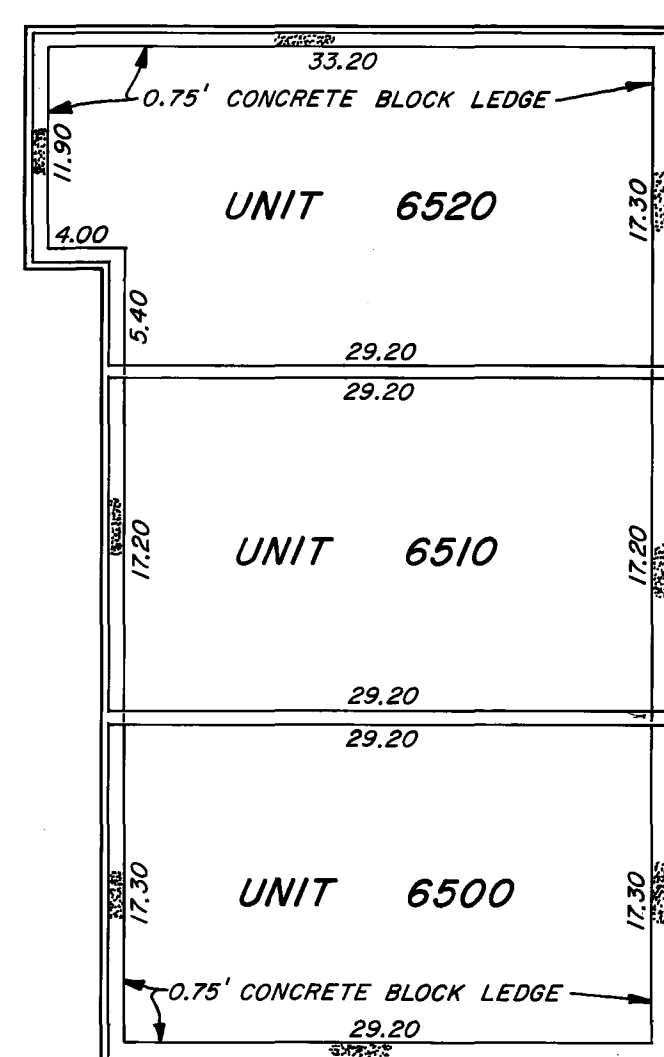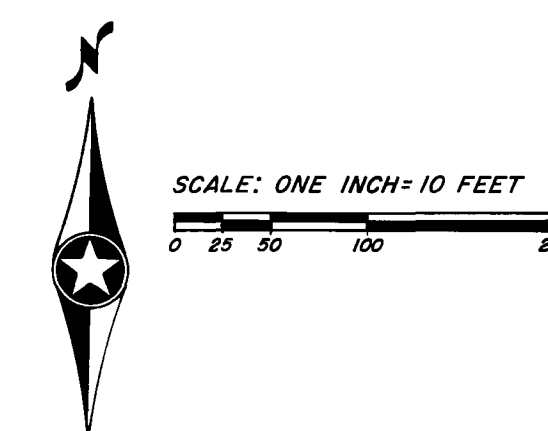


LOWER LEVEL

LOWER LEVEL ELEVATIONS:  
 FLOOR ELEVATION = 856.14  
 CONC. BLOCK LEDGE ELEVATION = 859.77  
 CEILING ELEVATION = 864.14  
 (SEA LEVEL DATUM)

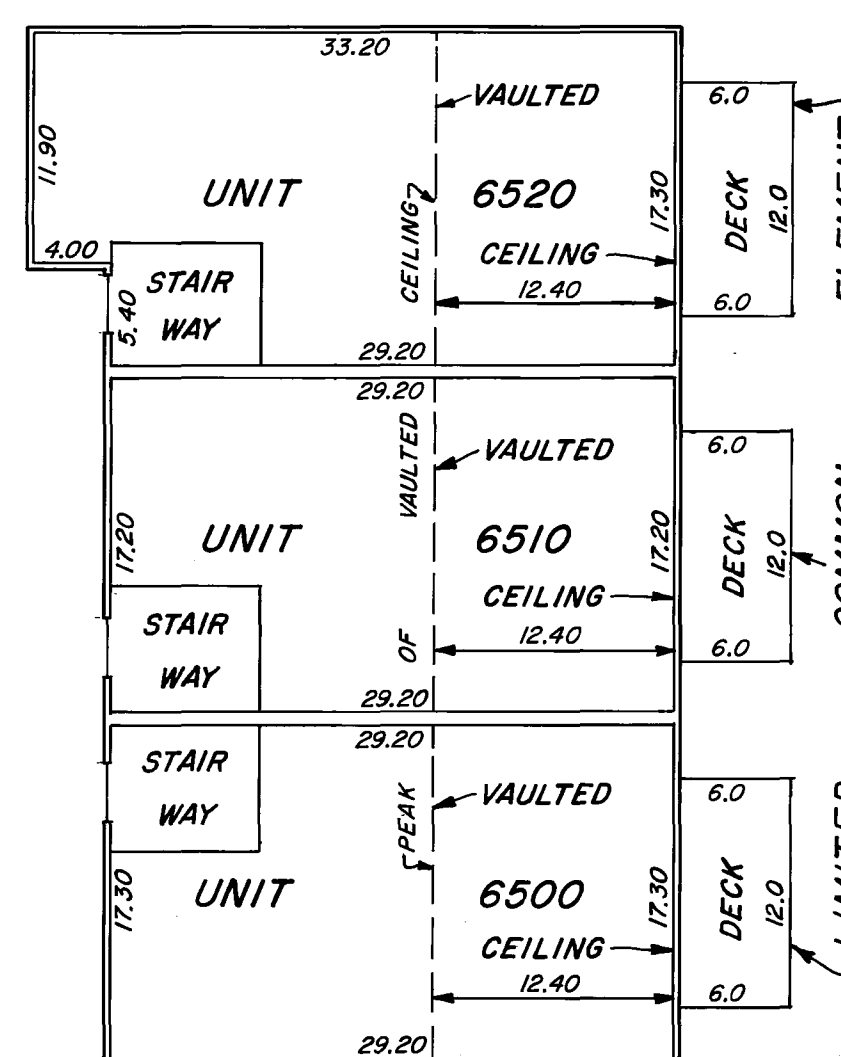

UPPER LEVEL

UPPER LEVEL ELEVATIONS:  
 FLOOR ELEVATION = 865.04  
 CEILING ELEVATION = 873.04  
 CEILING ELEVATION = 875.24  
 (PEAK OF VAULTED CEILING)  
 (SEA LEVEL DATUM)

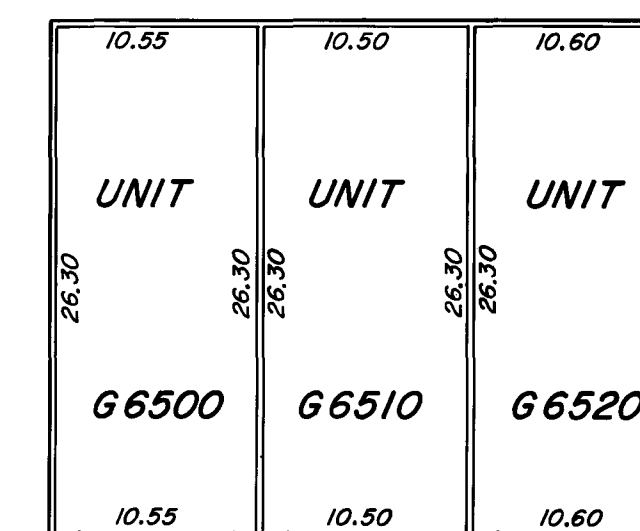

GARAGE

GARAGE ELEVATIONS:  
 FLOOR ELEVATION = 858.92  
 CEILING ELEVATION = 866.97  
 (SEA LEVEL DATUM)