

CERTIFICATE OF LOCATION OF GOVERNMENT CORNER

County of Anoka

State of Minnesota

Witness Corner of Sec. 6 Township 32 Range 24


(on north line of section east of Rum River)

On the 4th day of May, 1966, the described corner was evidenced by area resurvey

and to perpetuate the location of said corner, at the exact location thereof, a permanent marker was placed consisting of a cast iron monument

AND on the 29th day of October, 2010, said permanent marker was found down 1'± with a 'T' post on north side and the ties were updated. On 5/06/11 a sign & post was set on west side.

Updated reference ties are as shown below.

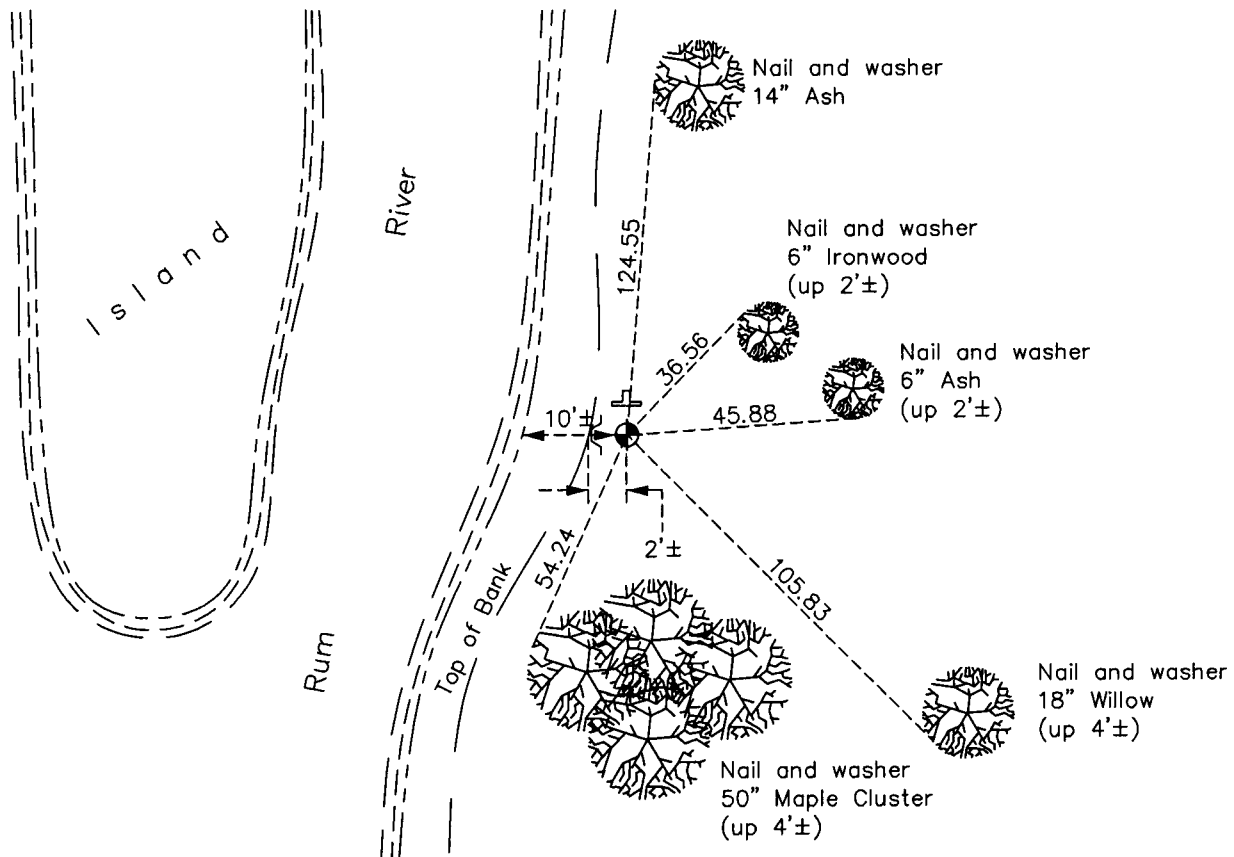

N

W ANOKA COUNTY SURVEYOR E

S

Revision Date

8/02/11

N.A.D. 1983 Coordinates
(1996 Adjustment)

County Project Coordinates	
Northing	196077.1771
Easting	471575.5754
Date	12/15/00

I hereby certify that this United States public land survey monument record is correct and complete to the best of my knowledge and belief.

Larry D. Hoium Date 8/02/11

Larry D. Hoium, Anoka County Surveyor

Minnesota License Number 18165