

# CERTIFICATE OF LOCATION OF GOVERNMENT CORNER

County of Anoka

State of Minnesota



Witness Corner of Sec. 6 Township 32 Range 24  
(on north line of section and west side of Rum River)

On the 3rd day of May, 1966, the described corner was evidenced by area resurvey

and to perpetuate the location of said corner, at the exact location thereof, a permanent marker was placed consisting of a cast iron monument with a sign and post on the east side

AND on the 27th day of October, 2010, said permanent marker was found and the ties  
were updated

Updated reference ties are as shown below.

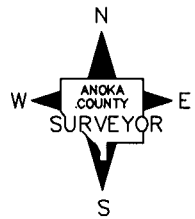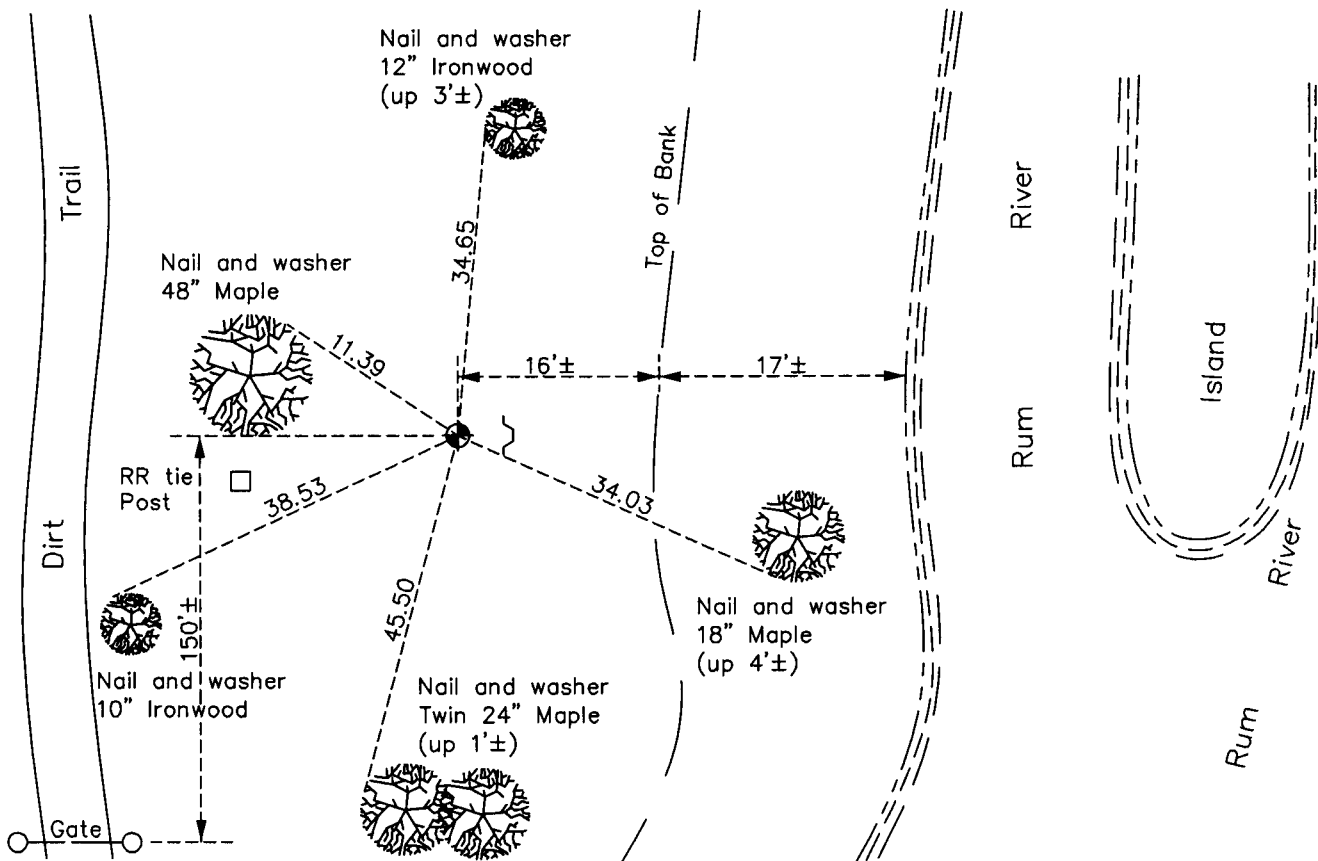

N.A.D. 1983 Coordinates  
(1996 Adjustment)

| County Project Coordinates |             |
|----------------------------|-------------|
| Northing                   | 196081.7508 |
| Easting                    | 471346.2519 |
| Date                       | 12/15/00    |

Revision Date  
4/04/11

I hereby certify that this United States public land survey monument record is correct and complete to the best of my knowledge and belief.  
*Larry D. Hoium* Date 4/04/11  
Larry D. Hoium, Anoka County Surveyor  
Minnesota License Number 18165