

CERTIFICATE OF LOCATION OF GOVERNMENT CORNER

County of Anoka

State of Minnesota



West 1/4 Corner of Sec. 1 Township 32 Range 24

On the 14th day of December, 1962, the described corner was evidenced by area resurvey

and to perpetuate the location of said corner, at the exact location thereof, a permanent marker was placed consisting of a 3/4" open end pipe standing 18" out of ground

AND on the 14th day of March, 2011, said permanent marker was replaced with a red & white 2" square steel Telspar monument up 1'± with a 'County Surveyor" cap set over 3/4" pipe

Updated reference ties are as shown below.

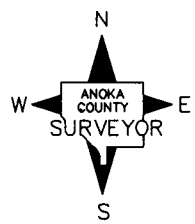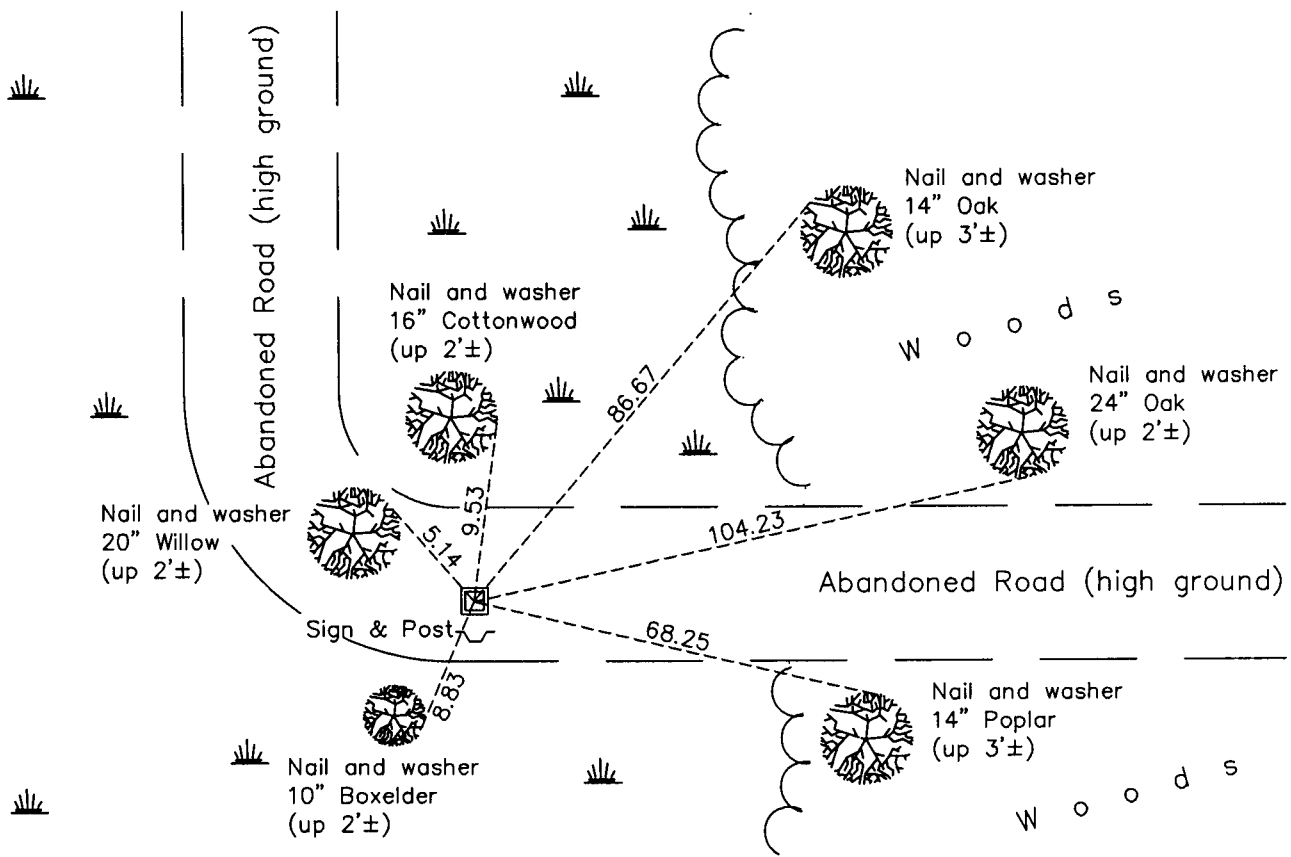

Revision Date
4/06/11

N.A.D. 1983 Coordinates
(1996 Adjustment)

County Project Coordinates	
Northing	193259.0580
Easting	495118.7199
Date	12/01/00

I hereby certify that this United States public land survey monument record is correct and complete to the best of my knowledge and belief.

Larry D. Hoium Date 4/06/11

Larry D. Hoium, Anoka County Surveyor

Minnesota License Number 18165