

CERTIFICATE OF LOCATION OF GOVERNMENT CORNER

County of Anoka

State of Minnesota



Southeast Corner of Sec. 6 Township 32 Range 24

On the 27th day of May, 1966, the described corner was evidenced by area resurvey

and to perpetuate the location of said corner, at the exact location thereof, a permanent marker was placed consisting of a red and white iron pipe

AND on the 17th day of December, 2010, said permanent marker was found up 3'± and the ties were updated. On February 17, 2011 a sign and post was set 1'± west of the iron pipe.

Updated reference ties are as shown below.

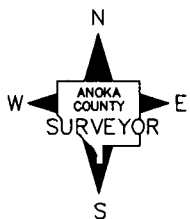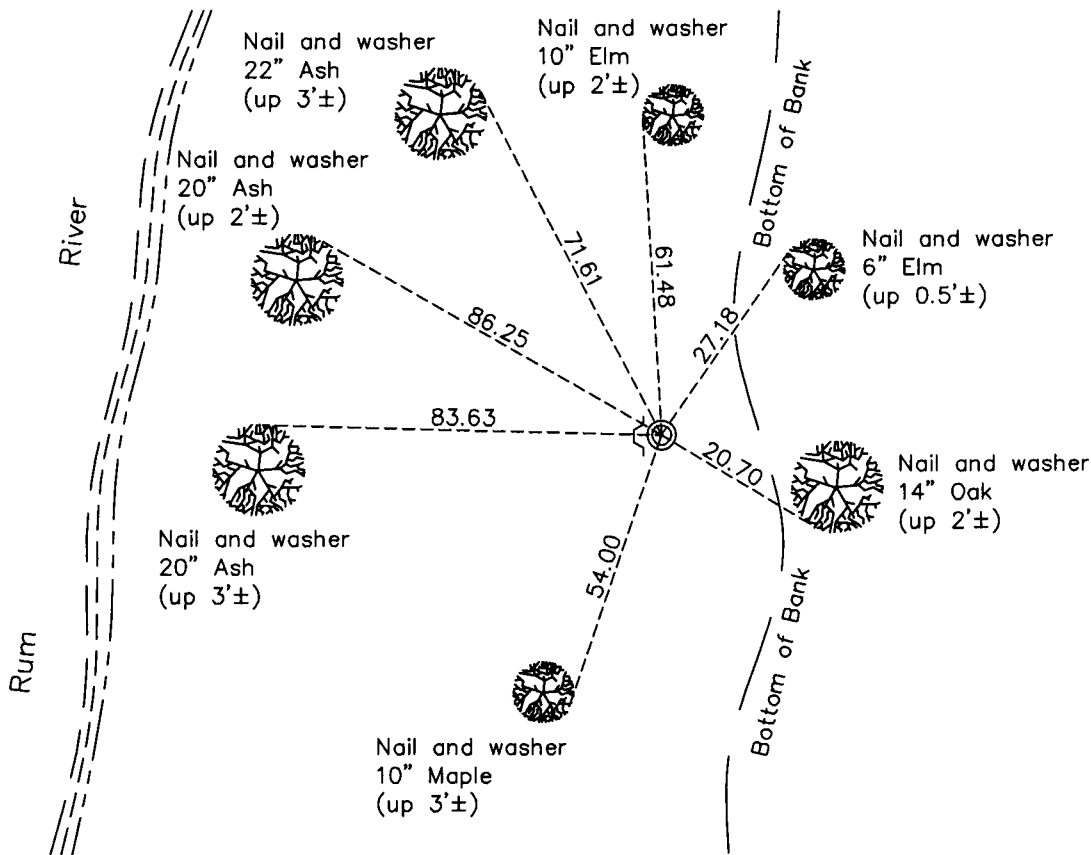

Revision Date
4/14/11

N.A.D. 1983 Coordinates
(1996 Adjustment)

County Project Coordinates	
Northing	190891.4562
Easting	474071.3528
Date	12/06/00

I hereby certify that this United States public land survey monument record is correct and complete to the best of my knowledge and belief.

Larry D. Hoium Date 4/14/11

Larry D. Hoium, Anoka County Surveyor

Minnesota License Number 18165