

CERTIFICATE OF LOCATION OF GOVERNMENT CORNER

County of Anoka


State of Minnesota

South 1/16 Corner of Sec. 11 Township 32 Range 24
 North-South 1/4 Line

I hereby certify that on the 16th day of October, 1961, I found the described corner which was evidenced by a sandstone rock

and I further certify that to perpetuate the location of said corner, I did, at the exact location thereof, place a permanent marker consisting of a sandstone rock

which reference or witness monuments are located in the manner following:

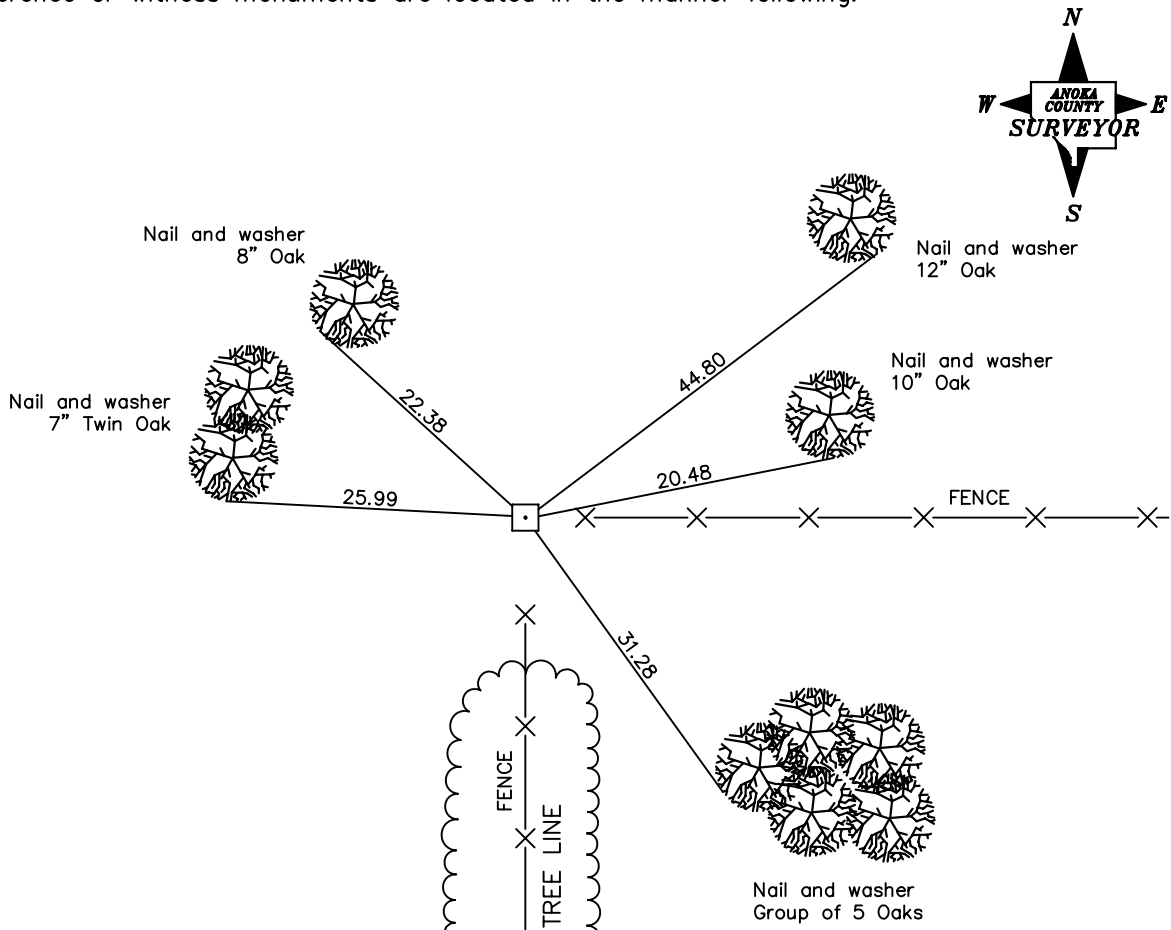

Revised date

6/17/82

N.A.D. 1983 Co-ordinates

County Project Co-ordinates	State Plane Co-ordinates
Northing _____	Y _____
Easting _____	X _____

Date(No GPS Info Taken)