

# CERTIFICATE OF LOCATION OF GOVERNMENT CORNER

County of Anoka

State of Minnesota



## North 1/4 Corner of Sec. 15 Township 32 Range 24

On the 29th day of January, 1964, the described corner was evidenced by area resurvey

and to perpetuate the location of said corner, at the exact location thereof, a permanent marker was placed consisting of a red and white iron pipe up 3 1/2"

AND on the 18th day of January, 2011, said permanent marker was found with paint worn off and the ties were updated. On 2/18/11 a sign & post was set 1'± north of iron pipe.

Updated reference ties are as shown below.

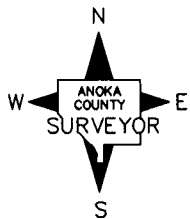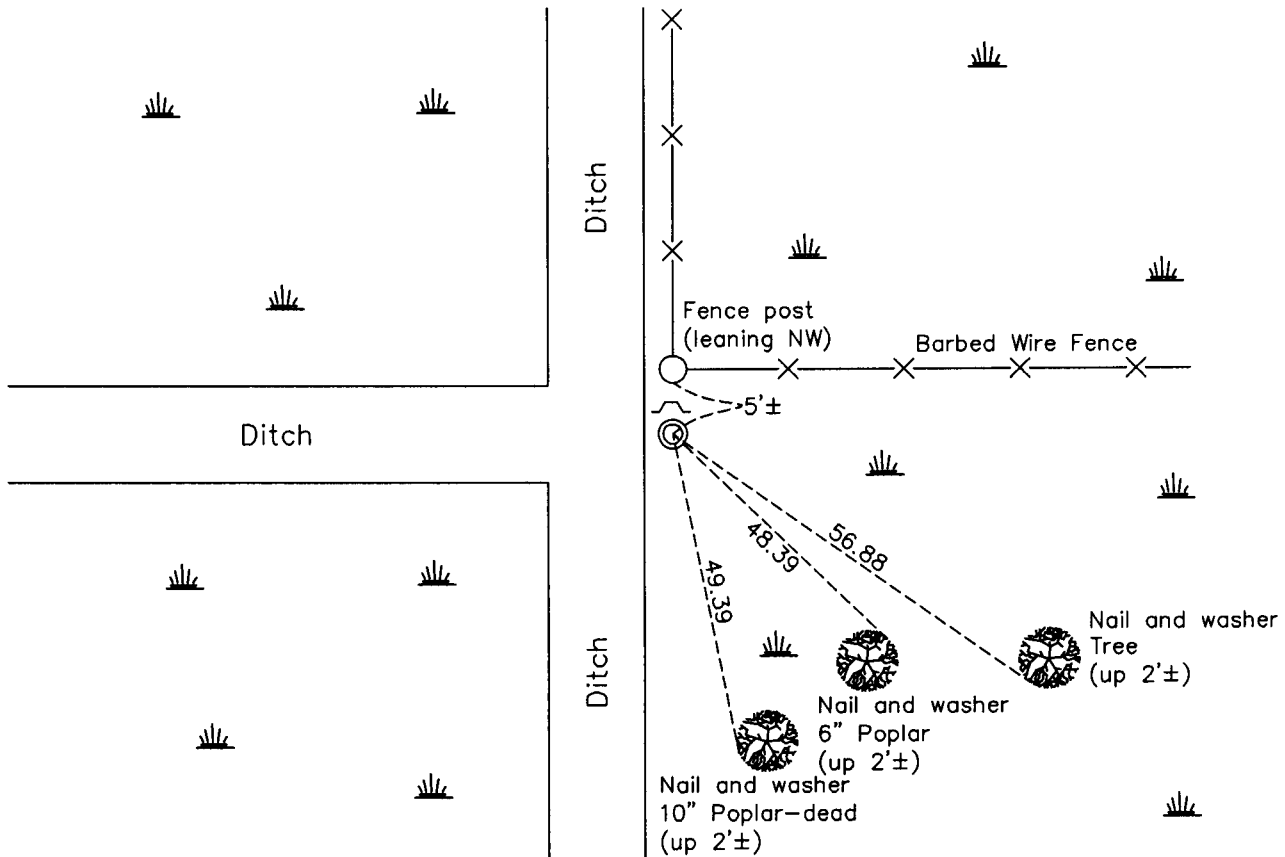

Revision Date

4/21/11

N.A.D. 1983 Coordinates  
(1996 Adjustment)

County Project Coordinates	
Northing	185579.5786
Easting	487286.9328
Date	1/25/01

I hereby certify that this United States public land survey monument record is correct and complete to the best of my knowledge and belief.

*Larry D. Hoium* Date 4/21/11

Larry D. Hoium, Anoka County Surveyor

Minnesota License Number 18165