

CERTIFICATE OF LOCATION OF GOVERNMENT CORNER

County of Anoka

State of Minnesota



North 1/4 Corner of Sec. 17 Township 32 Range 24

On the 28th day of June, 1973, the described corner was evidenced by area resurvey

and to perpetuate the location of said corner, at the exact location thereof, a permanent marker was placed consisting of a red and white 2" iron pipe up 1'±

AND on the 27th day of October, 2010, said permanent marker was found leaning. Pipe was straightened. On 3/01/11 GPS coordinates were checked, ties updated and sign and post set south.

Updated reference ties are as shown below.

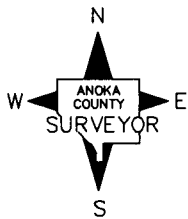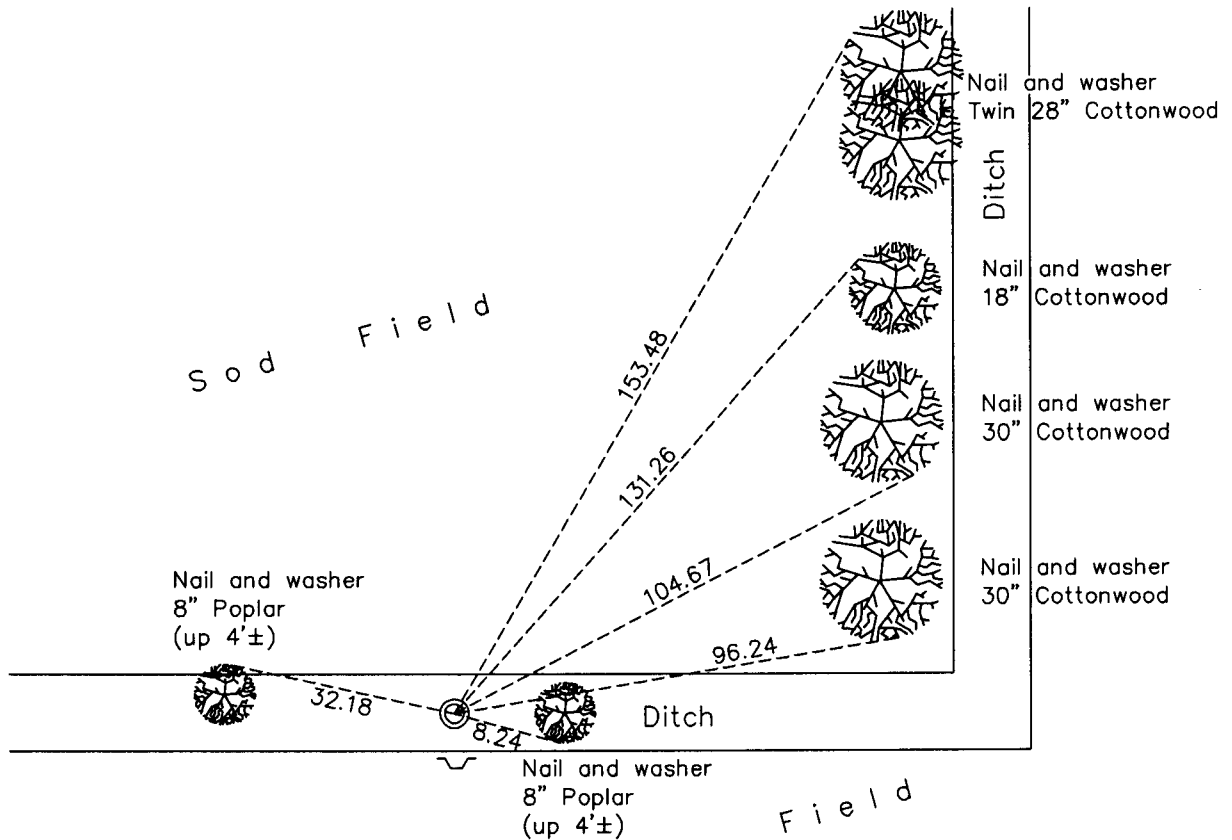

Revision Date
4/22/11

N.A.D. 1983 Coordinates
(1996 Adjustment)

County Project Coordinates	
Northing	185625.3993
Easting	476759.1495
Date	1/23/01

I hereby certify that this United States public land survey monument record is correct and complete to the best of my knowledge and belief.

Larry D. Hoium Date 4/22/11

Larry D. Hoium, Anoka County Surveyor
Minnesota License Number 18165