

CERTIFICATE OF LOCATION OF GOVERNMENT CORNER

County of Anoka

State of Minnesota



North 1/4 Corner of Sec. 22 Township 32 Range 24

On the 9th day of August, 1960, the described corner was evidenced by an iron pipe

and to perpetuate the location of said corner, at the exact location thereof, a permanent marker was placed consisting of a cast iron monument

AND on the 6th day of December, 2010, said permanent marker was found down 0.3'± and the ties were updated

Updated reference ties are as shown below.

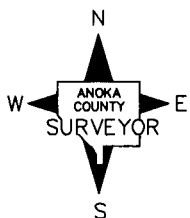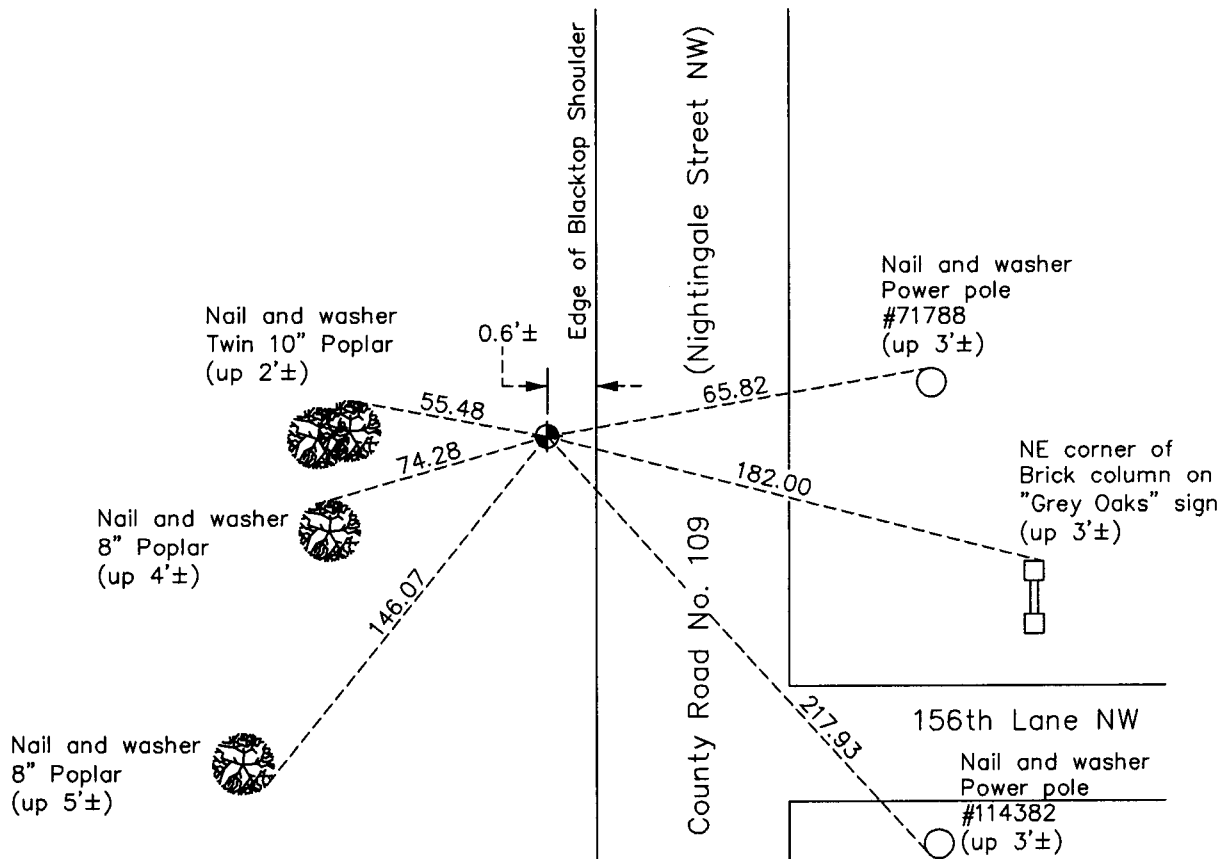

Revision Date

5/02/11

N.A.D. 1983 Coordinates
(1996 Adjustment)

County Project Coordinates	
Northing	180322.7694
Easting	487227.8667
Date	7/31/00

I hereby certify that this United States public land survey monument record is correct and complete to the best of my knowledge and belief.

Larry D. Hoium Date 5/02/11

Larry D. Hoium, Anoka County Surveyor

Minnesota License Number 18165